MOJJ ENGINEERING SYSTEMS LTD.

PROCESS DESIGNERS AND PROJECT ENGINEERS
81-B/15 MIDC BHOSARI, PUNE-411 026,INDIA

PROJECT NO	MSD-705
PROJECT NAME	SPRAY DRYER
PANEL	MSD-705-SPRAY DRYER
CLIENT	-

PANEL NAME	SPRAY DRYER
SUPPLIER	MOJJ ENGINEERING SYSTEMS LTD. PUNE
YEAR OF MFG	YEAR 2025-26
REVISION	AS BUILT

Edit date 24-06-2025 CREATOR SYSTEM ASHOK.SHELAKE

TOTAL NO. OF PAGES 62

Table of contents

Column X: An automatically generated page was edited F06_001

Page	Page description	supplementary page field	Date	Edited by	X
/1	TITLE PAGE		5/23/2025	NIKHIL.ADITYA	X
/2	Table of contents : /1 - /28		5/23/2025	NIKHIL.ADITYA	
/2.a	Table of contents : /29 - /58		5/23/2025	NIKHIL.ADITYA	
/2.b	Table of contents : /59 - /60		5/23/2025	NIKHIL.ADITYA	
/3	GENERAL SPECIFICATIONS		5/23/2025	NIKHIL.ADITYA	
/4	SYSTEM ARCHITECTURE		5/23/2025	NIKHIL.ADITYA	
/5	COVER PAGE		5/23/2025	NIKHIL.ADITYA	
/6	EXTERNAL GENERAL ARRANGEMENT DRAWING-FRONT VIEW		5/23/2025	NIKHIL.ADITYA	
/7	INTERNAL GENERAL ARRANGEMENT DRAWING-FRONT VIEW		5/23/2025	NIKHIL.ADITYA	
/8	EXTERNAL GENERAL ARRANGEMENT DRAWING OF HMI		5/23/2025	NIKHIL.ADITYA	
/9	LEGENDS		5/23/2025	NIKHIL.ADITYA	
/10	SINGLE LINE DIAGRAM		5/23/2025	NIKHIL.ADITYA	
/11	SINGLE LINE DIAGRAM		5/23/2025	NIKHIL.ADITYA	
/12	SINGLE LINE DIAGRAM		5/23/2025	NIKHIL.ADITYA	
/13	COVER PAGE		5/23/2025	NIKHIL.ADITYA	
/14	INCOMER WIRING		5/23/2025	NIKHIL.ADITYA	
/15	INCOMER WIRING		5/23/2025	NIKHIL.ADITYA	
/16	CONTROL WIRING		5/23/2025	NIKHIL.ADITYA	
/17	1F-MAIN ID BLOWER POWER & CONTROL WIRING		5/23/2025	NIKHIL.ADITYA	
/18	1F-MAIN ID BLOWER VFD CONTROL WIRING		5/23/2025	NIKHIL.ADITYA	
/19	2F-ATOMIZER POWER & CONTROL WIRING		5/23/2025	NIKHIL.ADITYA	
/20	2F-ATOMIZER VFD CONTROL WIRING		5/23/2025	NIKHIL.ADITYA	
/21	3F-FEED PUMP-A POWER & CONTROL WIRING		5/23/2025	NIKHIL.ADITYA	
/22	3F-FEED PUMP-A VFD CONTROL WIRING		5/23/2025	NIKHIL.ADITYA	
/23	4F-FD BLOWER POWER & CONTROL WIRING		5/23/2025	NIKHIL.ADITYA	
/24	5F-CIP PUMP POWER & CONTROL WIRING		5/23/2025	NIKHIL.ADITYA	
/25	6F-SPARE-01 POWER & CONTROL WIRING		5/23/2025	NIKHIL.ADITYA	
/26	7F-SCRUBBER PUMP-A POWER & CONTROL WIRING		5/23/2025	NIKHIL.ADITYA	
/27	8F-SPARE-02 POWER & CONTROL WIRING		5/23/2025	NIKHIL.ADITYA	
/28	9F-BURNER MOTOR POWER & CONTROL WIRING		5/23/2025	NIKHIL.ADITYA	

Table of contents

Column X: An automatically generated page was edited

F06_001

Page	Page description	supplementary page field	Date	Edited by	X
/29	TEMPERATURE CONTROLER		5/23/2025	NIKHIL.ADITYA	
/30	10F-ROTARY VALVE FOR CYCLONE POWER & CONTROL WIRING		5/23/2025	NIKHIL.ADITYA	
/31	11F-LUBRICATION OIL PUMP POWER & CONTROL WIRING		5/23/2025	NIKHIL.ADITYA	
/32	SUPPLY FEEDER		5/23/2025	NIKHIL.ADITYA	
/33	HAMMER-SUPPLY FEEDER WIRING		5/23/2025	NIKHIL.ADITYA	
/34	10-POINT SEQUENTIAL TIMER		5/23/2025	NIKHIL.ADITYA	
/35	COVER PAGE		5/23/2025	NIKHIL.ADITYA	
/36	24VDC CONTROL WIRING		5/23/2025	NIKHIL.ADITYA	
/37	24VDC DISTRIBUTION		5/23/2025	NIKHIL.ADITYA	
/38	SUPPLY MODULE		5/23/2025	NIKHIL.ADITYA	
/39	32DI-DIGITAL INPUT WIRING-1		5/23/2025	NIKHIL.ADITYA	
/40	32DI-DIGITAL INPUT WIRING-1		5/23/2025	NIKHIL.ADITYA	
/41	32DI-DIGITAL INPUT WIRING-1		5/23/2025	NIKHIL.ADITYA	
/42	32DI-DIGITAL INPUT WIRING-1		5/23/2025	NIKHIL.ADITYA	
/43	32DI-DIGITAL INPUT WIRING-2		5/23/2025	NIKHIL.ADITYA	
/44	32DI-DIGITAL INPUT WIRING-2		5/23/2025	NIKHIL.ADITYA	
/45	32DI-DIGITAL INPUT WIRING-2		5/23/2025	NIKHIL.ADITYA	
/46	32DI-DIGITAL INPUT WIRING-2		5/23/2025	NIKHIL.ADITYA	
/47	32DO-DIGITAL OUTPUT WIRING-1		5/23/2025	NIKHIL.ADITYA	
/48	32DO-DIGITAL OUTPUT WIRING-1		5/23/2025	NIKHIL.ADITYA	
/49	32DO-DIGITAL OUTPUT WIRING-1		5/23/2025	NIKHIL.ADITYA	
/50	32DO-DIGITAL OUTPUT WIRING-1		5/23/2025	NIKHIL.ADITYA	
/51	8AI-ANALOG INPUT WIRING-1		5/23/2025	NIKHIL.ADITYA	
/52	8AI-ANALOG INPUT WIRING-1		5/23/2025	NIKHIL.ADITYA	
/53	8AI-ANALOG INPUT WIRING-2		5/23/2025	NIKHIL.ADITYA	
/54	8AI-ANALOG INPUT WIRING-2		5/23/2025	NIKHIL.ADITYA	
/55	8AO-ANALOG OUTPUT WIRING-1		5/23/2025	NIKHIL.ADITYA	
/56	COVER PAGE		5/23/2025	NIKHIL.ADITYA	
/57	24VDC CONTROL WIRING		5/23/2025	NIKHIL.ADITYA	
/58	TERMINATION		5/23/2025	NIKHIL.ADITYA	

Table of contents

Column X: An automatically generated page was edited

F06_001

Page	Page description	supplementary page field	Date	Edited by	X
/59	TERMINATION		5/23/2025	NIKHIL.ADITYA	
/60	TERMINATION		5/23/2025	NIKHIL.ADITYA	

GENERAL SPECIFICATIONS

A. REFERENCES

01	CUSTOMER NAME	:	MOJJ ENGINEERING SYSTEMS. LTD
02	PROJECT	:	MCC CUM PLC PANEL

B. SYSTEM PARAMETERS

01	RATED INCOMING	:	415VAC, 3PH. 4WIRE
02	RATED CONTROL	:	230VAC
03	VOLTAGE VARIATION, %	:	± 10%
04	TYPE OF SYSTEM	:	MCC CUM PLC PANEL
05	RATED FREQUENCY, Hz.	:	50 Hz ± 5%
06	AMBIENT TEMP.	:	40°C

C. CONSTRUCTION

01	MAKE OF PANEL	:	MS FABRICATED		
02	DIMENSIONS IN MM.	:	2100+75 (H) + 2200 (W) + 400 (D) FOR MAIN PANEL		
	DIMENSIONS IN MM.	:	400 (H) + 400 (W) + 210 (D)		FOR HMI PANEL
03	MATERIAL	:	ENCLOSURE FRAME	:	2.0/1.6MM (CRCA SHEET)
		:	DOORS	:	2.0MM (CRCA SHEET)
		:	MOUNTING PLATE	:	2.0MM (CRCA SHEET)
		:	GLAND PLATE	:	3.0MM (CRCA SHEET)
		:	MOUNTING PLATE	:	DIP ORANGE
05	CABLE ENTRY	:	FROM BOTTOM SIDE		
06	LIFTING EYEBOLTS	:	PROVIDED AT TOP		
07	REAR ACCESS	:	NO		
08	PANEL COLOUR	:	SIEMENS GREY RAL 7032 STRUCTURE FINISH		
09	DOORS	:	FRONT DOOR OPENING		
10	DEGREE OF PROTECTION	:	IP-52		

D. EQUIPMENT

01	CONTROL/PROTECTION	:	MCCB'S,MPCB'S,MCB'S USED
02	LABEL STICKERS	:	ALL LEGEND INSIDE PANEL WILL BE YELLOW STICKERS. YELLOW BACKGROUND WITH BLACK PRINTED LETTERS.
		:	ALL LEGEND OUTSIDE PANEL WILL BE ALLUMINIUM LABELS. BLACK BACKGROUND WITH WHITE PRINTED LETTERS.

03	WIRING COLOUR CODING					
	415V AC, 3Ph INCOMING	:	AS PER RATING	:	RED,YELLOW & BLUE	
	415V AC, 3Ph (POWER WIRING)	:	FOR 0.17-3.7KW FEEDER	:	2.5 SQ.MM RED/YELLOW/BLUE	
		:	11KW FEEDER	:	6/4 SQ.MM RED/YELLOW/BLUE	
		:	18.5KW FEEDER	:	10 SQ.MM RED/YELLOW/BLUE	
	POWER EARTH	:	2.5 mm²	:	YELLOW/GREEN	
04	CONTROL WIRING	:	230VAC	:	1.5 mm²	
	230V AC PHASE	:	1.5mm²	:	GREY	
	230V NEUTRAL	:	1.5 mm²	:	BLACK	
	24VDC COMMON	:	0.75 mm²	:	ORANGE	
	24VDC PLC I/P	:	0.75 mm²	:	BLUE	
	DIGITAL INPUT	:	0.5 mm²	:	ORANGE/WHITE	
	DIGITAL OUTPUT (P.F.)	:	1.0 mm²	:	GREY	
	ANALOG INPUT	:	0.5 mm²	:	ORANGE/WHITE	
	ANALOG OUTPUT	:	0.5 mm²	:	BROWN/WHITE	
05	BUSBAR MOC	:	ALUMINIUM			
	SIZES	:	INCOMING BUS R/Y/B PHASE	:	1RX25X10MM	
		:	OUTGOING BUS R/Y/B PHASE	:	1RX25X10MM	
		:	NEUTRAL BUSBAR	:	1RX20X10MM	
		:	EARTHING BUSBAR	:	1RX25X10MM	
06	FERRULES	:	NUMBERS			
	FERRULING TYPE	:	BLACK LETTER ON WHITE SLEEVE (PRINTED FERRULE)			
07	TERMINAL COLOUR CODING					
	415V AC, 3Ph INCOMING	:	AS PER RATING	:	RED,YELLOW & BLUE	
	415V AC, 3Ph (POWER TERMINAL)	:	FOR 0.17-1.5KW FEEDER	:	6 SQ.MM RED/YELLOW/BLUE	
		:	FOR 3.7-11KW FEEDER	:	10 SQ.MM RED/YELLOW/BLUE	
		:	FOR 18.5KW FEEDER	:	16 SQ.MM RED/YELLOW/BLUE	
	POWER EARTH	:	4 mm²	:	YELLOW/GREEN	
08	CONTROL TERMINAL	:	230VAC	:	4 mm²	
	230V AC PHASE	:	4 mm²	:	GREY	
	230V NEUTRAL	:	4 mm²	:	BLACK	

MOJJ ENGINEERING SYSTEMS LTD


REVISION	DETAILS	DATE			
			TITLE:- GENERAL SPECIFICATIONS		
02	AS BUILT		FILE NO: MES / E&I / MSD-705		
01	AS PER COMMENTS	12-05-2025	DRAWN BY	N.A.	
00	FOR APPROVAL	08-05-2025	CHECKED	P.B.	
			APPROVED	MESL	

PROJECT:- SPRAY DRYER

PROJECT:- MSD-705

DRG. NO.:- 2526/PRG/MSD/705 | SHEET NO. 5 / 62 | REV.NO. AS BUILT

#PLC SYSTEMS ARCHITECTURE

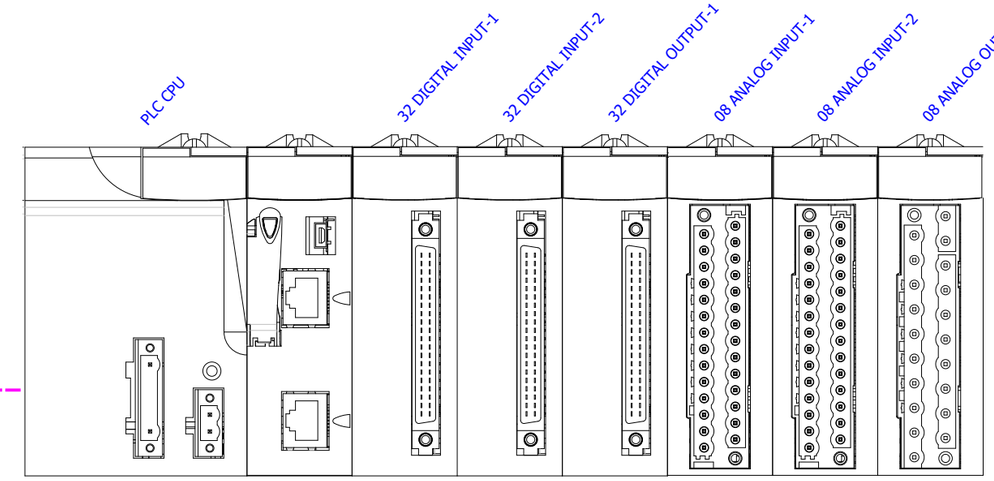

PLC HARDWARE DETAILS

SR.NO.	HARDWARE DETAILS	MLFB NO.	QTY.(NO'S)
01	8 SLOTS BACKPLANE	BMXXBP0800	01
02	STANDARD AC POWER SUPPLY	BMXCPS2000	01
03	CPU340-20 MODBUS ETHERNET	BMXP342020	01
04	DIG 32I 24 VDC SINK	BMXDDI3202K	02
05	FCN 2 X 20 WIRE 3M CABLE	BMXFCW303	03
06	DIG 32Q TRANS SOURCE 0.1A	BMXDDO3202K	01
07	Ana 8 U/I In No Isol Fast	BMXAMI0800	02
08	CAGED TERMINAL STRIP 28 POINTS	BMXFTB2800	02
09	Ana 8 Current Out No Isol	BMXAMO0802	01
10	SCREW TERMINAL STRIP 20 POINTS	BMXFTB2010	01
11	10"W Easy Touch Panel, Ethernet model	HMIET6500	01

PLC I/O COUNT

1	DIGITAL INPUT	64
2	DIGITAL OUTPUT	32
3	ANALOG INPUT	16
4	ANALOG OUTPUT	08

MOJJ ENGINEERING SYSTEMS LTD

REVISION	DETAILS	DATE			
02	AS BUILT		TITLE:- SYSTEM ARCHITECTURE		
01	AS PER COMMENTS	12-05-2025	FILE NO: MES / E&I / MSD-705		
00	FOR APPROVAL	08-05-2025	DRAWN BY	N.A.	
			CHECKED	P.B.	
			APPROVED	MESL	

PROJECT:- SPRAY DRYER


PROJECT:- MSD-705

DRG. NO.:- 2526/PRG/MSD/705 | SHEET NO. 6 / 62 | REV.NO. AS BUILT


GENERAL ARRANGEMENT DRAWING

EXTERNAL GENERAL ARRANGEMENT DRAWING


L.H.S. VIEW

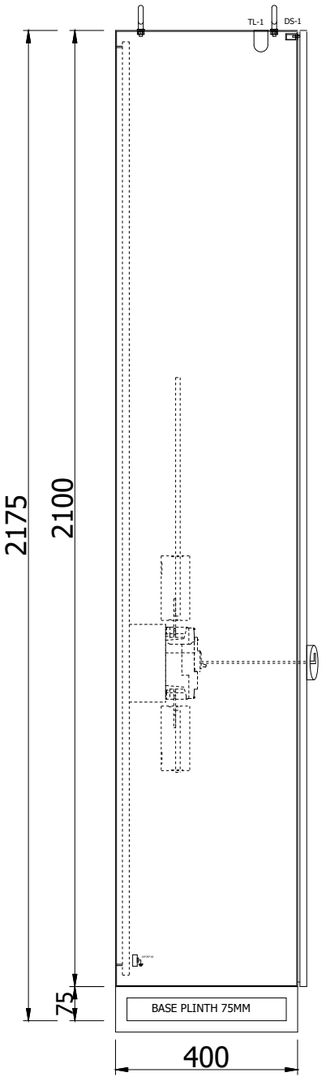


FRONT VIEW

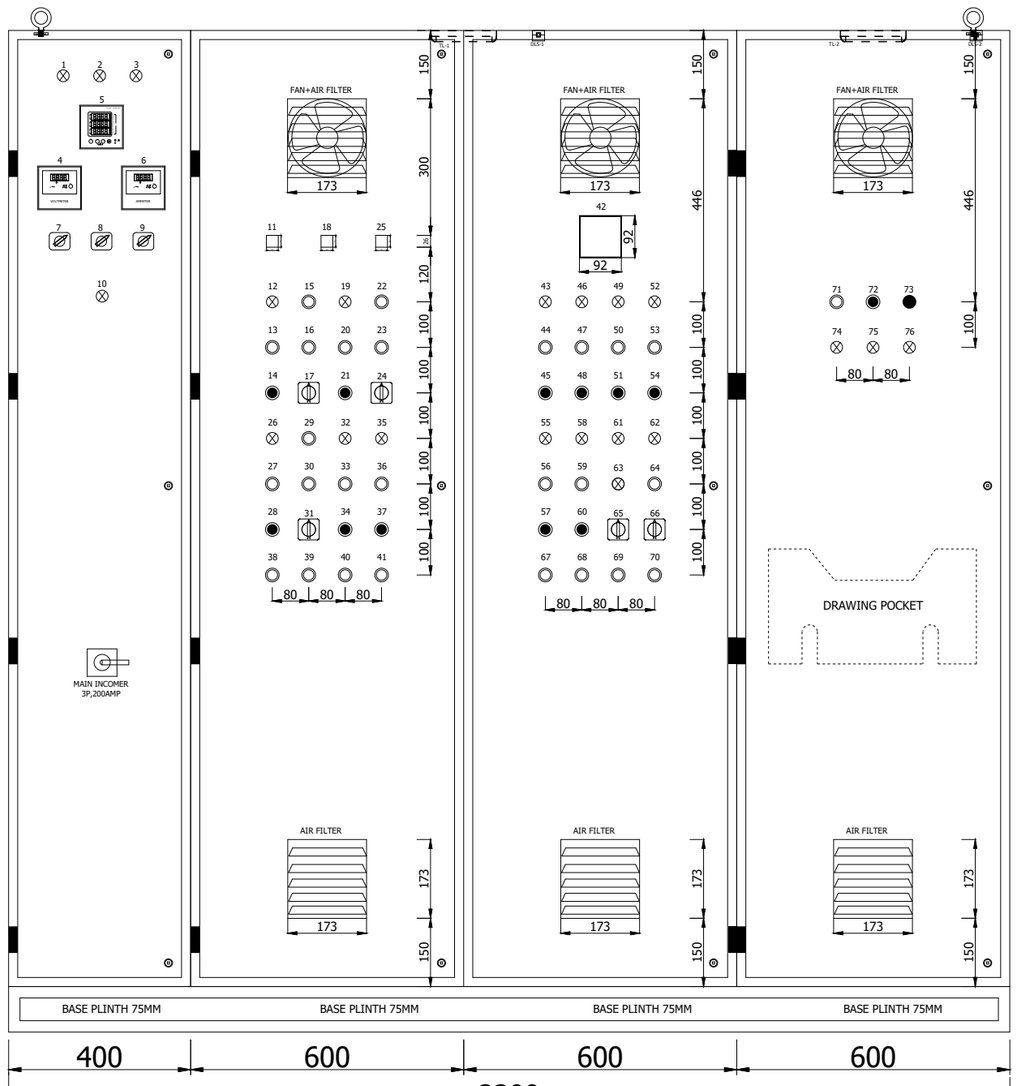

R.H.S. VIEW

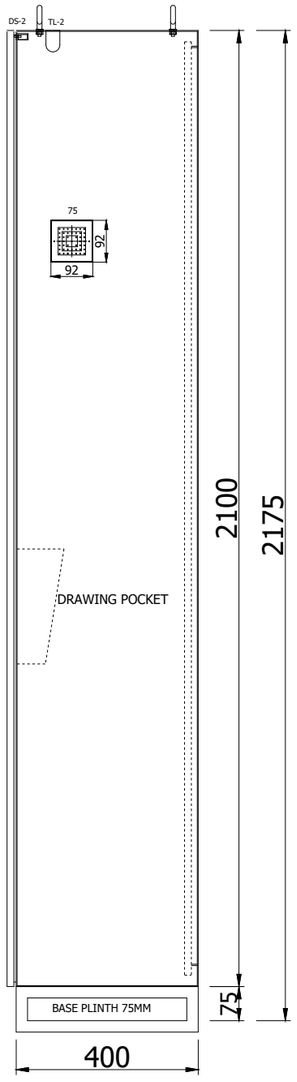

TOP VIEW

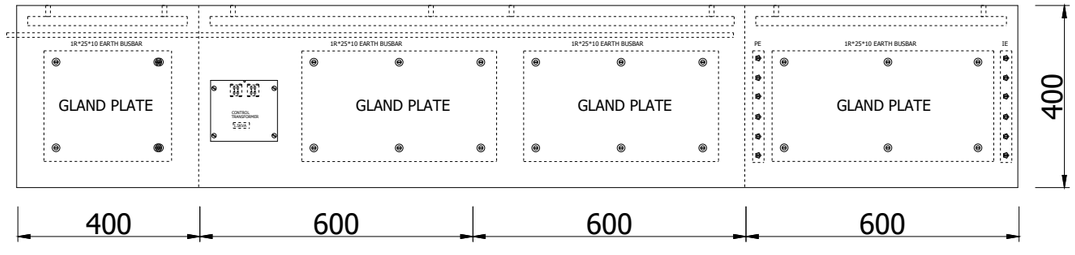

PANEL DETAILS	
MAKE OF PANEL	M.S FABRICATED
DIMENSIONS IN MM.	2100+75(H)X2200(W)X 400(D)
THICKNESS OF SHEET ENCLOSURE DOORS MOUNTING PLATE GLAND PLATE.	 2.0/1.6MM (CRCA SHEET) 2.0MM (CRCA SHEET) 2.0MM (CRCA SHEET) 3.0MM (CRCA SHEET)
GLAND PLATE	UNDRILLED GLAND PLATE FIXED WITH SCREWS AT BOTTOM
GLAND MOUNTING	AT SITE
CABLE ENTRY	AT BOTTOM
PANEL COLOUR	SIEMENS GREY RAL 7032
MOUNTING PLATE	DIP ORANGE
LIFTING EYEBOLTS	PROVIDED AT TOP
REAR ACCESS	NO
DOORS	HINGED DOORS WITH FRONT OPENING
DEGREE OF PROTECTION	IP-52

MOJJ ENGINEERING SYSTEMS LTD

REVISION	DETAILS	DATE			
02	AS BUILT		FILE NO:	MES / E&I / MSD-705	
01	AS PER COMMENTS	12-05-2025	DRAWN BY	N.A.	
00	FOR APPROVAL	08-05-2025	CHECKED	P.B.	
			APPROVED	MESL	


TITLE:- EXTERNAL GENERAL ARRANGEMENT DRAWING-FRONT VIEW

PROJECT:- SPRAY DRYER

PROJECT:- MSD-705

DRG. NO.:- 2526/PRG/MSD/705 | SHEET NO. 8 / 62 | REV.NO. AS BUILT

INTERNAL GENERAL ARRANGEMENT DRAWING

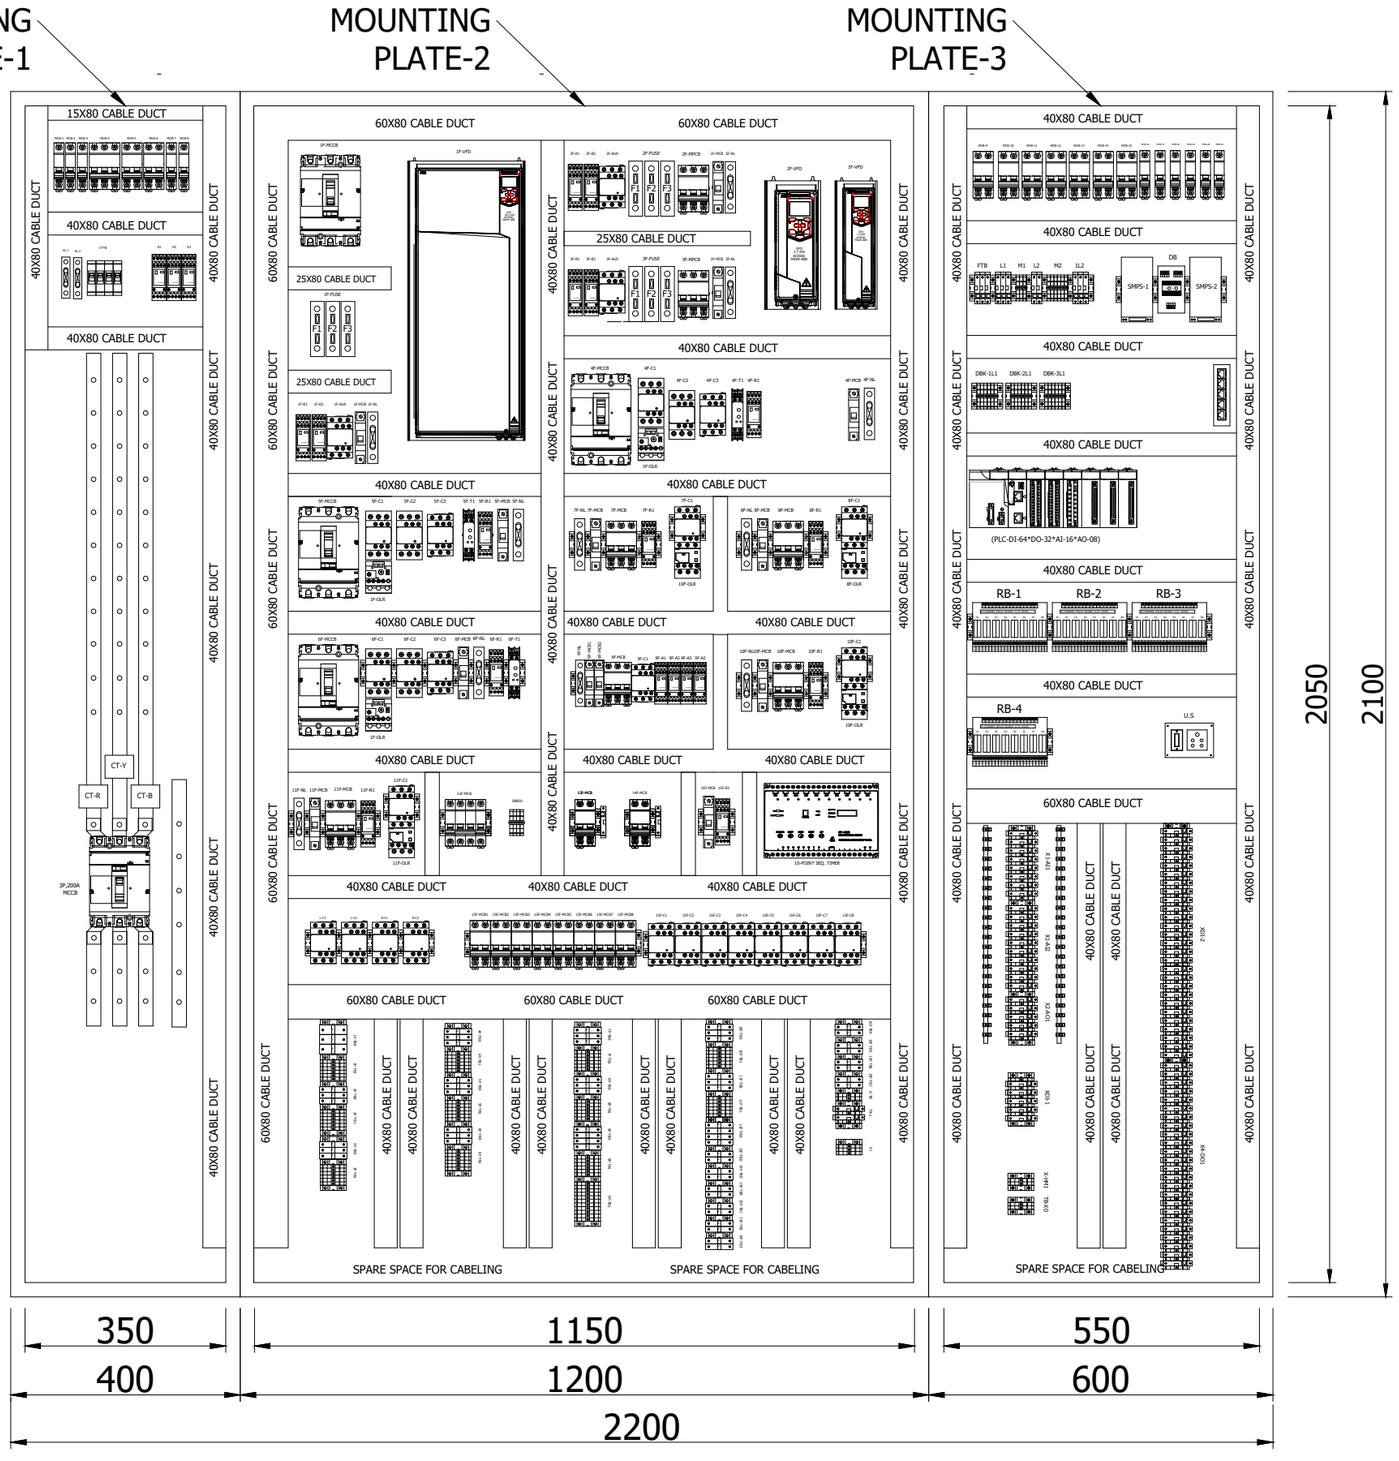

COMPONENT DETAILS FOR PLC SECTION:-

CPU	:	MAIN PLC
XDI1-2	:	DIGITAL INPUT MODULES TERMINALS
XDO1	:	DIGITAL OUTPUT MODULES TERMINALS
XAI1	:	ANALOG INPUT MODULES
XAO1-2	:	ANALOG OUTPUT MODULES
ETH	:	ETHERNET SWITCH
DB	:	DIODE MODULE
SMPS1-2	:	230VAC TO 24VDC POWER SUPPLY
RB1-4	:	24VDC 1C/O RELAY BOARD
MCB9-13	:	MCB FOR 230VAC
MCB14-21	:	MCB FOR 24VDC
FTB	:	FOR 230VAC & 24VDC INDICATIONS
L1-2 & M1-2	:	24 VDC SUPPLY DISTRIBUTION BLOCK
US	:	UTILITY SOCKET
X0	:	INCOMING SUPPLY TERMINAL BLOCK


MOJJ ENGINEERING SYSTEMS LTD

REVISION	DETAILS	DATE			
02	AS BUILT		TITLE:- INTERNAL GENERAL ARRANGEMENT DRAWING FRONT VIEW		
			FILE NO:	MES / E&I / MSD-705	
01	AS PER COMMENTS	12-05-2025	DRAWN BY	N.A.	
00	FOR APPROVAL	08-05-2025	CHECKED	P.B.	
			APPROVED	MESL	


PROJECT:-	SPRAY DRYER		
PROJECT:-	MSD-705		
DRG. NO.:- 2526/PRG/MSD/705	SHEET NO. 9 / 62	REV.NO. AS BUILT	

EXTERNAL GENERAL ARRANGEMENT DRAWING OF HMI

L.H.S. VIEW

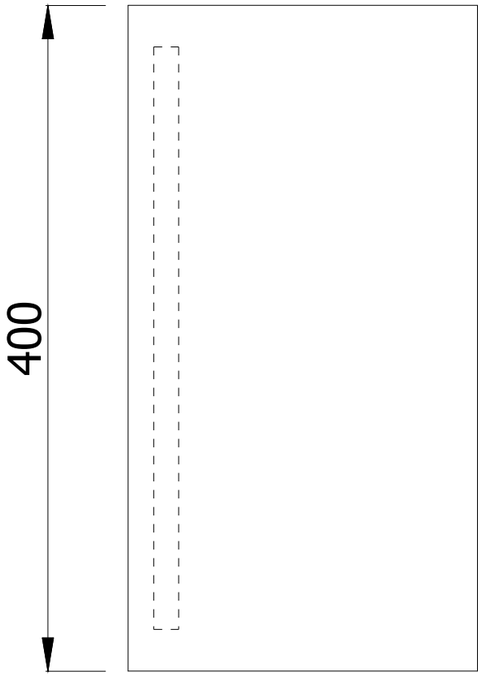


FRONT VIEW

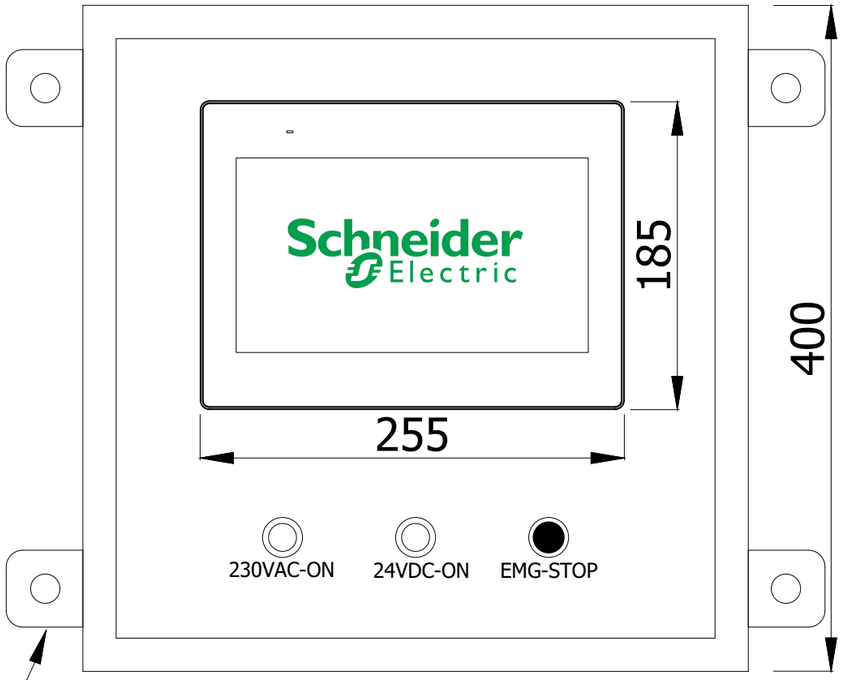


WALL-MOUNTING BRACKET


R.H.S. VIEW

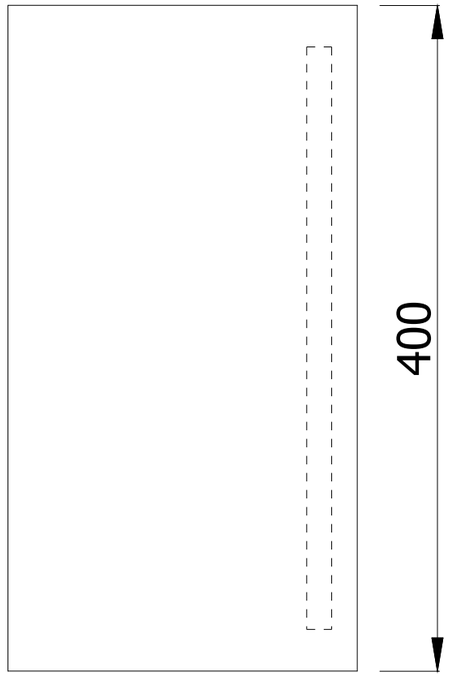

MOUTING VIEW

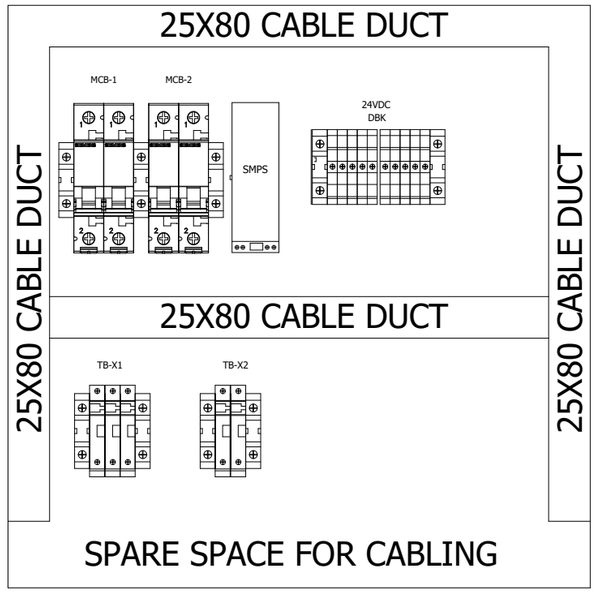

BOTTOM VIEW

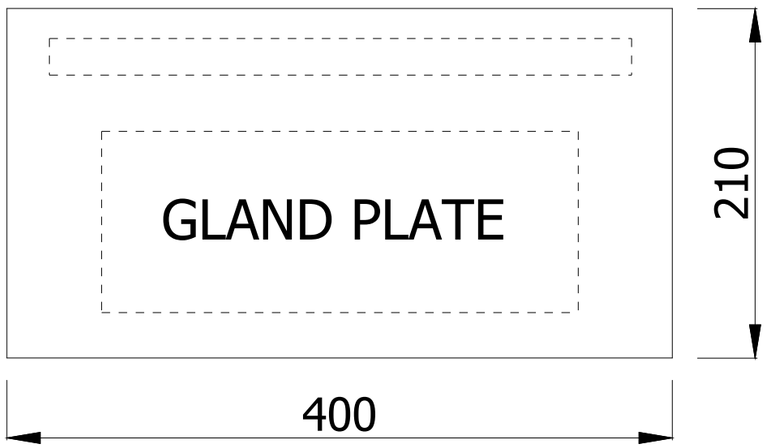

MOJJ ENGINEERING SYSTEMS LTD				TITLE:- EXTERNAL GENERAL ARRANGEMENT DRAWING OF HMI		PROJECT:- SPRAY DRYER	
	02	AS BUILT		FILE NO: MES / E&I / MSD-705			
	01	AS PER COMMENTS	12-05-2025	DRAWN BY	N.A.	PROJECT:- MSD-705	
	00	FOR APPROVAL	08-05-2025	CHECKED	P.B.		
	REVISION	DETAILS	DATE	APPROVED	MESL	DRG. NO.:- 2526/PRG/MSD/705	SHEET NO. 10 / 62 REV.NO. AS BUILT

MCC PANEL LEGENDS DETAILS

FEEDER NO	FEEDER NAME	RATING	SR NO	DESCRIPTION	CUTOUTS
-	INCOMER METERING SECTION	-	1	R-PHASE IND. LAMP (RED)	∅ 22.5
			2	Y-PHASE IND. LAMP (YELLOW)	∅ 22.5
			3	B-PHASE IND. LAMP (BLUE)	∅ 22.5
			4	MULTIFUNCTION METER	□ 92*92
			5	DIGITAL VOLTMETER	□ 92*92
			6	DIGITAL AMMETER	□ 92*92
			7	VOLTMETER SLECTOR SWITCH	∅ 10
			8	LOC/REM SSW	∅ 10
			9	AMMETER SELECTOR SWITCH	∅ 10
			10	230VAC CONTROL ON IND.	∅ 22.5
1F	MAIN ID BLOWER BL-02	VFD 18.5kW	11	1F-BOP	□ 26*26
			12	1F-TRIP IND. (AMBER)	∅ 22.5
			13	1F-START ILPB(GREEN)	∅ 22.5
			14	1F-EMG STOP PB	∅ 22.5
			15	1F-SPEED INCREASE	∅ 22.5
			16	1F-SPEED DECREASE	∅ 22.5
			17	1F-MAN/AUTO SSW	∅ 10
2F	ATOMIZER ATM-01	VFD 3.7kW	18	2F-BOP	□ 26*26
			19	2F-TRIP IND. (AMBER)	∅ 22.5
			20	2F-START ILPB(GREEN)	∅ 22.5
			21	2F-EMG STOP PB	∅ 22.5
			22	2F-SPEED INCREASE	∅ 22.5
			23	2F-SPEED DECREASE	∅ 22.5
			24	2F-MAN/AUTO SSW	∅ 10
3F	FEED PUMP-A PU-01	VFD 1.5kW	25	3F-BOP	□ 26*26
			26	3F-TRIP IND. (AMBER)	∅ 22.5
			27	3F-START ILPB(GREEN)	∅ 22.5
			28	3F-EMG STOP PB	∅ 22.5
			29	3F-SPEED INCREASE	∅ 22.5
			30	3F-SPEED DECREASE	∅ 22.5
			31	3F-MAN/AUTO SSW	∅ 10
4F	FD BLOWER BL-01	S/D 11kW	32	4F-TRIP IND. (AMBER)	∅ 22.5
			33	4F-START ILPB(GREEN)	∅ 22.5
			34	4F-EMG STOP PB	∅ 22.5
5F	CIP PUMP PU-03	S/D 11kW	35	5F-TRIP IND. (AMBER)	∅ 22.5
			36	5F-START ILPB(GREEN)	∅ 22.5
			37	5F-EMG STOP PB	∅ 22.5
			38	TEMP. CONTROLLER	□ 92*92

FEEDER NO	FEEDER NAME	RATING	SR NO	DESCRIPTION	CUTOUTS
15F	HAMMER CHAMBER CONE HM-01	-	39	15F-START ILPB(GREEN)-1	∅ 22.5
			40	15F-START ILPB(GREEN)-2	∅ 22.5
			41	15F-START ILPB(GREEN)-3	∅ 22.5
			42	15F-START ILPB(GREEN)-4	∅ 22.5
6F	SPARE-01 SP-01	S/D 11kW	43	6F-TRIP IND. (AMBER)	∅ 22.5
			44	6F-START ILPB(GREEN)	∅ 22.5
			45	6F-EMG STOP PB	∅ 22.5
7F	SCRUBBER PUMP-A PU-02	DOL 3.7kW	46	7F-TRIP IND. (AMBER)	∅ 22.5
			47	7F-START ILPB(GREEN)	∅ 22.5
			48	7F-EMG STOP PB	∅ 22.5
8F	SPARE-02 SP-02	DOL 3.7kW	49	8F-TRIP IND. (AMBER)	∅ 22.5
			50	8F-START ILPB(GREEN)	∅ 22.5
			51	8F-EMG STOP PB	∅ 22.5
9F	BURNER MOTOR BR-01	DOL 1.1kW	52	9F-TRIP IND. (AMBER)	∅ 22.5
			53	9F-START ILPB(GREEN)	∅ 22.5
			54	9F-EMG STOP PB	∅ 22.5
10F	ROTARY VALVE FOR CYCLONE CY-01	DOL 0.75kW	55	10F-TRIP IND. (AMBER)	∅ 22.5
			56	10F-START ILPB(GREEN)	∅ 22.5
			57	10F-EMG STOP PB	∅ 22.5
11F	LUBRICATION OIL PUMP LOP-01	DOL 0.17kW	58	11F-TRIP IND. (AMBER)	∅ 22.5
			59	11F-START ILPB(GREEN)	∅ 22.5
			60	11F-EMG STOP PB	∅ 22.5
12F	CIP WINCH PANEL SUPPLY	-	61	12F-ON IND. (GREEN)	∅ 22.5
13F	LUBRICATION PUMP SUPPLY	-	62	13F-ON IND. (GREEN)	∅ 22.5
14F	HAMMER CHAMBER CONE	-	63	14F-ON IND. (GREEN)	∅ 22.5
15F	HAMMER CHAMBER CONE HM-01	-	64	15F-START PULSE PUSH BUTTON	∅ 22.5
			65	15F-LOC/REM SSW	∅ 10
			66	15F-MAN/AUTO SSW	∅ 10
			67	15F-START ILPB(GREEN)-5	∅ 22.5
			68	15F-START ILPB(GREEN)-6	∅ 22.5
			69	15F-START ILPB(GREEN)-7	∅ 22.5
			70	15F-START ILPB(GREEN)-8	∅ 22.5
			71	HOOTER ACKNOWLEDGEMENT	∅ 22.5
			72	EMERGENCY PUSH BUTTON	∅ 22.5
			73	DUMMY	∅ 22.5
			74	230VAC UPS SUPPLY ON IND. (GREEN)	∅ 22.5
			75	24VDC SMPS-1 SUPPLY ON IND. (GREEN)	∅ 22.5
			76	24VDC SMPS-2 SUPPLY ON IND. (GREEN)	∅ 22.5
			77	HOOTER	□ 92*92

INCOMING 3PH, 4WIRE,
415V, 50Hz, AC SUPPLY

R/Y/B/N
1RX25X10 SQ.MM
AL BUSBAR

MCB-1-3
1P,2A

R-L1 Y-L2 B-L3

INC MCCB
3P,200A,50KA
LV525452
SCHNEIDER

MCB-4
3P,6A

R/Y/B/N
1RX25X10 SQ.MM
AL BUSBAR

VSS
V
(0-500V)

CT 1,2,3
200/1.5VA
CL 1.0
RESIN CAST 15VA

MFM
ASS
A
(0-200A)

MAKE OF COMPONENTS		
1	MCCB/MPCB/MCB	SCHNEIDER
2	POWER CONTACTOR	SCHNEIDER
3	ILPB/PUSH BUTTON/INDICATION LAMP	TEKNIC
4	MULTIFUNCTION METER	SCHNEIDER
5	AMMETER/VOLTMETER(DIGITAL TYPE)	RISHEINE NX
6	SELECTOR SWITCH	SALZER
7	CURRENT TRANSFORMER	SAHARA
8	POWER/CONTROL CABLE	POLYCAB
9	BUSBAR ASSEMBLY	ALUMINIUM

AL BUSBAR
R/Y/B 1RX25X10 MM
NEUTRAL 1RX20X10 MM

FA 3PH,4 WIRE,415 VAC,50Hz POWER SUPPLY 1F 2F 3F 4F

3PH / 11.1

CABLE SIZE					
MCB	MCB-5 2P,16A	1F-MCCB 3P,100 AMP	2F-MCB 3P,16 AMP	3F-MCB 3P,6 AMP	4F-MCCB /23.0 3P, 50AMP
FUSES		11F-FUSE 63A FUSE BASE 50A FUSE LINK	2F-FUSE 32A FUSE BASE 10A FUSE LINK	2F-FUSE 32A FUSE BASE 10A FUSE LINK	4F-C1 32A 4F-C2 32A 4F-C3 12A
CONTROL TFR /VFD	CONTROL TRANSFORMER 1.5KVA, 415/230VAC	1F-VFD 18.5KW ABB	2F-VFD 3.7KW ABB	3F-VFD 1.5KW ABB	R/Y/B 4 SQ.MM
TERMINAL/OLR	MCB-6 2P,16A				4F-OLR 6.4-32A (CLASS-30)
MOTOR RATING IN KW	DBK-01 230VAC R/N	16 SQ.MM	10 SQ.MM	6 SQ.MM	10 SQ.MM
MOTOR RATING IN HP		18.5	3.7	1.5	11
TYPE OF STARTER		25HP	5HP	2HP	15HP
DESCRIPTION	230VAC CONTOL SUPPLY	VFD FEEDER	VFD FEEDER	VFD FEEDER	S/D STARTER
TAG NO		MAIN ID BLOWER BL-02	ATOMIZER ATM-01	FEED PUMP-A PU-01	FD BLOWER BL-01

MOJJ ENGINEERING SYSTEMS LTD


REVISION	DETAILS	DATE			
02	AS BUILT		TITLE:- SINGLE LINE DIAGRAM		PROJECT:- SPRAY DRYER
			FILE NO: MES / E&I / MSD-705		
01	AS PER COMMENTS	12-05-2025	DRAWN BY	N.A.	PROJECT:- MSD-705
00	FOR APPROVAL	08-05-2025	CHECKED	P.B.	
			APPROVED	MESL	DRG. NO.:- 2526/PRG/MSD/705

SHEET NO. 12 / 62

REV.NO. AS BUILT

0	1	2	3	4	5	6	7	8	9

MAKE OF COMPONENTS		
1	MCCB/MPCB/MCB	SCHNEIDER
2	POWER CONTACTOR	SCHNEIDER
3	ILPB/PUSH BUTTON/INDICATION LAMP	TEKNIC
4	MULTIFUNCTION METER	SCHNEIDER
5	AMMETER/VOLTMETER(DIGITAL TYPE)	RISHEINE NX
6	SELECTOR SWITCH	SALZER
7	CURRENT TRANSFORMER	SAHARA
8	POWER/CONTROL CABLE	POLYCAB
9	BUSBAR ASSEMBLY	ALUMINIUM

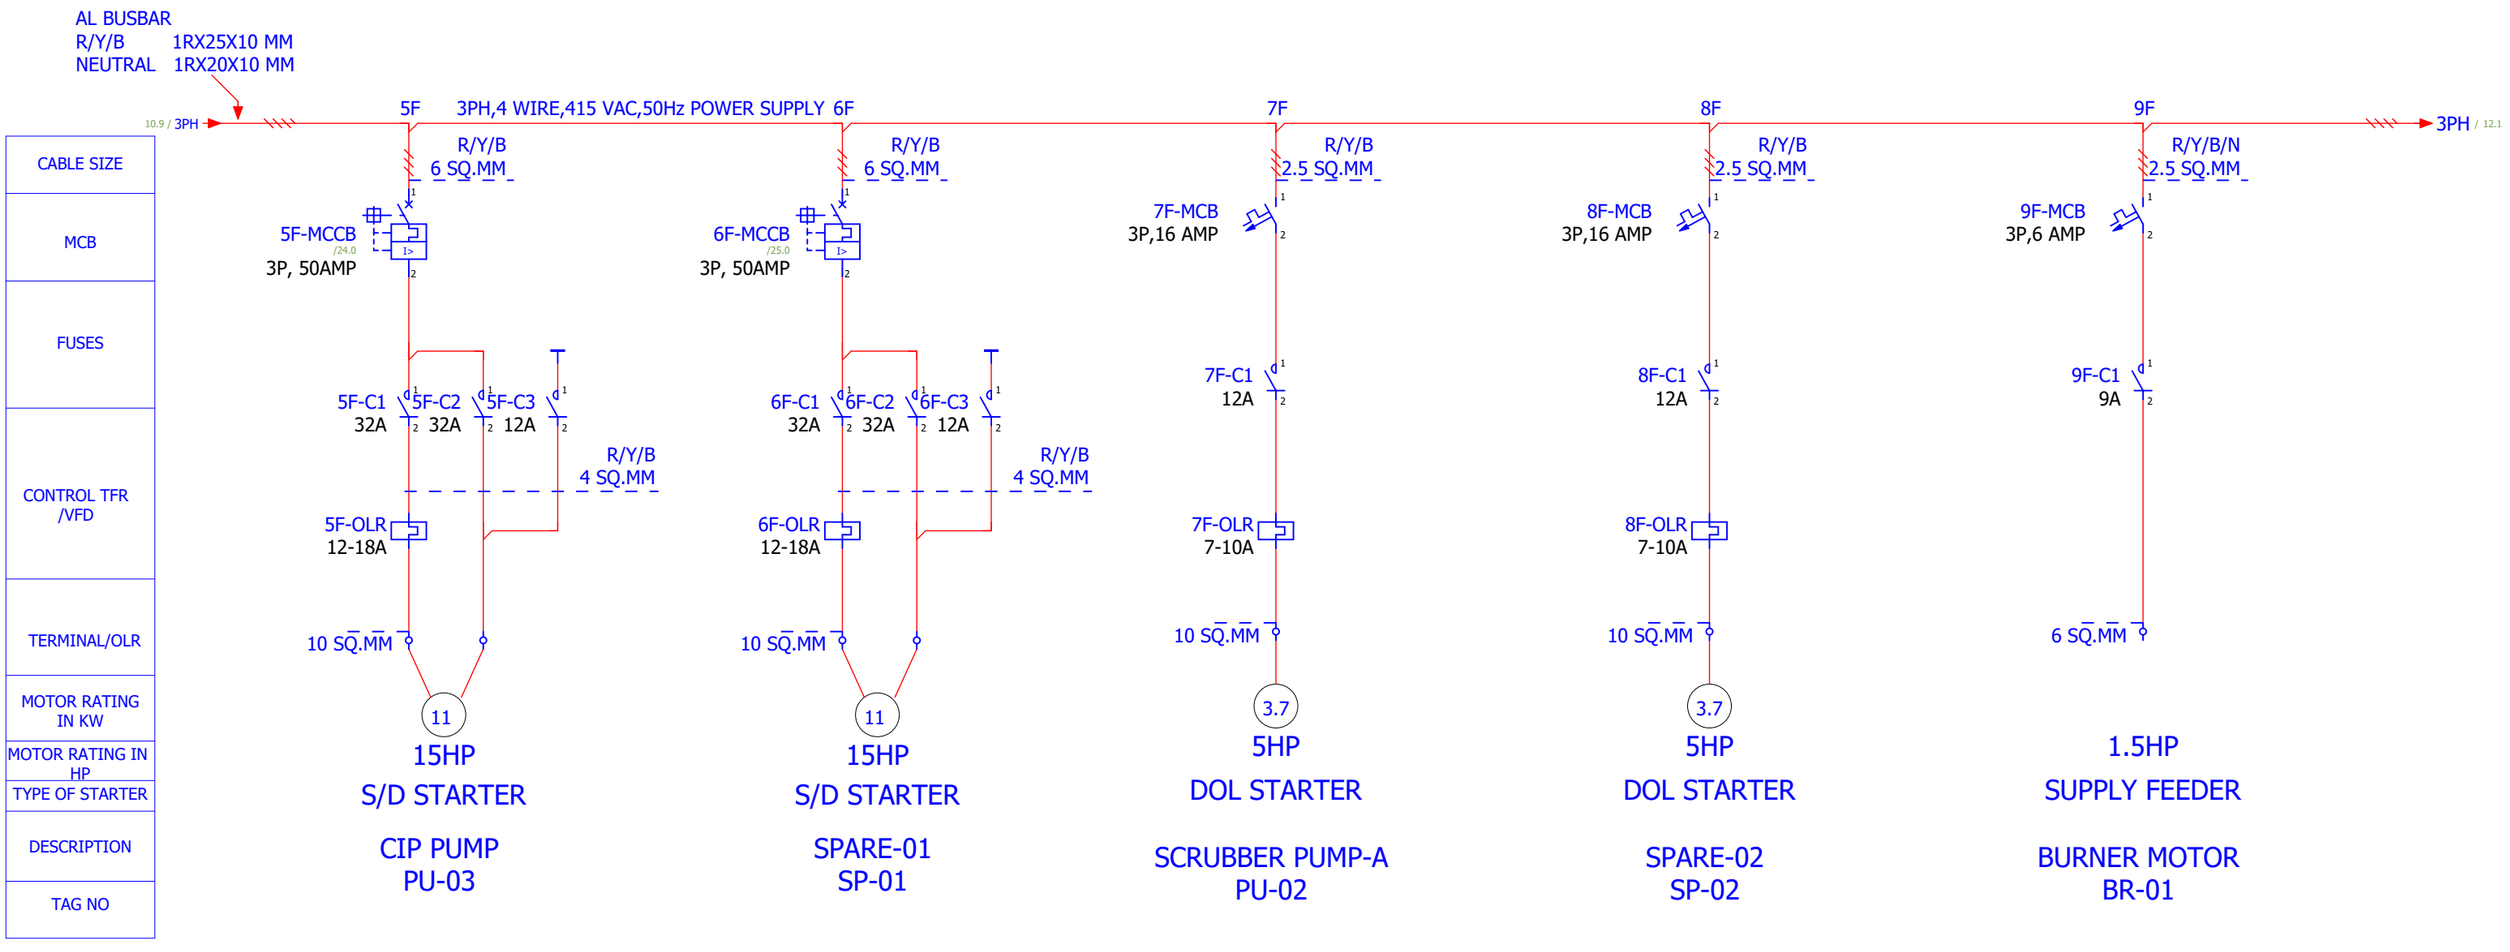

MOJJ ENGINEERING SYSTEMS LTD

REVISION	DETAILS	DATE			
02	AS BUILT		TITLE:- SINGLE LINE DIAGRAM		
01	AS PER COMMENTS	12-05-2025	FILE NO: MES / E&I / MSD-705		
00	FOR APPROVAL	08-05-2025	DRAWN BY	N.A.	
			CHECKED	P.B.	
			APPROVED	MESL	


PROJECT:- SPRAY DRYER

PROJECT:- MSD-705

DRG. NO.:- 2526/PRG/MSD/705 | SHEET NO. 13 / 62 | REV.NO. AS BUILT

0	1	2	3	4	5	6	7	8	9

MAKE OF COMPONENTS		
1	MCCB/MPCB/MCB	SCHNEIDER
2	POWER CONTACTOR	SCHNEIDER
3	ILPB/PUSH BUTTON/INDICATION LAMP	TEKNIC
4	MULTIFUNCTION METER	SCHNEIDER
5	AMMETER/VOLTMETER(DIGITAL TYPE)	RISHEINE NX
6	SELECTOR SWITCH	SALZER
7	CURRENT TRANSFORMER	SAHARA
8	POWER/CONTROL CABLE	POLYCAB
9	BUSBAR ASSEMBLY	ALUMINIUM

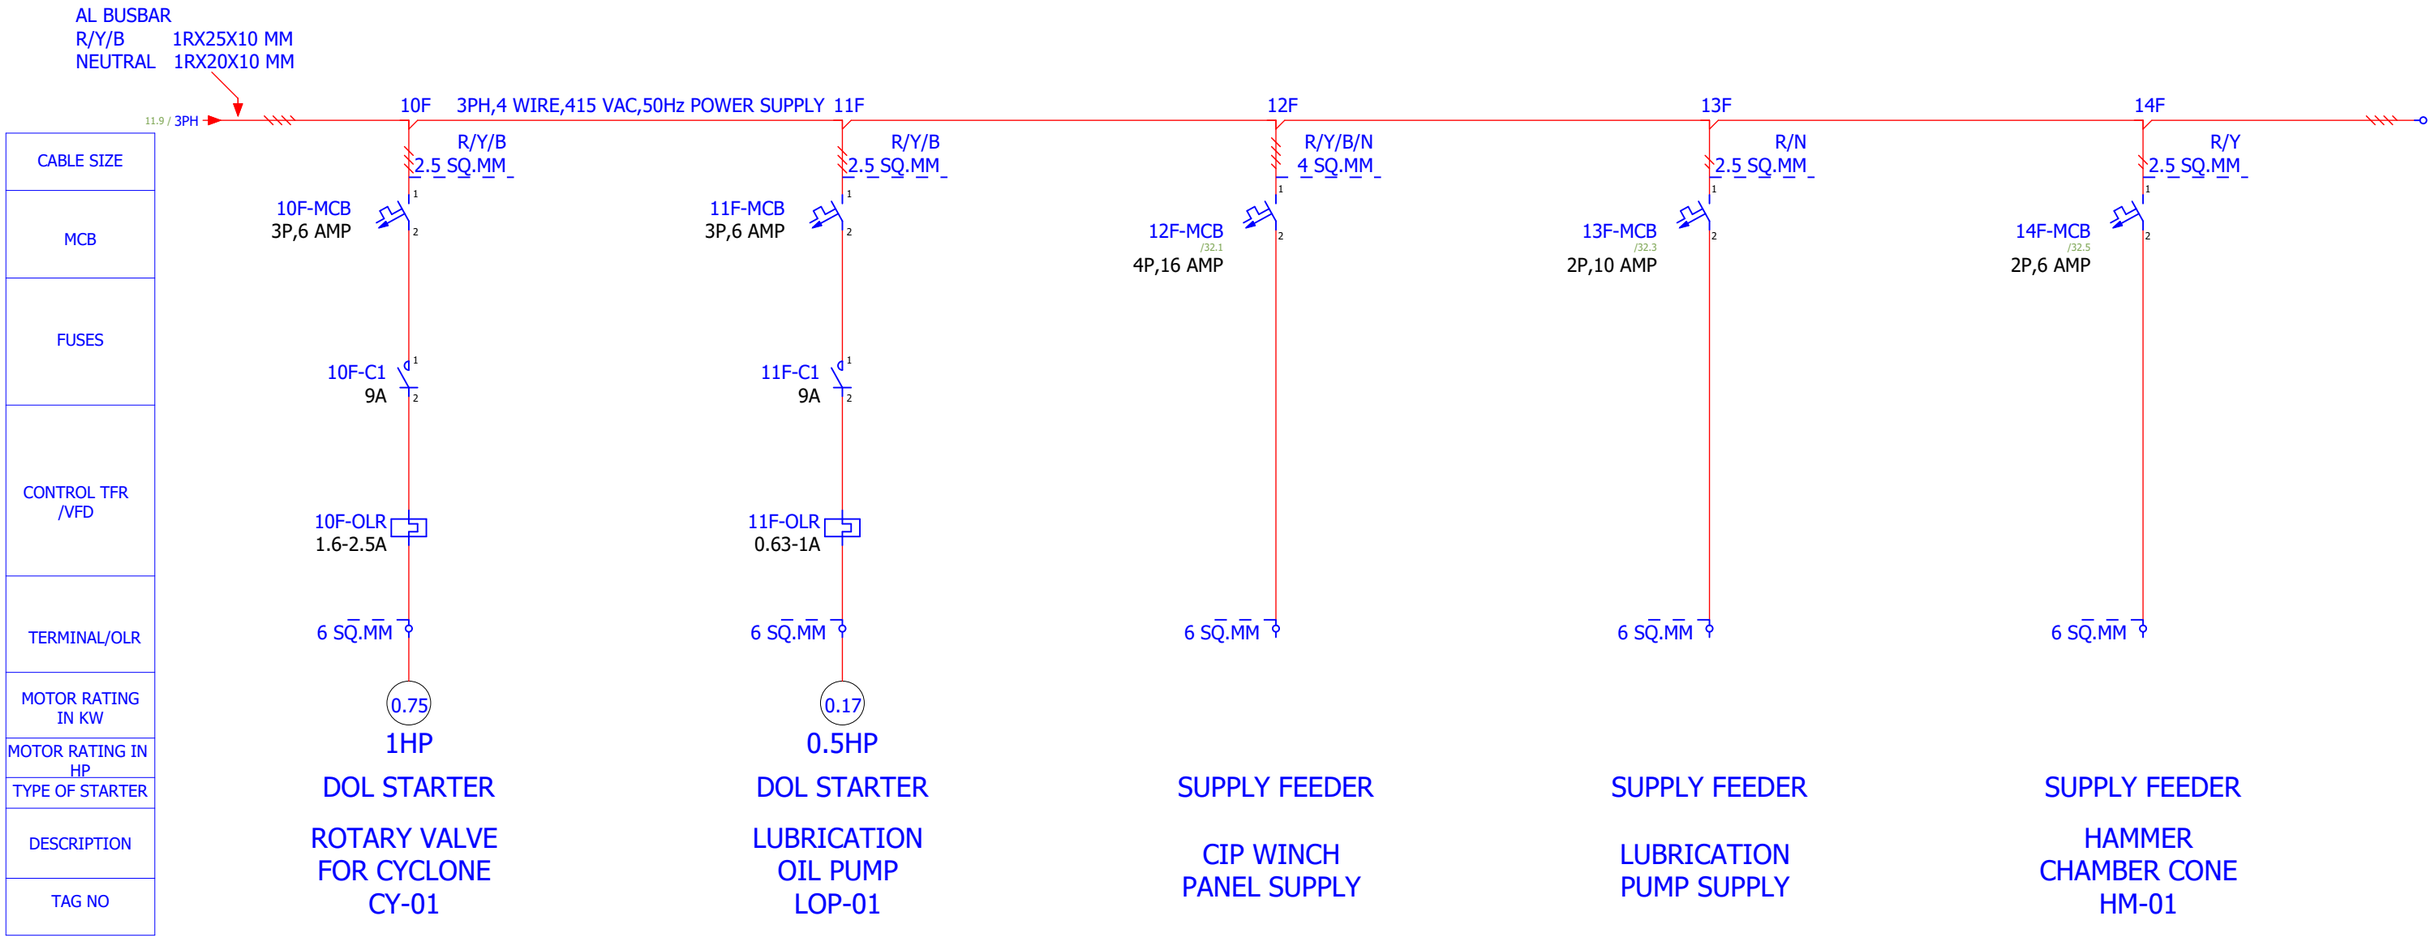

MOJJ ENGINEERING SYSTEMS LTD

REVISION	DETAILS	DATE			
			TITLE:- SINGLE LINE DIAGRAM		
02	AS BUILT		FILE NO: MES / E&I / MSD-705		
01	AS PER COMMENTS	12-05-2025	DRAWN BY	N.A.	
00	FOR APPROVAL	08-05-2025	CHECKED	P.B.	
			APPROVED	MESL	

PROJECT:- SPRAY DRYER		
PROJECT:- MSD-705		
DRG. NO.:- 2526/PRG/MSD/705	SHEET NO. 14 / 62	REV.NO. AS BUILT

0 | 1 | 2 | 3 | 4 | 5 | 6 | 7 | 8 | 9

ELECTRICAL WIRING DIAGRAM

MOJJ ENGINEERING SYSTEMS LTD

REVISION	DETAILS	DATE
02	AS BUILT	
01	AS PER COMMENTS	12-05-2025
00	FOR APPROVAL	08-05-2025

TITLE:- COVER PAGE			
FILE NO:	MES / E&I / MSD-705		
DRAWN BY	N.A.		
CHECKED	P.B.		
APPROVED	MESL		

PROJECT:-	SPRAY DRYER	
PROJECT:-	MSD-705	
DRG. NO.:- 2526/PRG/MSD/705	SHEET NO. 15 / 62	REV.NO. AS BUILT

3 PH 415V,50Hz AC SUPPLY

R
Y
B
N

INC MCCB
3P,200A, 50kA
LV525452
SCHNEIDER

NL

R0 / 15
Y0 / 15.0
B0 / 15.0
N0 / 15.0

CAUTION
Remains energized when main switch is opened

MCB-1
1P, 2A
/57.50
R0-RL1
R-L1
RED

MCB-2
1P, 2A
Y0-YL2
Y-L2
YELLOW

MCB-3
1P, 2A
B0-BL3
B-L3
BLUE

NL-1
NL1

R
N

R 16.0
N 16.0

TO FAN & TUBELIGHT SUPPLY

AL BUSBAR
1R*25*10 MM
R/Y/B
1R*25*05
NEUTRAL

R Y B N

INCOMER POWER
415V, 3PH, 200A
FROM CUSTOMERS

PHASE FAILURE F/B TO PLC


RL1
R-PHASE
R-1
RL2
Y-PHASE
R-2
RL3
B-PHASE
1L2-2
1L2-2 / 37.9
I0:2/3
I0:2/3 / 43.5

MOJJ ENGINEERING SYSTEMS LTD


REVISION	DETAILS	DATE
02	AS BUILT	
01	AS PER COMMENTS	12-05-2025
00	FOR APPROVAL	08-05-2025


TITLE:- INCOMER WIRING
FILE NO: MES / E&I / MSD-705
DRAWN BY N.A.
CHECKED P.B.
APPROVED MESL

PROJECT:- SPRAY DRYER
PROJECT:- MSD-705
DRG. NO.:- 2526/PRG/MSD/705
SHEET NO. 16 / 62
REV.NO. AS BUILT

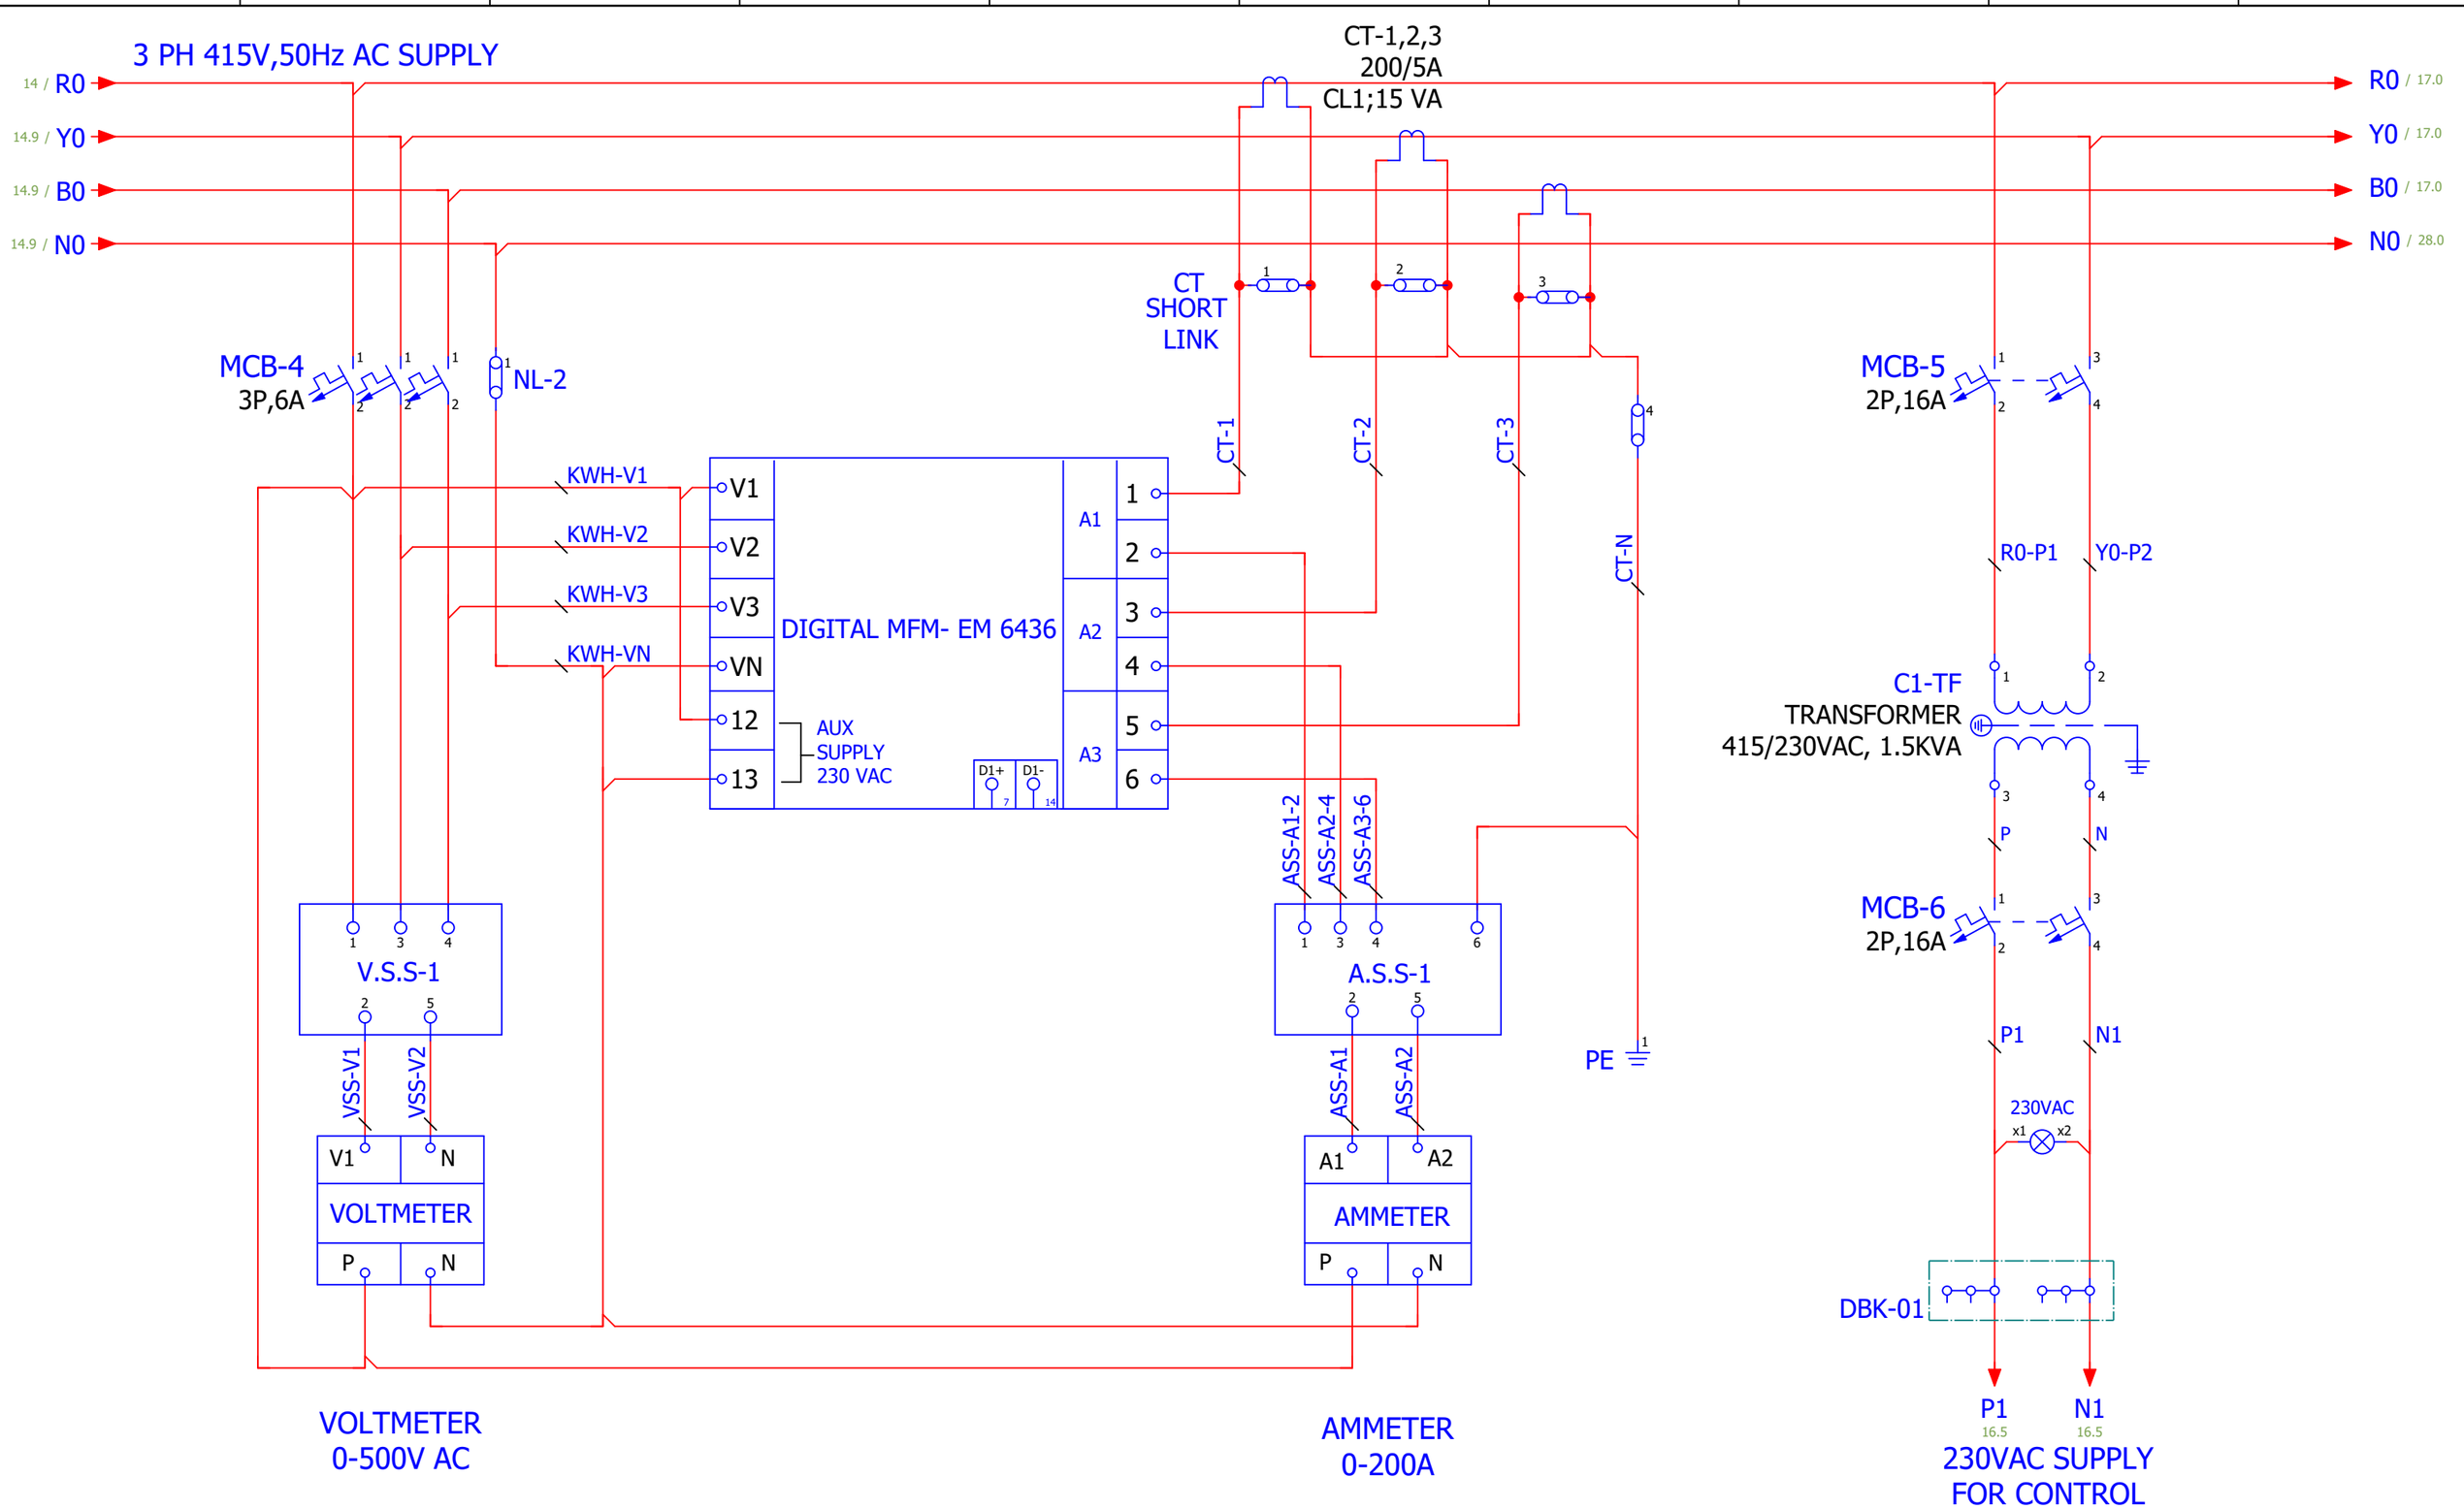

MOJJ ENGINEERING SYSTEMS LTD			TITLE:- INCOMER WIRING		PROJECT:- SPRAY DRYER
02	AS BUILT		FILE NO: MES / E&I / MSD-705		
01	AS PER COMMENTS	12-05-2025	DRAWN BY	N.A.	PROJECT:- MSD-705
00	FOR APPROVAL	08-05-2025	CHECKED	P.B.	DRG. NO.:- 2526/PRG/MSD/705 / SHEET NO. 17 / 62 / REV.NO. AS BUILT
REVISION	DETAILS	DATE	APPROVED	MESL	

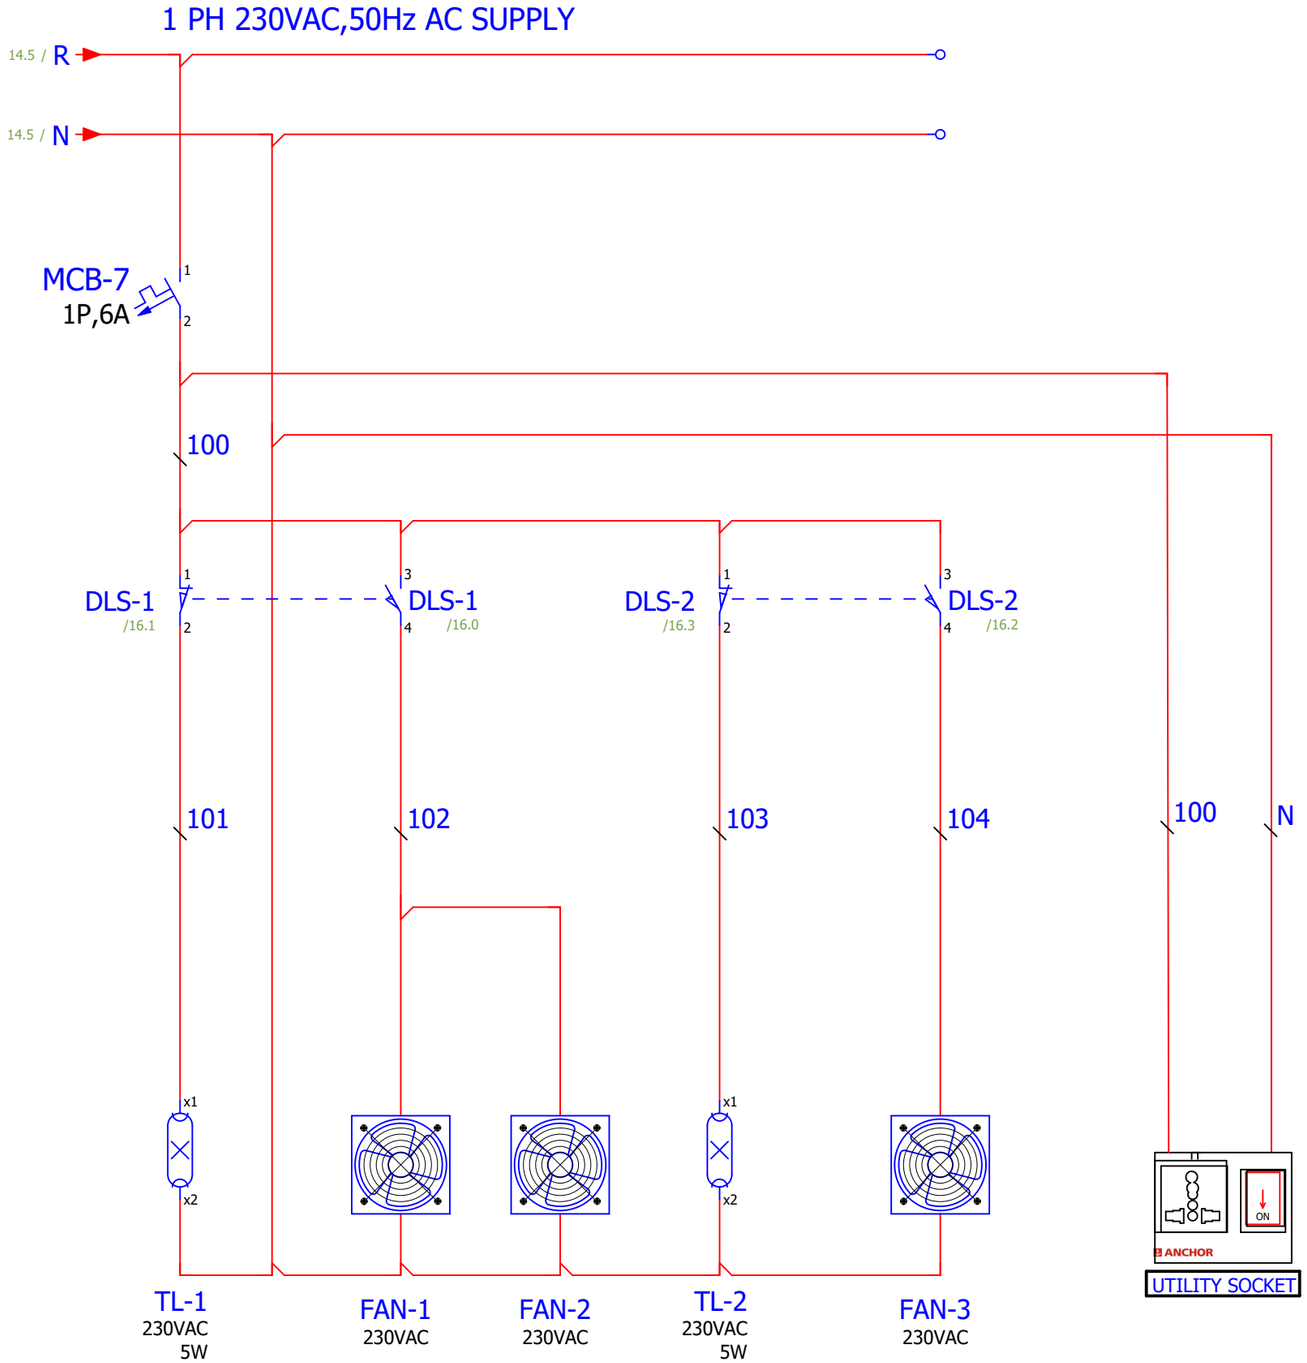

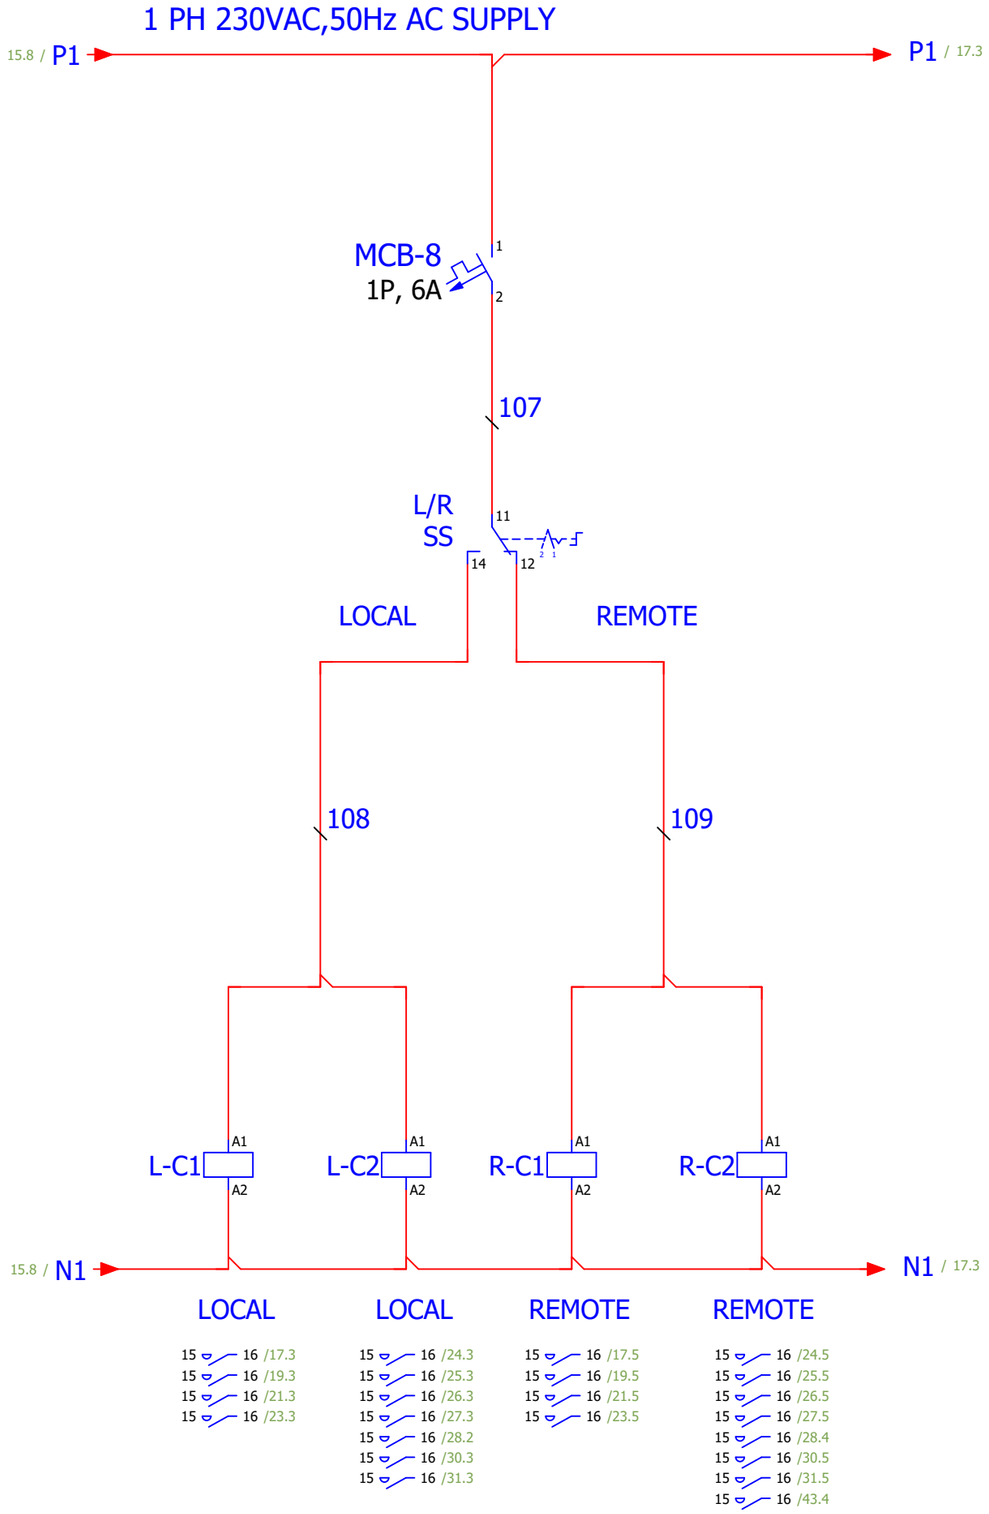


MOJJ ENGINEERING SYSTEMS LTD

REVISION	DETAILS	DATE			
02	AS BUILT		TITLE:- CONTROL WIRING		
01	AS PER COMMENTS	12-05-2025	FILE NO: MES / E&I / MSD-705		
00	FOR APPROVAL	08-05-2025	DRAWN BY	N.A.	
			CHECKED	P.B.	
			APPROVED	MESL	


PROJECT:- SPRAY DRYER

PROJECT:- MSD-705

DRG. NO.:- 2526/PRG/MSD/705 | SHEET NO. 18 / 62 | REV.NO. AS BUILT

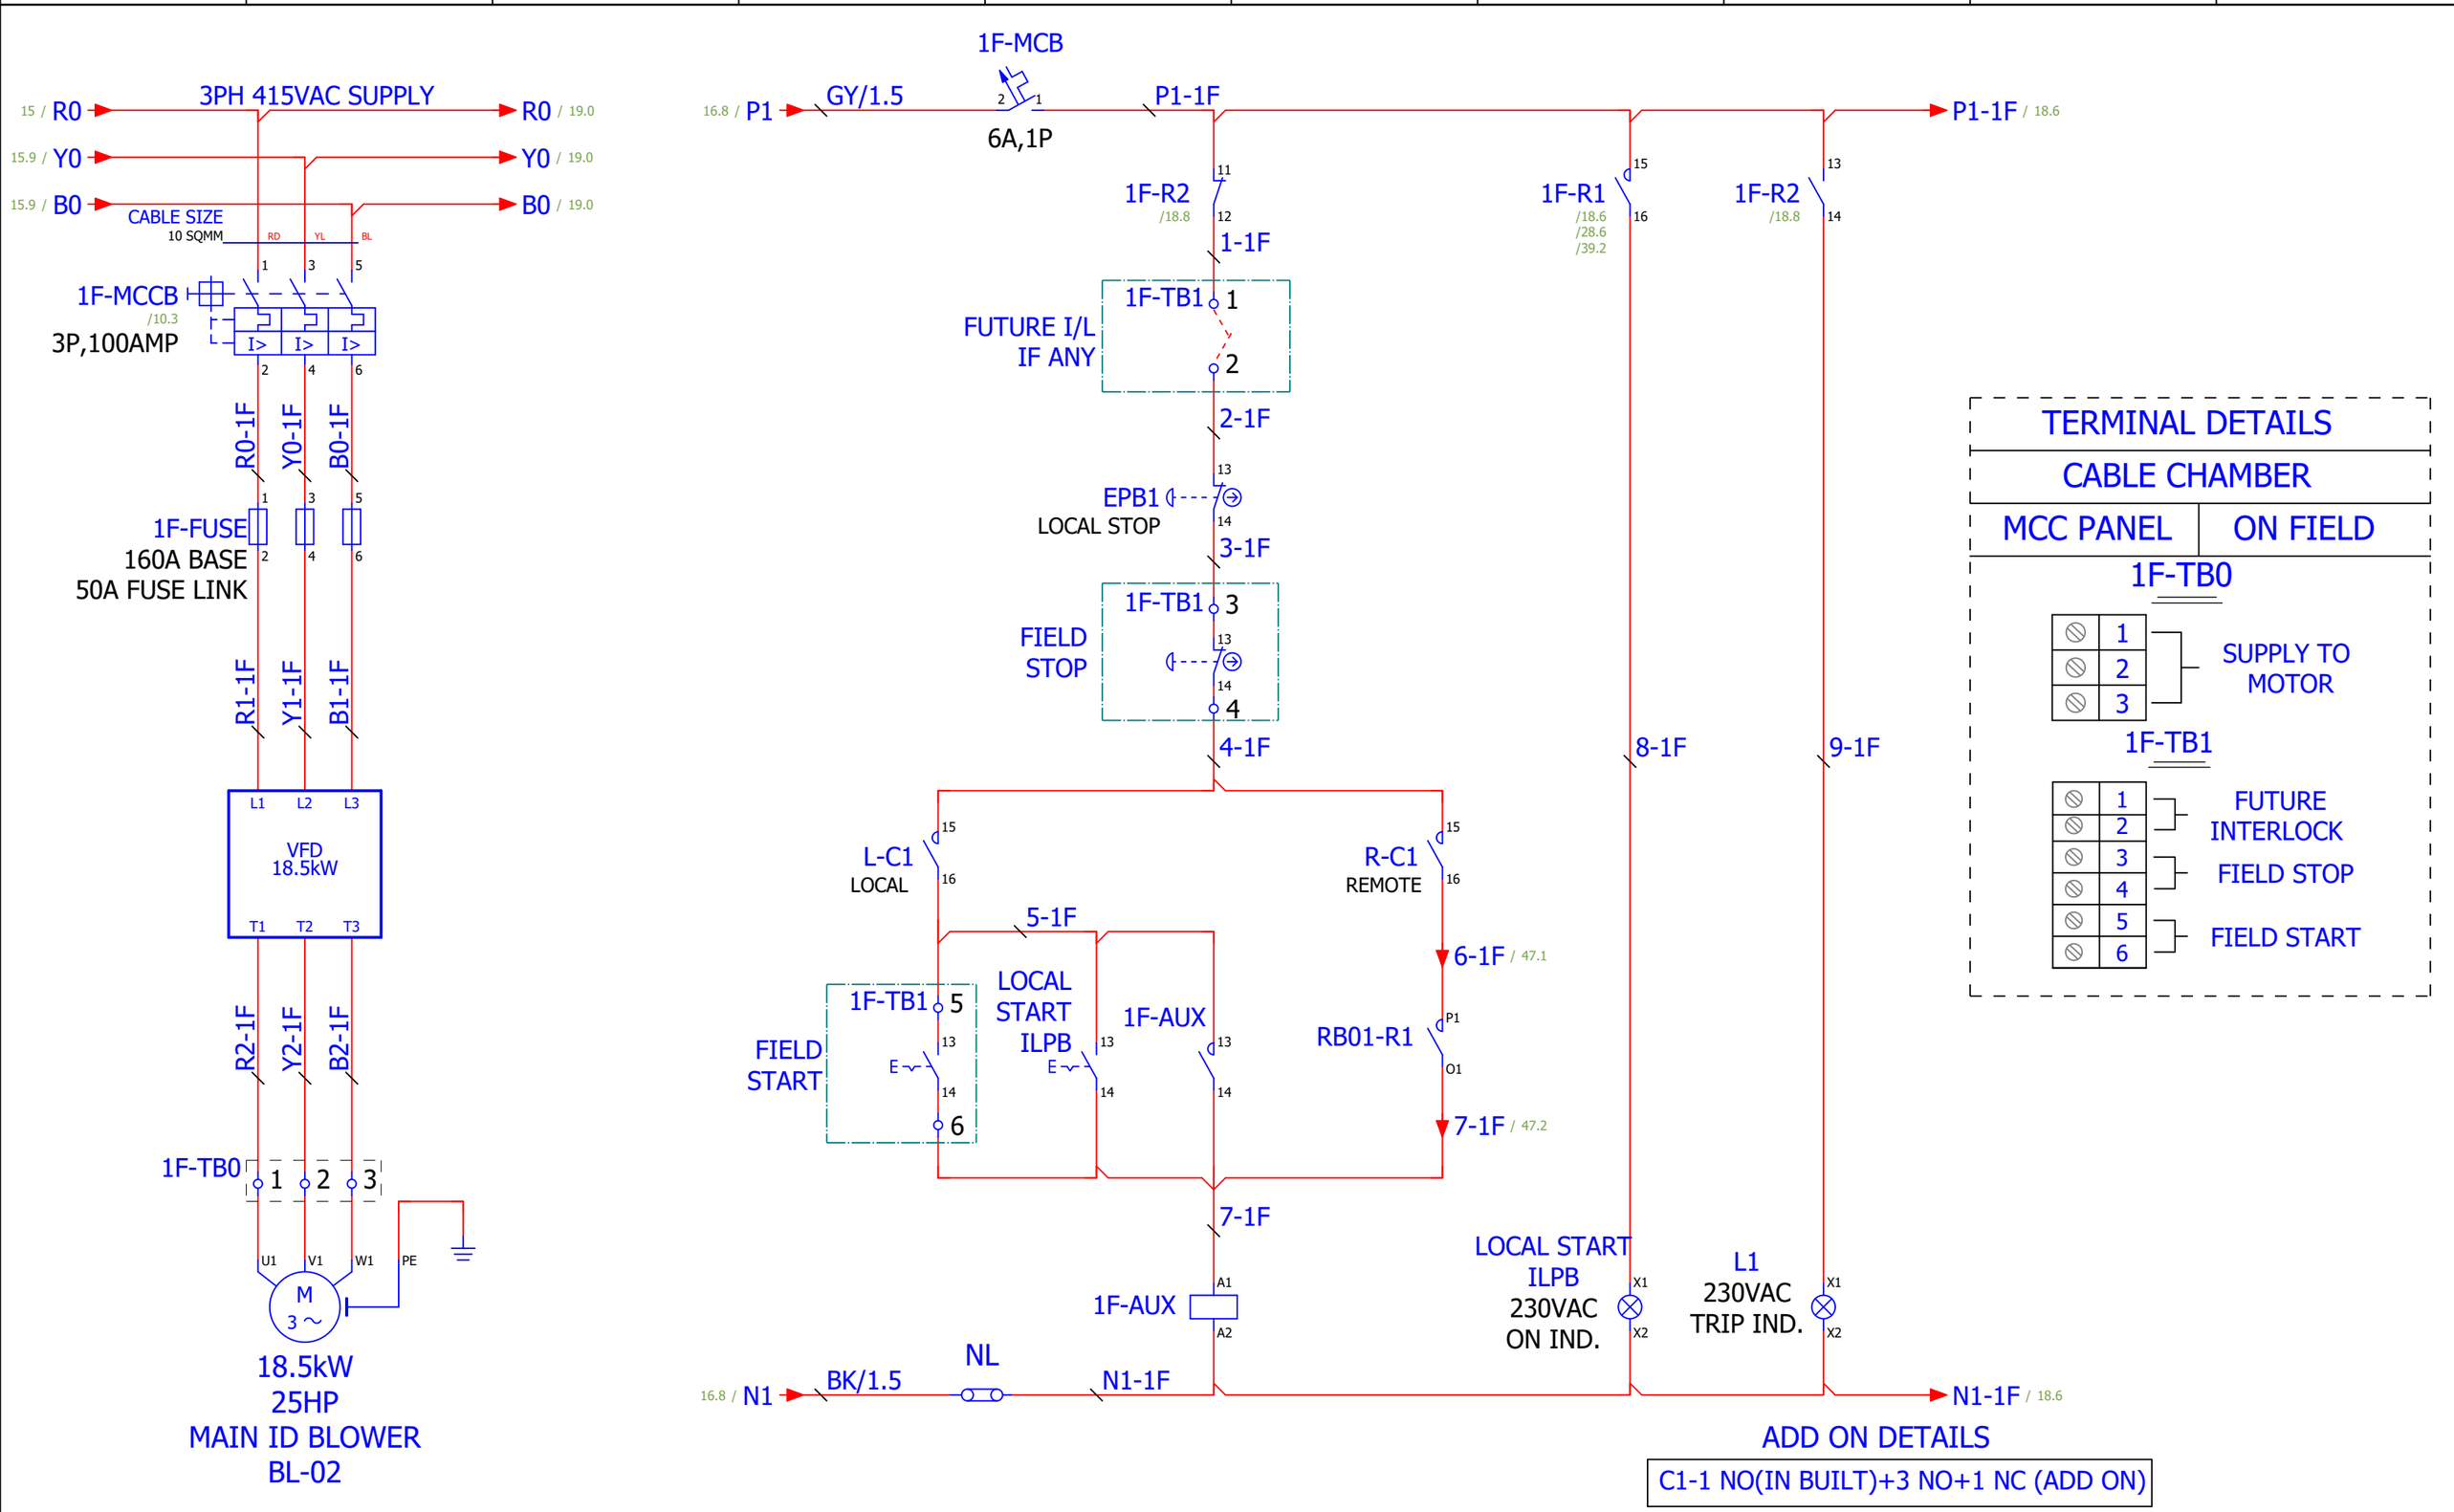


MOJJ ENGINEERING SYSTEMS LTD			TITLE:- 1F-MAIN ID BLOWER POWER & CONTROL WIRING		PROJECT:- SPRAY DRYER
02	AS BUILT		FILE NO: MES / E&I / MSD-705		
01	AS PER COMMENTS	12-05-2025	DRAWN BY	N.A.	PROJECT:- MSD-705
00	FOR APPROVAL	08-05-2025	CHECKED	P.B.	DRG. NO.:- 2526/PRG/MSD/705 / SHEET NO. 19/62 / REV.NO. AS BUILT
REVISION	DETAILS	DATE	APPROVED	MESL	

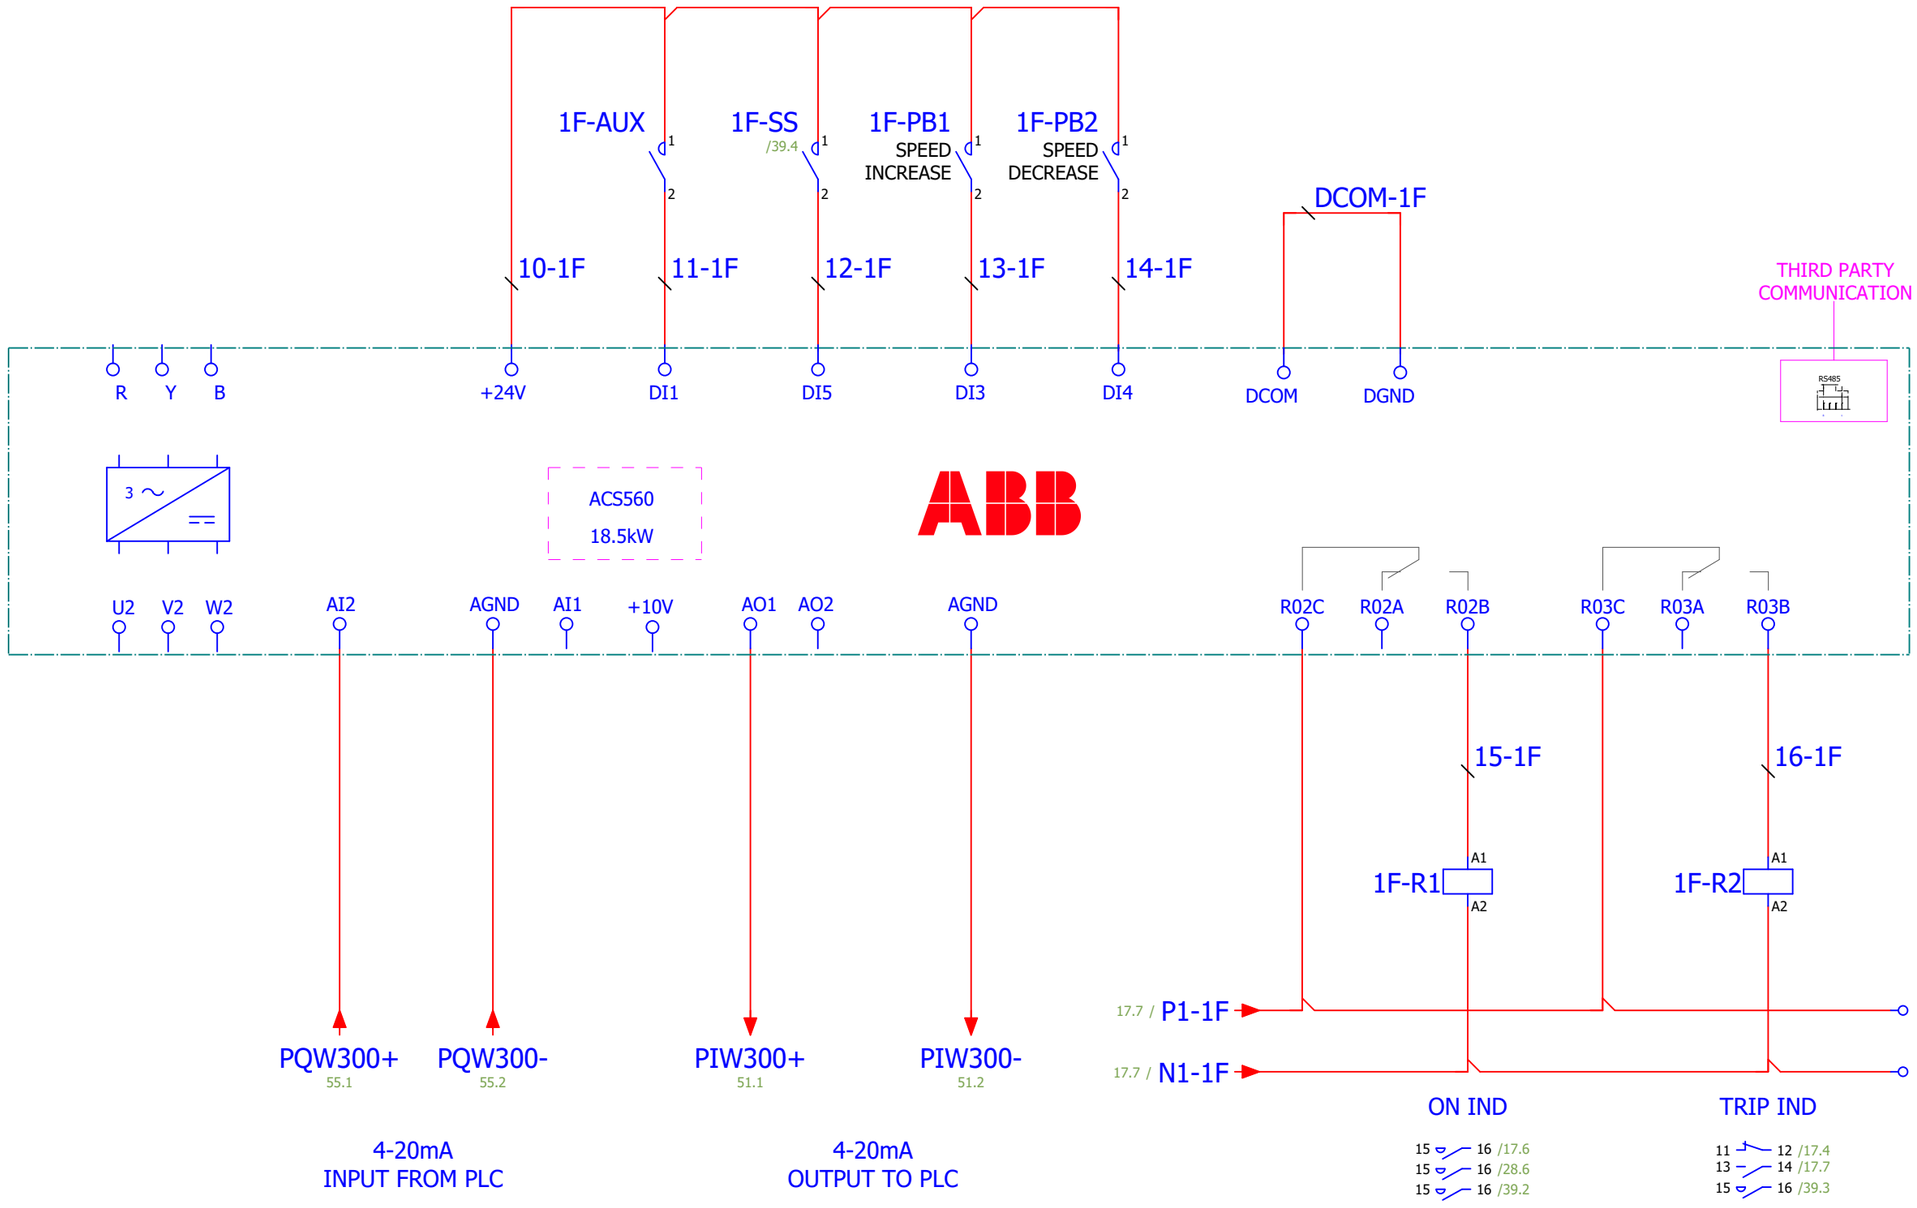

			TITLE:- 1F-MAIN ID BLOWER VFD CONTROL WIRING	PROJECT:- SPRAY DRYER	
02	AS BUILT		FILE NO: MES / E&I / MSD-705		
01	AS PER COMMENTS	12-05-2025	DRAWN BY N.A.	PROJECT:- MSD-705	
00	FOR APPROVAL	08-05-2025	CHECKED P.B.		
REVISION	DETAILS	DATE	APPROVED MESL	DRG. NO.:- 2526/PRG/MSD/705	SHEET NO. 20 / 62
					REV.NO. AS BUILT

MOJJ ENGINEERING SYSTEMS LTD

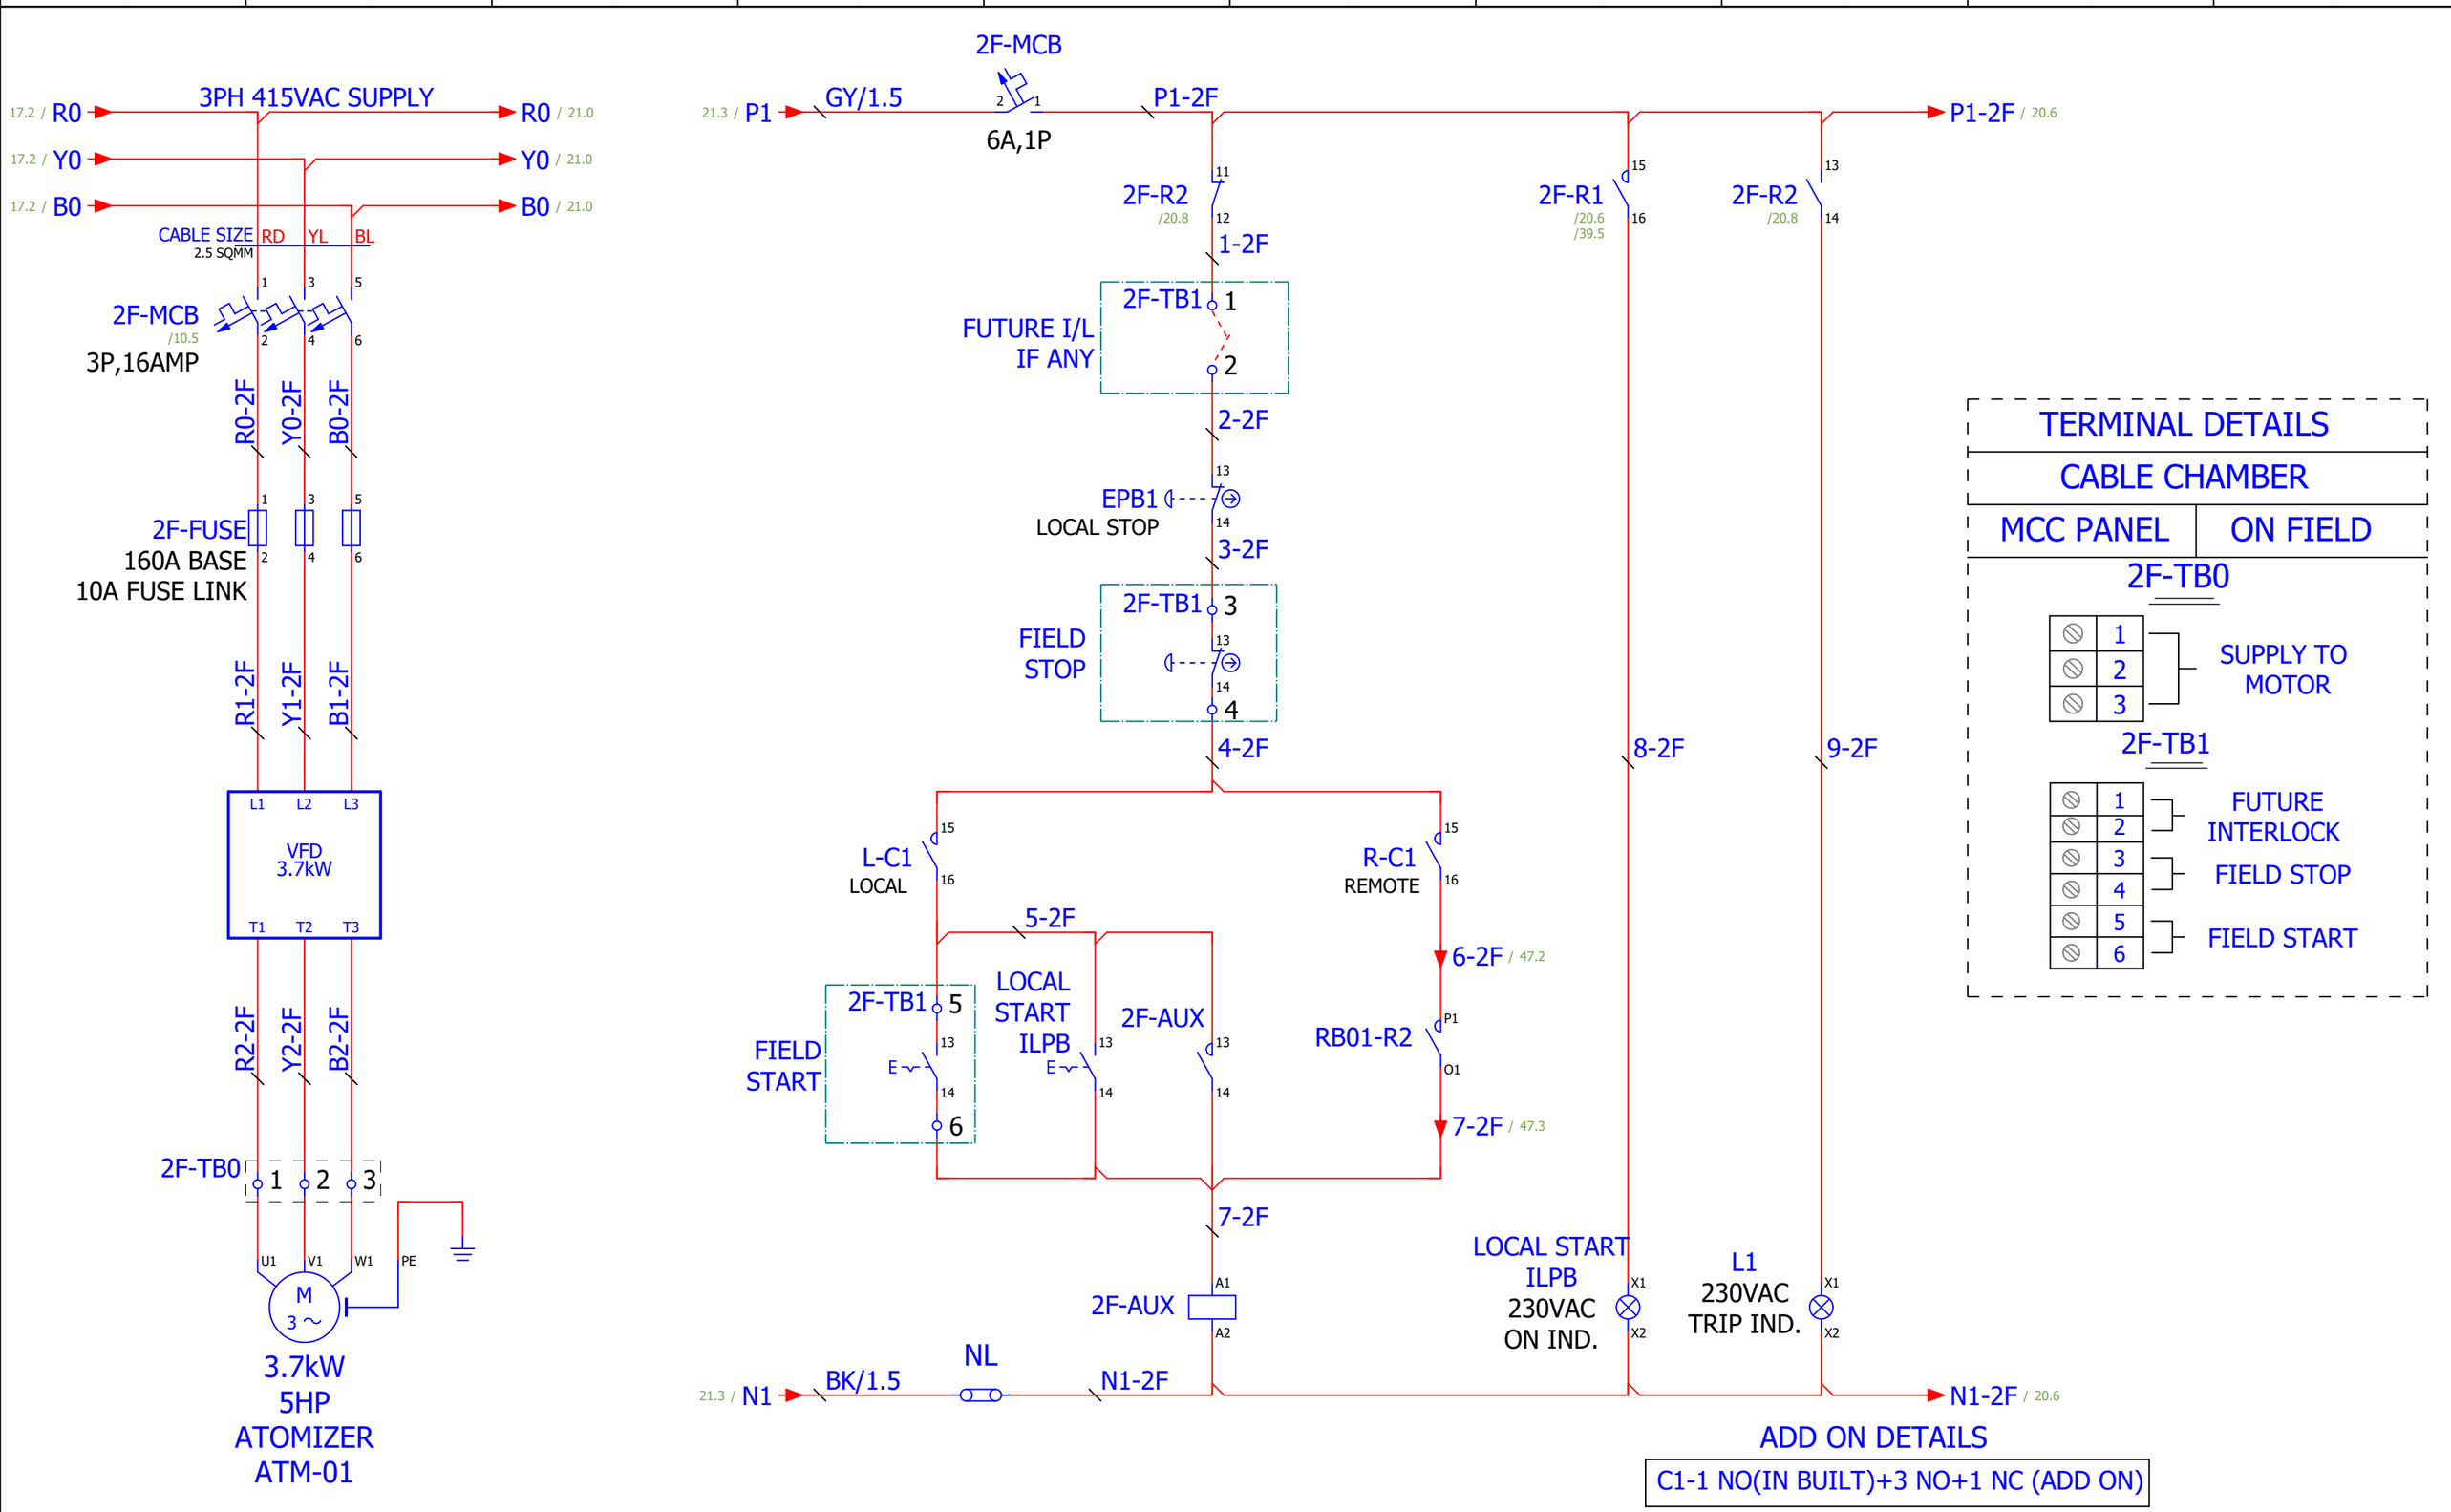


MOJJ ENGINEERING SYSTEMS LTD

REVISION	DETAILS	DATE
02	AS BUILT	
01	AS PER COMMENTS	12-05-2025
00	FOR APPROVAL	08-05-2025


TITLE:- 2F-ATOMIZER POWER & CONTROL WIRING
FILE NO: MES / E&I / MSD-705
DRAWN BY N.A.
CHECKED P.B.
APPROVED MESL

PROJECT:- SPRAY DRYER
PROJECT:- MSD-705
DRG. NO.:- 2526/PRG/MSD/705
SHEET NO. 21 / 62
REV.NO. AS BUILT

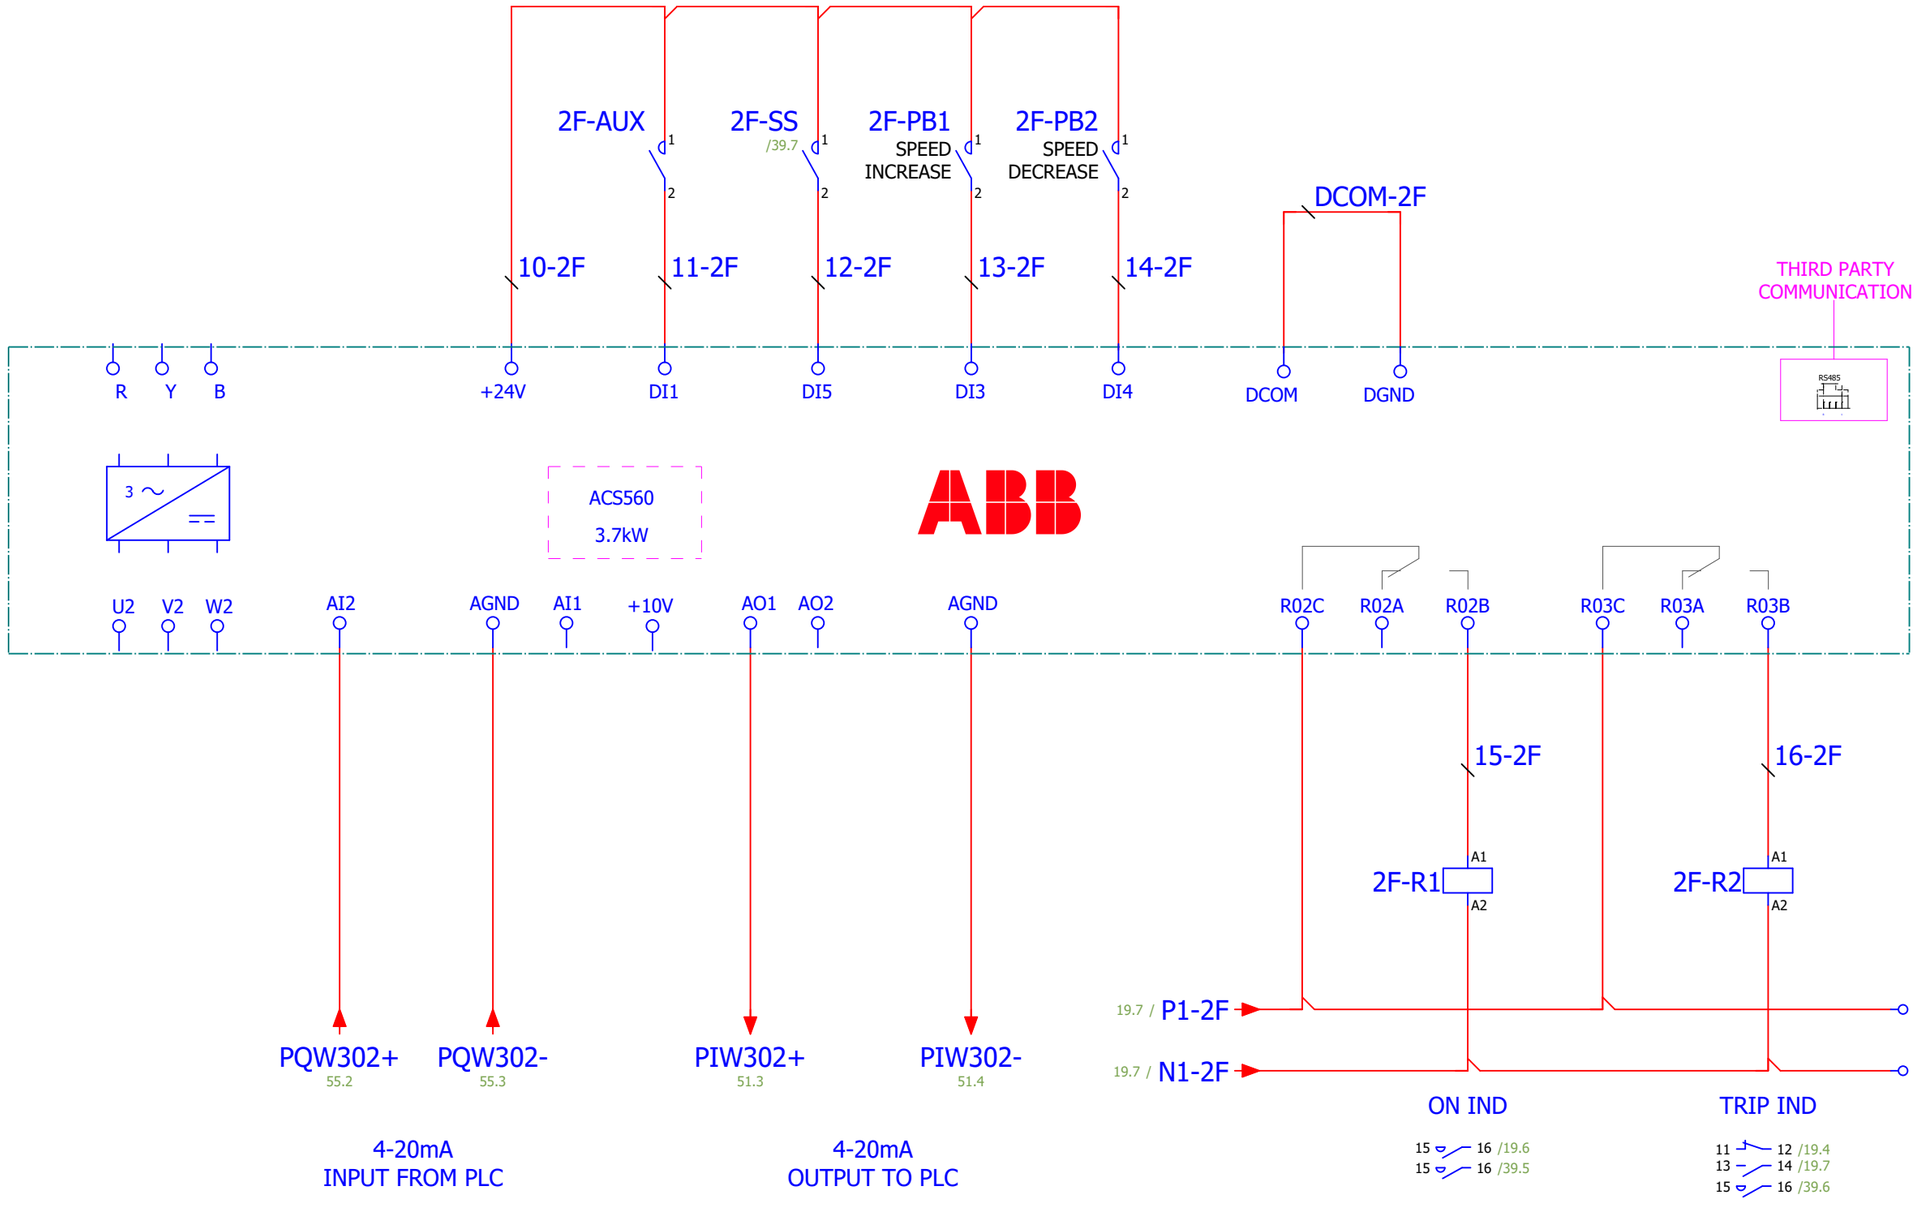


			TITLE:- 2F-ATOMIZER VFD CONTROL WIRING			PROJECT:- SPRAY DRYER	
02	AS BUILT		FILE NO: MES / E&I / MSD-705				
01	AS PER COMMENTS	12-05-2025	DRAWN BY	N.A.		PROJECT:- MSD-705	
00	FOR APPROVAL	08-05-2025	CHECKED	P.B.			
REVISION	DETAILS	DATE	APPROVED	MESL		DRG. NO.:- 2526/PRG/MSD/705	SHEET NO. 22 / 62
							REV.NO. AS BUILT


MOJJ ENGINEERING SYSTEMS LTD

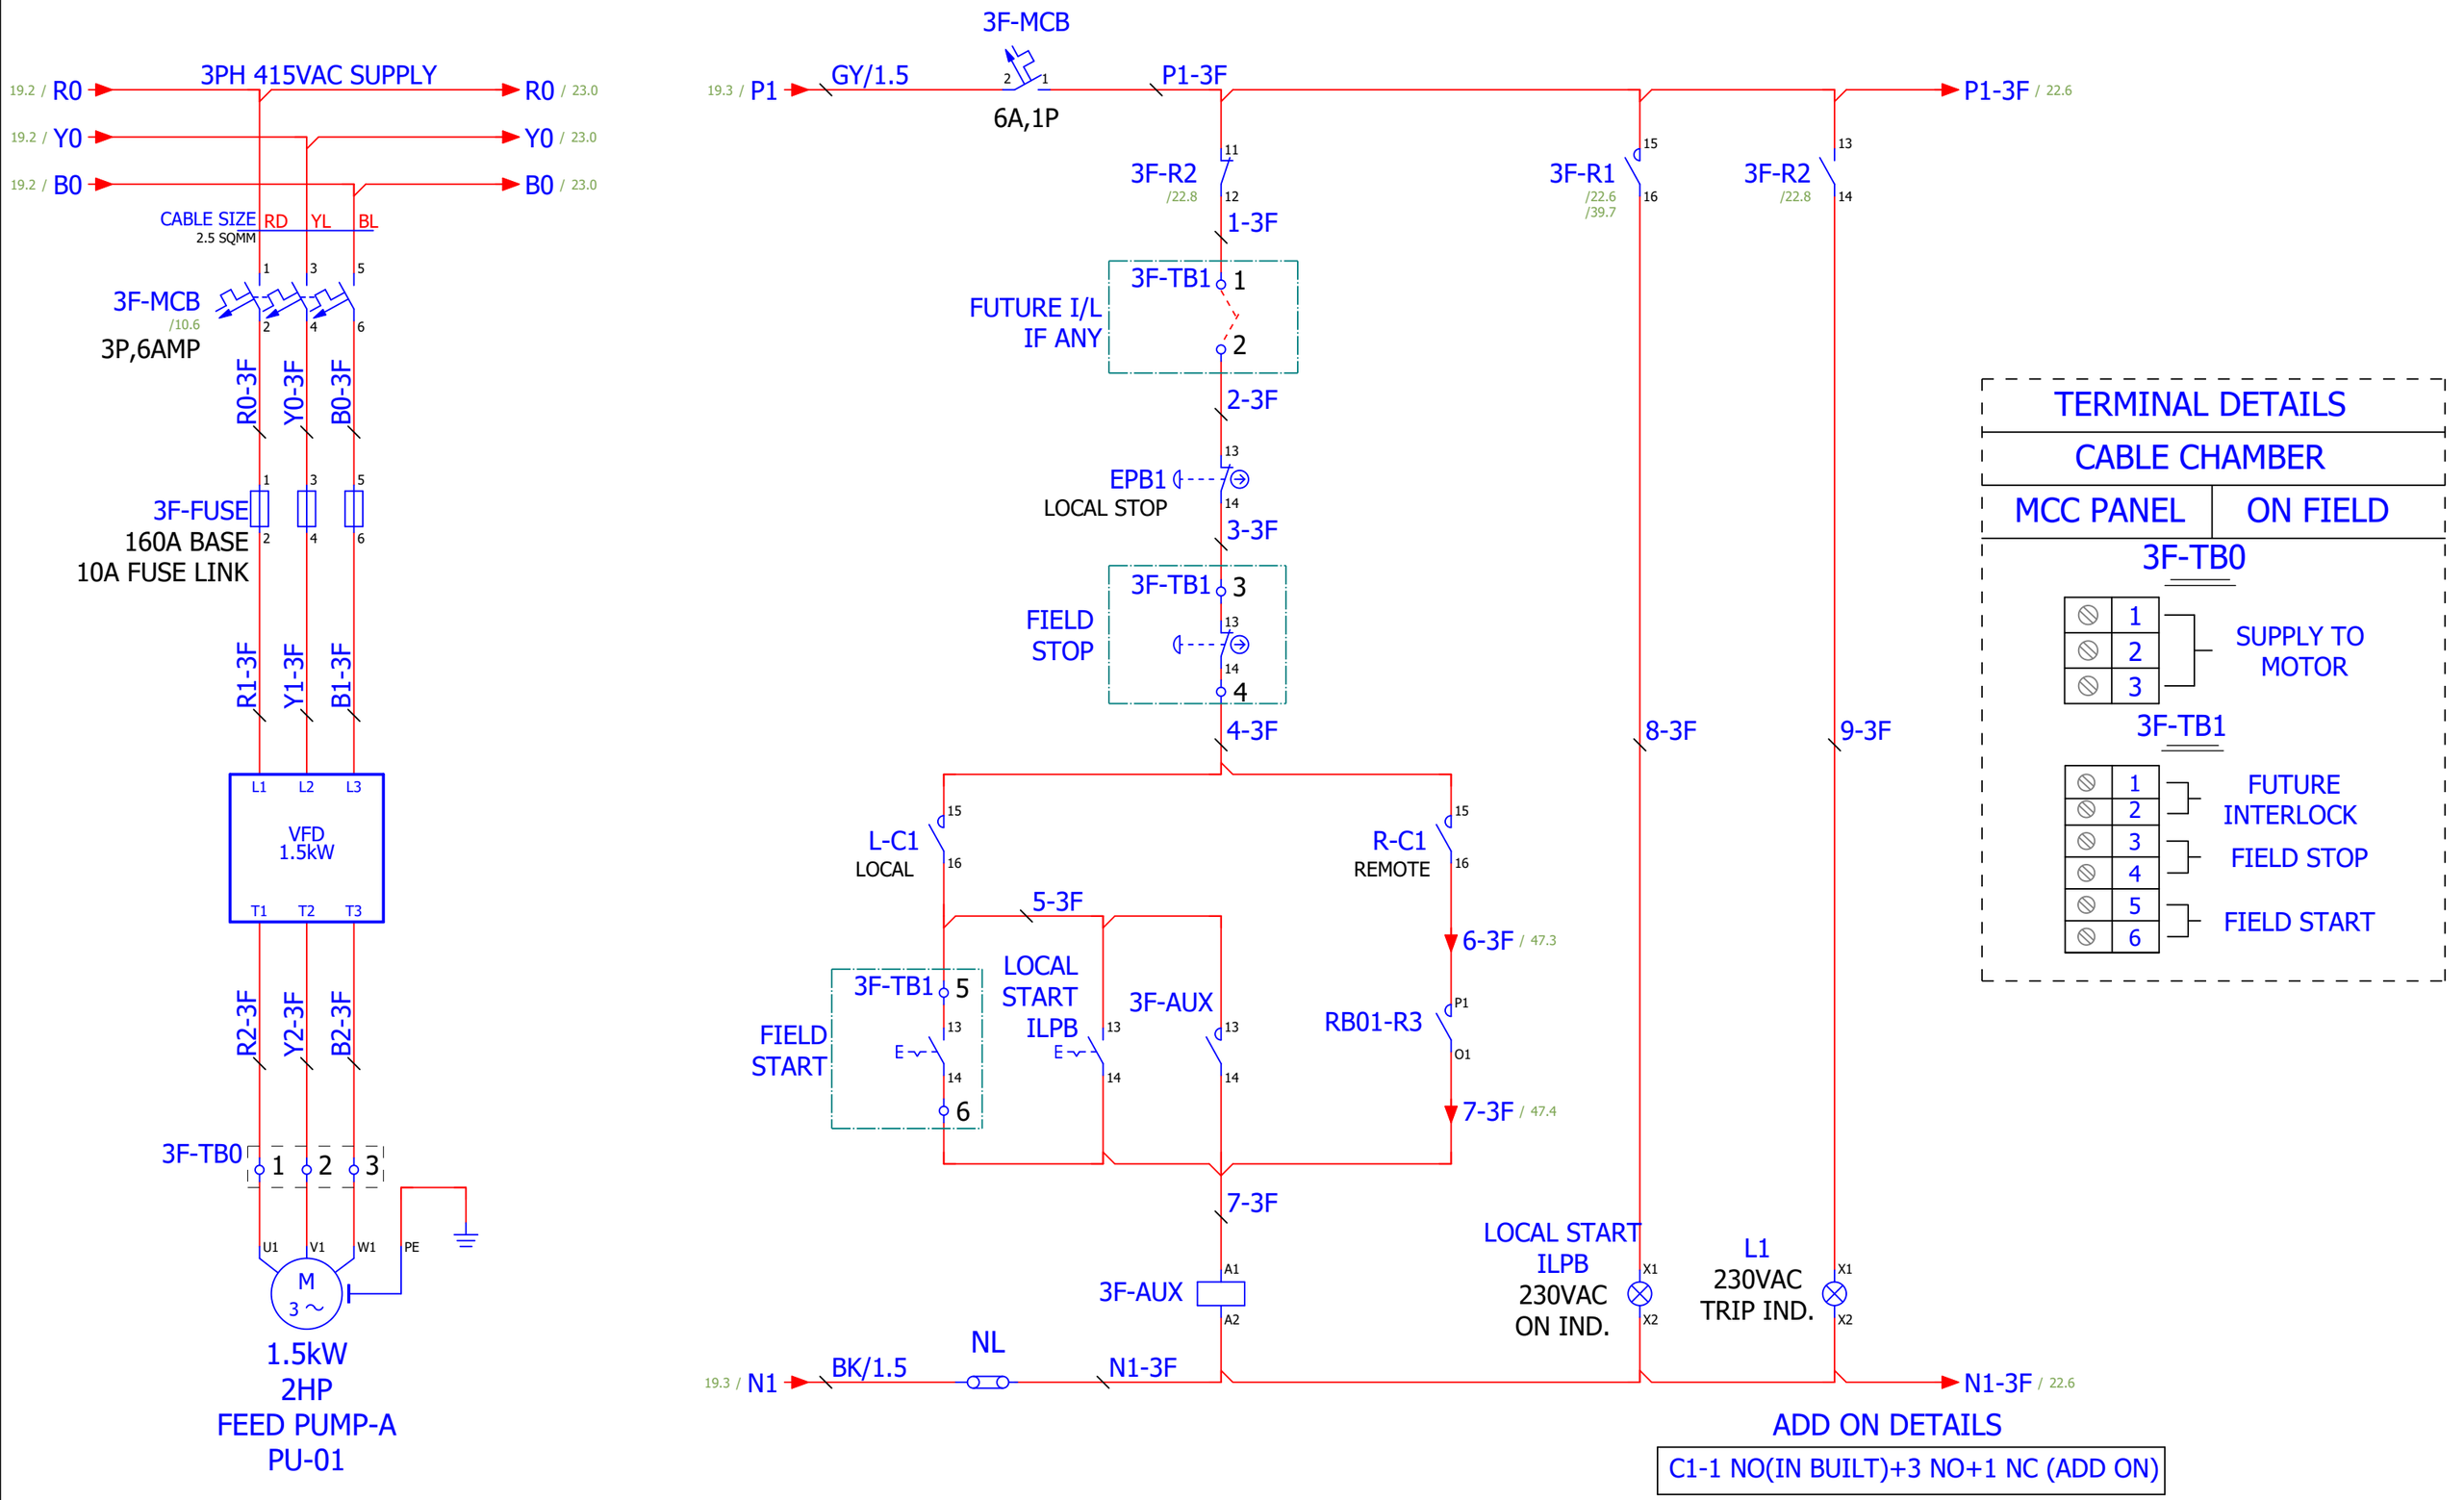

MOJJ ENGINEERING SYSTEMS LTD				TITLE:- 3F-FEED PUMP-A POWER & CONTROL WIRING		PROJECT:- SPRAY DRYER	
	02	AS BUILT		FILE NO: MES / E&I / MSD-705			
	01	AS PER COMMENTS	12-05-2025	DRAWN BY	N.A.	PROJECT:- MSD-705	
	00	FOR APPROVAL	08-05-2025	CHECKED	P.B.	DRG. NO.:- 2526/PRG/MSD/705	SHEET NO. 23 / 62
	REVISION	DETAILS	DATE	APPROVED	MESL		REV.NO. AS BUILT

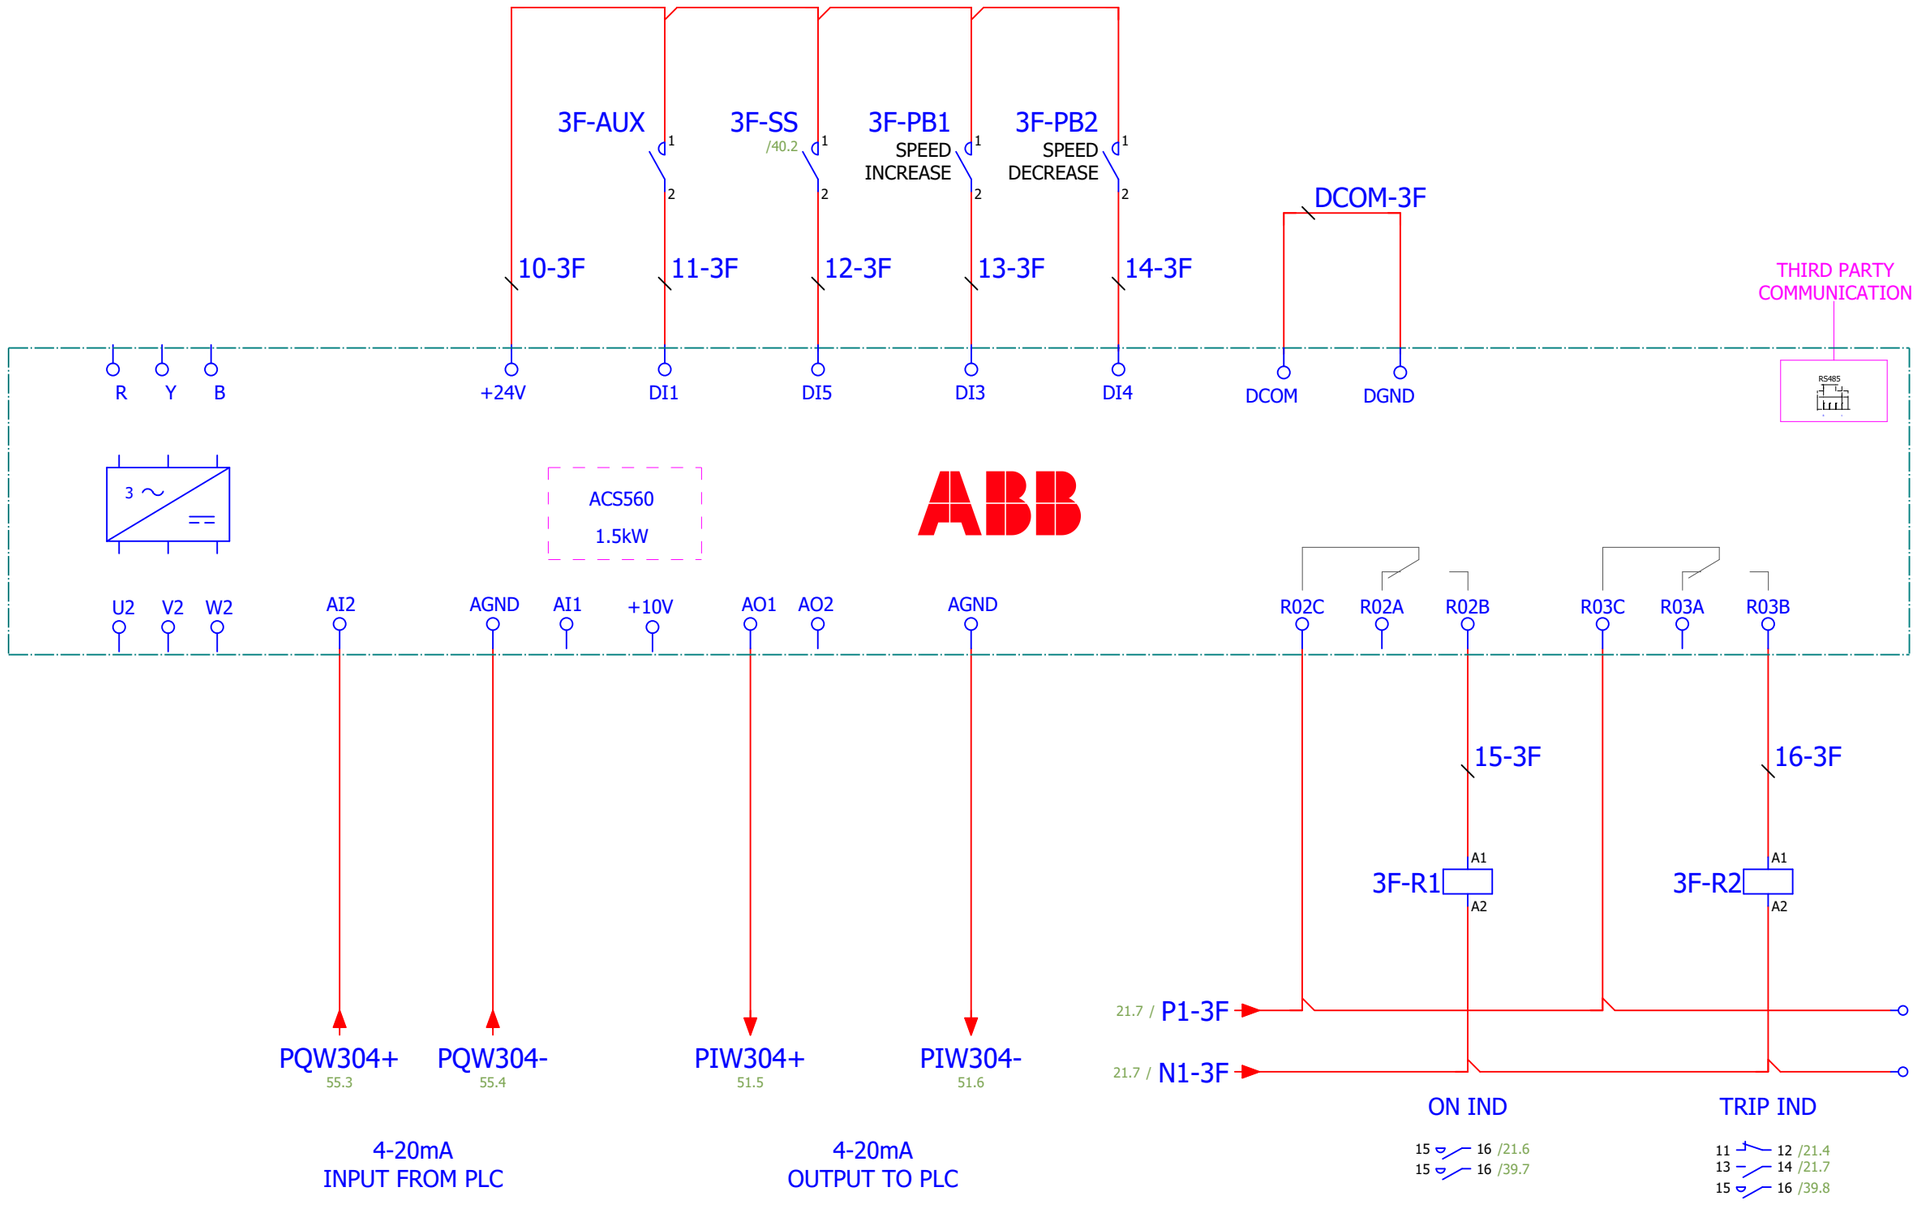

MOJJ ENGINEERING SYSTEMS LTD				TITLE:- 3F-FEED PUMP-A VFD CONTROL WIRING			PROJECT:- SPRAY DRYER	
	02	AS BUILT		FILE NO: MES / E&I / MSD-705				
	01	AS PER COMMENTS	12-05-2025	DRAWN BY	N.A.		PROJECT:- MSD-705	
	00	FOR APPROVAL	08-05-2025	CHECKED	P.B.			
	REVISION	DETAILS	DATE	APPROVED	MESL		DRG. NO.:- 2526/PRG/MSD/705	SHEET NO. 24 / 62 / REV.NO. AS BUILT

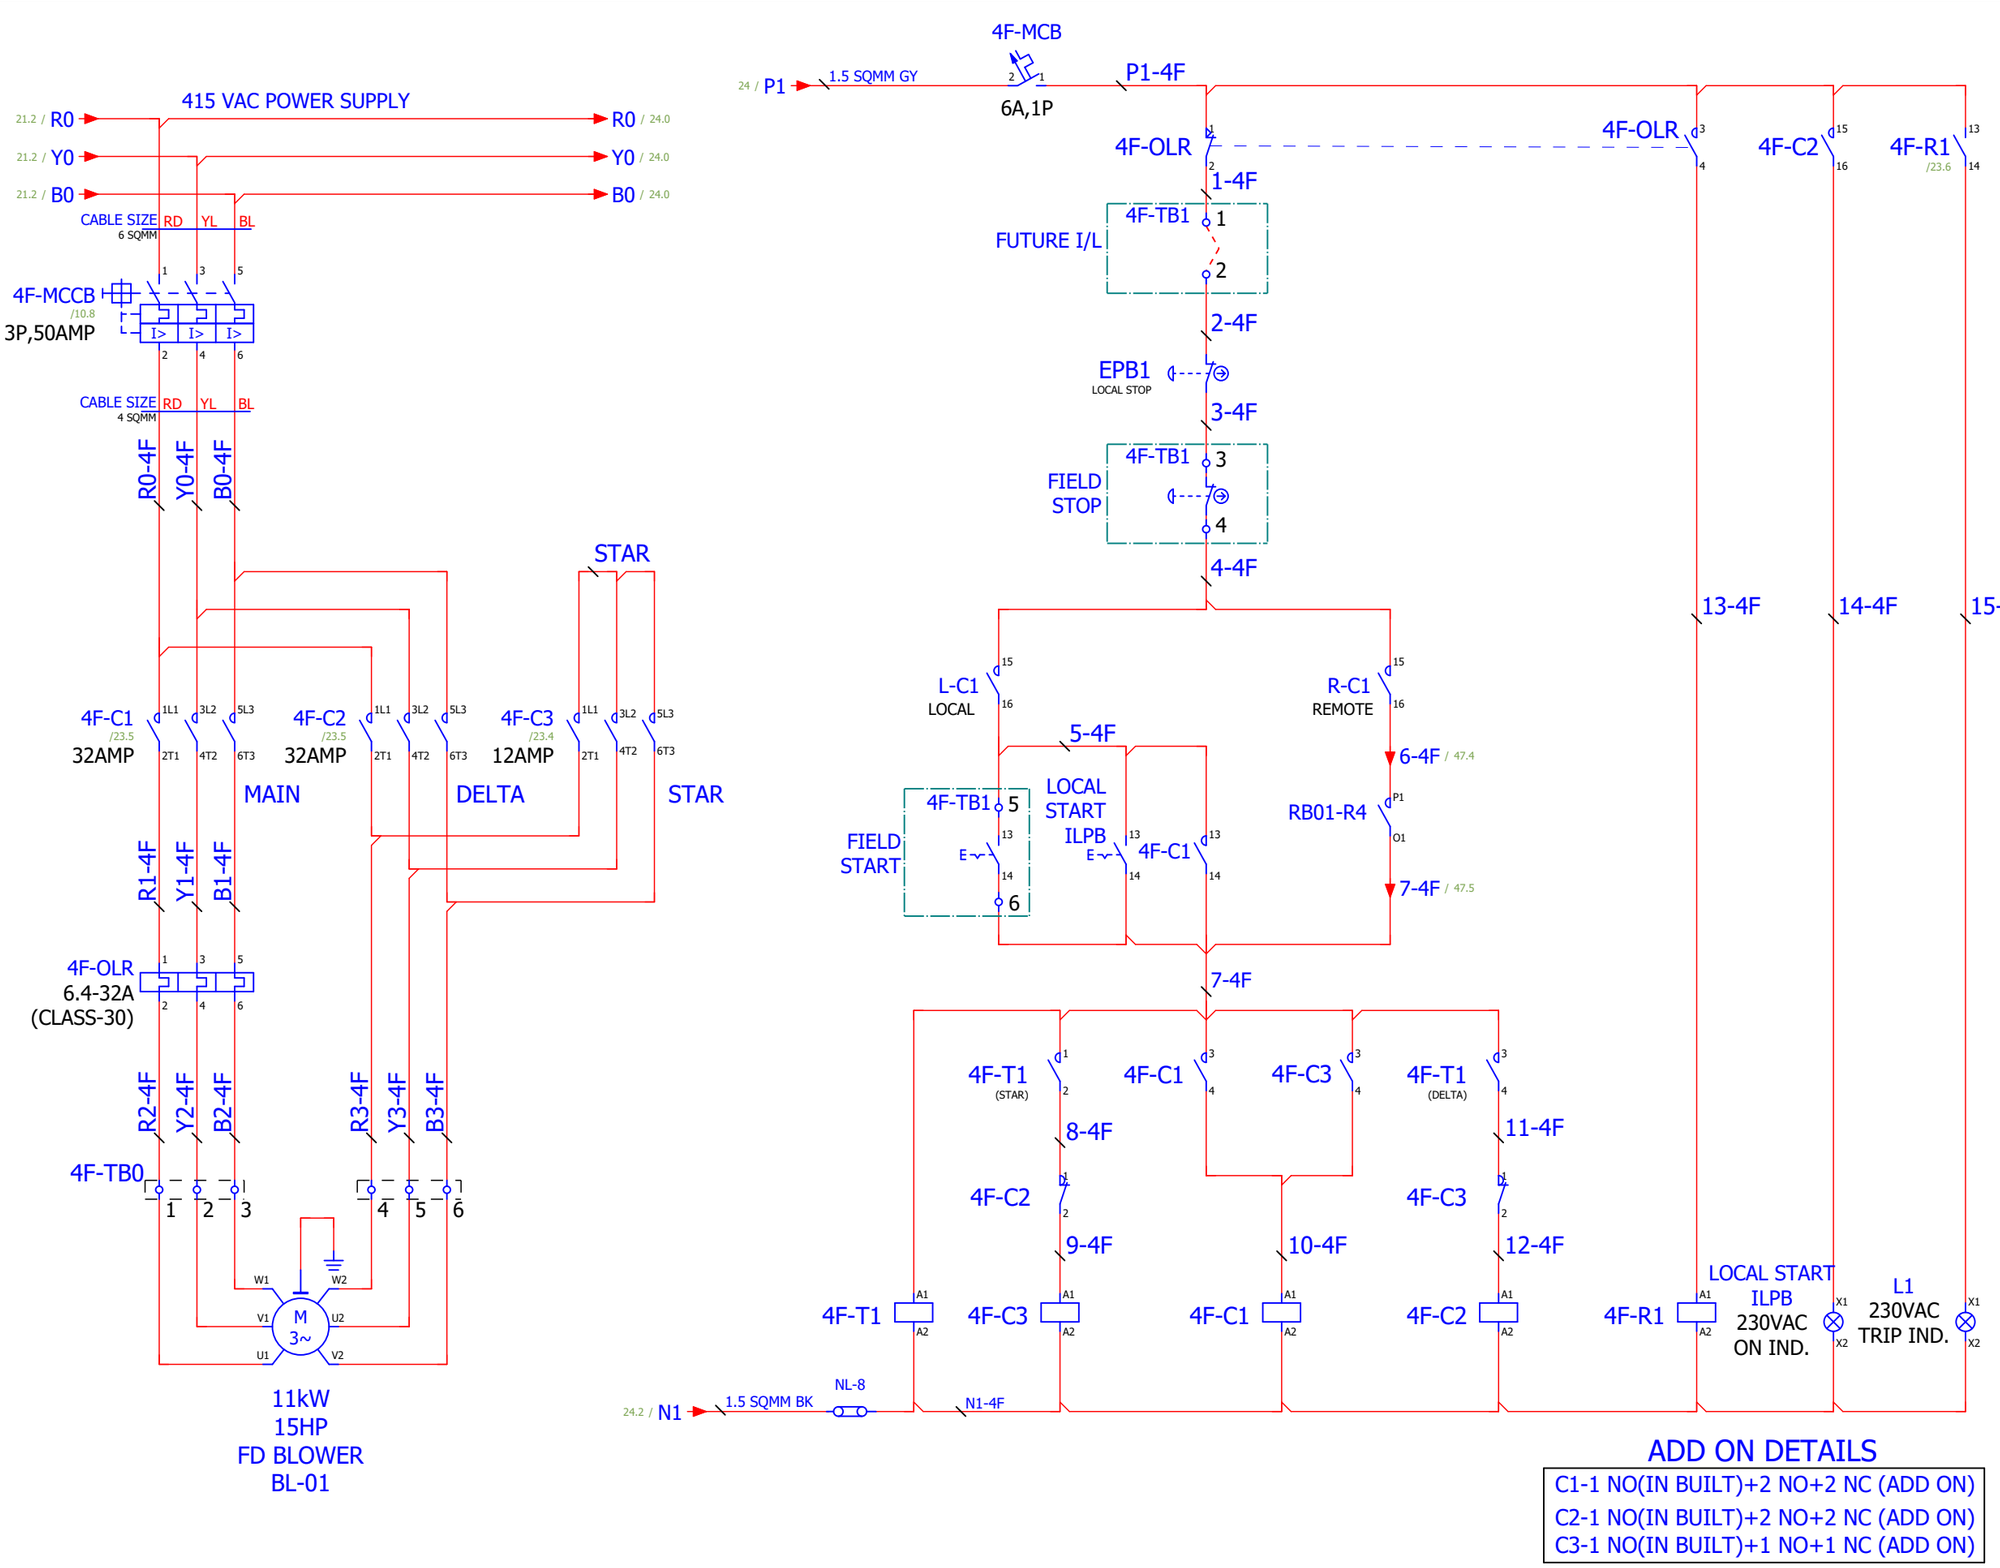

TERMINAL DETAILS

CABLE CHEMBER

MCC PANEL	ON FIELD

4F-TB0

1	SUPPLY TO MOTOR
2	
3	
4	
5	
6	

4F-TB1

1	FUTURE INTERLOCK
2	
3	FIELD STOP
4	
5	FIELD START
6	

ADD ON DETAILS


C1-1 NO(IN BUILT)+2 NO+2 NC (ADD ON)
C2-1 NO(IN BUILT)+2 NO+2 NC (ADD ON)
C3-1 NO(IN BUILT)+1 NO+1 NC (ADD ON)

MOJJ ENGINEERING SYSTEMS LTD

REVISION	DETAILS	DATE
02	AS BUILT	
01	AS PER COMMENTS	12-05-2025
00	FOR APPROVAL	08-05-2025

TITLE:- 4F-FD BLOWER POWER & CONTROL WIRING
FILE NO: MES / E&I / MSD-705
DRAWN BY N.A.
CHECKED P.B.
APPROVED MESL

PROJECT:- SPRAY DRYER
PROJECT:- MSD-705
DRG. NO.:- 2526/PRG/MSD/705
SHEET NO. 25 / 62
REV.NO. AS BUILT

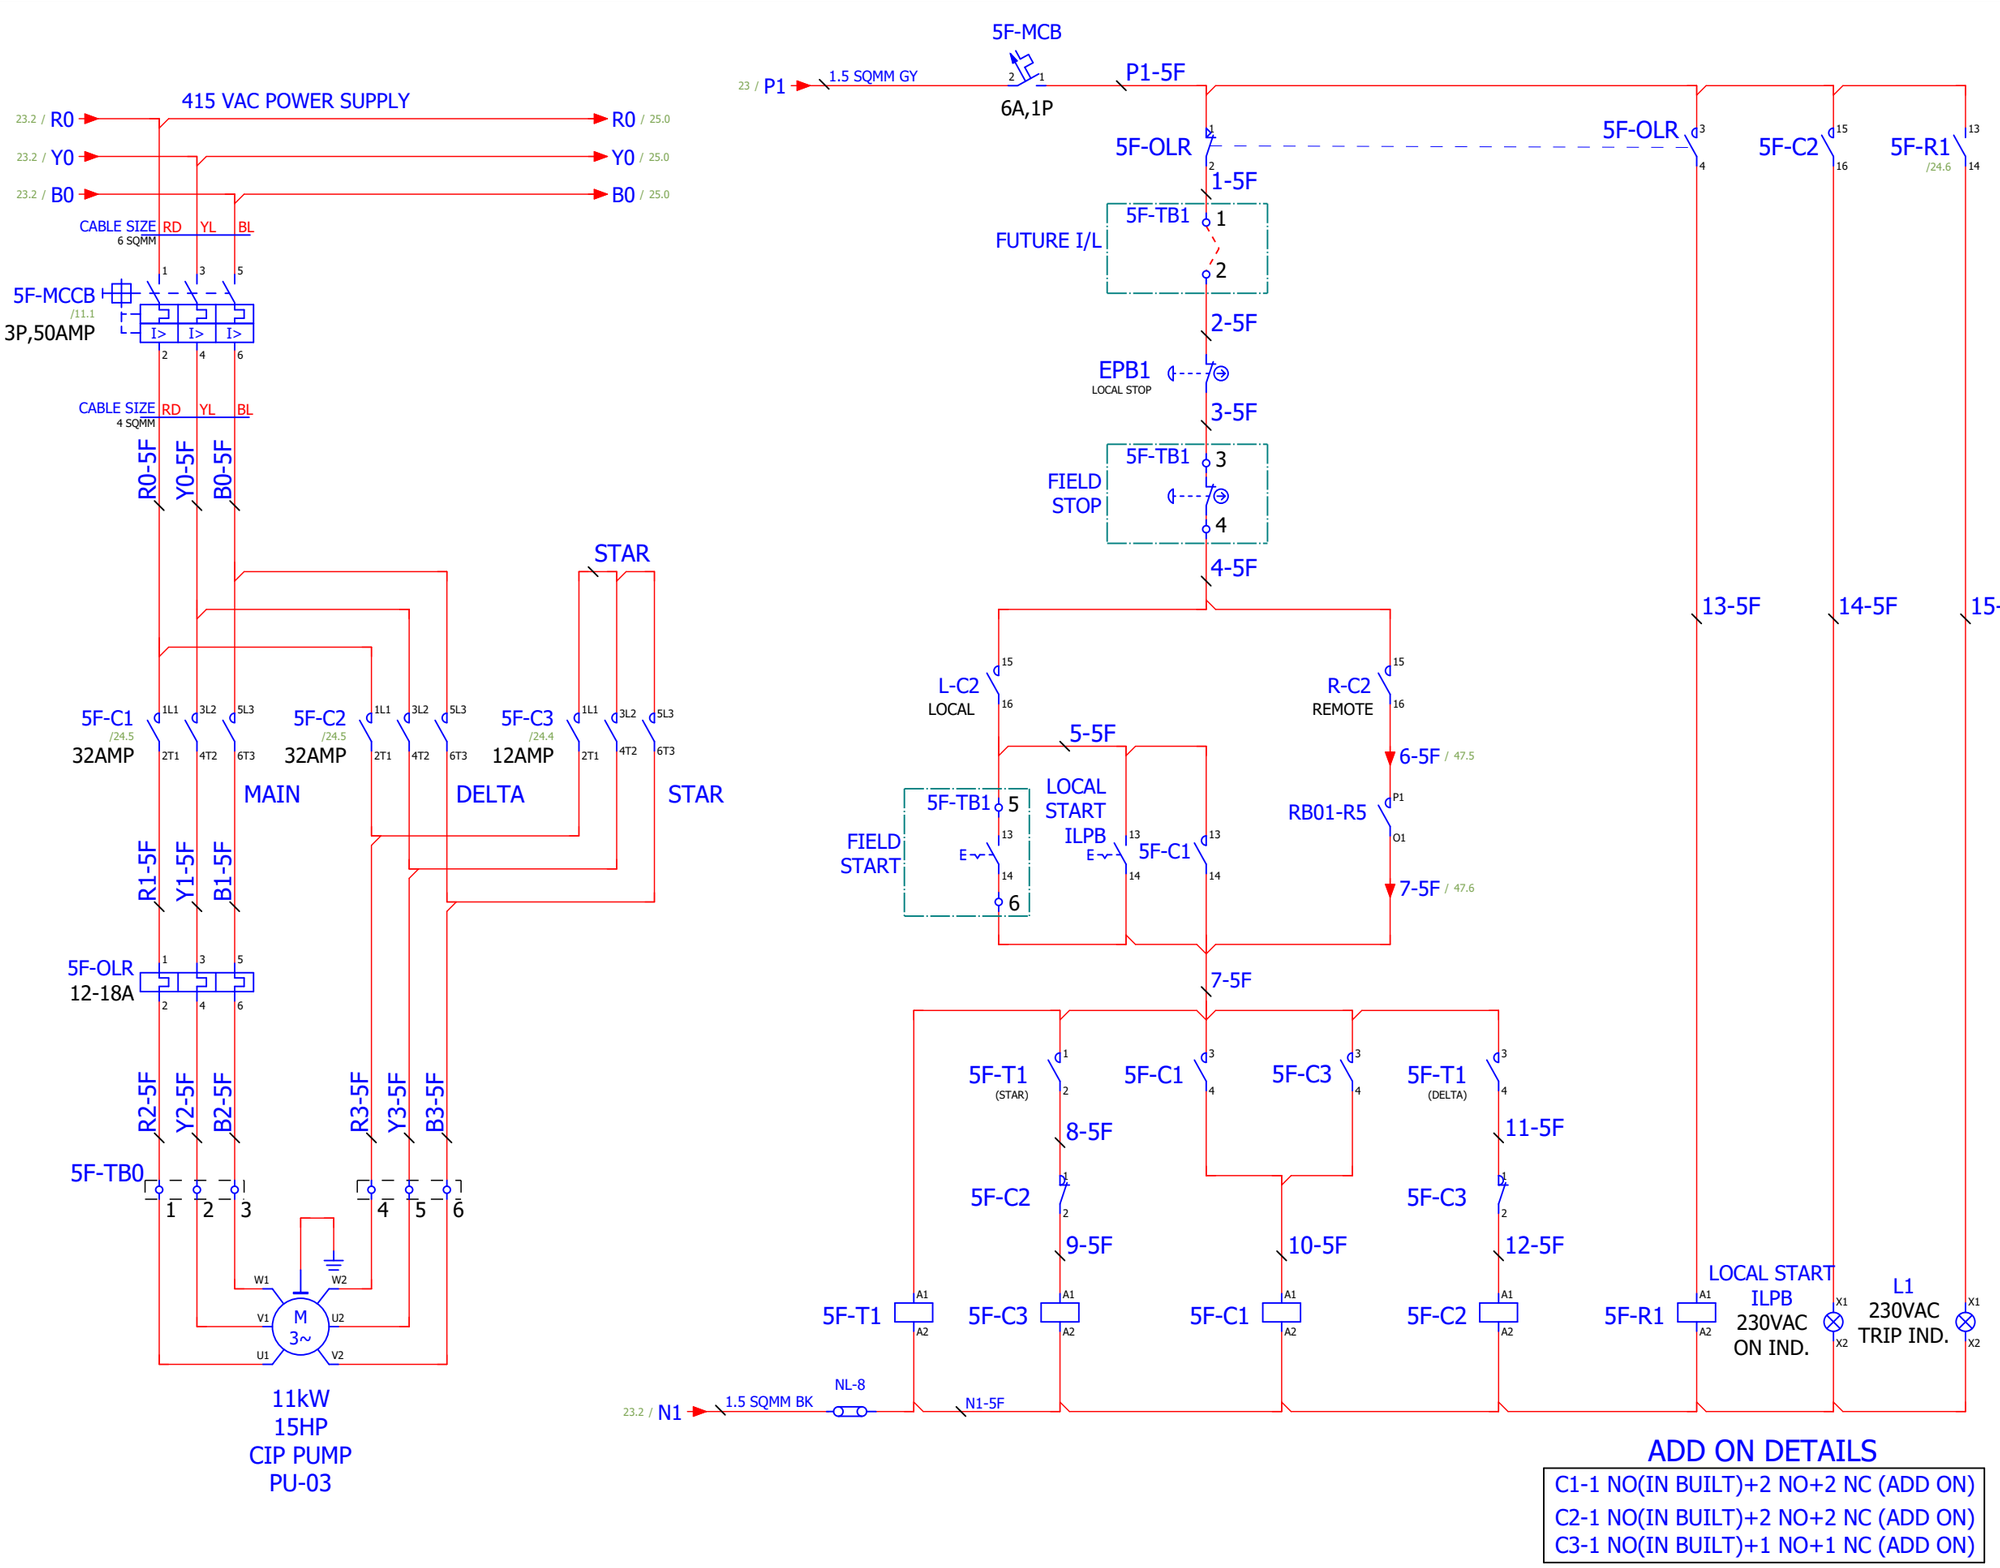

TERMINAL DETAILS

CABLE CHEMBER

MCC PANEL	ON FIELD

5F-TB0

1	SUPPLY TO MOTOR
2	
3	
4	
5	
6	

5F-TB1

1	FUTURE INTERLOCK
2	
3	FIELD STOP
4	
5	FIELD START
6	

ADD ON DETAILS


C1-1 NO(IN BUILT)+2 NO+2 NC (ADD ON)
C2-1 NO(IN BUILT)+2 NO+2 NC (ADD ON)
C3-1 NO(IN BUILT)+1 NO+1 NC (ADD ON)

MOJJ ENGINEERING SYSTEMS LTD

REVISION	DETAILS	DATE
02	AS BUILT	
01	AS PER COMMENTS	12-05-2025
00	FOR APPROVAL	08-05-2025

TITLE:- 5F-CIP PUMP POWER & CONTROL WIRING
FILE NO: MES / E&I / MSD-705
DRAWN BY N.A.
CHECKED P.B.
APPROVED MESL

PROJECT:- SPRAY DRYER
PROJECT:- MSD-705
DRG. NO.:- 2526/PRG/MSD/705
SHEET NO. 26 / 62
REV.NO. AS BUILT

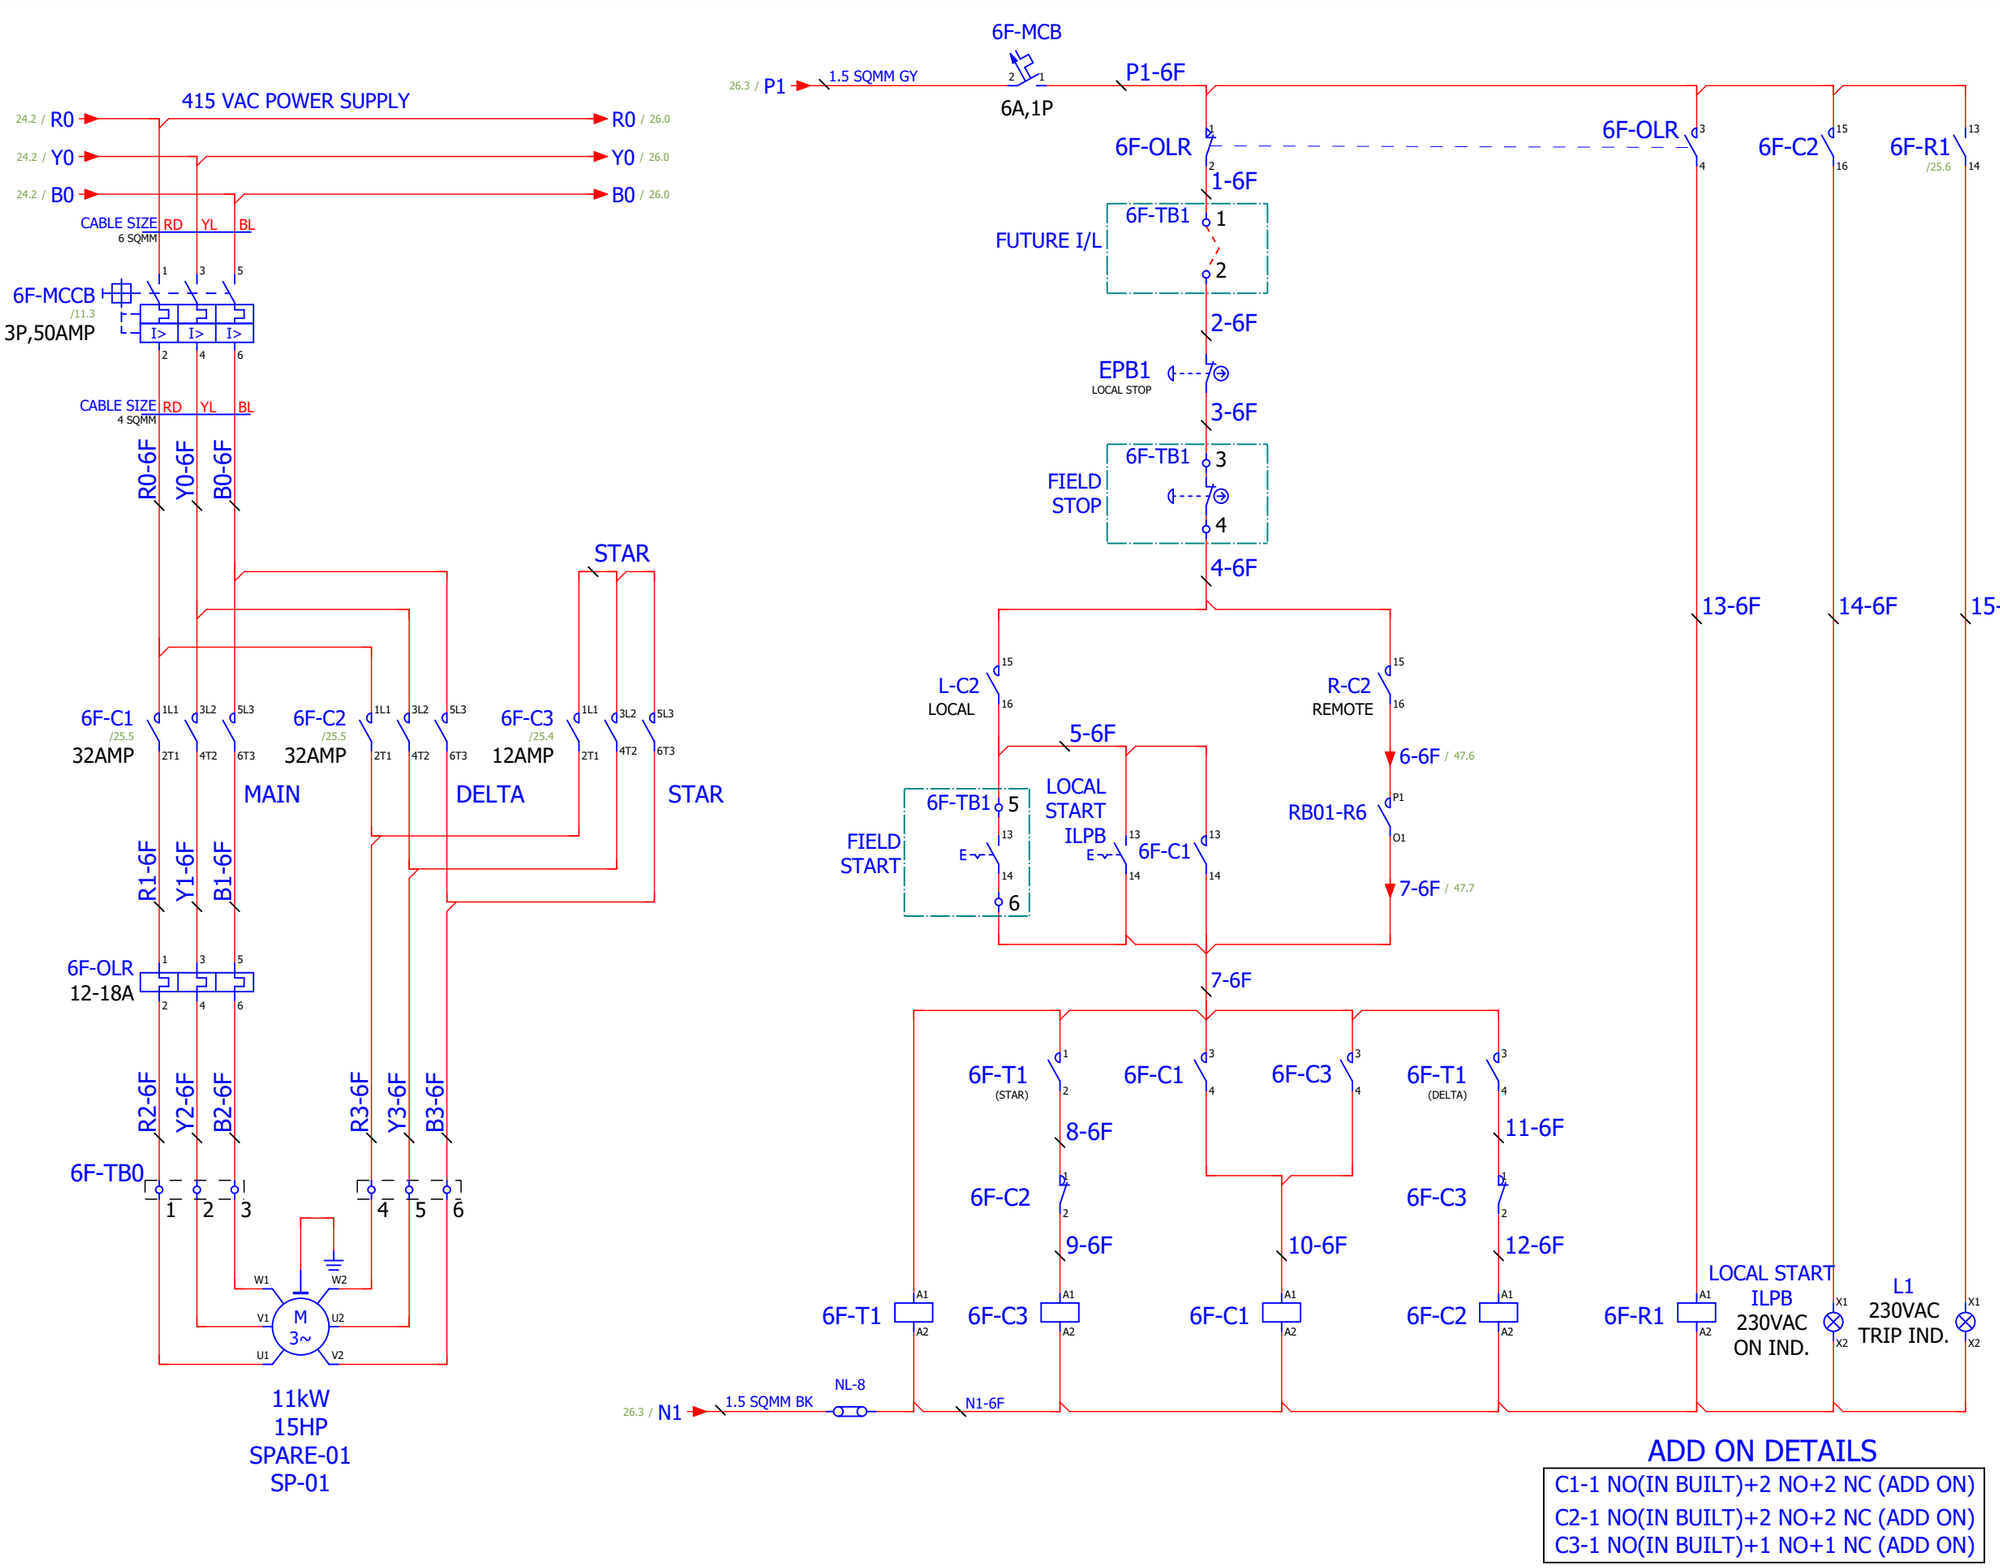

TERMINAL DETAILS

CABLE CHEMBER

MCC PANEL	ON FIELD

6F-TB0

1	SUPPLY TO MOTOR
2	
3	
4	
5	
6	

6F-TB1

1	FUTURE INTERLOCK
2	
3	FIELD STOP
4	
5	FIELD START
6	

ADD ON DETAILS


C1-1 NO(IN BUILT)+2 NO+2 NC (ADD ON)
C2-1 NO(IN BUILT)+2 NO+2 NC (ADD ON)
C3-1 NO(IN BUILT)+1 NO+1 NC (ADD ON)

MOJJ ENGINEERING SYSTEMS LTD

REVISION	DETAILS	DATE
02	AS BUILT	
01	AS PER COMMENTS	12-05-2025
00	FOR APPROVAL	08-05-2025

TITLE:- 6F-SPARE-01 POWER & CONTROL WIRING
FILE NO: MES / E&I / MSD-705
DRAWN BY N.A.
CHECKED P.B.
APPROVED MESL

PROJECT:- SPRAY DRYER
PROJECT:- MSD-705
DRG. NO.:- 2526/PRG/MSD/705
SHEET NO. 27 / 62
REV.NO. AS BUILT

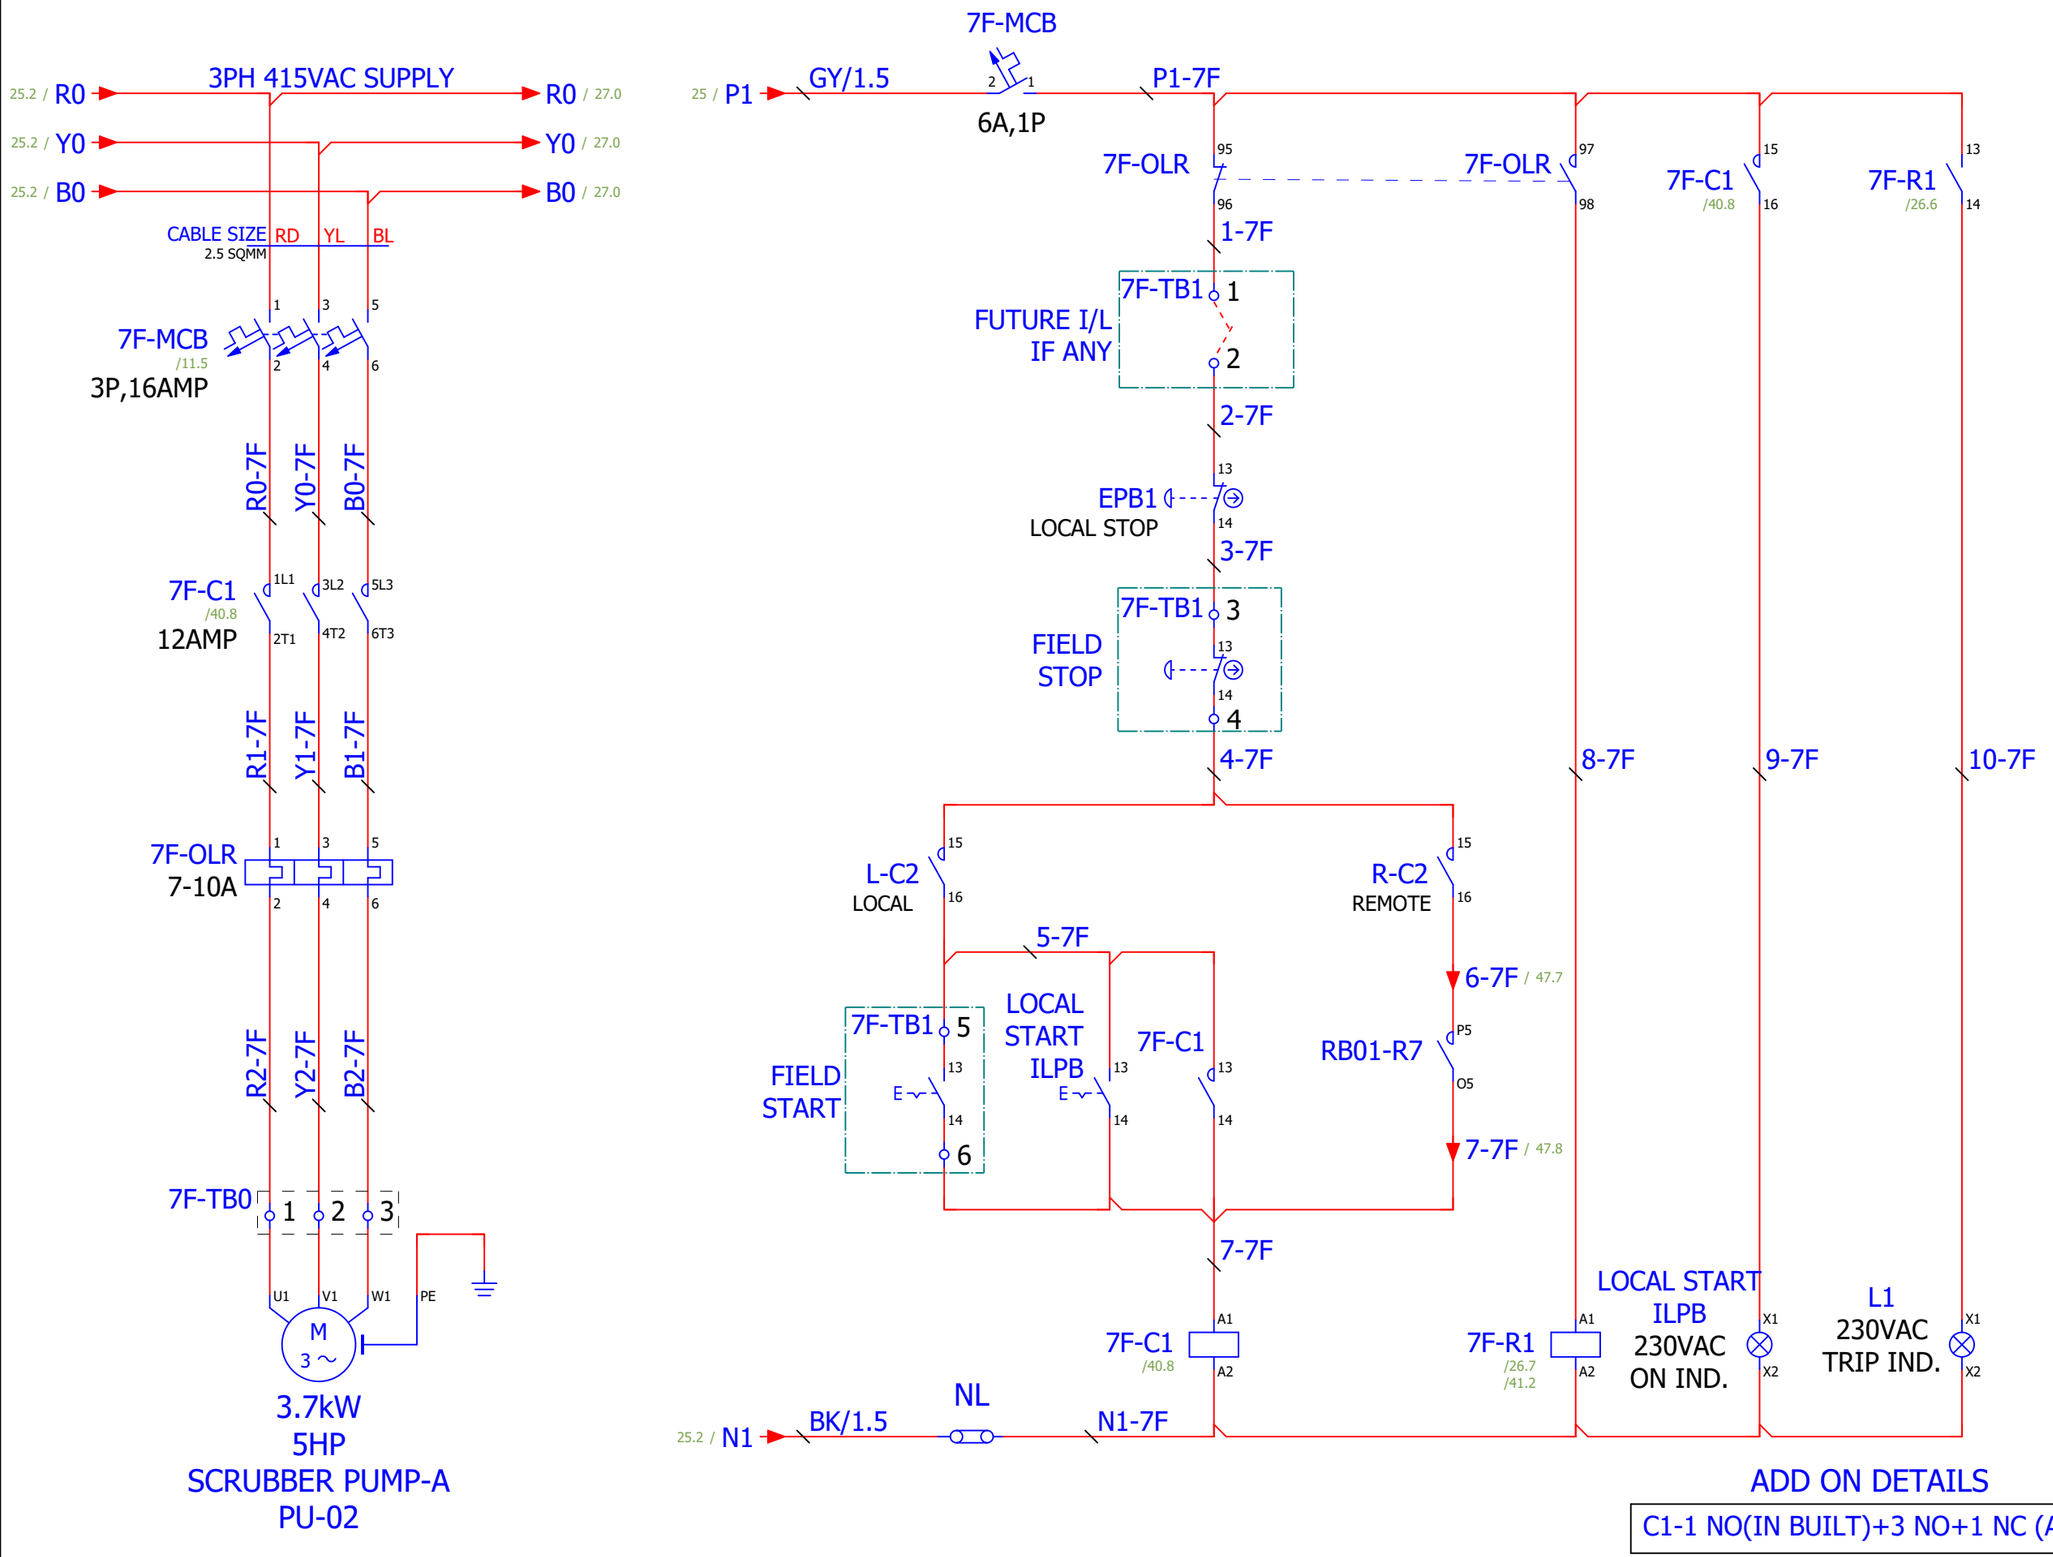

TERMINAL DETAILS

CABLE CHAMBER	
MCC PANEL	ON FIELD

7F-TB0

1	SUPPLY TO MOTOR
2	
3	

7F-TB1

1	FUTURE INTERLOCK
2	
3	FIELD STOP
4	
5	FIELD START
6	

ADD ON DETAILS

C1-1 NO(IN BUILT)+3 NO+1 NC (ADD ON)

MOJJ ENGINEERING SYSTEMS LTD

REVISION	DETAILS	DATE
02	AS BUILT	
01	AS PER COMMENTS	12-05-2025
00	FOR APPROVAL	08-05-2025

TITLE:- 7F-SCRUBBER PUMP-A POWER & CONTROL WIRING

FILE NO: MES / E&I / MSD-705

DRAWN BY N.A.

CHECKED P.B.

APPROVED MESL


PROJECT:- SPRAY DRYER

PROJECT:- MSD-705

DRG. NO.:- 2526/PRG/MSD/705

SHEET NO. 28 / 62

REV.NO. AS BUILT

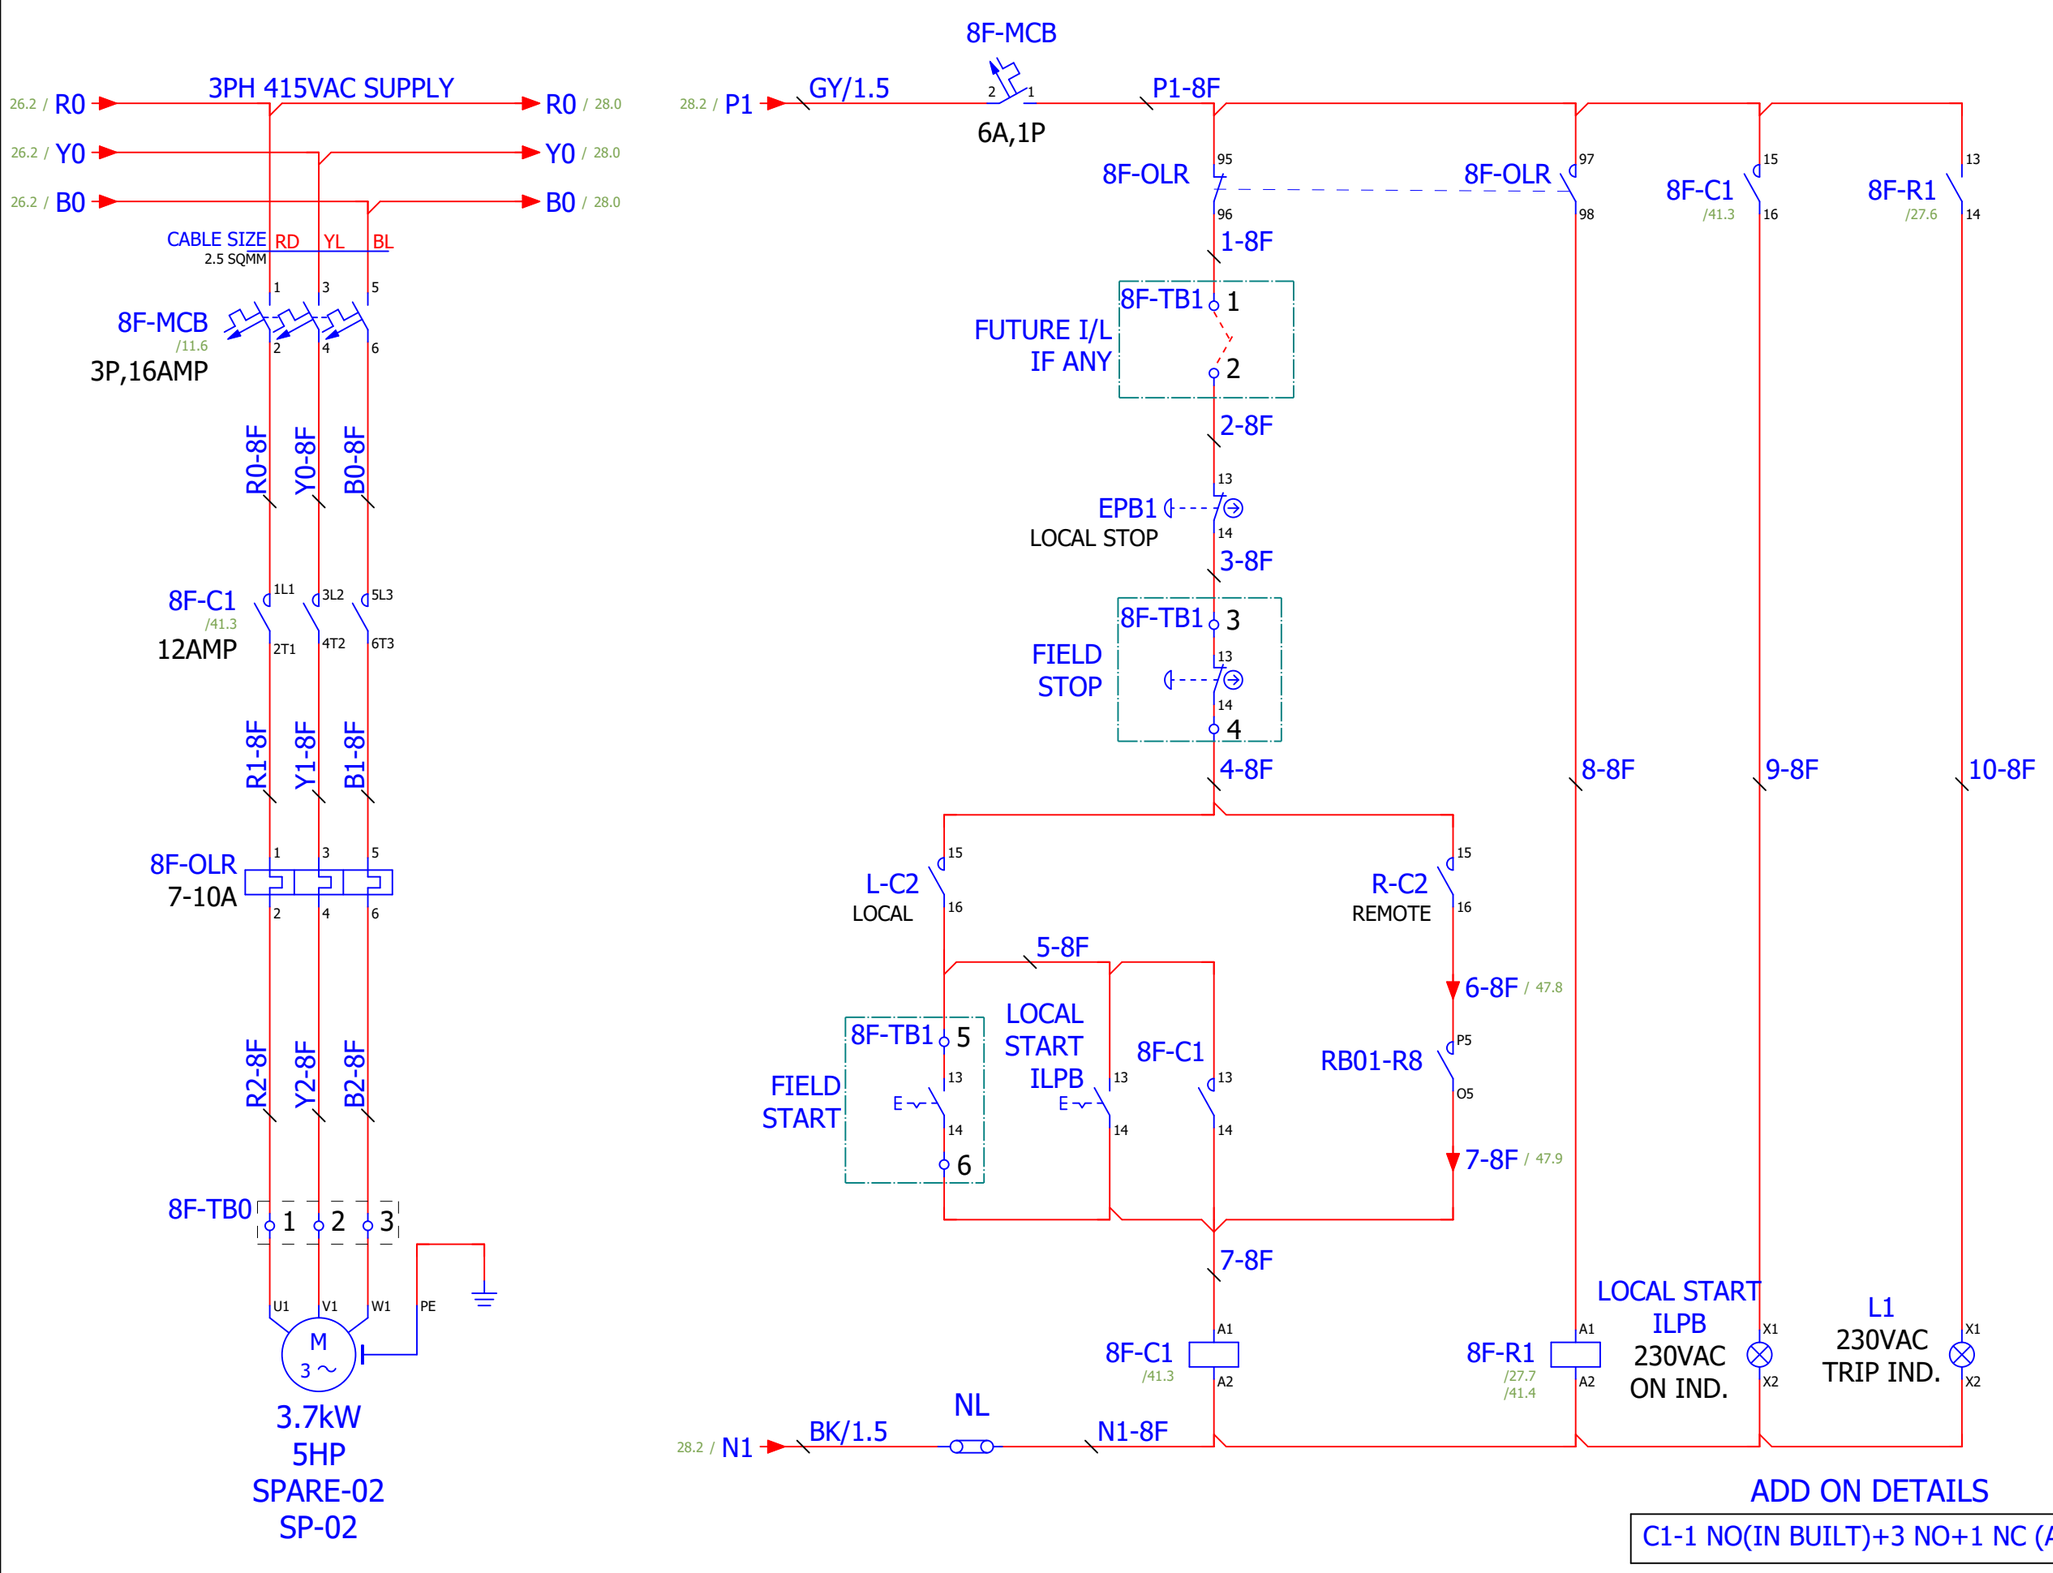

TERMINAL DETAILS

CABLE CHAMBER	
MCC PANEL	ON FIELD

8F-TB0

1	SUPPLY TO MOTOR
2	
3	

8F-TB1

1	FUTURE INTERLOCK
2	
3	FIELD STOP
4	
5	FIELD START
6	

ADD ON DETAILS


C1-1 NO(IN BUILT)+3 NO+1 NC (ADD ON)

MOJJ ENGINEERING SYSTEMS LTD

REVISION	DETAILS	DATE
02	AS BUILT	
01	AS PER COMMENTS	12-05-2025
00	FOR APPROVAL	08-05-2025

TITLE:- 8F-SPARE-02 POWER & CONTROL WIRING
FILE NO: MES / E&I / MSD-705
DRAWN BY N.A.
CHECKED P.B.
APPROVED MESL

PROJECT:- SPRAY DRYER
PROJECT:- MSD-705
DRG. NO.:- 2526/PRG/MSD/705
SHEET NO. 29 / 62
REV.NO. AS BUILT

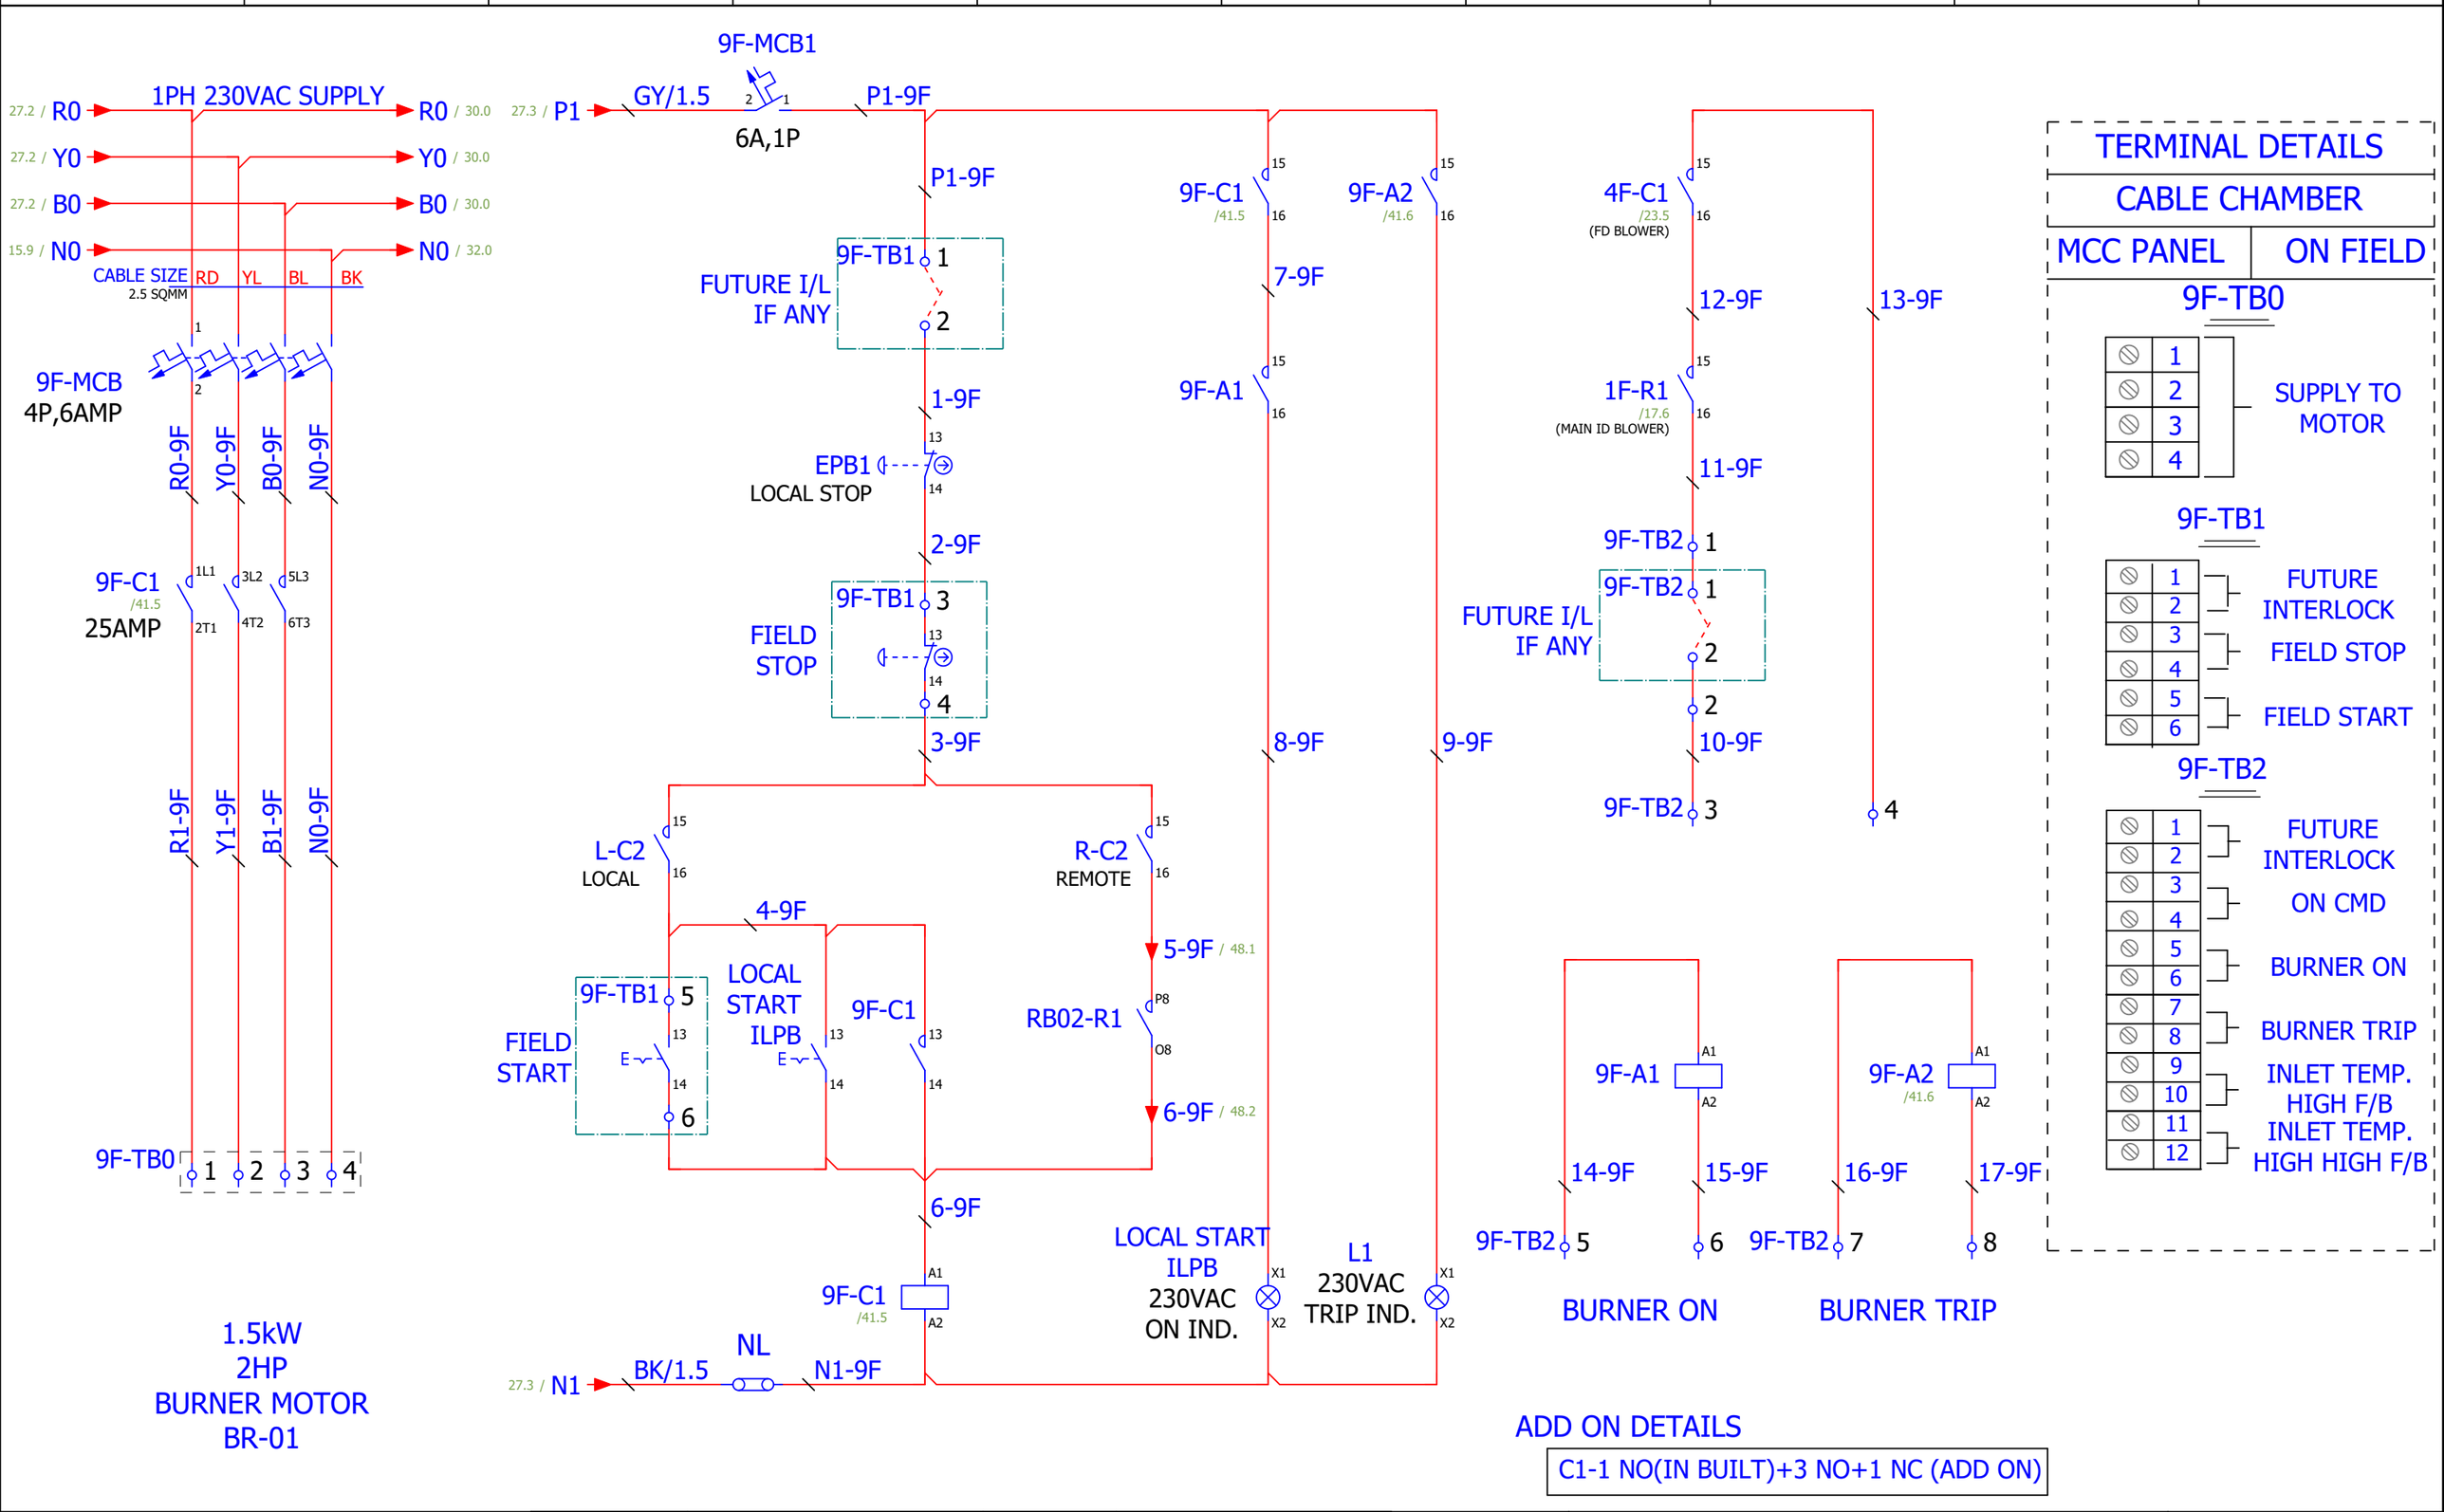

MOJJ ENGINEERING SYSTEMS LTD

REVISION	DETAILS	DATE			
02	AS BUILT		FILE NO:	MES / E&I / MSD-705	
01	AS PER COMMENTS	12-05-2025	DRAWN BY	N.A.	
00	FOR APPROVAL	08-05-2025	CHECKED	P.B.	
			APPROVED	MESL	

TITLE:- 9F-BURNER MOTOR POWER & CONTROL WIRING


PROJECT:- SPRAY DRYER

PROJECT:- MSD-705


DRG. NO.:- 2526/PRG/MSD/705

SHEET NO. 30 / 62


REV.NO. AS BUILT

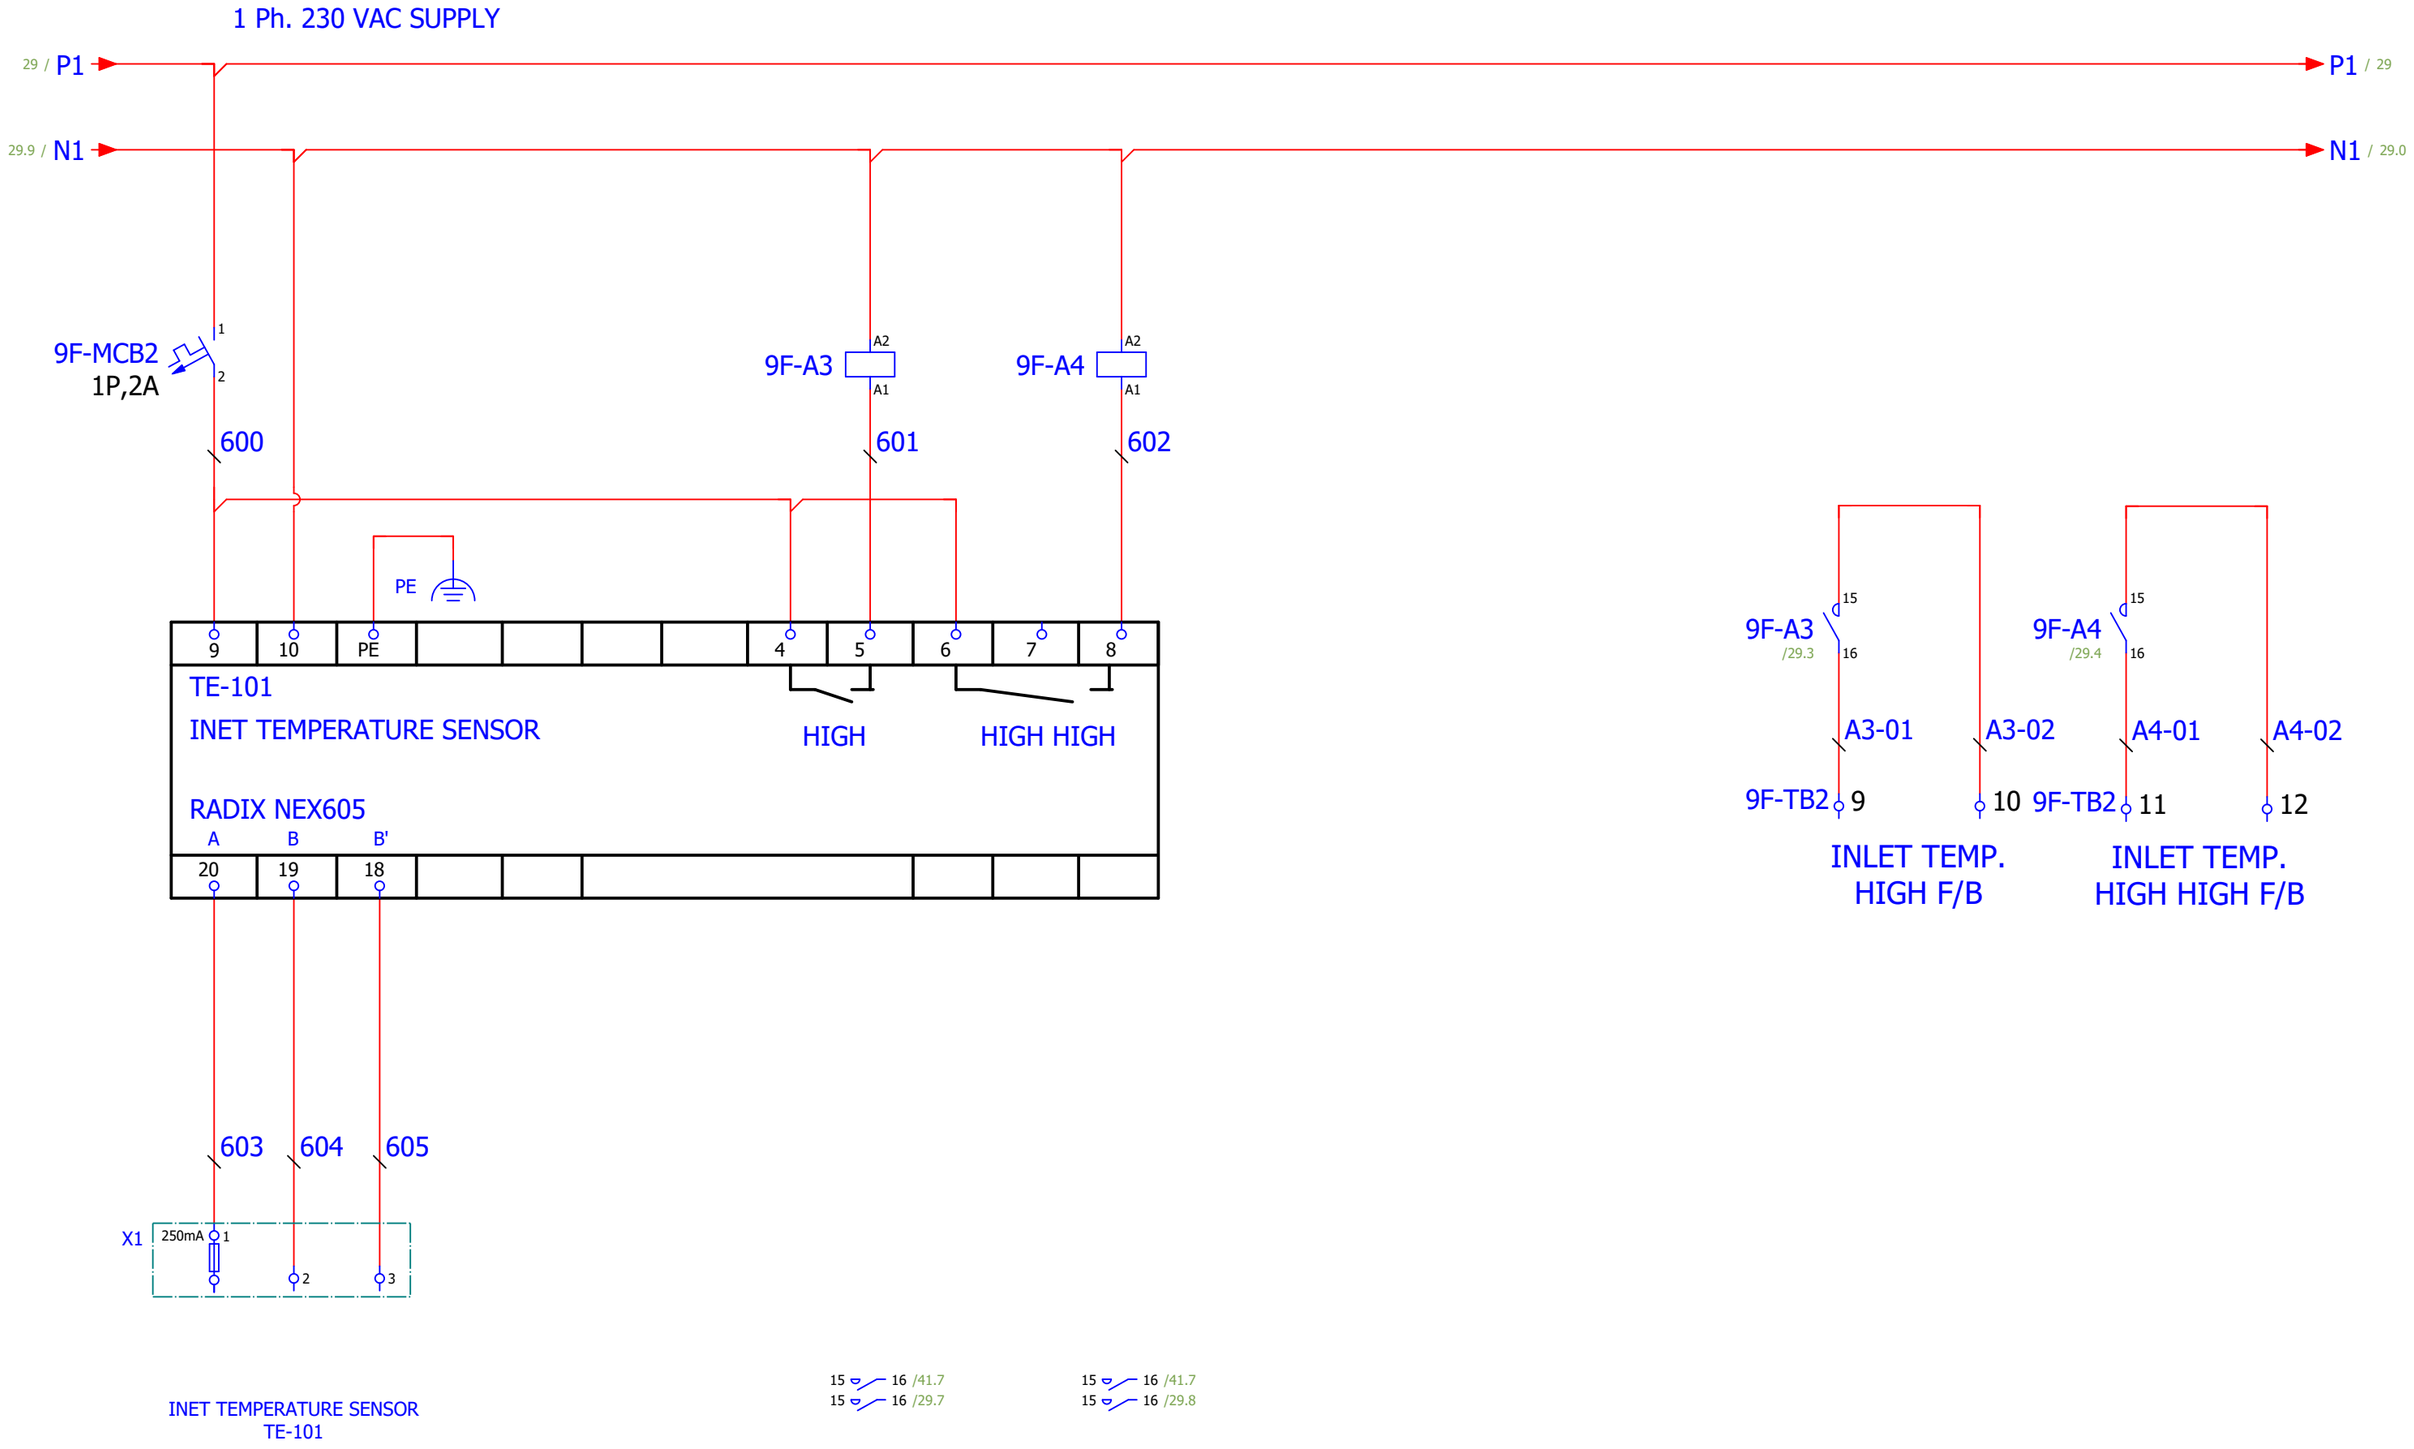


MOJJ ENGINEERING SYSTEMS LTD			TITLE:- TEMPERATURE CONTROLER		PROJECT:- SPRAY DRYER
02	AS BUILT		FILE NO: MES / E&I / MSD-705		
01	AS PER COMMENTS	12-05-2025	DRAWN BY	N.A.	PROJECT:- MSD-705
00	FOR APPROVAL	08-05-2025	CHECKED	P.B.	
REVISION	DETAILS	DATE	APPROVED	MESL	DRG. NO.:- 2526/PRG/MSD/705 / SHEET NO. 31 / 62 / REV.NO. AS BUILT

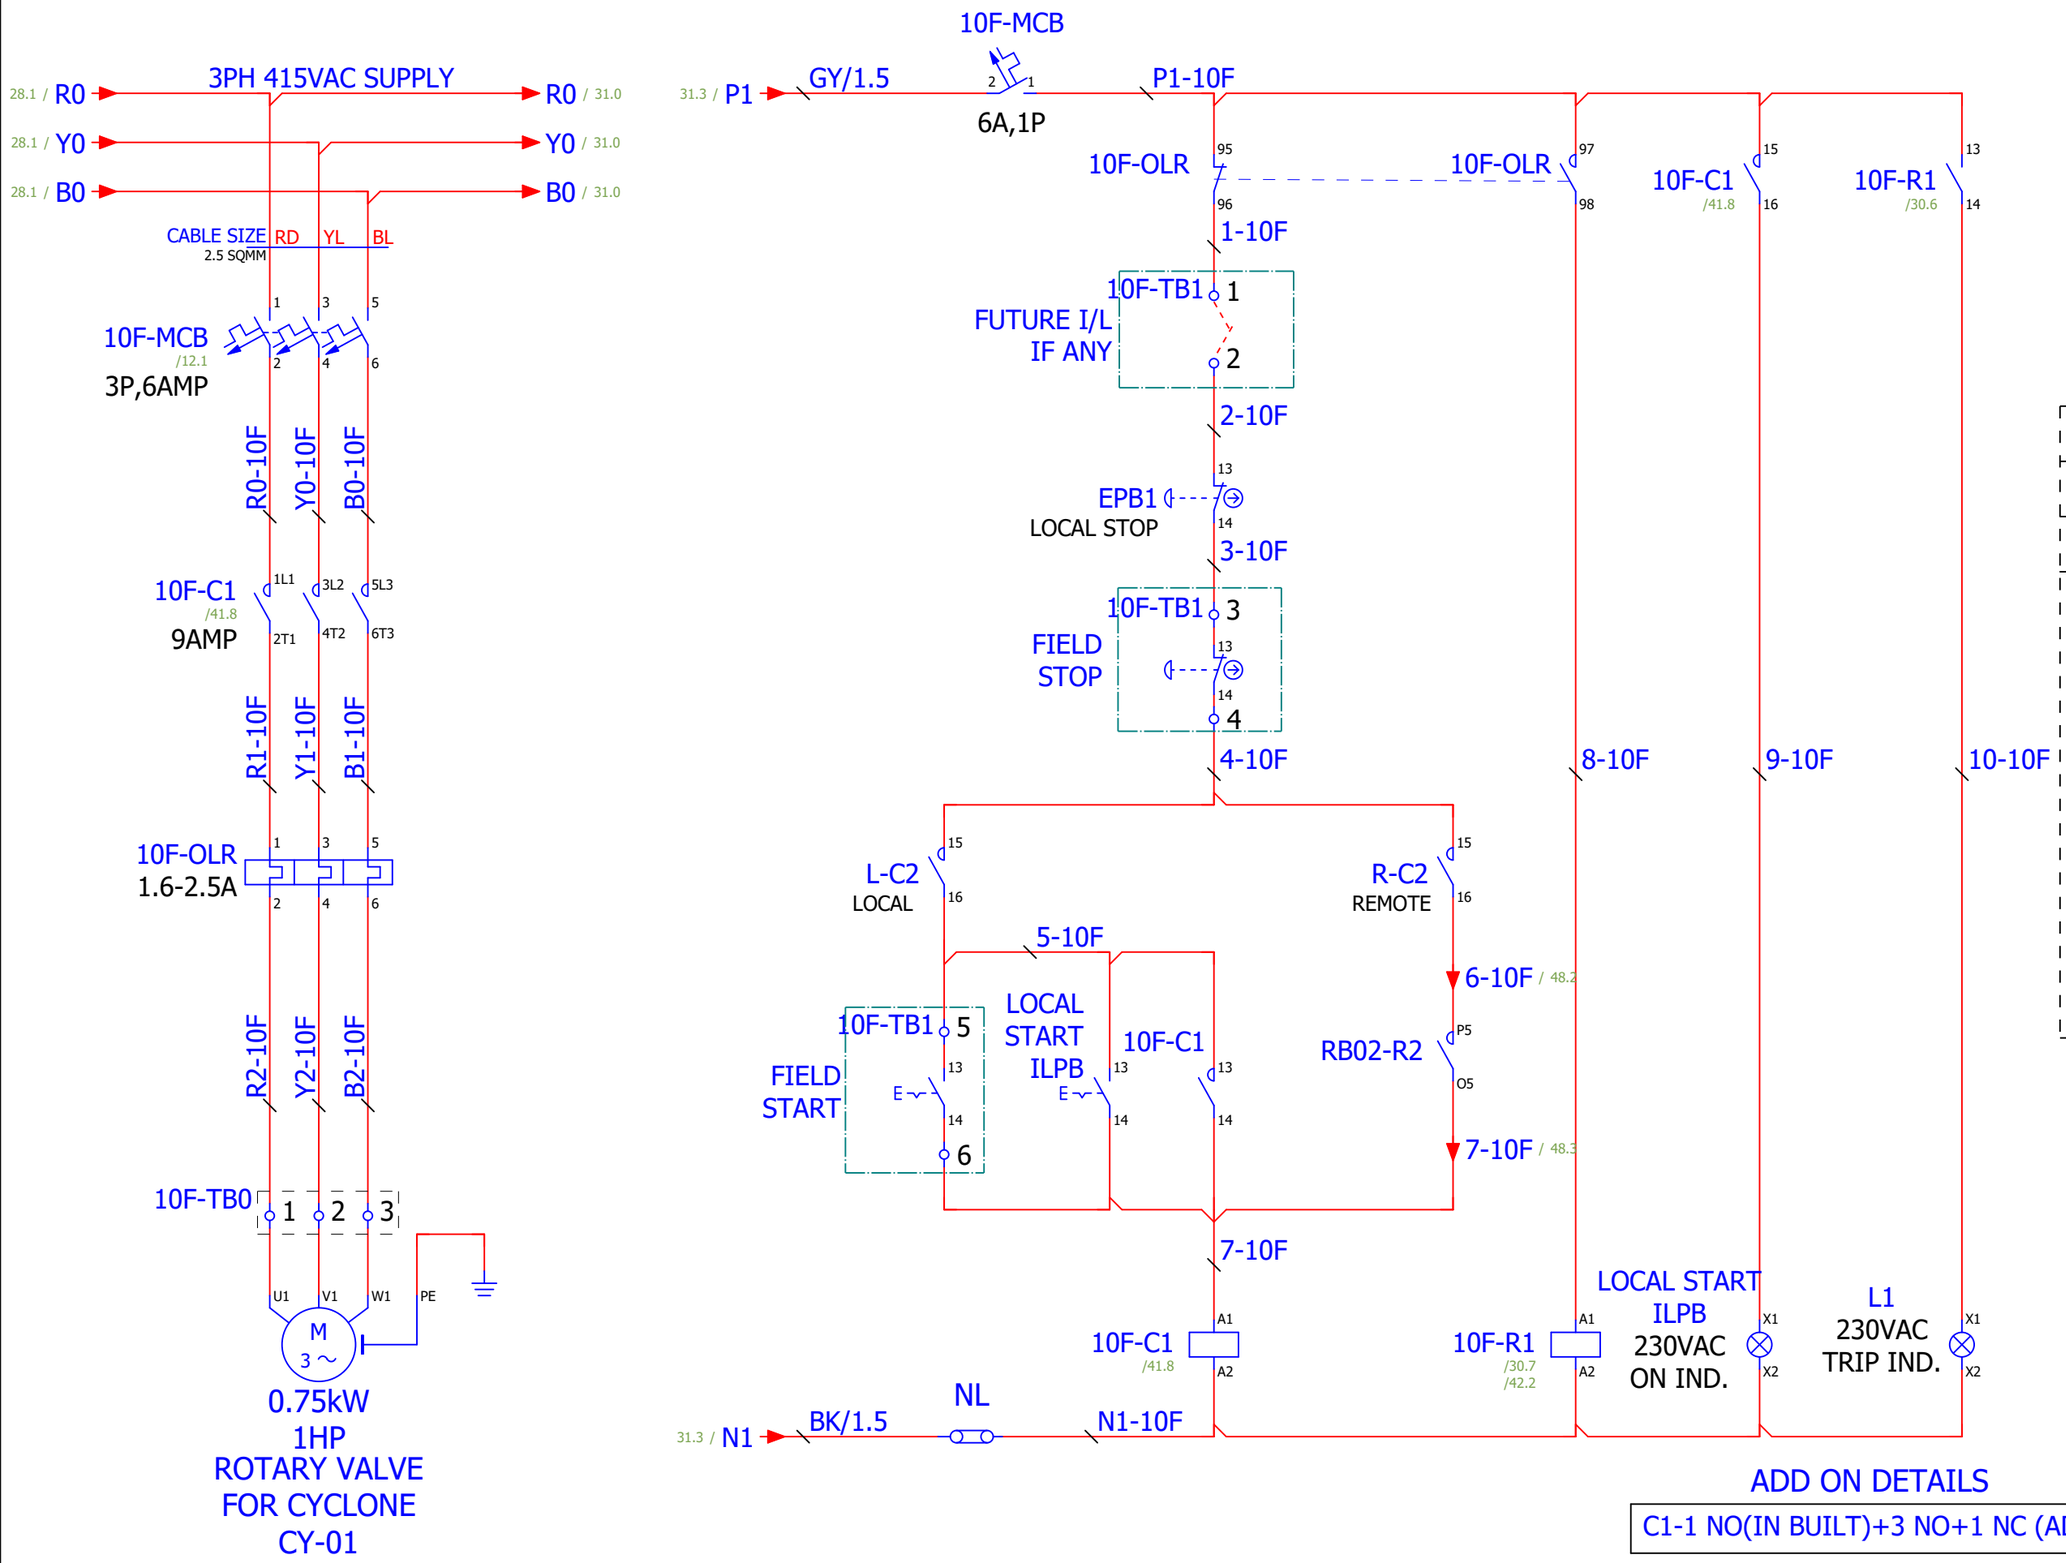

MOJJ ENGINEERING SYSTEMS LTD				TITLE:- 10F-ROTARY VALVE FOR CYCLONE POWER & CONTROL WIRING		PROJECT:- SPRAY DRYER	
	02	AS BUILT		FILE NO: MES / E&I / MSD-705			
	01	AS PER COMMENTS	12-05-2025	DRAWN BY	N.A.	PROJECT:- MSD-705	
	00	FOR APPROVAL	08-05-2025	CHECKED	P.B.		
	REVISION	DETAILS	DATE	APPROVED	MESL	DRG. NO.:- 2526/PRG/MSD/705	SHEET NO. 32 / 62 REV.NO. AS BUILT

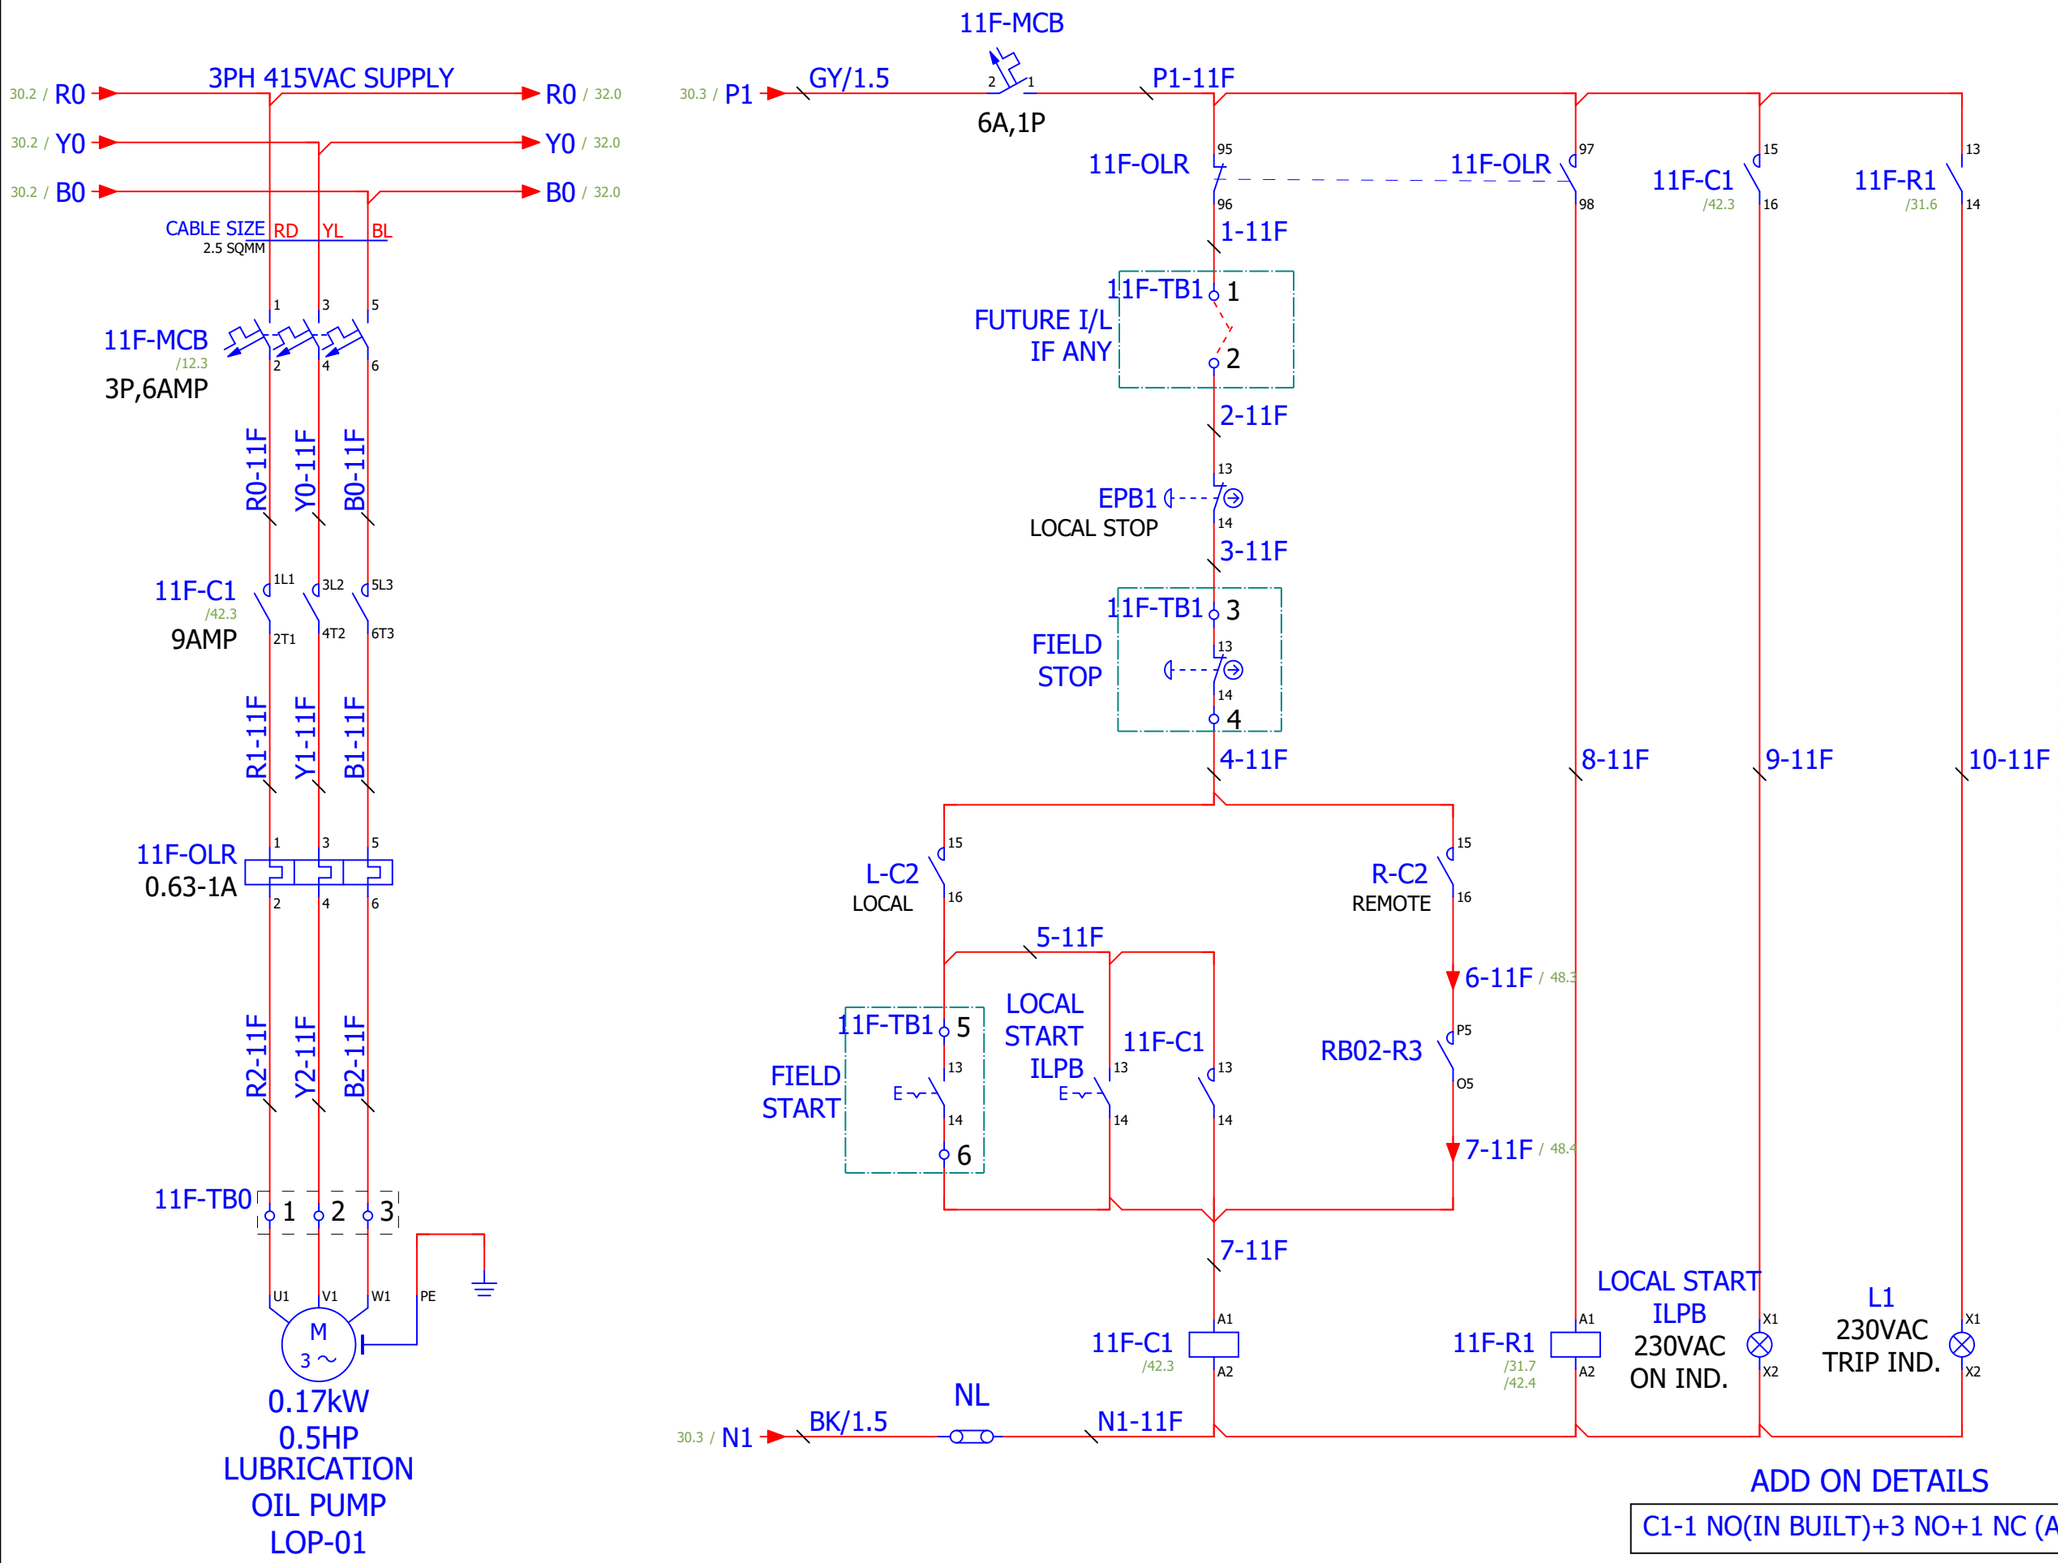

MOJJ ENGINEERING SYSTEMS LTD				TITLE:- 11F-LUBRICATION OIL PUMP POWER & CONTROL WIRING		PROJECT:- SPRAY DRYER	
	02	AS BUILT		FILE NO: MES / E&I / MSD-705			
	01	AS PER COMMENTS	12-05-2025	DRAWN BY	N.A.	PROJECT:- MSD-705	
	00	FOR APPROVAL	08-05-2025	CHECKED	P.B.	DRG. NO.:- 2526/PRG/MSD/705	SHEET NO. 33 / 62
	REVISION	DETAILS	DATE	APPROVED	MESL		REV.NO. AS BUILT

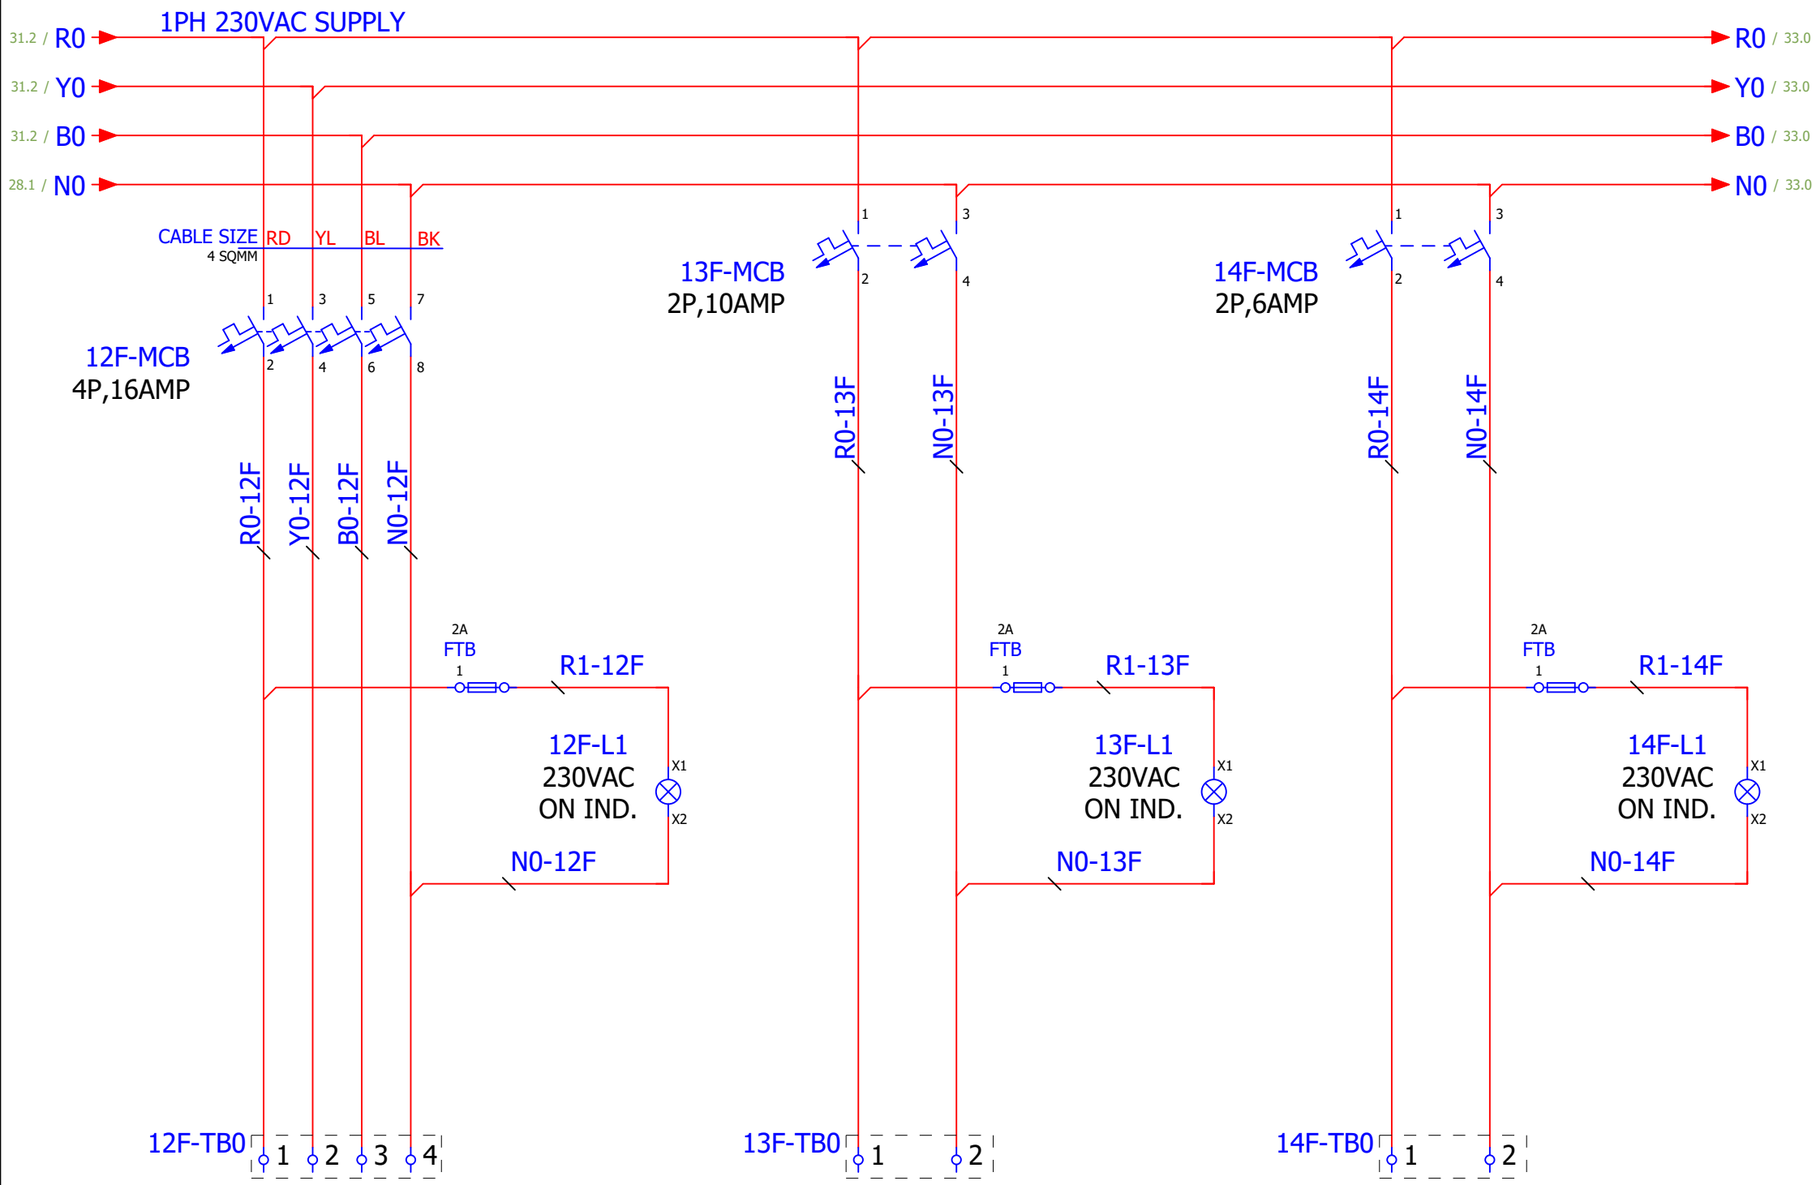

TERMINAL DETAILS

CABLE CHAMBER

MCC PANEL	ON FIELD

12F-TB0

1	SUPPLY TO MOTOR
2	
3	
4	

13F-TB0

1	SUPPLY TO MOTOR
2	
3	

14F-TB0

1	SUPPLY TO MOTOR
2	

MOJJ ENGINEERING SYSTEMS LTD

REVISION	DETAILS	DATE
02	AS BUILT	
01	AS PER COMMENTS	12-05-2025
00	FOR APPROVAL	08-05-2025

TITLE:- SUPPLY FEEDER

FILE NO: MES / E&I / MSD-705

DRAWN BY	N.A.
CHECKED	P.B.
APPROVED	MESL


PROJECT:- SPRAY DRYER

PROJECT:- MSD-705

DRG. NO.:- 2526/PRG/MSD/705

SHEET NO. 34 / 62

REV.NO. AS BUILT

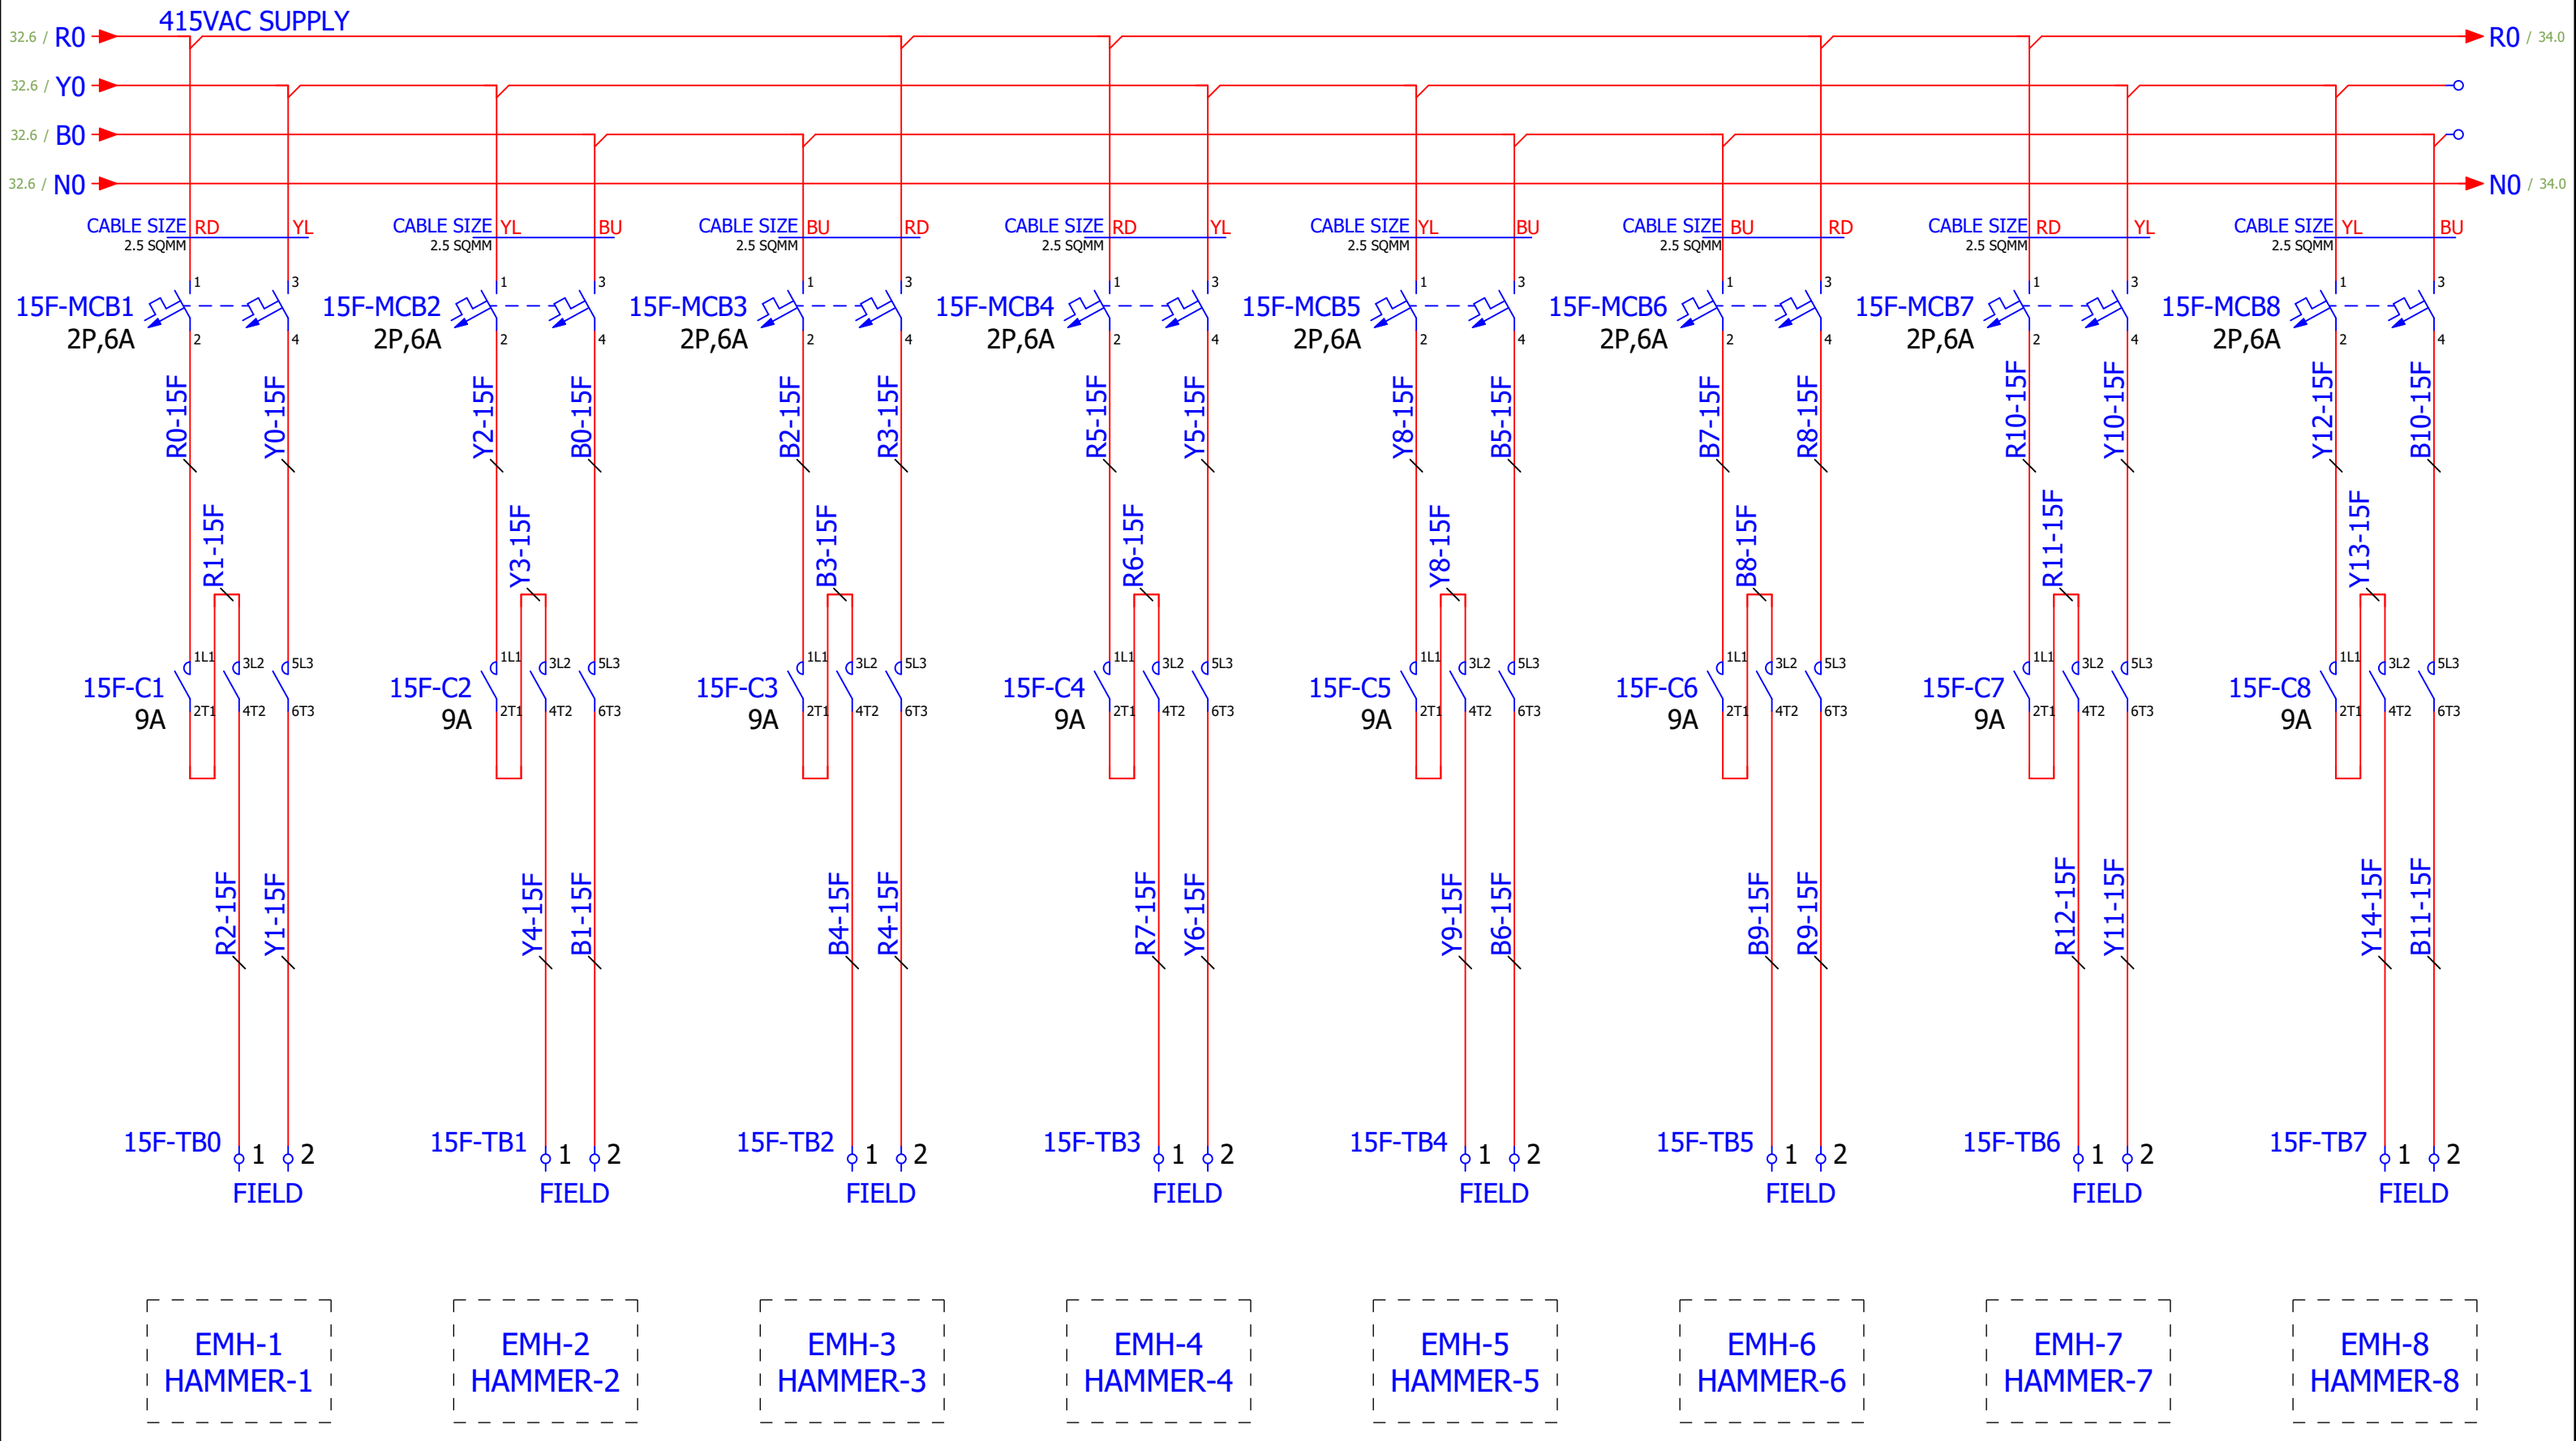

MOJJ ENGINEERING SYSTEMS LTD

REVISION	DETAILS	DATE
02	AS BUILT	
01	AS PER COMMENTS	12-05-2025
00	FOR APPROVAL	08-05-2025

TITLE:- HAMMER-SUPPLY FEEDER WIRING

FILE NO: MES / E&I / MSD-705

DRAWN BY	N.A.
CHECKED	P.B.
APPROVED	MESL


PROJECT:- SPRAY DRYER

PROJECT:- MSD-705

DRG. NO.:- 2526/PRG/MSD/705

SHEET NO. 35 / 62

REV.NO. AS BUILT

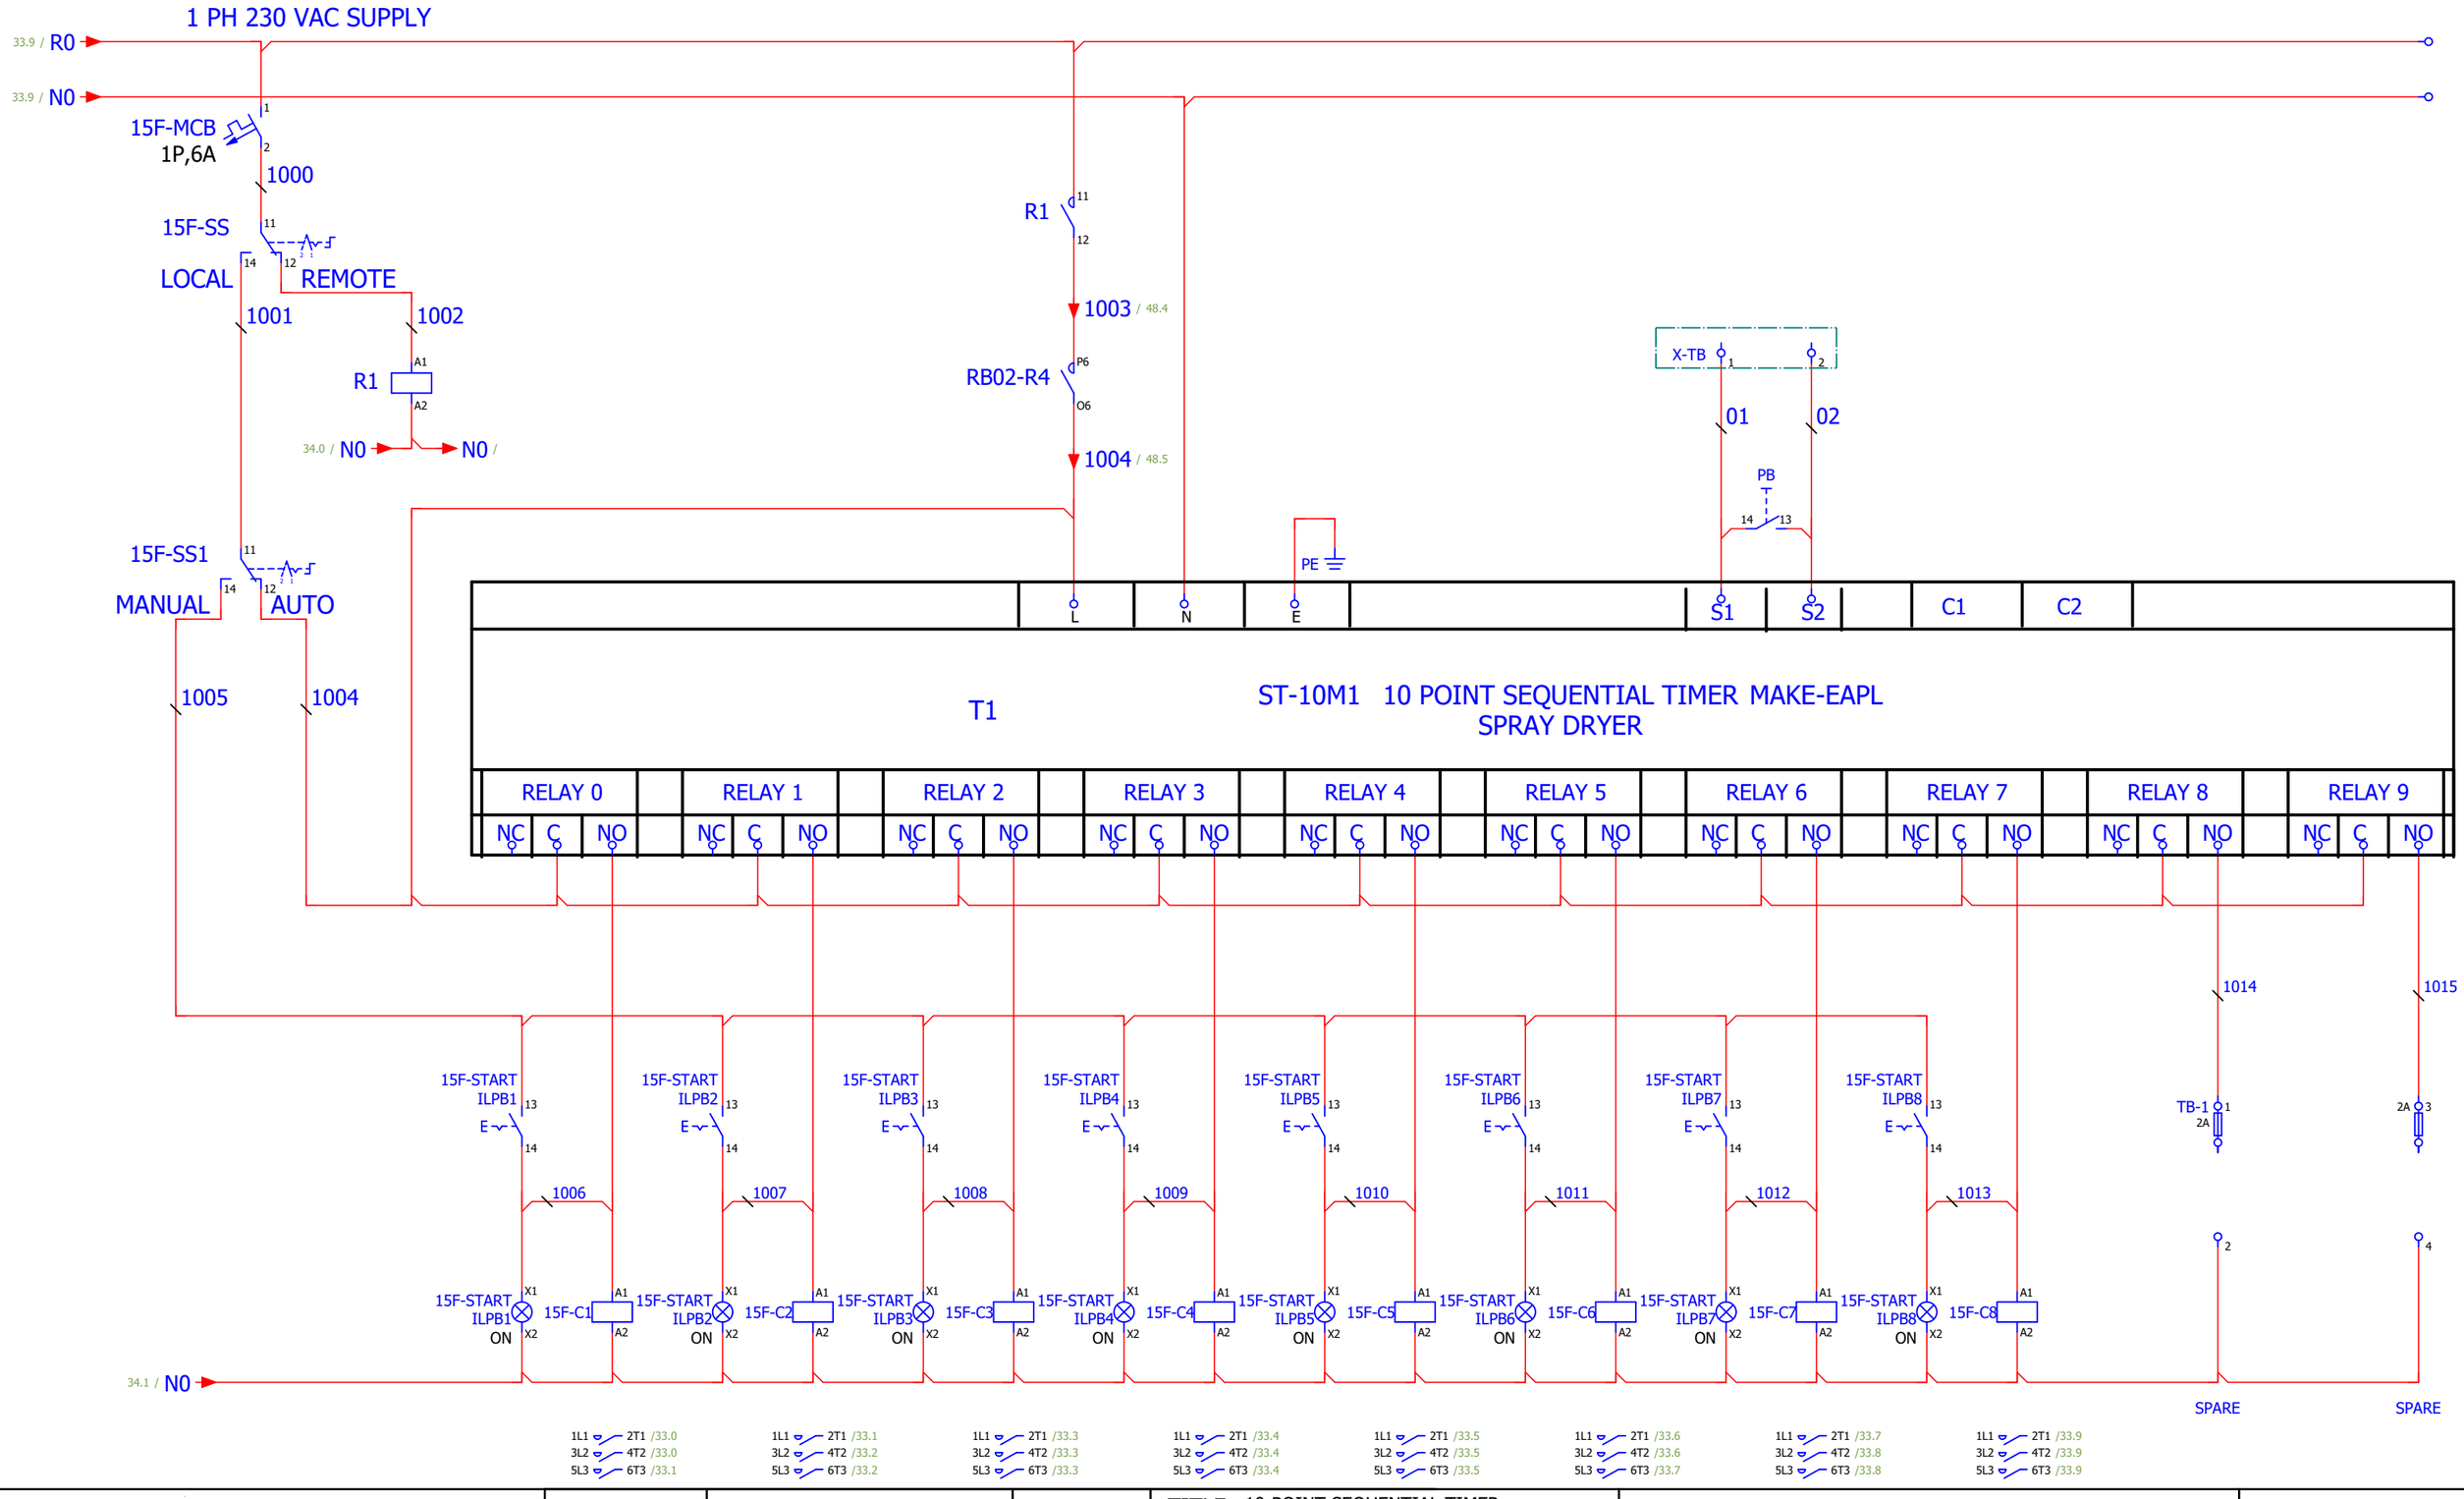


MOJJ ENGINEERING SYSTEMS LTD

REVISION	DETAILS	DATE			
02	AS BUILT		TITLE:- 10-POINT SEQUENTIAL TIMER		PROJECT:- SPRAY DRYER
			FILE NO: MES / E&I / MSD-705		
01	AS PER COMMENTS	12-05-2025	DRAWN BY	N.A.	PROJECT:- MSD-705
00	FOR APPROVAL	08-05-2025	CHECKED	P.B.	DRG. NO.:- 2526/PRG/MSD/705 / SHEET NO. 36 / 62 / REV.NO. AS BUILT
			APPROVED	MESL	

PLC WIRING DIAGRAM

MOJJ ENGINEERING SYSTEMS LTD				TITLE:- COVER PAGE			PROJECT:- SPRAY DRYER	
	02	AS BUILT		FILE NO: MES / E&I / MSD-705				
	01	AS PER COMMENTS	12-05-2025	DRAWN BY	N.A.		PROJECT:- MSD-705	
	00	FOR APPROVAL	08-05-2025	CHECKED	P.B.			
	REVISION	DETAILS	DATE	APPROVED	MESL		DRG. NO.:- 2526/PRG/MSD/705	SHEET NO. 37 / 62 REV.NO. AS BUILT

230VAC POWER SUPPLY 50Hz

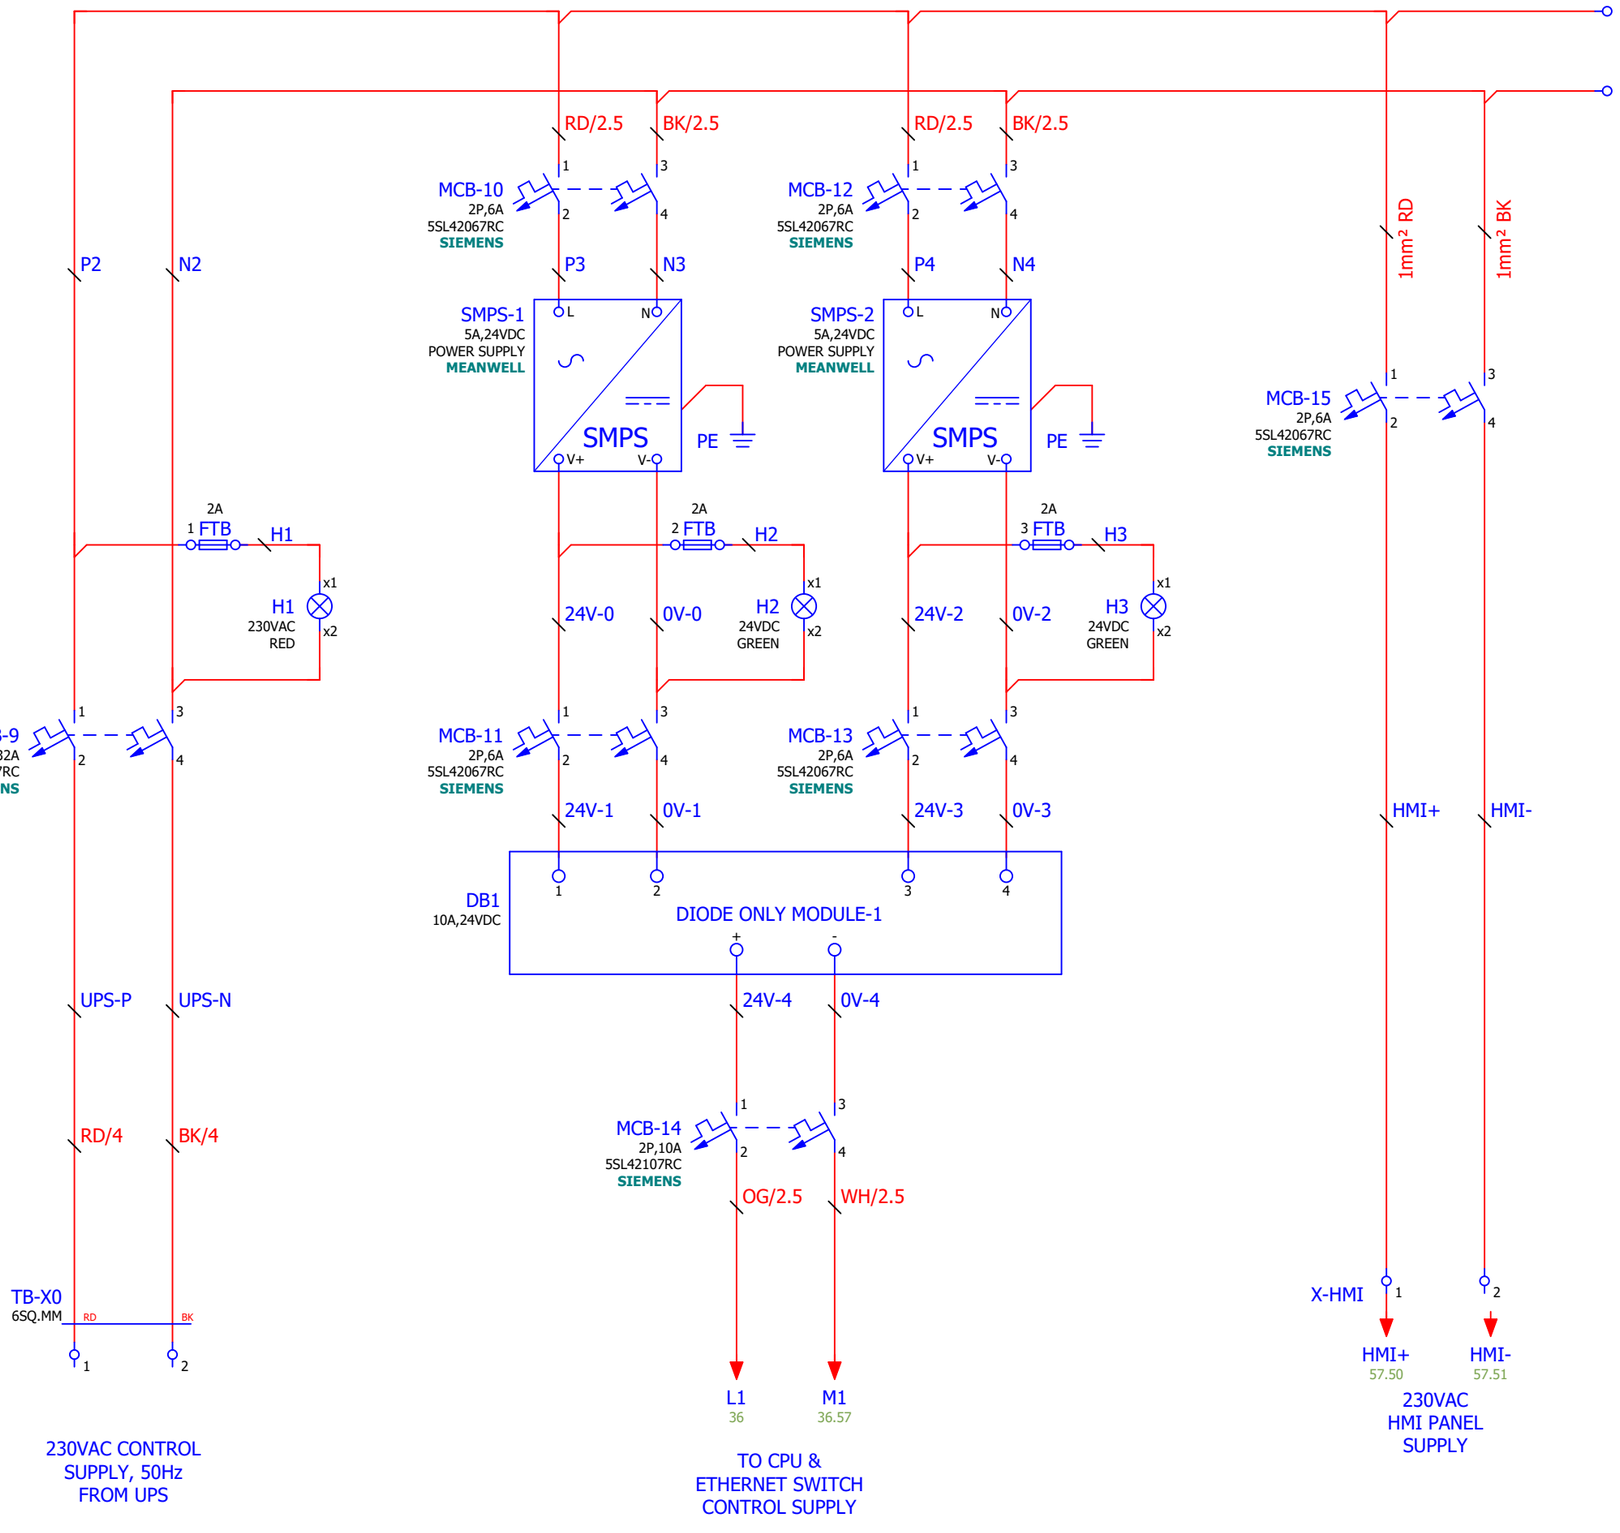


230VAC CONTROL SUPPLY, 50Hz FROM UPS

TO CPU & ETHERNET SWITCH CONTROL SUPPLY

230VAC HMI PANEL SUPPLY


24VDC POWER SUPPLY

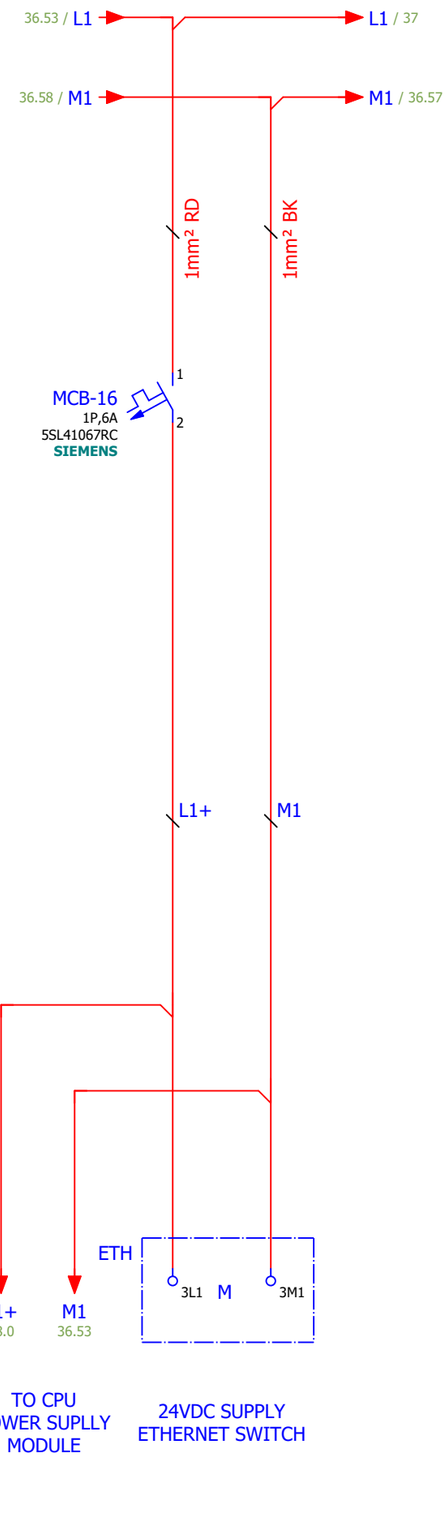

TO CPU POWER SUPLLY MODULE

24VDC SUPPLY ETHERNET SWITCH

MOJJ ENGINEERING SYSTEMS LTD					
			TITLE:- 24VDC CONTROL WIRING		PROJECT:- SPRAY DRYER
02	AS BUILT		FILE NO: MES / E&I / MSD-705		
01	AS PER COMMENTS	12-05-2025	DRAWN BY	N.A.	PROJECT:- MSD-705
00	FOR APPROVAL	08-05-2025	CHECKED	P.B.	
REVISION	DETAILS	DATE	APPROVED	MESL	DRG. NO.:- 2526/PRG/MSD/705 / SHEET NO. 38 / 62 / REV.NO. AS BUILT

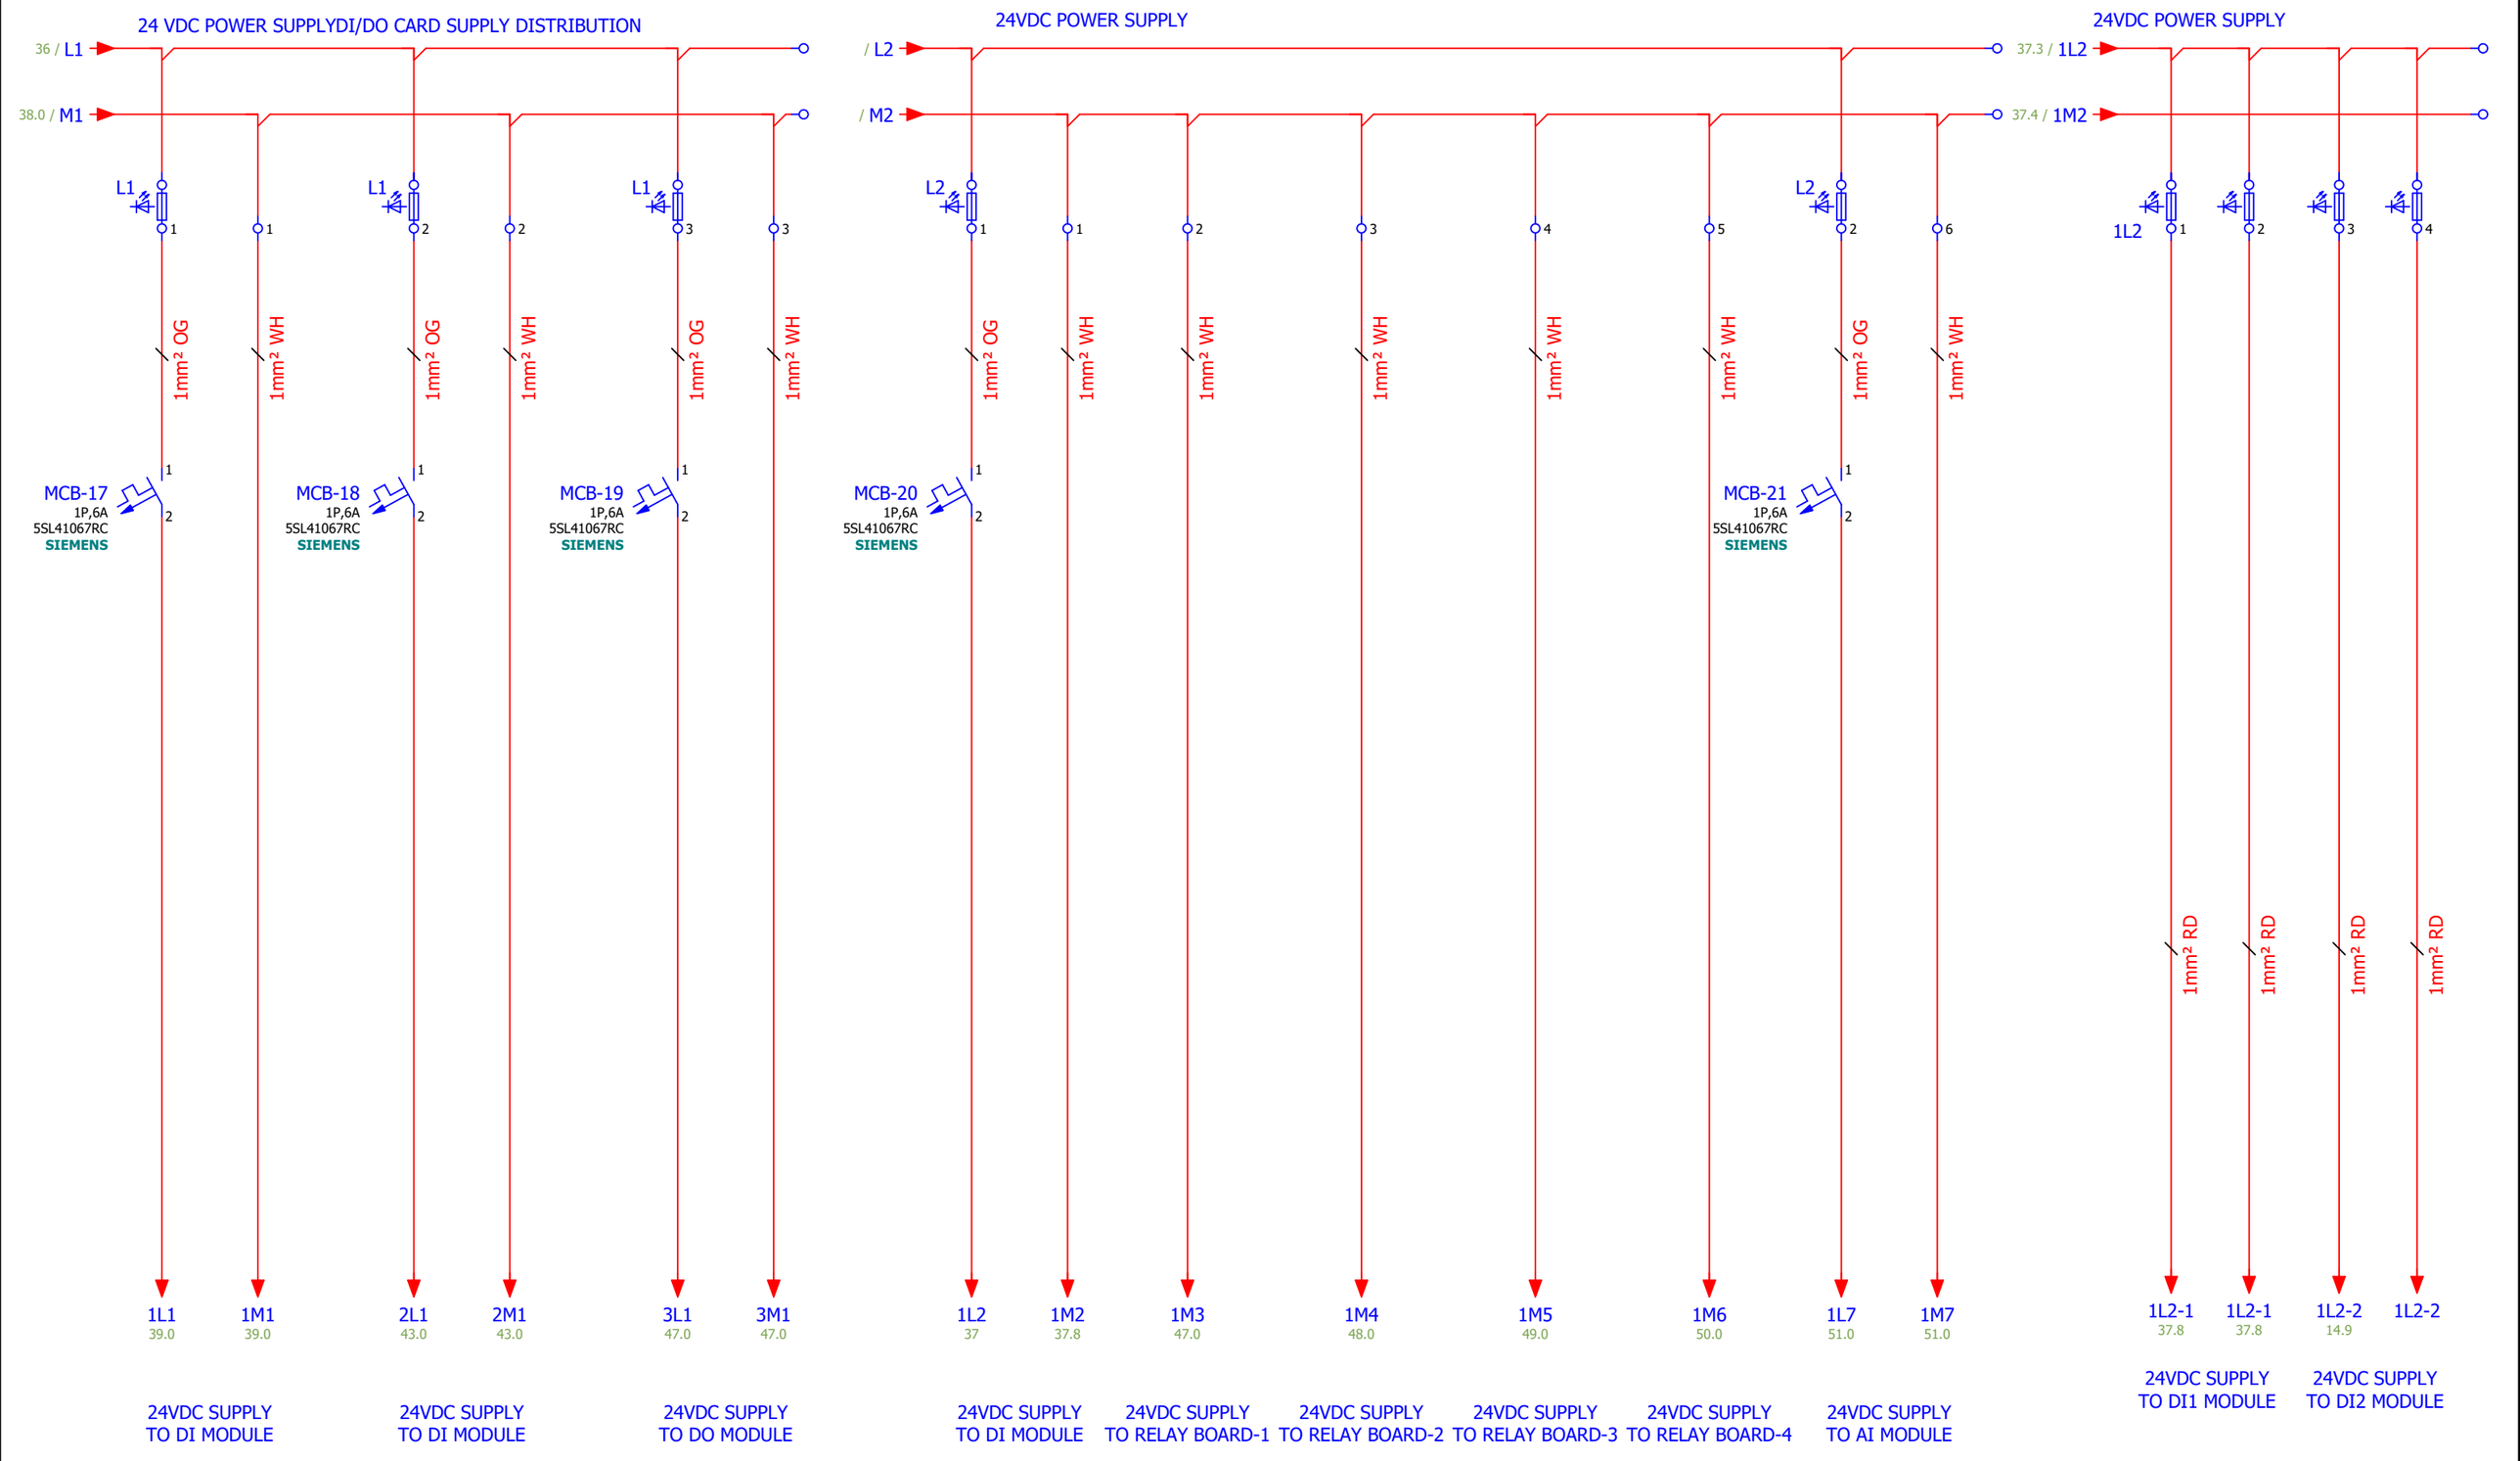

			TITLE:- 24VDC DISTRIBUTION		
02	AS BUILT		FILE NO: MES / E&I / MSD-705		
01	AS PER COMMENTS	12-05-2025	DRAWN BY	N.A.	
00	FOR APPROVAL	08-05-2025	CHECKED	P.B.	
REVISION	DETAILS	DATE	APPROVED	MESL	

MOJJ ENGINEERING SYSTEMS LTD


PROJECT:- SPRAY DRYER		
PROJECT:- MSD-705		
DRG. NO.:- 2526/PRG/MSD/705	SHEET NO. 39 / 62	REV.NO. AS BUILT

SUPPLY MODULE

BMXCPS2010

1 OF 1

Schneider Electric

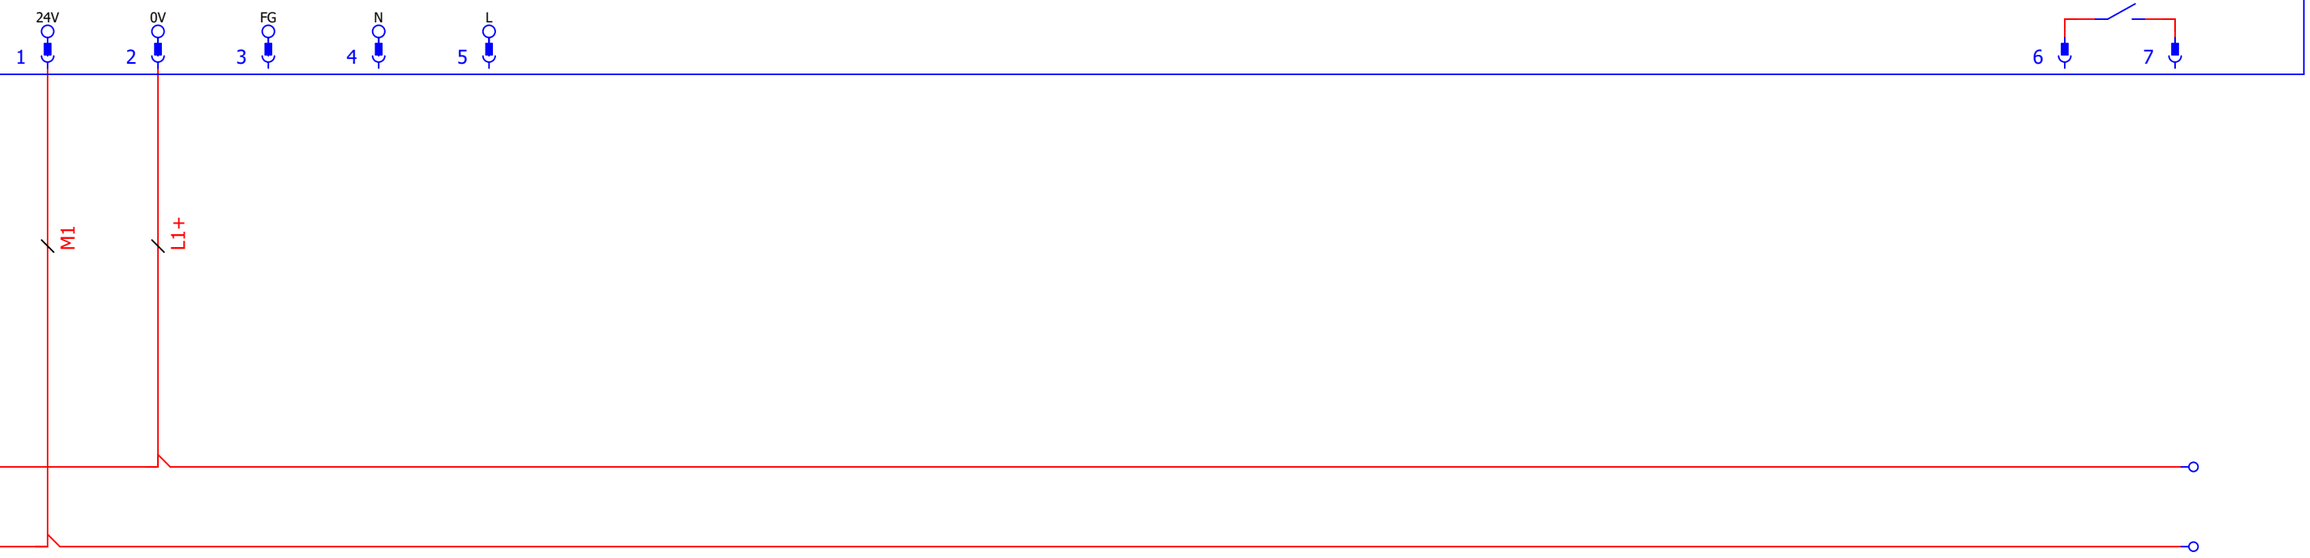

MOJJ ENGINEERING SYSTEMS LTD				TITLE:- SUPPLY MODULE		PROJECT:- SPRAY DRYER	
	02	AS BUILT		FILE NO: MES / E&I / MSD-705			
	01	AS PER COMMENTS	12-05-2025	DRAWN BY	N.A.	PROJECT:- MSD-705	
	00	FOR APPROVAL	08-05-2025	CHECKED	P.B.	DRG. NO.:- 2526/PRG/MSD/705	SHEET NO. 40 / 62
	REVISION	DETAILS	DATE	APPROVED	MESL		REV.NO. AS BUILT

DI1 | 32 DI DIGITAL INPUT MODULE-1 | BMXDDI3202K | DI 32x24VDC | 1 OF 4 | Schneider Electric

SPS1+ SPS1- I0 I1 I2 I3 I4 I5 I6 I7

1L1 1M1

37.0 / 1L1 → 1L1 / 40.0

37.1 / 1M1 → 1M1 / 40.0

39.9 / 1L2-1 → 1L2-1 / 39.0

OG/0.5 BL/0.5 OG/0.5 BL/0.5 OG/0.5 BL/0.5 OG/0.5 BL/0.5 OG/0.5 BL/0.5 OG/0.5 BL/0.5 OG/0.5 BL/0.5 OG/0.5 BL/0.5

I0:1/0 I0:1/1 I0:1/2 I0:1/3 I0:1/4 I0:1/5 I0:1/6 I0:1/7

1F-R1	1F-R2	1F-SS	2F-R1	2F-R2	2F-SS	3F-R1	3F-R2
/17.6	/18.8	/18.4	/19.6	/20.8	/20.4	/21.6	/22.8
15 16	15 16	15 16	15 16	15 16	15 16	15 16	15 16

PANEL SECTION

FIELD SECTION

TAG :	(BL-02) O/F	(BL-02) T/F	(BL-02) AM/F	(ATM-01) O/F	(ATM-01) T/F	(ATM-01) AM/F	(PU-01) O/F	(PU-01) T/F
DESC :	MAIN ID BLOWER (BL-02) ON F/B	MAIN ID BLOWER (BL-02) TRIP F/B	VFD FOR MAIN ID BLOWER (BL-02) AUTO/MANUAL F/B	ATOMIZER MOTOR (ATM-01) ON F/B	ATOMIZER MOTOR (ATM-01) F/B	ATOMIZER MOTOR (ATM-01) AUTO/MANUAL F/B	FEED PUMP-A (PU-01) ON F/B	FEED PUMP-A (PU-01) TRIP F/B

NOTE-TYPE OF TERMINALS USED
1 -NORMAL TERMINAL
2 -FUSED TERMINAL 500mA

MOJJ ENGINEERING SYSTEMS LTD

REVISION	DETAILS	DATE			
02	AS BUILT		TITLE:- 32DI-DIGITAL INPUT WIRING-1		
			FILE NO: MES / E&I / MSD-705		
01	AS PER COMMENTS	12-05-2025	DRAWN BY	N.A.	
00	FOR APPROVAL	08-05-2025	CHECKED	P.B.	
			APPROVED	MESL	

PROJECT:- SPRAY DRYER

PROJECT:- MSD-705

DRG. NO.:- 2526/PRG/MSD/705 | SHEET NO. 41 / 62 | REV.NO. AS BUILT

DI1 32 DI DIGITAL INPUT MODULE-1 BMXDDI3202K DI 32x24VDC 2 OF 4

Schneider Electric

SPS1+ SPS1- I8 I9 I00 I01 I02 I03 I04 I05

1L1 1M1

39.1 / 1L1 → 1L1 / 41.0

39.1 / 1M1 → 1M1 / 41.0

40.9 / 1L2-1 → 1L2-1 / 40.0

OG/0.5	BL/0.5	OG/0.5	BL/0.5	OG/0.5	BL/0.5	OG/0.5	BL/0.5	OG/0.5	BL/0.5
IO:1/8	IO:1/9	IO:1/10	IO:1/11	IO:1/12	IO:1/13	IO:1/14	IO:1/15		
15	15	15	15	15	15	15	15		
3F-SS /22.4	4F-C2 /23.5	4F-R1 /23.6	5F-C2 /24.5	5F-R1 /24.6	6F-C2 /25.5	6F-R1 /25.6	7F-C1 /26.4		
16	16	16	16	16	16	16	16		

PANEL SECTION

FIELD SECTION

TAG :	(PU-01) AM/F	(BL-01) O/F	(BL-01) T/F	(PU-03) O/F	(PU-03) T/F	(SP-01) O/F	(SP-01) T/F	(PU-02) O/F
DESC :	FEED PUMP-A (PU-01) AUTO/MANUAL F/B	FD BLOWER (BL-01) ON F/B	FD BLOWER (BL-01) TRIP F/B	CIP PUMP (PU-03) ON F/B	CIP PUMP (PU-03) TRIP F/B	SPARE FEEDER (SP-01) ON F/B	SPARE FEEDER (SP-01) TRIP F/B	SCRUBBER PUMP-A (PU-02) ON F/B

NOTE-TYPE OF TERMINALS USED

1 -NORMAL TERMINAL

2 -FUSED TERMINAL 500mA

MOJJ ENGINEERING SYSTEMS LTD

REVISION	DETAILS	DATE			
02	AS BUILT		TITLE:- 32DI-DIGITAL INPUT WIRING-1		
			FILE NO: MES / E&I / MSD-705		
01	AS PER COMMENTS	12-05-2025	DRAWN BY	N.A.	
00	FOR APPROVAL	08-05-2025	CHECKED	P.B.	
			APPROVED	MESL	

PROJECT:- SPRAY DRYER

PROJECT:- MSD-705

DRG. NO.:- 2526/PRG/MSD/705 | SHEET NO. 42 / 62 | REV.NO. AS BUILT

DI1 32 DI DIGITAL INPUT MODULE-1 BMXDDI3202K DI 32x24VDC 3 OF 4

Schneider Electric

SPS2+ SPS2- I16 I17 I18 I19 I20 I21 I22 I23

1L1 1M1

40.1 / 1L1 → 1L1 / 42.0

40.1 / 1M1 → 1M1 / 42.0

41.9 / 1L2-1 → 1L2-1 / 41.0

OG/0.5 BL/0.5 OG/0.5 BL/0.5 OG/0.5 BL/0.5 OG/0.5 BL/0.5 OG/0.5 BL/0.5 OG/0.5 BL/0.5 OG/0.5 BL/0.5 OG/0.5 BL/0.5

I0:1/16 I0:1/17 I0:1/18 I0:1/19 I0:1/20 I0:1/21 I0:1/22 I0:1/23

15 16

7F-R1 /26.6

8F-C1 /27.4

8F-R1 /27.6

9F-C1 /28.3

9F-A2 /28.8

9F-A3 /29.3

9F-A4 /29.4

10F-C1 /30.4

PANEL SECTION

FIELD SECTION

TAG :	(PU-02) T/F	(SP-02) O/F	(SP-02) T/F	(BR-01) BR O/F	(BR-01) BR T/F	(BR-01) HG/F	(BR-01) LW/F	(RTV-01) O/F
DESC :	SCRUBBER PUMP-A (PU-02) TRIP F/B	SPARE FEEDER (SP-02) ON F/B	SPARE FEEDER (SP-02) TRIP F/B	BURNER (BR-01) ON F/B	BURNER (BR-01) LOCKOUT F/B	BURNER HIGH FLAME F/B	BURNER LOW FLAME F/B	ROTARY VALVE FOR CYCLONE [CY-01] MOTOR (RTV-01) ON F/B

NOTE-TYPE OF TERMINALS USED

1 -NORMAL TERMINAL

2 -FUSED TERMINAL 500mA

MOJJ ENGINEERING SYSTEMS LTD

REVISION	DETAILS	DATE			
02	AS BUILT		TITLE:- 32DI-DIGITAL INPUT WIRING-1		
			FILE NO: MES / E&I / MSD-705		
01	AS PER COMMENTS	12-05-2025	DRAWN BY	N.A.	
00	FOR APPROVAL	08-05-2025	CHECKED	P.B.	
			APPROVED	MESL	

PROJECT:- SPRAY DRYER

PROJECT:- MSD-705

DRG. NO.:- 2526/PRG/MSD/705 | SHEET NO. 43 / 62 | REV.NO. AS BUILT

DI1

32 DI DIGITAL INPUT MODULE-1 | BMXDDI3202K | DI 32x24VDC | 4 OF 4

Schneider Electric

SPS2+ SPS2- I24 I25 I26 I27 I28 I29 I30 I31

1L1 1M1

41.1 / 1L1

41.1 / 1M1

42.9 / 1L2-1

1L2-1 / 42.0

OG/0.5 BL/0.5 OG/0.5 BL/0.5 OG/0.5 BL/0.5 OG/0.5 BL/0.5 OG/0.5 BL/0.5 OG/0.5 BL/0.5 OG/0.5 BL/0.5 OG/0.5 BL/0.5

IO:1/24 IO:1/25 IO:1/26 IO:1/27 IO:1/28 IO:1/29 IO:1/30 IO:1/31

10F-R1 /30.6 (15, 16)

11F-C1 /31.4 (15, 16)

11F-R1 /31.6 (15, 16)

XDI1 (1, 2, 3, 4, 5, 6, 7, 8, 9, 10)

PANEL SECTION

FIELD SECTION

TAG :	DESC :
(RTV-01) T/F	ROTARY VALVE FOR CYCLONE [CY-01] MOTOR (RTV-01) TRIP F/B
(LOP-01) O/F	LUBRICATION OIL PUMP (LOP-01) ON F/B
(LOP-01) T/F	LUBRICATION OIL PUMP (LOP-01) TRIP F/B
(FS-401) H/F	LUBRICATION OIL FLOW SWITCH (FS-401)
(FS-401) HL/F	OIL HIGH LEVEL/ LOW LEVEL SWITCH
(CIPW-01) FWD/F	CIP WINCH (CIPW-01) FWD F/B
(CIPW-01) REV/F	CIP WINCH (CIPW-01) REV F/B
(CIPW-01) T/F	CIP WINCH (CIPW-01) TRIP F/B

NOTE-TYPE OF TERMINALS USED

1 -NORMAL TERMINAL

2 -FUSED TERMINAL 500mA

MOJJ ENGINEERING SYSTEMS LTD

REVISION	DETAILS	DATE			
02	AS BUILT		TITLE:- 32DI-DIGITAL INPUT WIRING-1		
			FILE NO: MES / E&I / MSD-705		
01	AS PER COMMENTS	12-05-2025	DRAWN BY	N.A.	
00	FOR APPROVAL	08-05-2025	CHECKED	P.B.	
			APPROVED	MESL	

PROJECT:- SPRAY DRYER

PROJECT:- MSD-705

DRG. NO.:- 2526/PRG/MSD/705 | SHEET NO. 44 / 62 | REV.NO. AS BUILT

DI2 | 32 DI DIGITAL INPUT MODULE-2 | BMXDDI3202K | DI 32x24VDC | 1 OF 4 | Schneider Electric

SPS1+ SPS1- I0 I1 I2 I3 I4 I5 I6 I7

2L1 2M1

37.1 / 2L1 → 2L1 / 44.0

37.2 / 2M1 → 2M1 / 44.0

43.4 / 1L2-2 → 1L2-2 / 44.0

OG/0.5 BL/0.5 OG/0.5 BL/0.5 OG/0.5 BL/0.5 OG/0.5 BL/0.5 OG/0.5 BL/0.5 OG/0.5 BL/0.5 OG/0.5 BL/0.5 OG/0.5 BL/0.5

I0:2/0 I0:2/1 I0:2/2 I0:2/3 I0:2/4 I0:2/4-1 I0:2/5 I0:2/6 I0:2/7

PANEL SECTION

FIELD SECTION

XDI2 (1, 2)

15F-SS (15, 16)

R-C2 /16.8 (15, 16)

1L2-2 43.0

I0:2/3 14.9

E-STOP /43.6 (11, 12)

E-STOP /43.6 (11, 12)

HOOTER ACK. (15, 16)

9F-A1 (15, 16)

(3, 4, 5, 6)

TAG :	DESC :
(CIPW-01) AM/F	CIP WINCH (CIPW-01) AUTO/MANUAL F/B
(HM01) AM/F	HAMMER AUTO/MAN F/B
(MCC01)AM/F	MCC AUTO / MAUNAL F/B
RYB/F	R,Y,B PHASE FAIL F/B
PLC/F	PLC EMERGENCY F/B
H/ACK/F	HOOTER ACK F/B
(BR-01) BR R/F	BURNER RUN F/B
DI SP-01	DI SPARE 1

NOTE-TYPE OF TERMINALS USED

1 -NORMAL TERMINAL

2 -FUSED TERMINAL 500mA

MOJJ ENGINEERING SYSTEMS LTD

REVISION	DETAILS	DATE
02	AS BUILT	
01	AS PER COMMENTS	12-05-2025
00	FOR APPROVAL	08-05-2025

TITLE:- 32DI-DIGITAL INPUT WIRING-2

FILE NO: MES / E&I / MSD-705

DRAWN BY N.A.

CHECKED P.B.

APPROVED MESL

PROJECT:- SPRAY DRYER

PROJECT:- MSD-705

DRG. NO.:- 2526/PRG/MSD/705

SHEET NO. 45 / 62

REV.NO. AS BUILT

DI2 | 32 DI DIGITAL INPUT MODULE-2 | BMXDDI3202K | DI 32x24VDC | 2 OF 4 | Schneider Electric

SPS1+ SPS1- I8 I9 I10 I11 I12 I13 I14 I15

2L1 2M1

43.1 / 2L1 → 2L1 / 45.0

43.1 / 2M1 → 2M1 / 45.0

43.9 / 1L2-2 → 1L2-2 / 45.0

OG/0.5 BL/0.5 OG/0.5 BL/0.5 OG/0.5 BL/0.5 OG/0.5 BL/0.5 OG/0.5 BL/0.5 OG/0.5 BL/0.5 OG/0.5 BL/0.5 OG/0.5 BL/0.5 9

I0:2/8 I0:2/9 I0:2/10 I0:2/11 I0:2/12 I0:2/13 I0:2/14 I0:2/15

PANEL SECTION

XDI2 7 8 9 10 11 12 13 14 15 16 17 18 19 20 21 22

FIELD SECTION

TAG :	DI SP-02	DI SP-03	DI SP-04	DI SP-05	DI SP-06	DI SP-07	DI SP-08	DI SP-09
DESC :	DI SPARE 2	DI SPARE 3	DI SPARE 4	DI SPARE 5	DI SPARE 6	DI SPARE 7	DI SPARE 8	DI SPARE 9

NOTE-TYPE OF TERMINALS USED
1 -NORMAL TERMINAL
2 -FUSED TERMINAL 500mA

MOJJ ENGINEERING SYSTEMS LTD

REVISION	DETAILS	DATE			
02	AS BUILT		TITLE:- 32DI-DIGITAL INPUT WIRING-2		
			FILE NO: MES / E&I / MSD-705		
01	AS PER COMMENTS	12-05-2025	DRAWN BY	N.A.	
00	FOR APPROVAL	08-05-2025	CHECKED	P.B.	
			APPROVED	MESL	

PROJECT:- SPRAY DRYER

PROJECT:- MSD-705

DRG. NO.:- 2526/PRG/MSD/705 | SHEET NO. 46 / 62 | REV.NO. AS BUILT

DI2 | 32 DI DIGITAL INPUT MODULE-2 | BMXDDI3202K | DI 32x24VDC | 3 OF 4 | Schneider Electric

SPS2+ SPS2- I16 I17 I18 I19 I20 I21 I22 I23

2L1 2M1

44.1 / 2L1 → 2L1 / 46.0

44.1 / 2M1 → 2M1 / 46.0

44.9 / 1L2-2 → 1L2-2 / 46.0

OG/0.5 BL/0.5 OG/0.5 BL/0.5 OG/0.5 BL/0.5 OG/0.5 BL/0.5 OG/0.5 BL/0.5 OG/0.5 BL/0.5 OG/0.5 BL/0.5 OG/0.5 BL/0.5

I0:2/16 I0:2/17 I0:2/18 I0:2/19 I0:2/20 I0:2/21 I0:2/22 I0:2/23

PANEL SECTION

XDI2 23 24 25 26 27 28 29 30 31 32 33 34 35 36 37 38

FIELD SECTION

TAG :	DI SP-10	DI SP-11	DI SP-12	DI SP-13	DI SP-14	DI SP-15	DI SP-16	DI SP-17
DESC :	DI SPARE 10	DI SPARE 11	DI SPARE 12	DI SPARE 13	DI SPARE 14	DI SPARE 15	DI SPARE 16	DI SPARE 17

NOTE-TYPE OF TERMINALS USED

1 -NORMAL TERMINAL

2 -FUSED TERMINAL 500mA

MOJJ ENGINEERING SYSTEMS LTD

REVISION	DETAILS	DATE			
02	AS BUILT		TITLE:- 32DI-DIGITAL INPUT WIRING-2		
01	AS PER COMMENTS	12-05-2025	FILE NO: MES / E&I / MSD-705		
00	FOR APPROVAL	08-05-2025	DRAWN BY	N.A.	
			CHECKED	P.B.	
			APPROVED	MESL	

PROJECT:- SPRAY DRYER

PROJECT:- MSD-705

DRG. NO.:- 2526/PRG/MSD/705 | SHEET NO. 47 / 62 | REV.NO. AS BUILT

DI2

32 DI DIGITAL INPUT MODULE-2 | BMXDDI3202K | DI 32x24VDC | 4 OF 4

SPS2+ SPS2- I24 I25 I26 I27 I28 I29 I30 I31

2L1 2M1

45.1 / 2L1

45.1 / 2M1

45.9 / 1L2-2

1L2-2 /

OG/0.5 BL/0.5 OG/0.5 BL/0.5 OG/0.5 BL/0.5 OG/0.5 BL/0.5 OG/0.5 BL/0.5 OG/0.5 BL/0.5 OG/0.5 BL/0.5 OG/0.5 BL/0.5

I0:2/24 I0:2/25 I0:2/26 I0:2/27 I0:2/28 I0:2/29 I0:2/30 I0:2/31

PANEL SECTION

XDI2 39 40 41 42 43 44 45 46 47 48 49 50 51 52 53 54

FIELD SECTION

TAG :	DI SP-18	DI SP-19	DI SP-20	DI SP-21	DI SP-22	DI SP-23	DI SP-24	DI SP-25
DESC :	DI SPARE 18	DI SPARE 19	DI SPARE 20	DI SPARE 21	DI SPARE 22	DI SPARE 23	DI SPARE 24	DI SPARE 25

NOTE-TYPE OF TERMINALS USED

1 -NORMAL TERMINAL

2 -FUSED TERMINAL 500mA

MOJJ ENGINEERING SYSTEMS LTD

REVISION	DETAILS	DATE			
02	AS BUILT		TITLE:- 32DI-DIGITAL INPUT WIRING-2		
			FILE NO: MES / E&I / MSD-705		
01	AS PER COMMENTS	12-05-2025	DRAWN BY	N.A.	
00	FOR APPROVAL	08-05-2025	CHECKED	P.B.	
			APPROVED	MESL	

PROJECT:- SPRAY DRYER

PROJECT:- MSD-705

DRG. NO.:- 2526/PRG/MSD/705 | SHEET NO. 48 / 62 | REV.NO. AS BUILT

DO1

32 DO DIGITAL OUTPUT MODULE-1 | BMXDDO3202K | DO 32x24VDC | 1 OF 4

Schneider Electric

PSPS1+ PPS1- Q0 Q1 Q2 Q3 Q4 Q5 Q6 Q7

3L1 3M1 Q0:3/0 Q0:3/1 Q0:3/2 Q0:3/3 Q0:3/4 Q0:3/5 Q0:3/6 Q0:3/7

37.2 / 3L1 → 3L1 / 48.0

37.3 / 3M1 → 3M1 / 48.0

37.4 / 1M3

RELAY BOARD-1
8 CH (RB-01) 24VDC-1C/0

-1 +1	-2 +2	-3 +3	-4 +4	-5 +5	-6 +6	-7 +7	-8 +8
A1	A1	A1	A1	A1	A1	A1	A1
RB01-R1	RB01-R2	RB01-R3	RB01-R4	RB01-R5	RB01-R6	RB01-R7	RB01-R8
A2	A2	A2	A2	A2	A2	A2	A2
P1 C1 O1	P2 C2 O2	P3 C3 O3	P4 C4 O4	P5 C5 O5	P6 C6 O6	P7 C7 O7	P8 C8 O8

PANEL SECTION

FIELD SECTION

6-1F 17.5	7-1F 17.5	6-2F 19.5	7-2F 19.5	6-3F 21.5	7-3F 21.5	6-4F 23.5	7-4F 23.5
6-5F 24.5	7-5F 24.5	6-6F 25.5	7-6F 25.5	6-7F 26.5	7-7F 26.5	6-8F 27.5	7-8F 27.5

TAG :	(P-SPD-401/2A) CMD	(ATM-01) CMD	(PU-01) CMD	(BL-01) CMD	(PU-03) CMD	(SP-01) CMD	(PU-02) CMD	(SP-02) CMD
DESC :	MAIN ID BLOWER (BL-02) START/STOP CMD	ATOMIZER (ATM-01) START/STOP CMD	FEED PUMP-A (PU-01) START/STOP CMD	FD BLOWER (BL-01) START/STOP CMD	CIP PUMP (PU-03) START/STOP CMD	SPARE-01 (SP-01) START/STOP CMD	SCRUBBER PUMP-A (PU-02) START/STOP CMD	SPARE-02 (SP-02) START/STOP CMD
	P1 O1 /17.5	P1 O1 /19.5	P1 O1 /21.5	P1 O1 /23.5	P1 O1 /24.5	P1 O1 /25.5	P5 O5 /26.5	P5 O5 /27.5

NOTE-TYPE OF TERMINALS USED

1 -NORMAL TERMINAL

2 -FUSED TERMINAL 500mA

MOJJ ENGINEERING SYSTEMS LTD

REVISION	DETAILS	DATE			
02	AS BUILT		TITLE:- 32DO-DIGITAL OUTPUT WIRING-1		
01	AS PER COMMENTS	12-05-2025	FILE NO: MES / E&I / MSD-705		
00	FOR APPROVAL	08-05-2025	DRAWN BY	N.A.	
			CHECKED	P.B.	
			APPROVED	MESL	

PROJECT:- SPRAY DRYER

PROJECT:- MSD-705

DRG. NO.:- 2526/PRG/MSD/705 | SHEET NO. 49 / 62 | REV.NO. AS BUILT

DO1 | 32 DO DIGITAL OUTPUT MODULE-1 | BMXDDO3202K | DO 32x24VDC | 2 OF 4 | Schneider Electric

PPS1+ PPS1- Q8 Q9 Q10 Q11 Q12 Q13 Q14 Q15

3L1 3M1 Q0:3/8 Q0:3/9 Q0:3/10 Q0:3/11 Q0:3/12 Q0:3/13 Q0:3/14 Q0:3/15

47.1 / 3L1 → 3L1 / 48.5

47.1 / 3M1 → 3M1 / 48.6

37.5 / 1M4

RELAY BOARD-2
8 CH (RB-02) 24VDC-1C/0

-1 +1	-2 +2	-3 +3	-4 +4	-5 +5	-6 +6	-7 +7	-8 +8
A1	A1	A1	A1	A1	A1	A1	A1
RB02-R1	RB02-R2	RB02-R3	RB02-R4	RB02-R5	RB02-R6	RB02-R7	RB02-R8
A2	A2	A2	A2	A2	A2	A2	A2
P1 C1 O1	P2 C2 O2	P3 C3 O3	P4 C4 O4	P5 C5 O5	P6 C6 O6	P7 C7 O7	P8 C8 O8

500 501 502 503 504 505 506

HOOTER 24VDC (x1, x2)

XDO1 1 2 3 4 5 6

PANEL SECTION

FIELD SECTION

5-9F 28.4	6-9F 28.4	6-10F 30.5	7-10F 30.5	6-11F 31.5	7-11F 31.5	1003 34.4	1004 34.4
3L1 48.1	3M1 48.1						

TAG :	(BL-02) CMD	(CY-01) CMD	(LOP-01) CMD	EH-101-CMD	HMT-01 CMD	(BR-01) RST CMD	(CIPW-01) FWD CMD	(CIPW-01) REV CMD
DESC :	BURNER (BR-01) START/STOP CMD	ROTARY VALVE FOR CYCLONE (CY-01) START/STOP CMD	LUBRICATION OIL PUMP (LOP-01) START/STOP CMD	HAMMER TIMER (HM01) ON CMD	HOOTER ON CMD	BURNER (BR-01) RESET CMD	CIP WINCH (CIPW-01) FWD START/STOP CMD	CIP WINCH (CIPW-01) REV START/STOP CMD
	P8 O8 /28.4	P5 O5 /30.5	P5 O5 /31.5	P6 O6 /34.4				

NOTE-TYPE OF TERMINALS USED
1 -NORMAL TERMINAL
2 -FUSED TERMINAL 500mA

MOJJ ENGINEERING SYSTEMS LTD


REVISION	DETAILS	DATE			
02	AS BUILT		FILE NO:	MES / E&I / MSD-705	
01	AS PER COMMENTS	12-05-2025	DRAWN BY	N.A.	
00	FOR APPROVAL	08-05-2025	CHECKED	P.B.	
			APPROVED	MESL	

TITLE:- 32DO-DIGITAL OUTPUT WIRING-1

PROJECT:- SPRAY DRYER

PROJECT:- MSD-705

DRG. NO.:- 2526/PRG/MSD/705 | SHEET NO. 50 / 62 | REV.NO. AS BUILT

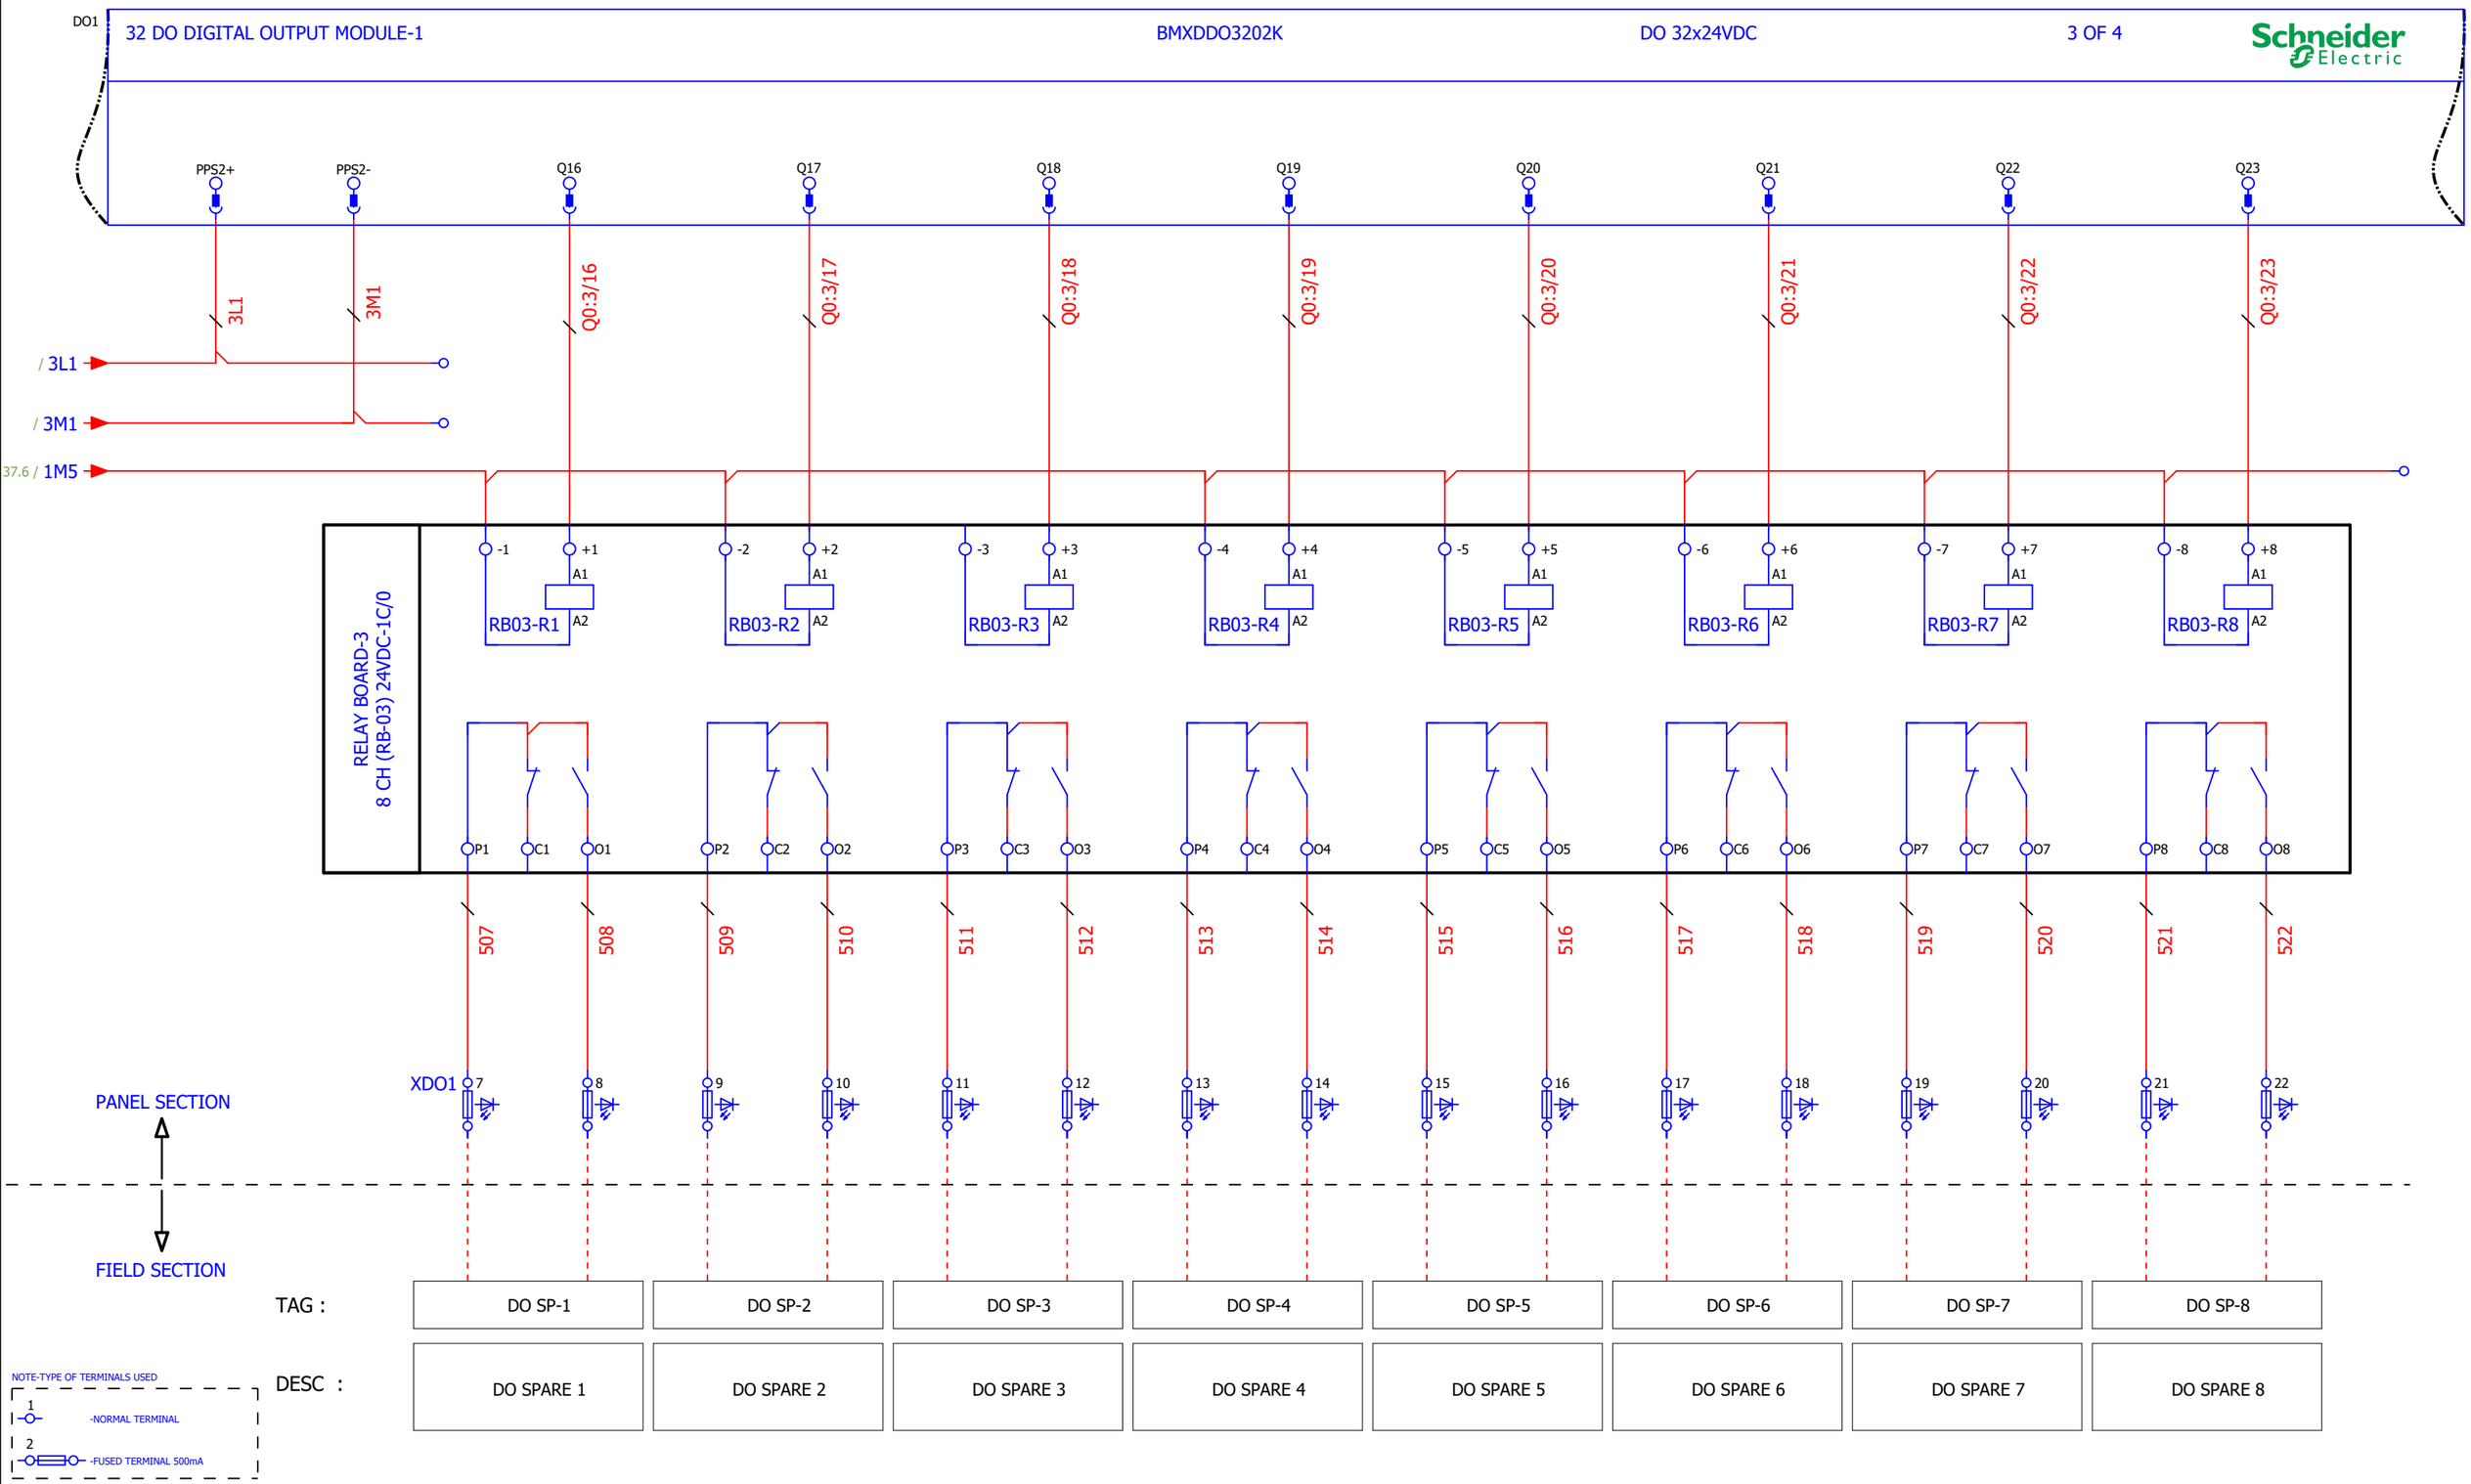

MOJJ ENGINEERING SYSTEMS LTD

REVISION	DETAILS	DATE			
02	AS BUILT		TITLE:- 32DO-DIGITAL OUTPUT WIRING-1		
01	AS PER COMMENTS	12-05-2025	FILE NO: MES / E&I / MSD-705		
00	FOR APPROVAL	08-05-2025	DRAWN BY	N.A.	
			CHECKED	P.B.	
			APPROVED	MESL	

PROJECT:- SPRAY DRYER		
PROJECT:- MSD-705		
DRG. NO.:- 2526/PRG/MSD/705	SHEET NO. 51 / 62	REV.NO. AS BUILT

DO1

32 DO DIGITAL OUTPUT MODULE-1 | BMXDDO3202K | DO 32x24VDC | 4 OF 4

Schneider Electric

Q24 Q25 Q26 Q27 Q28 Q29 Q30 Q31

Q0:3/24 Q0:3/25 Q0:3/26 Q0:3/27 Q0:3/28 Q0:3/29 Q0:3/30 Q0:3/31

37.6 / 1M6

RELAY BOARD-4
8 CH (RB-04) 24VDC-1C/0

-1 +1 A1 RB04-R1 A2
-2 +2 A1 RB04-R2 A2
-3 +3 A1 RB04-R3 A2
-4 +4 A1 RB04-R4 A2
-5 +5 A1 RB04-R5 A2
-6 +6 A1 RB04-R6 A2
-7 +7 A1 RB04-R7 A2
-8 +8 A1 RB04-R8 A2

P1 C1 O1 | P2 C2 O2 | P3 C3 O3 | P4 C4 O4 | P5 C5 O5 | P6 C6 O6 | P7 C7 O7 | P8 C8 O8

523 524 525 526 527 528 529 530 531 532 533 534 535 536 537 538

PANEL SECTION

XDO1 23 24 25 26 27 28 29 30 31 32 33 34 35 36 37 38

FIELD SECTION

TAG :	DESC :
DO SP-9	DO SPARE 10
DO SP-10	DO SPARE 10
DO SP-11	DO SPARE 11
DO SP-12	DO SPARE 12
DO SP-13	DO SPARE 13
DO SP-14	DO SPARE 14
DO SP-15	DO SPARE 15
DO SP-16	DO SPARE 16

NOTE-TYPE OF TERMINALS USED
1 -NORMAL TERMINAL
2 -FUSED TERMINAL 500mA

MOJJ ENGINEERING SYSTEMS LTD


REVISION	DETAILS	DATE		
02	AS BUILT		FILE NO:	MES / E&I / MSD-705
01	AS PER COMMENTS	12-05-2025	DRAWN BY	N.A.
00	FOR APPROVAL	08-05-2025	CHECKED	P.B.
			APPROVED	MESL

TITLE:- 32DO-DIGITAL OUTPUT WIRING-1

PROJECT:- SPRAY DRYER

PROJECT:- MSD-705

DRG. NO.:- 2526/PRG/MSD/705 | SHEET NO. 52 / 62 | REV.NO. AS BUILT

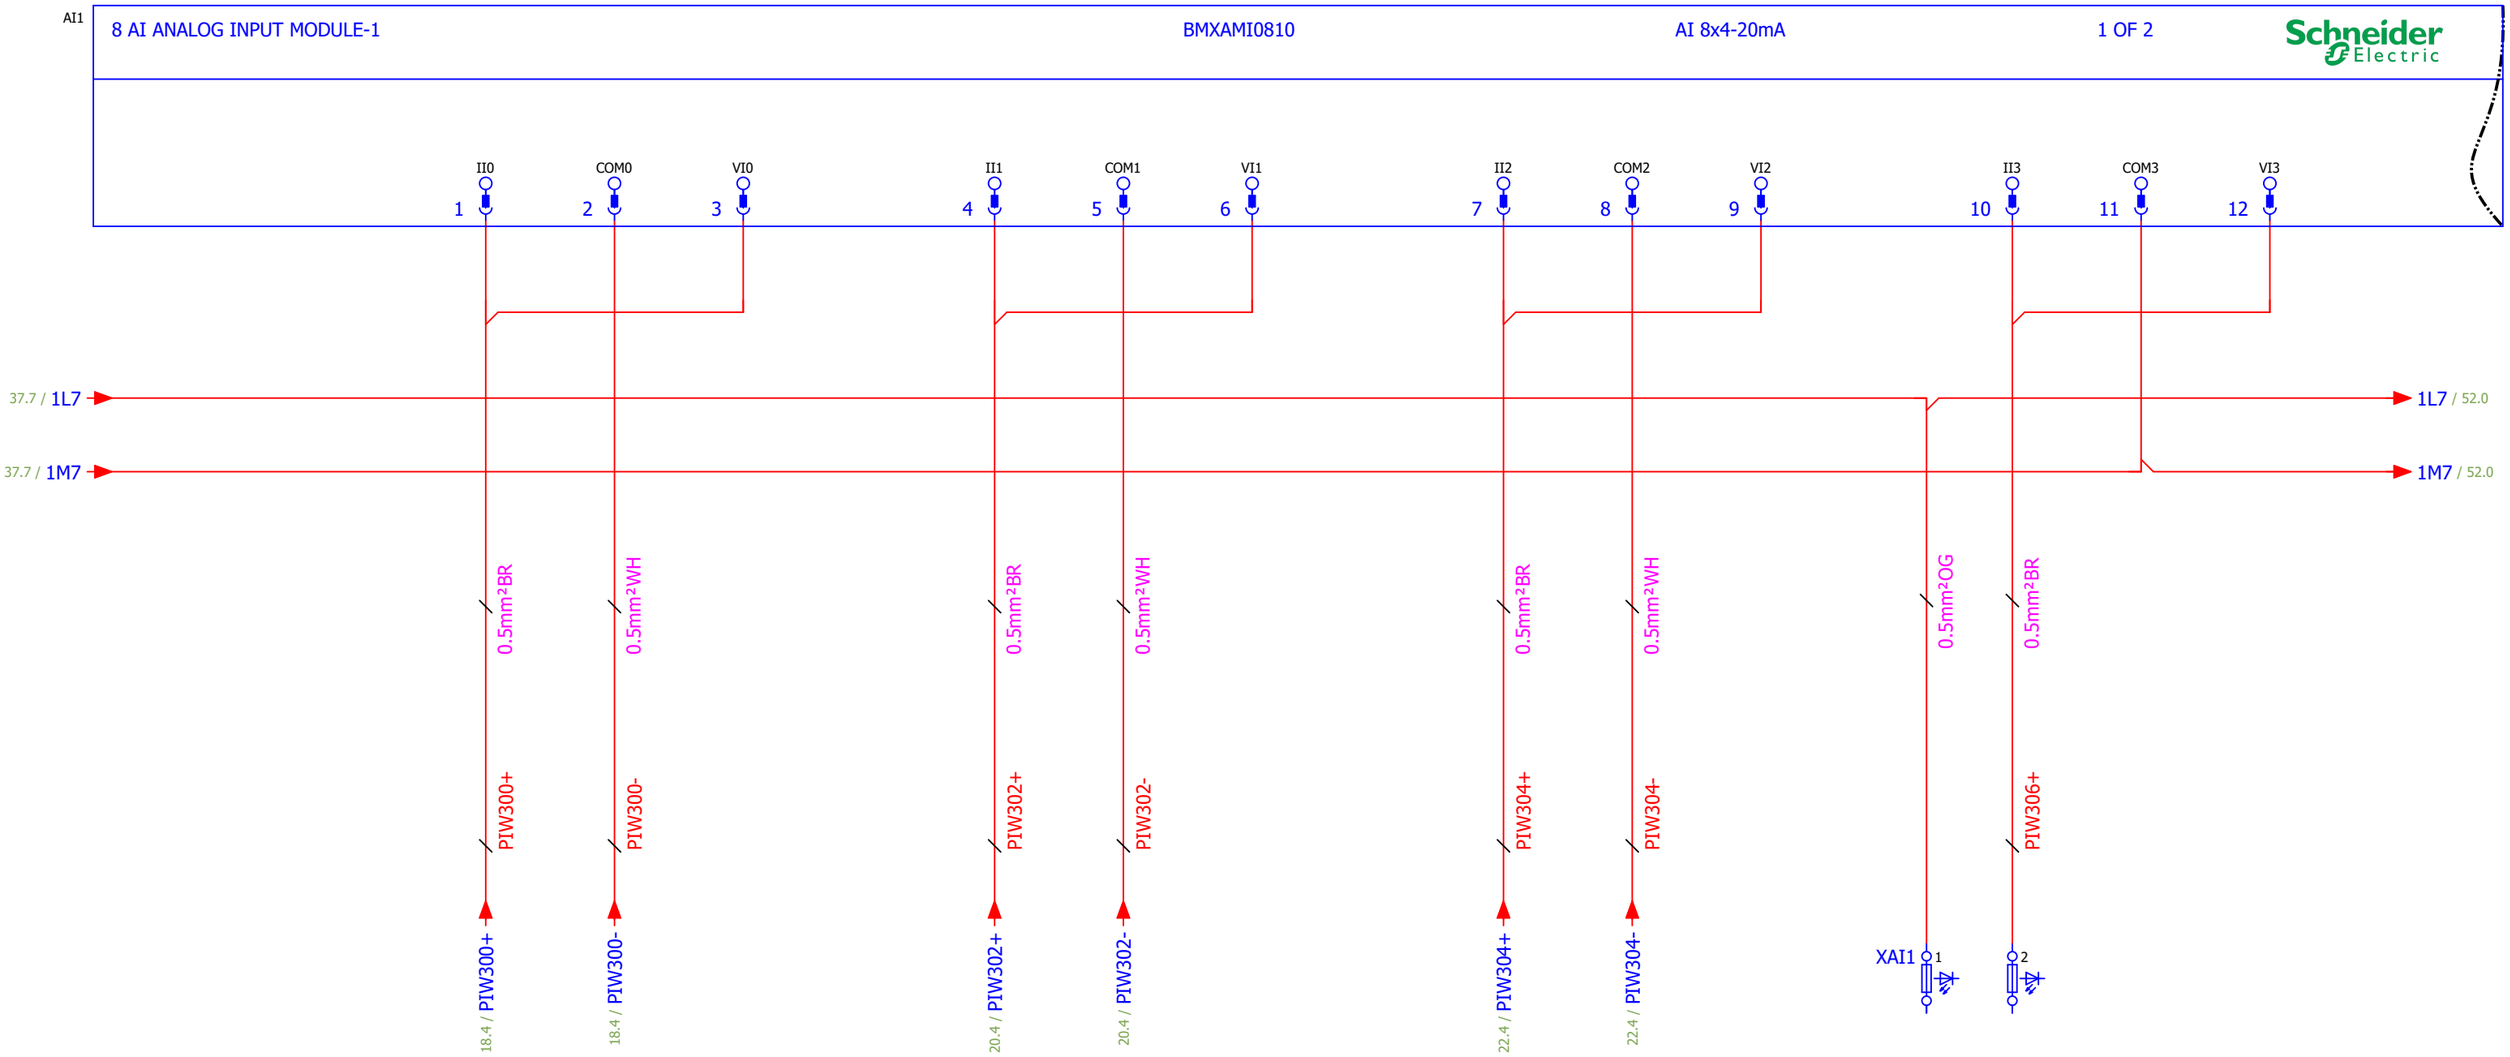

PANEL SECTION

FIELD SECTION

TAG :	(BL-02)/AI	(ATM-01)/AI	(PU-01)/AI	TE-101/AI
DESC :	AI (RPM) MAIN ID BLOWER (BL-02) VFD	AI (RPM) ATOMIZER MOTOR (ATM-01) VFD	AI (RPM) FEED PUMP A (PU-01) VFD	SPRAY DRYER CHAMBER INLET TEMP.
	(4 WIRE)	(4 WIRE)	(4 WIRE)	(2 WIRE)

NOTE-TYPE OF TERMINALS USED


1 -NORMAL TERMINAL

2 -FUSED TERMINAL 500mA

MOJJ ENGINEERING SYSTEMS LTD

REVISION	DETAILS	DATE			
02	AS BUILT		TITLE:- 8AI-ANALOG INPUT WIRING-1		
01	AS PER COMMENTS	12-05-2025	FILE NO: MES / E&I / MSD-705		
00	FOR APPROVAL	08-05-2025	DRAWN BY	N.A.	
			CHECKED	P.B.	
			APPROVED	MESL	

PROJECT:- SPRAY DRYER		
PROJECT:- MSD-705		
DRG. NO.:- 2526/PRG/MSD/705	SHEET NO. 53 / 62	REV.NO. AS BUILT

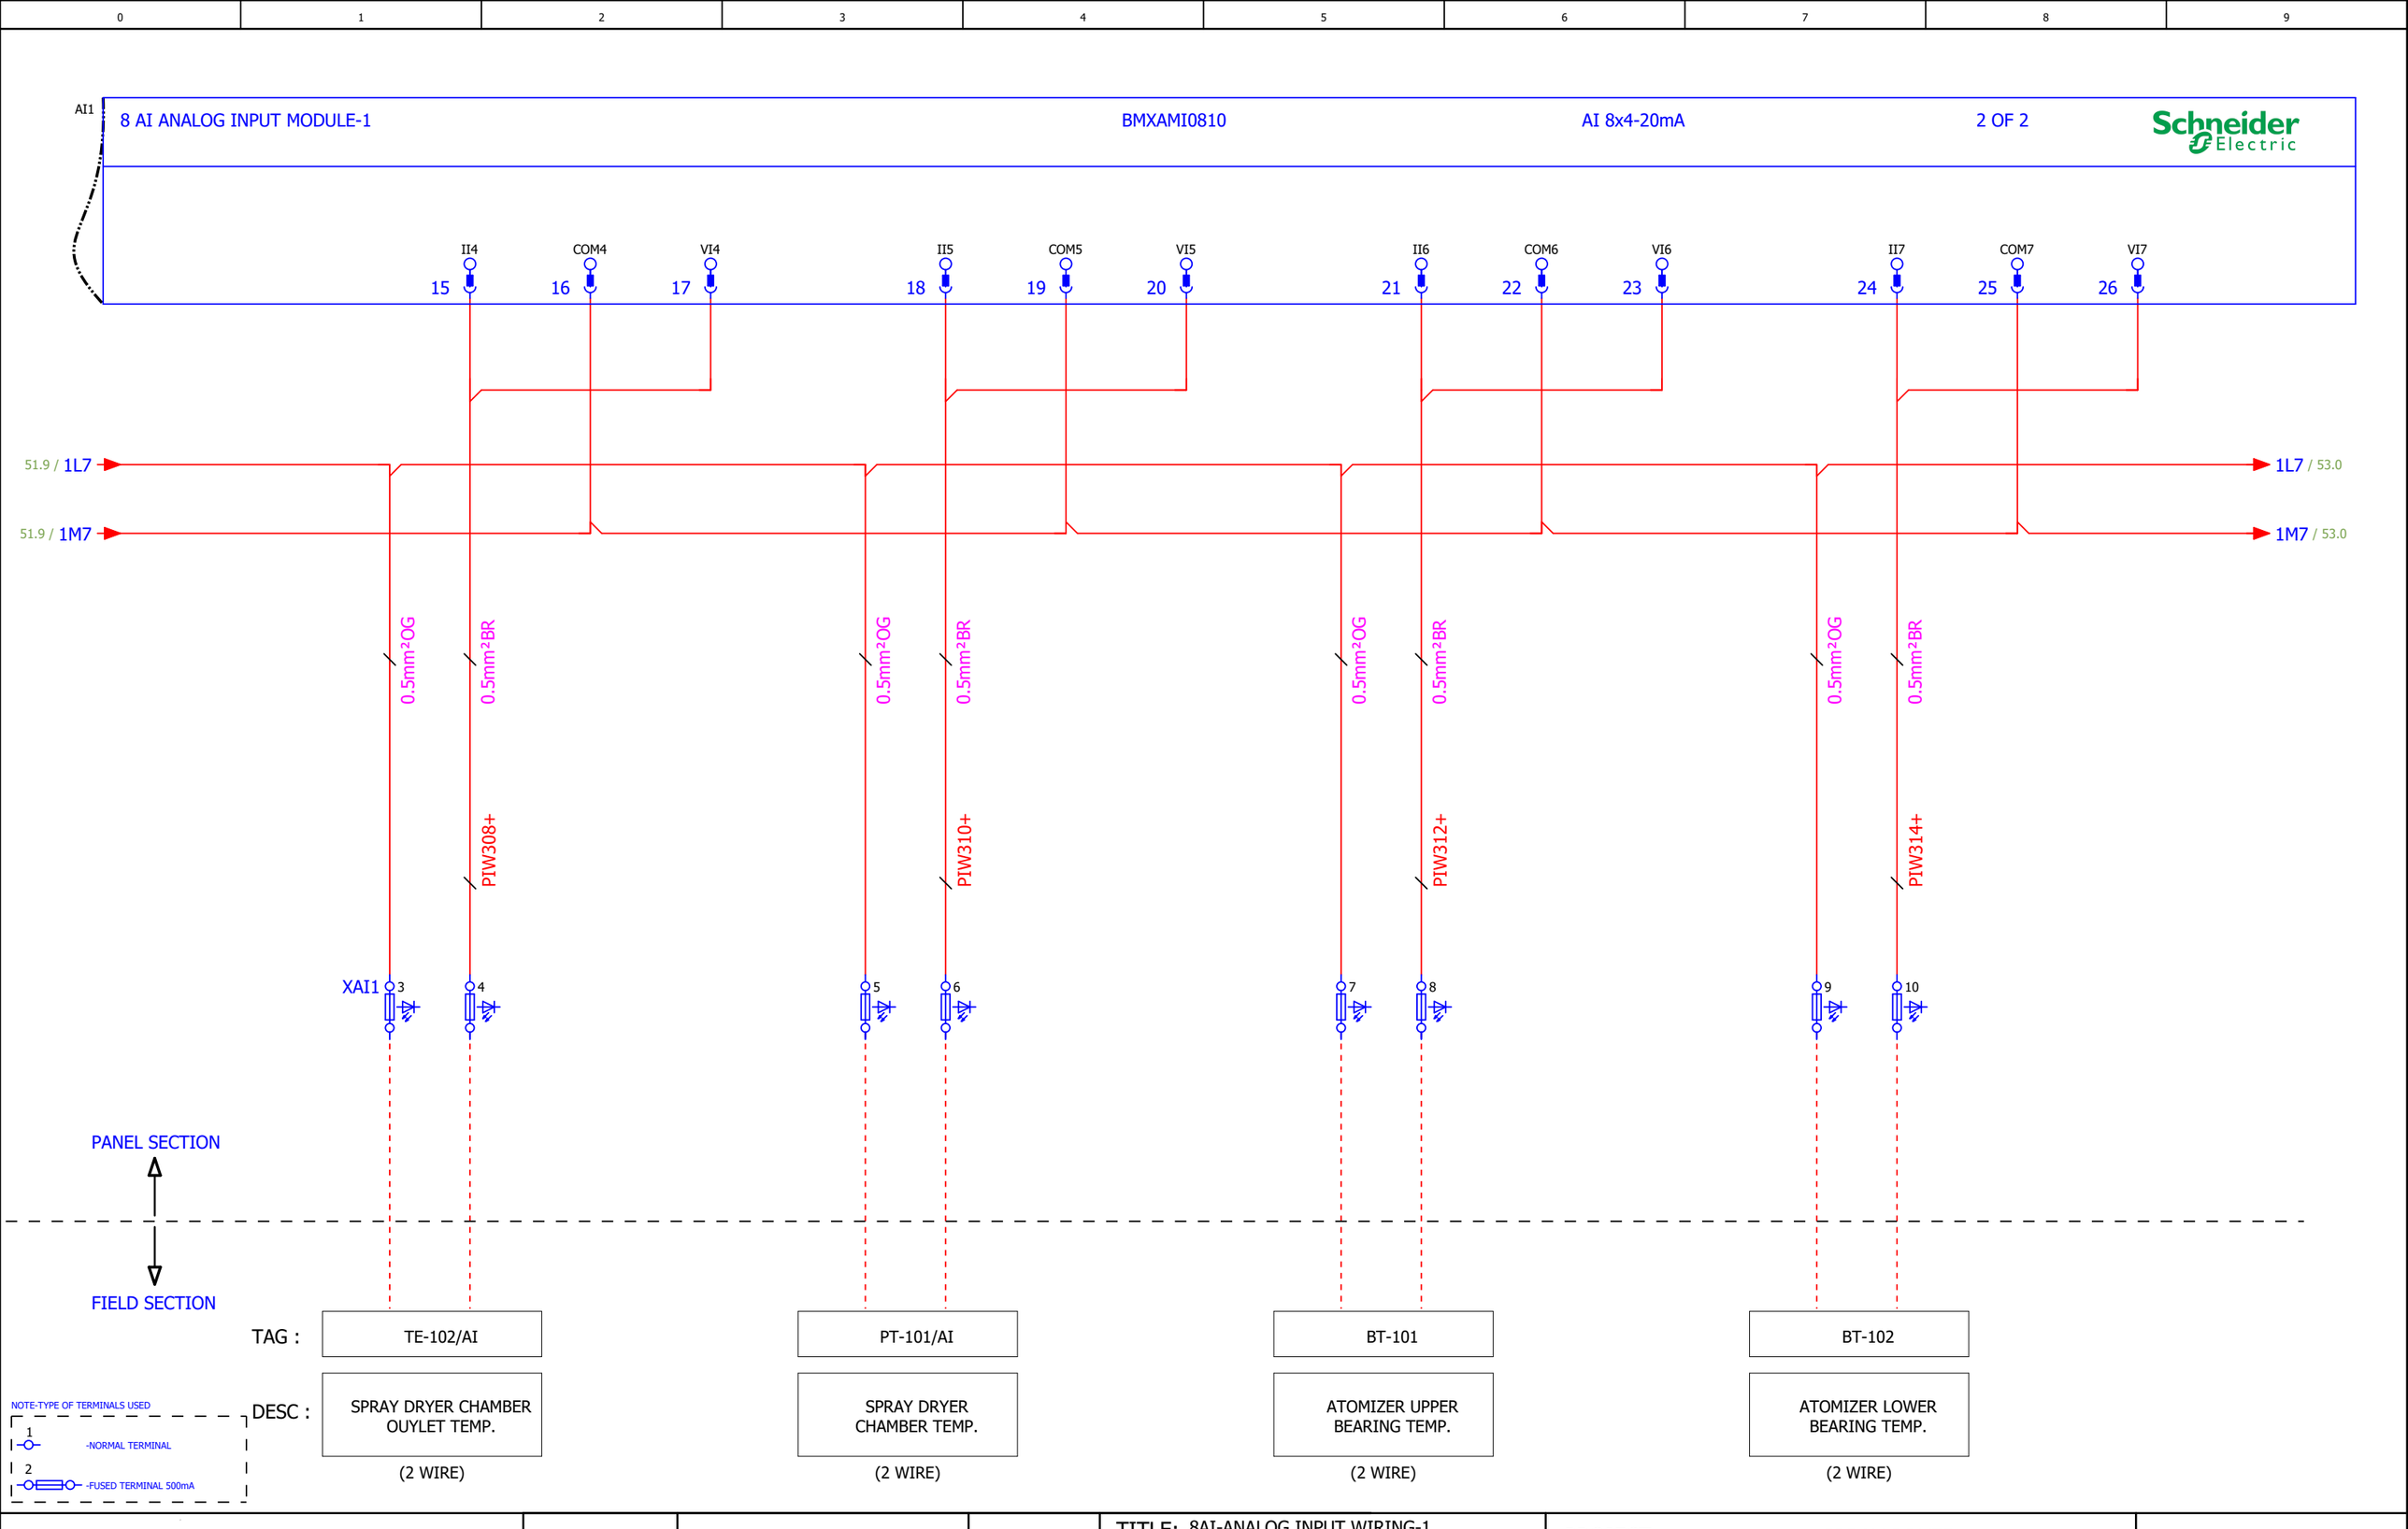

			TITLE:- 8AI-ANALOG INPUT WIRING-1			PROJECT:- SPRAY DRYER	
02	AS BUILT		FILE NO: MES / E&I / MSD-705				
01	AS PER COMMENTS	12-05-2025	DRAWN BY	N.A.		PROJECT:- MSD-705	
00	FOR APPROVAL	08-05-2025	CHECKED	P.B.			
REVISION	DETAILS	DATE	APPROVED	MESL		DRG. NO.:- 2526/PRG/MSD/705	SHEET NO. 54 / 62 / REV.NO. AS BUILT

MOJJ ENGINEERING SYSTEMS LTD

AI2

8 AI ANALOG INPUT MODULE-2 | BMXAMI0810 | AI 8x4-20mA | 1 OF 2

Schneider Electric

1	2	3	4	5	6	7	8	9	10	11	12
II0	COM0	VI0	II1	COM1	VI1	II2	COM2	VI2	II3	COM3	VI3

52.9 / 1L7 → 1L7 / 54.0

52.9 / 1M7 → 1M7 / 54.0

0.5mm²OG, 0.5mm²BR — PIW316+

0.5mm²OG, 0.5mm²BR — PIW318+

0.5mm²OG, 0.5mm²BR — PIW320+

0.5mm²OG, 0.5mm²BR — PIW322+

XAI2 1 2 3 4 5 6 7 8

PANEL SECTION

FIELD SECTION

TAG :	AI SP-1	AI SP-2	AI SP-3	AI SP-4
DESC :	AI SPARE 1	AI SPARE 2	AI SPARE 3	AI SPARE 4
	(2 WIRE)	(2 WIRE)	(2 WIRE)	(2 WIRE)

NOTE-TYPE OF TERMINALS USED

1 -NORMAL TERMINAL

2 -FUSED TERMINAL 500mA

MOJJ ENGINEERING SYSTEMS LTD

REVISION	DETAILS	DATE			
02	AS BUILT		TITLE:- 8AI-ANALOG INPUT WIRING-2		
01	AS PER COMMENTS	12-05-2025	FILE NO: MES / E&I / MSD-705		
00	FOR APPROVAL	08-05-2025	DRAWN BY	N.A.	
			CHECKED	P.B.	
			APPROVED	MESL	

PROJECT:- SPRAY DRYER

PROJECT:- MSD-705

DRG. NO.:- 2526/PRG/MSD/705 | SHEET NO. 55 / 62 | REV.NO. AS BUILT

0	1	2	3	4	5	6	7	8	9

AI2 | 8 AI ANALOG INPUT MODULE-2 | BMXAMI0810 | AI 8x4-20mA | 2 OF 2 | Schneider Electric

	II4	COM4	VI4	II5	COM5	VI5	II6	COM6	VI6	II7	COM7	VI7
	15	16	17	18	19	20	21	22	23	24	25	26

53.9 / 1L7

53.9 / 1M7

	0.5mm²OG	0.5mm²BR	0.5mm²OG	0.5mm²BR	0.5mm²OG	0.5mm²WH	0.5mm²BR	0.5mm²WH	0.5mm²OG	0.5mm²WH	0.5mm²BR	0.5mm²WH
		PIW324+		PIW326+			PIW328+	PIW328-			PIW330+	PIW330-

XAI2

	9	10	11	12	13	14	15	16	17	18	19	20

PANEL SECTION

FIELD SECTION

TAG :	AI SP-5	AI SP-6	ATM-B5	AI SP-7
DESC :	AI SPARE 5	AI SPARE 6	ATOMIZER BELT SENSOR	AI SPARE 7
	(2 WIRE)	(2 WIRE)	(4 WIRE)	(4 WIRE)

NOTE-TYPE OF TERMINALS USED

1 -NORMAL TERMINAL

2 -FUSED TERMINAL 500mA

MOJJ ENGINEERING SYSTEMS LTD

REVISION	DETAILS	DATE			
02	AS BUILT		TITLE:- 8AI-ANALOG INPUT WIRING-2		
01	AS PER COMMENTS	12-05-2025	FILE NO: MES / E&I / MSD-705		
00	FOR APPROVAL	08-05-2025	DRAWN BY	N.A.	
			CHECKED	P.B.	
			APPROVED	MESL	

PROJECT:- SPRAY DRYER


PROJECT:- MSD-705

DRG. NO.:- 2526/PRG/MSD/705 | SHEET NO. 56 / 62 | REV.NO. AS BUILT

0	1	2	3	4	5	6	7	8	9

AO1

8 AO ANALOG OUTPUT MODULE-1 | BMXAMO0802 | AO 8x4-20mA | 1 OF 2 | Schneider Electric

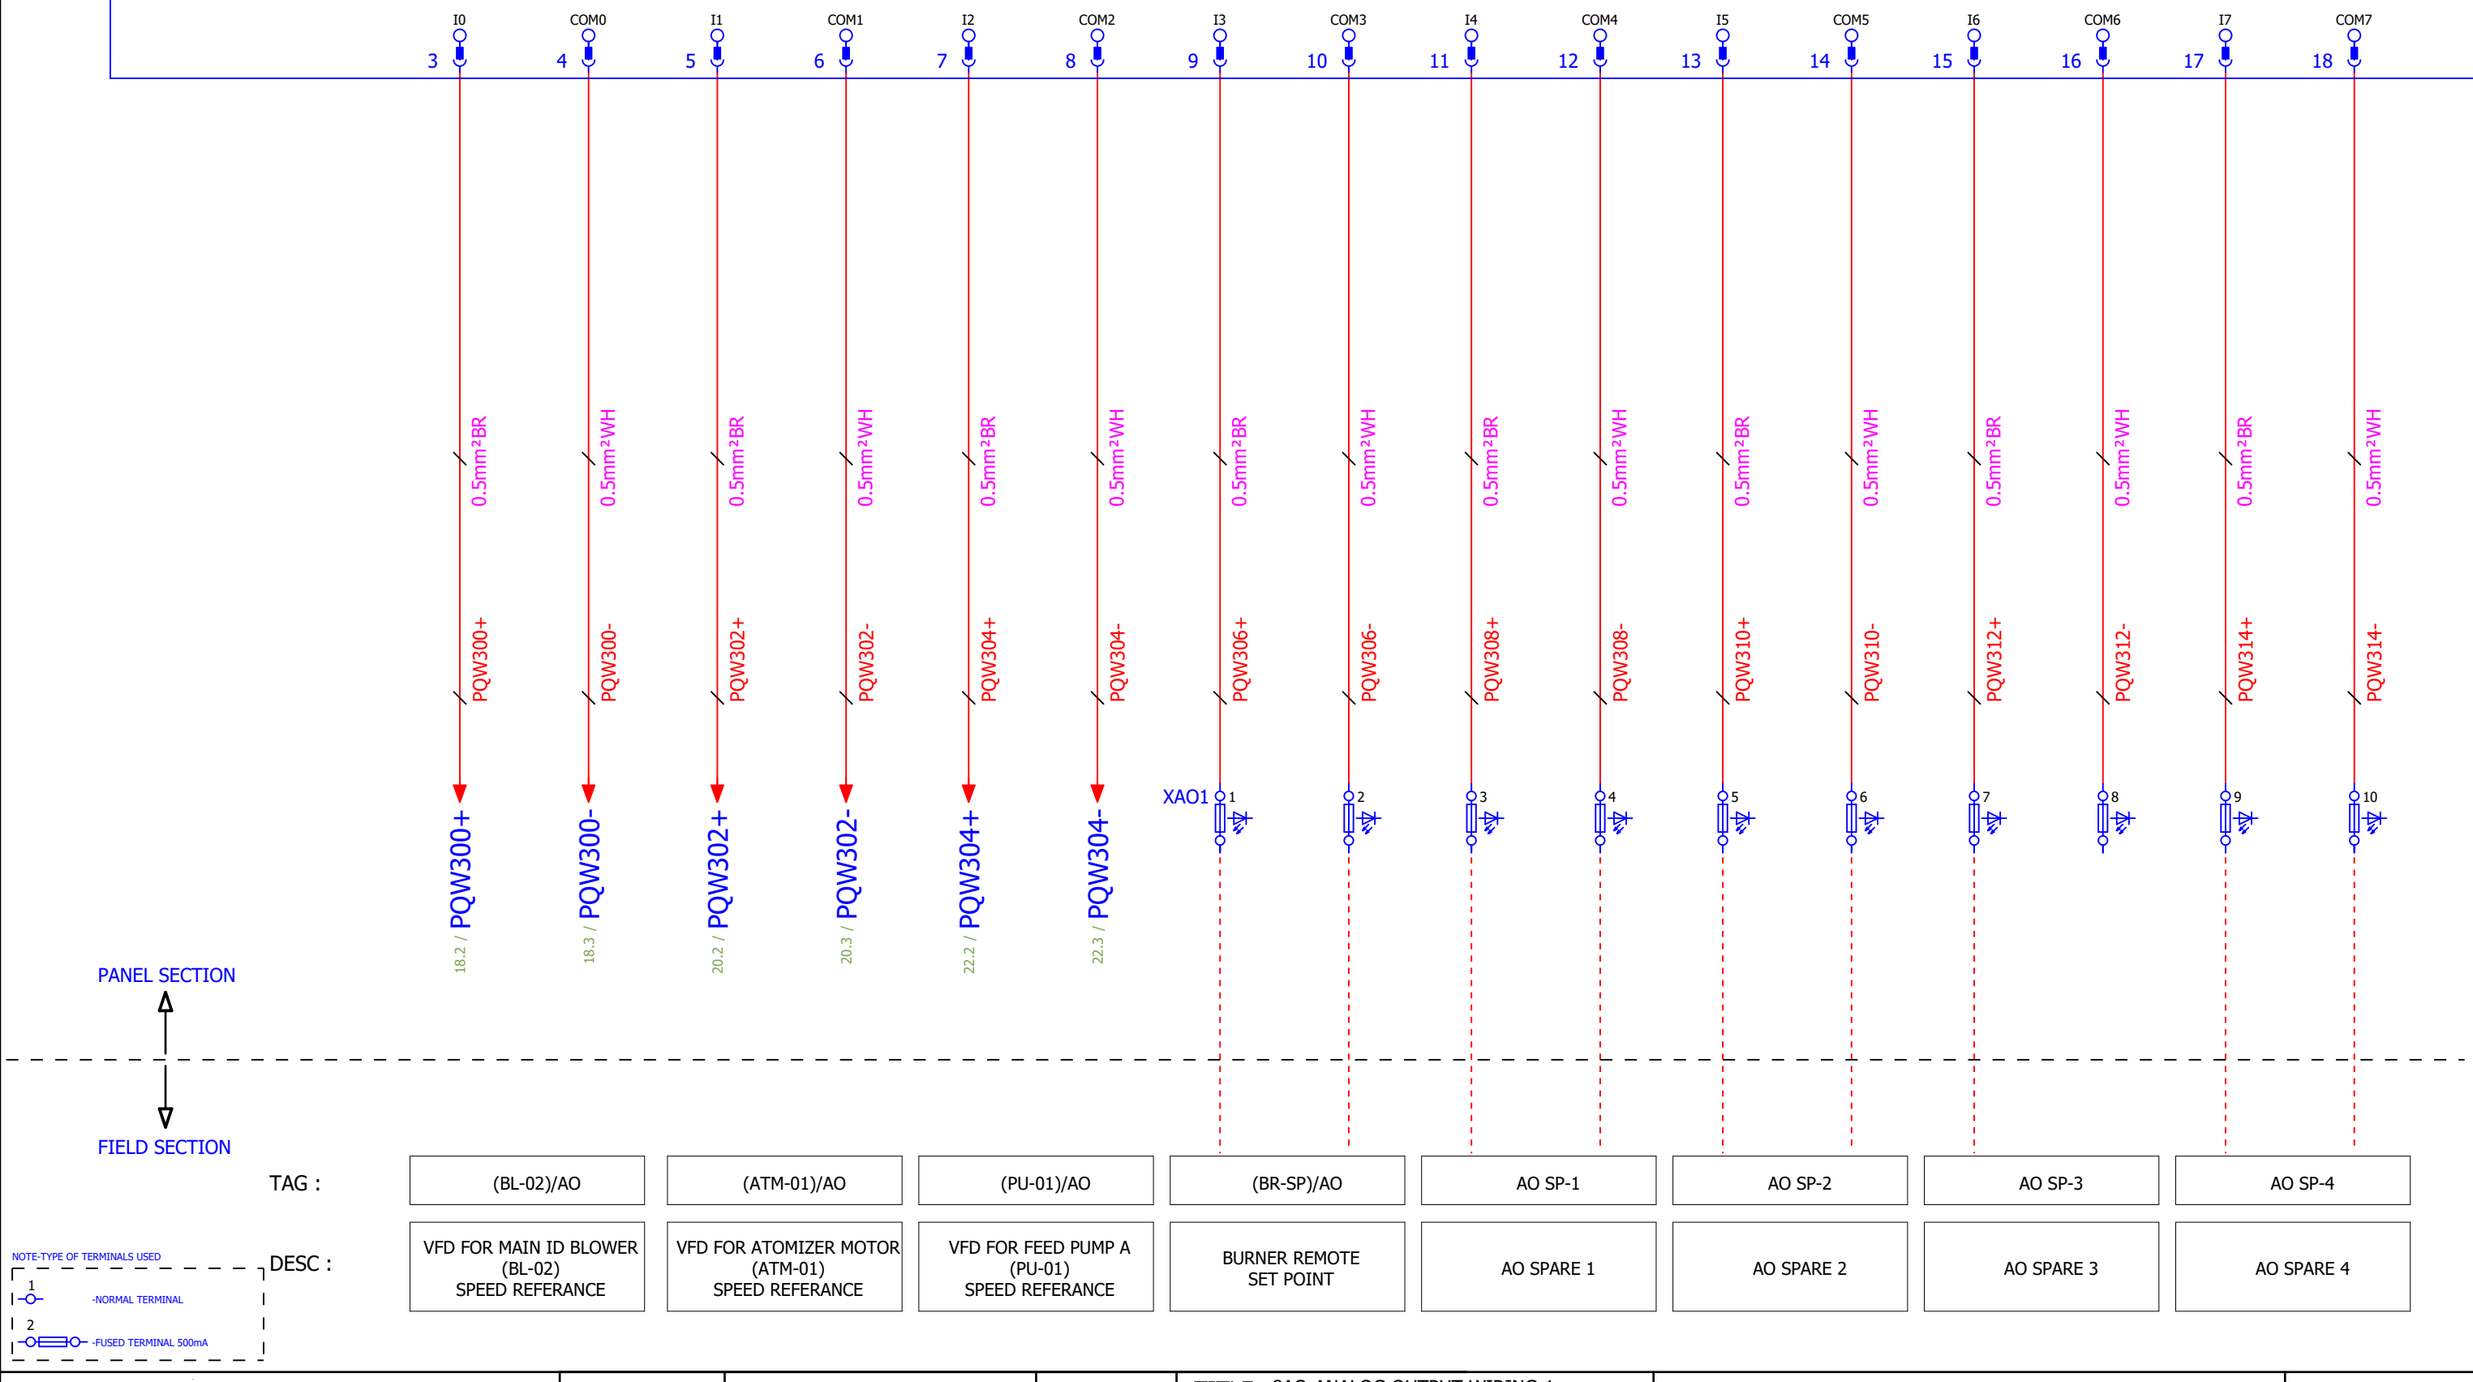

TAG :	DESC :
(BL-02)/AO	VFD FOR MAIN ID BLOWER (BL-02) SPEED REFERANCE
(ATM-01)/AO	VFD FOR ATOMIZER MOTOR (ATM-01) SPEED REFERANCE
(PU-01)/AO	VFD FOR FEED PUMP A (PU-01) SPEED REFERANCE
(BR-SP)/AO	BURNER REMOTE SET POINT
AO SP-1	AO SPARE 1
AO SP-2	AO SPARE 2
AO SP-3	AO SPARE 3
AO SP-4	AO SPARE 4

NOTE-TYPE OF TERMINALS USED

1 -NORMAL TERMINAL

2 -FUSED TERMINAL 500mA

MOJJ ENGINEERING SYSTEMS LTD

REVISION	DETAILS	DATE			
02	AS BUILT		TITLE:- 8AO-ANALOG OUTPUT WIRING-1		
01	AS PER COMMENTS	12-05-2025	FILE NO: MES / E&I / MSD-705		
00	FOR APPROVAL	08-05-2025	DRAWN BY	N.A.	
			CHECKED	P.B.	
			APPROVED	MESL	

PROJECT:- SPRAY DRYER


PROJECT:- MSD-705

DRG. NO.:- 2526/PRG/MSD/705 | SHEET NO. 57 / 62 | REV.NO. AS BUILT

HMI PANEL WIRING DIAGRAM

MOJJ ENGINEERING SYSTEMS LTD				TITLE:- COVER PAGE			PROJECT:- SPRAY DRYER	
	02	AS BUILT		FILE NO: MES / E&I / MSD-705				
	01	AS PER COMMENTS	12-05-2025	DRAWN BY	N.A.		PROJECT:- MSD-705	
	00	FOR APPROVAL	08-05-2025	CHECKED	P.B.			
	REVISION	DETAILS	DATE	APPROVED	MESL		DRG. NO.:- 2526/PRG/MSD/705	SHEET NO. 58 / 62 REV.NO. AS BUILT

230VAC POWER SUPPLY 50Hz

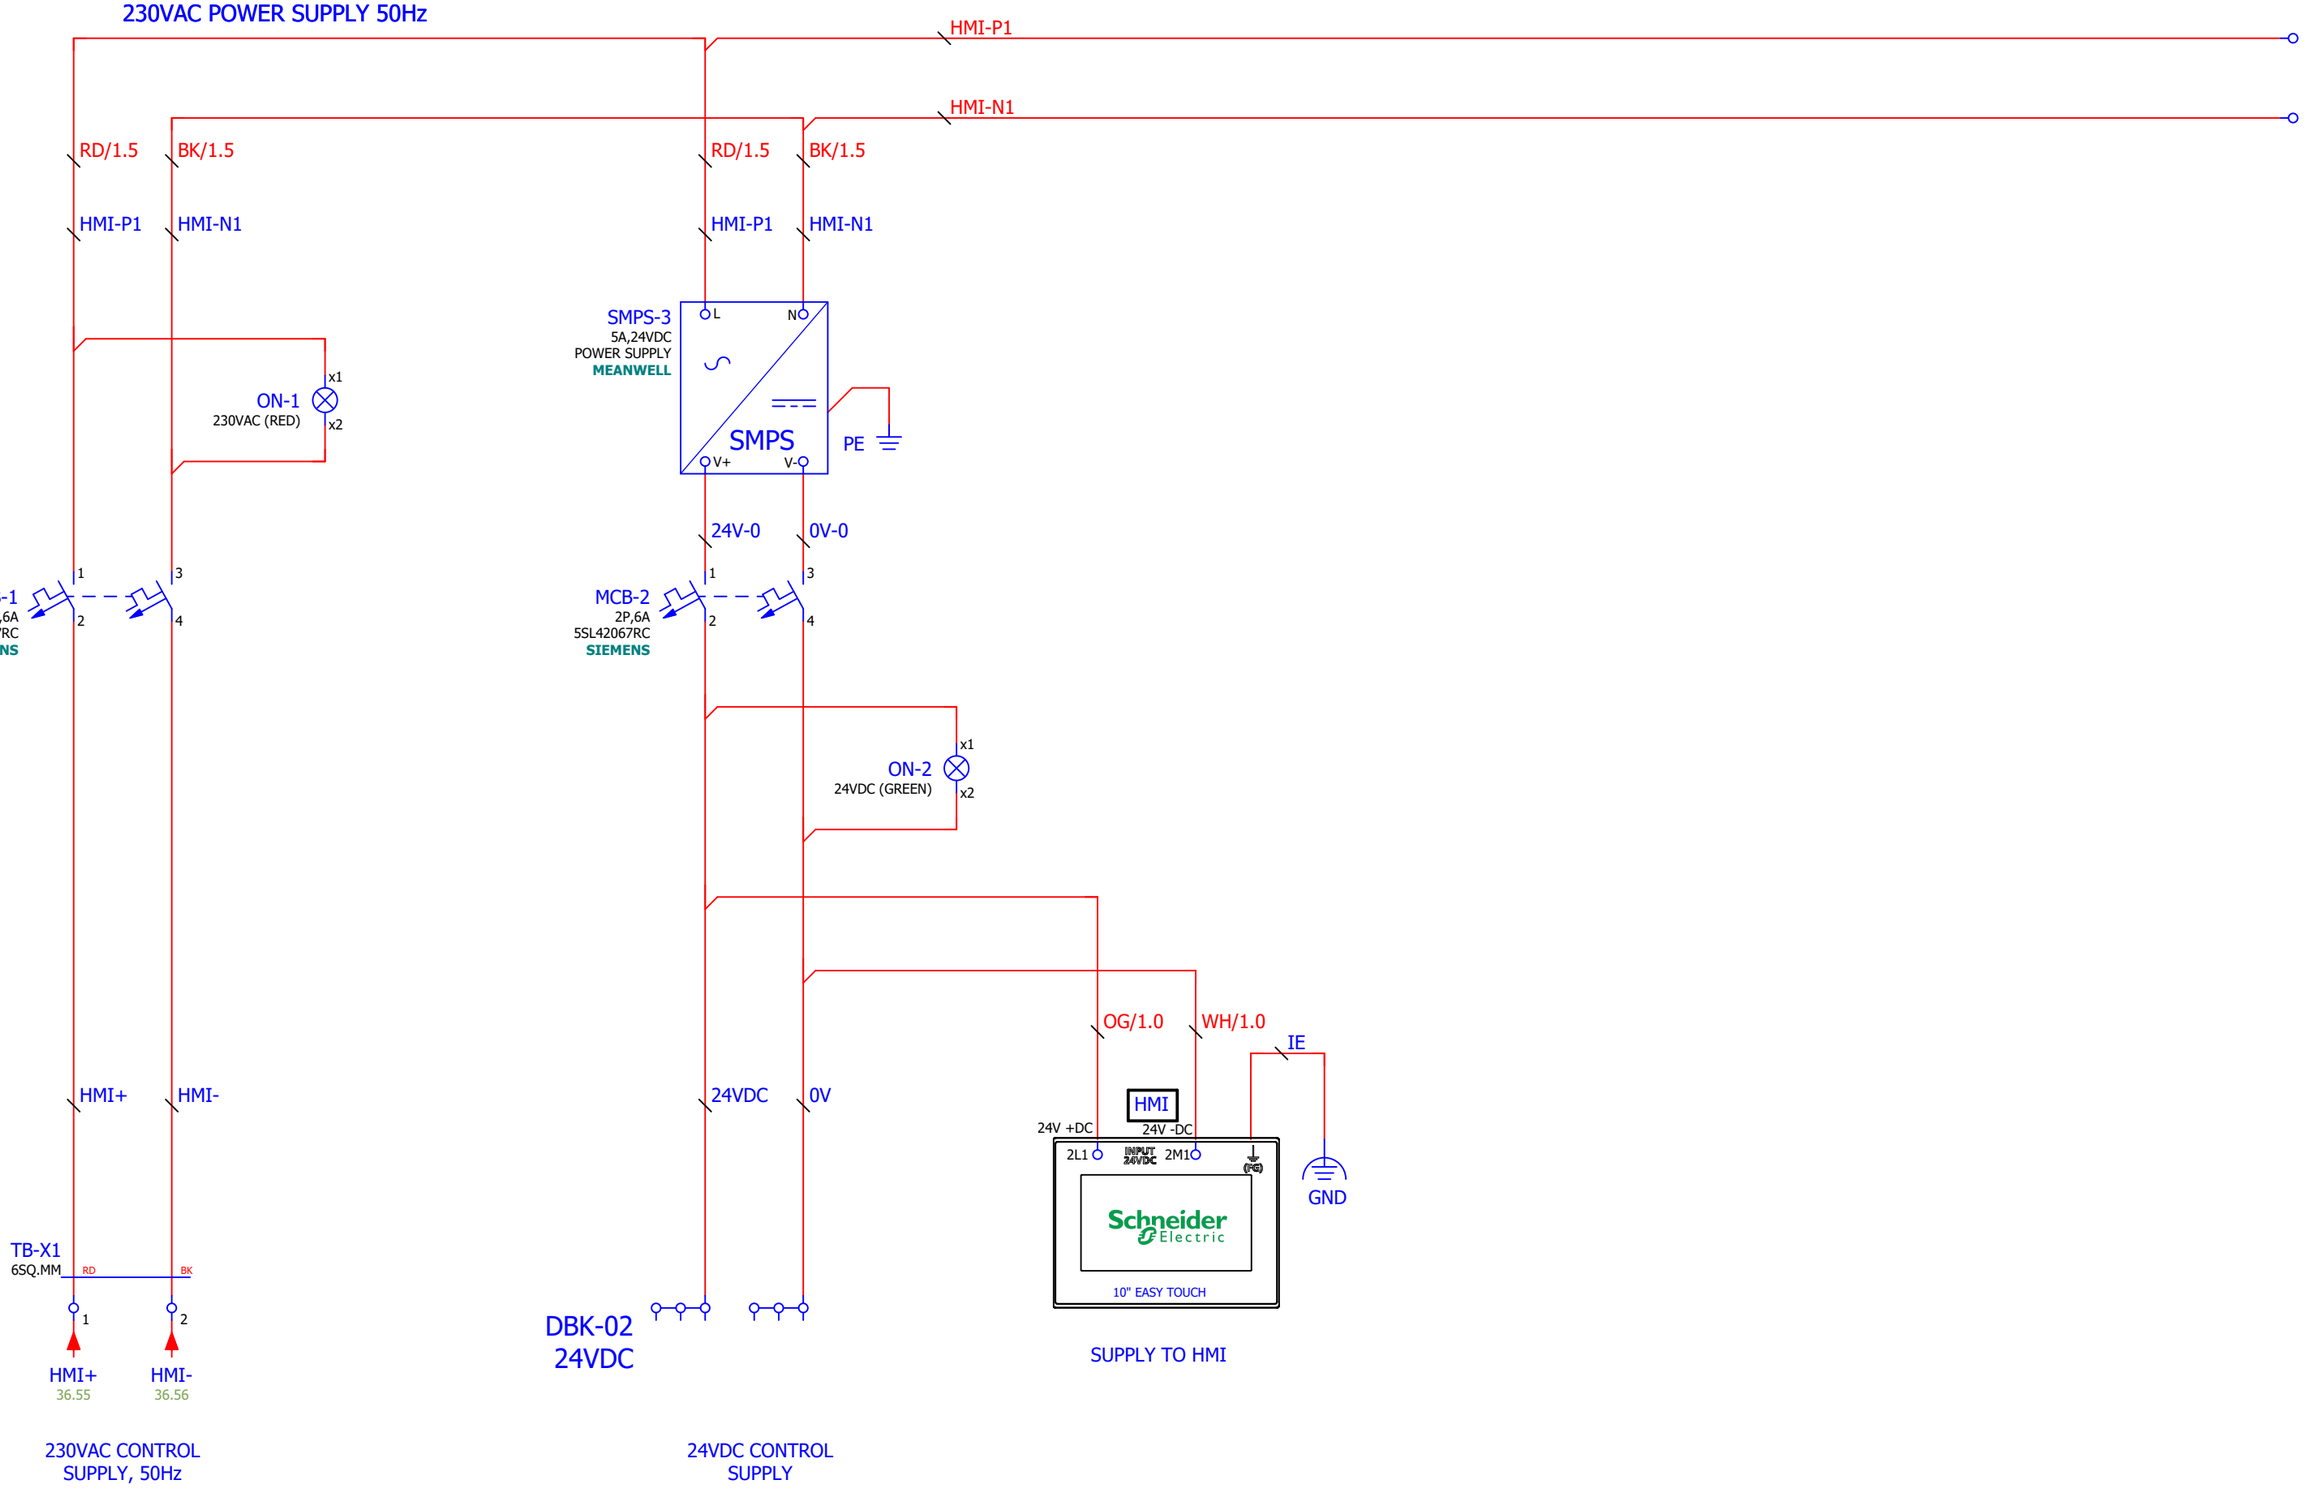

MOJJ ENGINEERING SYSTEMS LTD			TITLE:- 24VDC CONTROL WIRING		PROJECT:- SPRAY DRYER	
02	AS BUILT		FILE NO: MES / E&I / MSD-705			
01	AS PER COMMENTS	12-05-2025	DRAWN BY	N.A.	PROJECT:- MSD-705	
00	FOR APPROVAL	08-05-2025	CHECKED	P.B.		
REVISION	DETAILS	DATE	APPROVED	MESL	DRG. NO.:- 2526/PRG/MSD/705	SHEET NO. 59 / 62 / REV.NO. AS BUILT

TERMINAL DETAILS

IN PANEL	ON FIELD

X0

1R*25*10 R/Y/B/N

R	1	RD	INCOMER POWER 415V, 3PH, 4 WIRE FROM CUSTOMERS
Y	2	YL	
B	3	BL	
N	4	BK	

1F-TB0

16 SQ.MM

R2-1F	1	RD	MAIN ID BLOWER BL-02
Y2-1F	2	YL	
B2-1F	3	BL	

1F-TB1

4 SQ.MM

1-1F	1	GY	FUTURE INTERLOCK
2-1F	2	GY	
3-1F	3	GY	FIELD STOP
4-1F	4	GY	
5-1F	5	GY	FIELD START
7-1F	6	GY	

2F-TB0

10 SQ.MM

R2-2F	1	RD	ATOMIZER ATM-01
Y2-2F	2	YL	
B2-2F	3	BL	

2F-TB1

4 SQ.MM

1-2F	1	GY	FUTURE INTERLOCK
2-2F	2	GY	
3-2F	3	GY	FIELD STOP
4-2F	4	GY	
5-2F	5	GY	FIELD START
7-2F	6	GY	

3F-TB0

6 SQ.MM

R2-3F	1	RD	FEED PUMP-A PU-01
Y2-3F	2	YL	
B2-3F	3	BL	

3F-TB1

4 SQ.MM

1-3F	1	GY	FUTURE INTERLOCK
2-3F	2	GY	
3-3F	3	GY	FIELD STOP
4-3F	4	GY	
5-3F	5	GY	FIELD START
7-3F	6	GY	

TERMINAL DETAILS

IN PANEL	ON FIELD

4F-TB0

10 SQ.MM

R2-4F	1	RD	FD BLOWER BL-01
Y2-4F	2	YL	
B2-4F	3	BL	
R3-4F	4	RD	
Y3-4F	5	YL	
B3-4F	6	BL	

4F-TB1

4 SQ.MM

1-4F	1	GY	FUTURE INTERLOCK
2-4F	2	GY	
3-4F	3	GY	FIELD STOP
4-4F	4	GY	
5-4F	5	GY	FIELD START
7-4F	6	GY	

5F-TB0

10 SQ.MM

R2-5F	1	RD	CIP PUMP PU-03
Y2-5F	2	YL	
B2-5F	3	BL	
R3-5F	4	RD	
Y3-5F	5	YL	
B3-5F	6	BL	

5F-TB1

4 SQ.MM

1-5F	1	GY	FUTURE INTERLOCK
2-5F	2	GY	
3-5F	3	GY	FIELD STOP
4-5F	4	GY	
5-5F	5	GY	FIELD START
7-5F	6	GY	

6F-TB0

10 SQ.MM

R2-6F	1	RD	SPARE-01SP-01
Y2-6F	2	YL	
B2-6F	3	BL	
R3-6F	4	RD	
Y3-6F	5	YL	
B3-6F	6	BL	

TERMINAL DETAILS

IN PANEL	ON FIELD

6F-TB1

4 SQ.MM

1-6F	1	GY	FUTURE INTERLOCK
2-6F	2	GY	
3-6F	3	GY	FIELD STOP
4-6F	4	GY	
5-6F	5	GY	FIELD START
7-6F	6	GY	

7F-TB0

10 SQ.MM

R2-7F		RD	SCRUBBER PUMP-A PU-02
Y2-7F		YL	
B2-7F		BL	

7F-TB1

4 SQ.MM

1-7F	1	GY	FUTURE INTERLOCK
2-7F	2	GY	
3-7F	3	GY	FIELD STOP
4-7F	4	GY	
5-7F	5	GY	FIELD START
7-7F	6	GY	

8F-TB0

10 SQ.MM

R2-8F		RD	SPARE-02 SP-02
Y2-8F		YL	
B2-8F		BL	

8F-TB1

4 SQ.MM

1-8F	1	GY	FUTURE INTERLOCK
2-8F	2	GY	
3-8F	3	GY	FIELD STOP
4-8F	4	GY	
5-8F	5	GY	FIELD START
7-8F	6	GY	

9F-TB0

1R*25*10 R/Y/B/N

R1-9F	1	RD	BURNER MOTOR BR-01
Y1-9F	2	YL	
B1-9F	3	BL	
N0-9F	4	BK	

TERMINAL DETAILS

IN PANEL	ON FIELD

9F-TB1

4 SQ.MM

P1-9F	1	GY	FUTURE INTERLOCK-1
1-9F	2	GY	
2-9F	3	GY	FIELD STOP
3-9F	4	GY	
4-9F	5	GY	FIELD START
6-9F	6	GY	

9F-TB2

4 SQ.MM

11-9F	1	GY	FUTURE INTERLOCK-2
10-9F	2	GY	
10-9F	3	GY	ON CMD
13-9F	4	GY	
14-9F	5	GY	BURNER ON
15-9F	6	GY	
16-9F	7	GY	BURNER TRIP
17-9F	8	GY	

10F-TB0

6 SQ.MM

R2-10F		RD	ROTARY VALVE FOR CYCLONE CY-01
Y2-10F		YL	
B2-10F		BL	

10F-TB1

4 SQ.MM

1-10F	1	GY	FUTURE INTERLOCK
2-10F	2	GY	
3-10F	3	GY	FIELD STOP
4-10F	4	GY	
5-10F	5	GY	FIELD START
7-10F	6	GY	

11F-TB0

6 SQ.MM

R2-11F		RD	LUBRICATION OIL PUMP LOP-01
Y2-11F		YL	
B2-11F		BL	

11F-TB1

4 SQ.MM

1-11F	1	GY	FUTURE INTERLOCK
2-11F	2	GY	
3-11F	3	GY	FIELD STOP
4-11F	4	GY	
5-11F	5	GY	FIELD START
7-11F	6	GY	

MOJJ ENGINEERING SYSTEMS LTD

REVISION	DETAILS	DATE		
02	AS BUILT			
01	AS PER COMMENTS	12-05-2025	DRAWN BY	N.A.
00	FOR APPROVAL	08-05-2025	CHECKED	P.B.
			APPROVED	MESL

TITLE:- TERMINATION

FILE NO: MES / E&I / MSD-705

PROJECT:- SPRAY DRYER

PROJECT:- MSD-705

DRG. NO.:- 2526/PRG/MSD/705

SHEET NO. 60 / 62

REV.NO. AS BUILT

TERMINAL DETAILS

IN PANEL	ON FIELD

12F-TB0

6 SQ.MM

R0-12F	1	RD	CIP WINCH PANEL SUPPLY
Y0-12F	2	YL	
B0-12F	3	BL	
N0-12F	4	BK	

13F-TB0

6 SQ.MM

R0-13F	1	RD	LUBRICATION PUMP SUPPLY
N0-13F	2	BK	

14F-TB0

6 SQ.MM

R0-14F	1	RD	HAMMER CHAMBER CONE HM-01
N0-14F	2	BK	

15F-TB0

6 SQ.MM

R2-15F	1	RD	EMH-1 HAMMER-1
Y1-15F	2	BK	

15F-TB1

6 SQ.MM

Y4-15F	1	YL	EMH-2 HAMMER-2
B1-15F	2	BK	

15F-TB2

6 SQ.MM

B4-15F	1	BL	EMH-3 HAMMER-3
R4-15F	2	BK	

15F-TB3

6 SQ.MM

R7-15F	1	RD	EMH-4 HAMMER-4
Y6-15F	2	BK	

15F-TB4

6 SQ.MM

Y9-15F	1	YL	EMH-5 HAMMER-5
B6-15F	2	BK	

15F-TB5

6 SQ.MM

B9-15F	1	BL	EMH-6 HAMMER-6
R9-15F	2	BK	

15F-TB6

6 SQ.MM

R12-15F	1	RD	EMH-7 HAMMER-7
Y11-15F	2	BK	

15F-TB7

6 SQ.MM

Y14-15F	1	YL	EMH-8 HAMMER-8
B11-15F	2	BK	

TERMINAL DETAILS

IN PANEL	ON FIELD

X-TB

4 SQ.MM

01	1	GY	FIELD START PULSE
02	2	GY	

TB-1

4 SQ.MM

1014	1	GY	SPARE
N0	2	BK	
1015	3	GY	SPARE
N0	4	BK	

X1

4 SQ.MM

603	1	OG	INET TEMPERATURE SENSOR TE-101
604	2	WH	
605	3	WH	

TB-X0

4 SQ.MM

UPS-P	1	GY	230VAC CONTROL SUPPLY FROM UPS
UPS-N	2	BK	

XDI1

4 SQ.MM

IL2-1	1	OG	LUBRICATION OIL FLOW SWITCH (FS-401)
I0:1/27	2	BL	
IL2-1	3	OG	OIL HIGH LEVEL/ LOW LEVEL SWITC
I0:1/28	4	BL	
IL2-1	5	OG	CIP WINCH (CIPW-01) FWD F/B
I0:1/29	6	BL	
IL2-1	7	OG	CIP WINCH (CIPW-01) REV F/B
I0:1/30	8	BL	
IL2-1	9	OG	CIP WINCH (CIPW-01) TRIP F/B
I0:1/31	10	BL	

XDI2

4 SQ.MM

IL2-2	1	OG	CIP WINCH (CIPW-01) AUTO/MANUAL F/B
I0:2/0	2	BL	
IL2-2	3	OG	PLC EMERGENCY F/B
I0:2/4-1	4	BL	
IL2-2	5	OG	DI SPARE 1
I0:2/7	6	BL	
IL2-2	7	OG	DI SPARE 2
I0:2/8	8	BL	
IL2-2	9	OG	DI SPARE 3
I0:2/9	10	BL	
IL2-2	11	OG	DI SPARE 4
I0:2/10	12	BL	

TERMINAL DETAILS

IN PANEL	ON FIELD

XDI2

4 SQ.MM

IL2-2	13	OG	DI SPARE 5
I0:2/11	14	BL	
IL2-2	15	OG	DI SPARE 6
I0:2/12	16	BL	
IL2-2	17	OG	DI SPARE 7
I0:2/13	18	BL	
IL2-2	19	OG	DI SPARE 8
I0:2/14	20	BL	
IL2-2	21	OG	DI SPARE 9
I0:2/15	22	BL	
IL2-2	23	OG	DI SPARE 10
I0:2/16	24	BL	
IL2-2	25	OG	DI SPARE 11
I0:2/17	26	BL	
IL2-2	27	OG	DI SPARE 12
I0:2/18	28	BL	
IL2-2	29	OG	DI SPARE 13
I0:2/19	30	BL	
IL2-2	31	OG	DI SPARE 14
I0:2/20	32	BL	
IL2-2	33	OG	DI SPARE 15
I0:2/21	34	BL	
IL2-2	35	OG	DI SPARE 16
I0:2/22	36	BL	
IL2-2	37	OG	DI SPARE 17
I0:2/23	38	BL	
IL2-2	39	OG	DI SPARE 18
I0:2/24	40	BL	
IL2-2	41	OG	DI SPARE 19
I0:2/25	42	BL	
IL2-2	43	OG	DI SPARE 20
I0:2/26	44	BL	
IL2-2	45	OG	DI SPARE 21
I0:2/27	46	BL	
IL2-2	47	OG	DI SPARE 22
I0:2/28	48	BL	
IL2-2	49	OG	DI SPARE 23
I0:2/29	50	BL	
IL2-2	51	OG	DI SPARE 24
I0:2/30	52	BL	
IL2-2	53	OG	DI SPARE 25
I0:2/31	54	BL	

TERMINAL DETAILS

IN PANEL	ON FIELD

XDO1

4 SQ.MM

501	1	GY	BURNER(BR-01) RESET CMD
502	2	GY	
503	3	GY	CIP WINCH (CIPW-01) FWD START/STOP CMD
504	4	GY	
505	5	GY	CIP WINCH (CIPW-01) REV START/STOP CMD
506	6	GY	
507	7	GY	DO SPARE 1
508	8	GY	
509	9	GY	DO SPARE 2
510	10	GY	
511	11	GY	DO SPARE 3
512	12	GY	
513	13	GY	DO SPARE 4
514	14	GY	
515	15	GY	DO SPARE 5
516	16	GY	
517	17	GY	DO SPARE 6
518	18	GY	
519	19	GY	DO SPARE 7
520	20	GY	
521	21	GY	DO SPARE 8
522	22	GY	
523	23	GY	DO SPARE 9
524	24	GY	
525	25	GY	DO SPARE 10
526	26	GY	
527	27	GY	DO SPARE 11
528	28	GY	
529	29	GY	DO SPARE 12
530	30	GY	
531	31	GY	DO SPARE 13
532	32	GY	
533	33	GY	DO SPARE 14
534	34	GY	
535	35	GY	DO SPARE 15
536	36	GY	
537	37	GY	DO SPARE 16
538	38	GY	

MOJJ ENGINEERING SYSTEMS LTD

REVISION	DETAILS	DATE			
02	AS BUILT				
01	AS PER COMMENTS	12-05-2025	DRAWN BY	N.A.	
00	FOR APPROVAL	08-05-2025	CHECKED	P.B.	
			APPROVED	MESL	

TITLE:- TERMINATION

FILE NO: MES / E&I / MSD-705

PROJECT:- SPRAY DRYER

PROJECT:- MSD-705

DRG. NO.:- 2526/PRG/MSD/705

SHEET NO. 61 / 62

REV.NO. AS BUILT

TERMINAL DETAILS

IN PANEL	ON FIELD

XAI1

4 SQ.MM

IL7	1	OG	SPRAY DRYER CHAMBER INLET TEMP.
PIW306+	2	BR	
IL2-2	3	OG	SPRAY DRYER CHAMBER OUTLET TEMP.
PIW308+	4	BR	
IL2-2	5	OG	SPRAY DRYER CHAMBER TEMP.
PIW310+	6	BR	
IL2-2	7	OG	ATOMIZER UPPER BEARING TEMP.
PIW312+	8	BR	
IL2-2	9	OG	ATOMIZER LOWER BEARING TEMP.
PIW314+	10	BR	

XAI2

4 SQ.MM

IL7	1	OG	AI SPARE 1
PIW316+	2	BR	
IL7	3	OG	AI SPARE 2
PIW318+	4	BR	
IL7	5	OG	AI SPARE 3
PIW320+	6	BR	
IL7	7	OG	AI SPARE 4
PIW322+	8	BR	
IL7	9	OG	AI SPARE 5
PIW324+	10	BR	
IL7	11	OG	AI SPARE 6
PIW326+	12	BR	
IL7	13	OG	
IM7	14	WH	ATOMIZER BELT SENSOR
PIW328+	15	OG	
PIW328-	16	BR	
IL7	17	OG	
IM7	18	WH	AI SPARE 7
PIW330+	19	OG	
PIW330-	20	BR	

XAO1

4 SQ.MM

PQW306+	1	BR	BURNER REMOTE SET POINT
PIW306+	2	WH	
PQW308+	3	BR	AO SPARE 1
PIW308+	4	WH	
PQW310+	5	BR	AO SPARE 2
PIW310+	6	WH	
PQW312+	7	BR	AO SPARE 3
PIW312+	8	WH	
PQW314+	9	BR	AO SPARE 4
PIW314+	10	WH	

MOJJ ENGINEERING SYSTEMS LTD

REVISION	DETAILS	DATE			
02	AS BUILT		TITLE:- TERMINATION		
01	AS PER COMMENTS	12-05-2025	FILE NO: MES / E&I / MSD-705		
00	FOR APPROVAL	08-05-2025	DRAWN BY	N.A.	
			CHECKED	P.B.	
			APPROVED	MESL	

PROJECT:- SPRAY DRYER

PROJECT:- MSD-705

DRG. NO.:- 2526/PRG/MSD/705 | SHEET NO. 62 / 62 | REV.NO. AS BUILT