AQUACARESEE PVT. LTD.
OFFICE NO.204, 205 AND 206
VINAYAK ARCADE, 2ND FLOOR
OPP. BAJAJ AUTO, AKURDI,PUNE-411035
www.aquacaresee.co.in
MOB:-9049560684
www.aquacaresee.co.in

PROJECT CODE	POWER CUM PLC PANEL FOR ETP PLANT
CLIENT	SHAH EYE CARE PVT. LTD.
SYSTEM	EFFLUENT TREATMENT PLANT-10 KLD
DOCUMENT	POWER CUM PLC WIRING DIAGRAM
YEAR OF MFG	YEAR 2025-26

Edit date 02-12-2025 CREATOR SYSTEM TUSHAR.AHER 27

Table of contents

Column X: An automatically generated page was edited

F06_001

Page	Page description	supplementary page field	Date	Edited by	X
/1	TITLE PAGE		06-11-2025	SAKSHI.BHADAURIYA	X
/2	Table of contents : /1 - /27		06-11-2025	SAKSHI.BHADAURIYA	
/3	GENERAL SPECIFICATIONS		06-11-2025	SAKSHI.BHADAURIYA	
/4	GENERAL ARRANGEMENT DRAWING		06-11-2025	SAKSHI.BHADAURIYA	
/5	LEGENDS DETAILS		06-11-2025	SAKSHI.BHADAURIYA	
/6	SINGLE LINE DIAGRAM		06-11-2025	SAKSHI.BHADAURIYA	
/7	SINGLE LINE DIAGRAM		06-11-2025	SAKSHI.BHADAURIYA	
/8	INCOMER WIRING		06-11-2025	SAKSHI.BHADAURIYA	
/9	CONTROL WIRING		06-11-2025	SAKSHI.BHADAURIYA	
/10	RAW EFFLUENT TRANSFER PUMP POWER & CONTROL WIRING		06-11-2025	SAKSHI.BHADAURIYA	
/11	PRIMARY TREATED TRANSFER PUMP POWER & CONTROL WIRING		06-11-2025	SAKSHI.BHADAURIYA	
/12	FILTER FEED PUMP-P1&P2 POWER & CONTROL WIRING		06-11-2025	SAKSHI.BHADAURIYA	
/13	SLUDGE WITHDRAW PUMP POWER & CONTROL WIRING		06-11-2025	SAKSHI.BHADAURIYA	
/14	AIR BLOWER - B1 & B2 POWER WIRING		06-11-2025	SAKSHI.BHADAURIYA	
/15	AIR BLOWER - B1 & B2 CONTROL WIRING		06-11-2025	SAKSHI.BHADAURIYA	
/16	AIR BLOWER - B1 & B2 VFD WIRING		06-11-2025	SAKSHI.BHADAURIYA	
/17	SUPPLY FEEDER POWER & CONTROL WIRING		06-11-2025	SAKSHI.BHADAURIYA	
/18	PLC WIRING DIAGRAM		06-11-2025	SAKSHI.BHADAURIYA	
/19	CPU-DIGITAL INPUT WIRING		06-11-2025	SAKSHI.BHADAURIYA	
/20	DIGITAL INPUT MODULE-1 WIRING DIAGRAM		06-11-2025	SAKSHI.BHADAURIYA	
/21	DIGITAL INPUT MODULE-1 WIRING DIAGRAM		06-11-2025	SAKSHI.BHADAURIYA	
/22	DIGITAL INPUT MODULE-2 WIRING DIAGRAM		06-11-2025	SAKSHI.BHADAURIYA	
/23	CPU DIGITAL OUTPUT WIRING		06-11-2025	SAKSHI.BHADAURIYA	
/24	DIGITAL OUTPUT MODULE-1 WIRING DIAGRAM		06-11-2025	SAKSHI.BHADAURIYA	
/25	DIGITAL OUTPUT MODULE-1 WIRING DIAGRAM		06-11-2025	SAKSHI.BHADAURIYA	
/26	ANALOG INPUT WIRING DIAGRAM		06-11-2025	SAKSHI.BHADAURIYA	
/27	TERMINATION		06-11-2025	SAKSHI.BHADAURIYA	

AQUACARESEE PVT. LTD.

OFFICE NO.204, 205 AND 206
VINAYAK ARCADE, 2ND FLOOR
OPP. BAJAJ AUTO, AKURDI,PUNE-411035
www.aquacaresee.co.in
MOB:-9049560684

REVISION	DETAILS	DATE	APPROVED	P.S.B.
03	AS BUILT	24-11-2025		
02	AS PER COMMENTS	01-10-2025		
01	AS PER COMMENTS	29-09-2025	DRAWN BY	N.A.
00	FOR APPROVAL	27-09-2025	CHECKED	V.S.K.

TITLE:- Table of contents : /1 - /27

SYSTEM:- EFFLUENT TREATMENT PLANT-10 KLD

PROJECT:- POWER CUM PLC PANEL FOR ETP PLANT

DRG. NO.:- -

SHEET NO. 2 / 27

REV.NO. AS BUILT

GENERAL SPECIFICATIONS

A. REFERENCES

01	CUSTOMER NAME	:	SHAH EYE CARE PVT. LTD.
02	PROJECT	:	EFFLUENT TREATMENT PLANT-10 KLD

B. SYSTEM PARAMETERS

01	RATED INCOMING	:	415VAC, 3PH. 3WIRE
02	RATED CONTROL	:	230VAC
03	VOLTAGE VARIATION, %	:	± 10%
04	TYPE OF SYSTEM	:	POWER CUM PLC PANEL
05	RATED FREQUENCY, Hz.	:	50 Hz ± 5%
06	AMBIENT TEMP.	:	40°C

C. CONSTRUCTION

01	MAKE OF PANEL	:	M.S FABRICATED		
02	DIMENSIONS IN MM.	:	1200+400(H)X800(W)X400(D)		
03	THICKNESS OF SHEET	:	ENCLOSURE	:	1.6MM (CRCA SHEET)
		:	DOORS	:	1.6MM (CRCA SHEET)
		:	MOUNTING PLATE	:	1.6MM (CRCA SHEET)
		:	GLAND PLATE.	:	1.6MM (CRCA SHEET)
04	GLAND PLATE	:	UNDRILLED GLAND PLATE FIXED WITH SCREWS AT BOTTOM		
05	GLAND MOUNTING	:	AT SITE		
06	CABLE ENTRY	:	FROM BOTTOM SIDE		
07	PANEL COLOUR	:	SIEMENS GREY RAL 7035 ,STRUCTURE FINISH		
08	MOUNTING PLATE	:	DIP ORANGE		
09	WALL MOUNTED	:	PROVIDED AT SIDE		
10	REAR ACCESS	:	NO		
11	DOORS	:	FRONT DOOR OPENING		
12	DEGREE OF PROTECTION	:	IP-42 INDOOR		

D. EQUIPMENT

01	CONTROL/PROTECTION	:	MCB'S FUSES USED
02	LABEL STICKERS	:	ALL LEGEND INSIDE PANEL WILL BE YELLOW STICKERS. YELLOW BACKGROUND WITH BLACK PRINTED LETTERS.
		:	ALL LEGEND OUTSIDE PANEL WILL BE ALLUMINIUM LABELS. BLACK BACKGROUND WITH WHITE PRINTED LETTERS.

03	WIRING COLOUR CODING				
	415V AC, 3Ph INCOMING	:	AS PER STANDARD	:	RED,YELLOW,BLUE & BLACK
	415V AC, 3Ph (POWER WIRING)	:	FOR 0.37-1.5kW FEEDER	:	2.5 SQ.MM RED/YELLOW/BLUE
	POWER EARTH	:	2.5 mm²	:	YELLOW/GREEN
04	CONTROL WIRING	:	230VAC	:	1.0 mm²
	230V AC PHASE	:	1.0 mm²	:	RED
	230V NEUTRAL	:	1.0 mm²	:	BLACK
	24VDC(+VE)	:	0.5 mm²	:	BLUE
	24VDC(-VE)	:	0.5 mm²	:	WHITE
	PLC INPUT	:	0.5 mm²	:	BLUE
	PLC OUTPUT	:	0.5 mm²	:	YELLOW
05	FERRULES	:	NUMBERS		
	FERRULING TYPE	:	BLACK LETTER ON WHITE SLEEVE (PRINTED FERRULE)		
06	TERMINAL COLOUR CODING				
	415V AC, 3Ph (POWER TERMINAL)	:	FOR 0.37-1.5kW FEEDER	:	6 SQ.MM RED/YELLOW/BLUE
07	CONTROL TERMINAL				
	DIGITAL INPUT	:	2.5 mm²	:	GREY
	DIGITAL OUTPUT	:	2.5 mm²	:	GREY

AQUACARESEE PVT. LTD.
OFFICE NO.204, 205 AND 206
VINAYAK ARCADE, 2ND FLOOR
OPP. BAJAJ AUTO, AKURDI,PUNE-411035
www.aquacaresee.co.in
MOB:-9049560684

REVISION	DETAILS	DATE		
03	AS BUILT	24-11-2025		
02	AS PER COMMENTS	01-10-2025		
01	AS PER COMMENTS	29-09-2025	DRAWN BY	N.A.
00	FOR APPROVAL	27-09-2025	CHECKED	V.S.K.
			APPROVED	P.S.B.

TITLE:- GENERAL SPECIFICATIONS

SYSTEM:- EFFLUENT TREATMENT PLANT-10 KLD


PROJECT:- POWER CUM PLC PANEL FOR ETP PLANT

DRG. NO.:- -


REV.NO. AS BUILT

EXTERNAL & INTERNAL GENERAL ARANGEMENT DRAWING


RHS VIEW

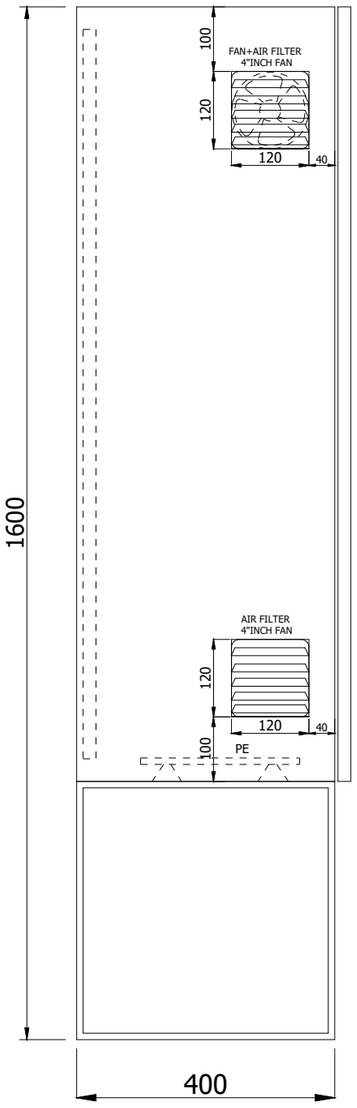


FRONT VIEW

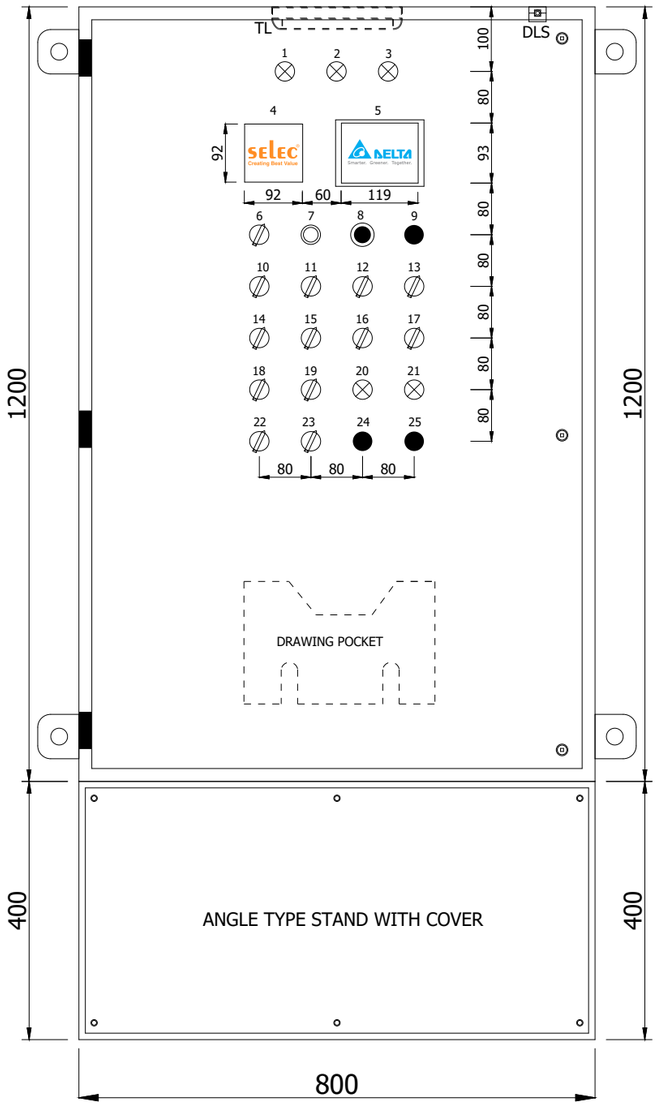


RHS VIEW

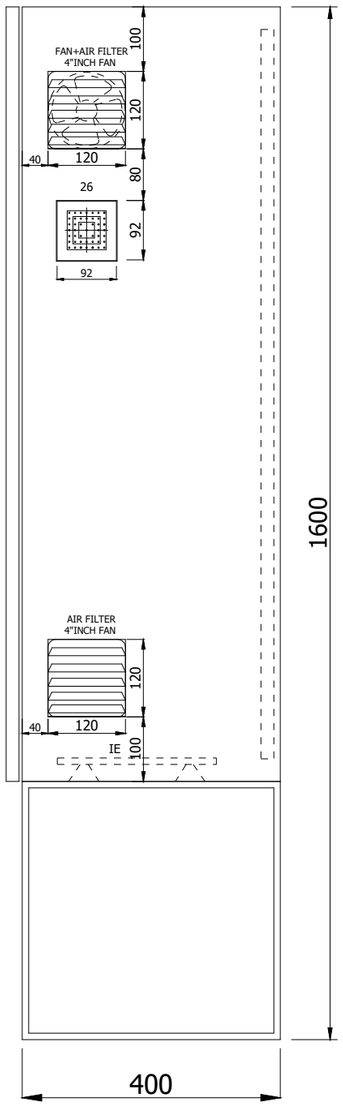

MOUNTING VIEW

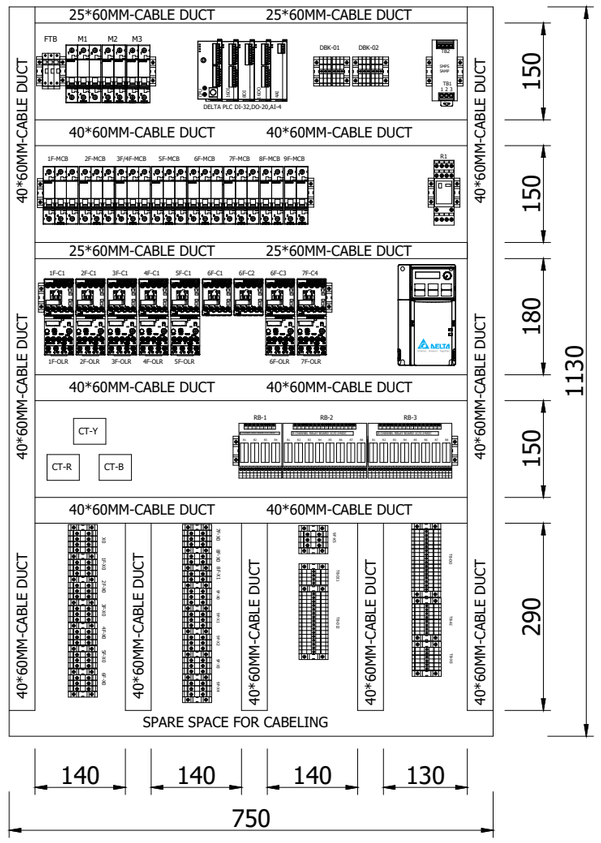

BOTTOM VIEW

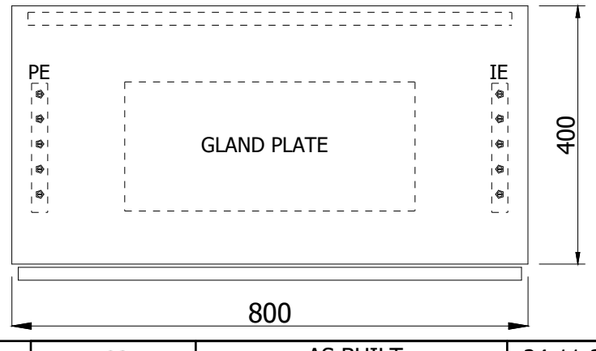

AQUACARESEE PVT. LTD.
OFFICE NO.204, 205 AND 206
VINAYAK ARCADE, 2ND FLOOR
OPP. BAJAJ AUTO, AKURDI,PUNE-411035
www.aquacaresee.co.in
MOB:-9049560684

REVISION	DETAILS	DATE	APPROVED	P.S.B.
03	AS BUILT	24-11-2025		
02	AS PER COMMENTS	01-10-2025		
01	AS PER COMMENTS	29-09-2025	DRAWN BY	N.A.
00	FOR APPROVAL	27-09-2025	CHECKED	V.S.K.

TITLE:- GENERAL ARRANGEMENT DRAWING

SYSTEM:- EFFLUENT TREATMENT PLANT-10 KLD

PROJECT:- POWER CUM PLC PANEL FOR ETP PLANT

DRG. NO.:- -

SHEET NO. 4 / 27

REV.NO. AS BUILT

PANEL LEGENDS DETAILS

FEEDER NO.	FEEDER NAME	RATING	SR NO.	DESCRIPTION	CUTOUT DETAILS (Ø22.5)
-	INCOMER SECTION	-	1	R-PHASE IND.	(Ø22.5)
			2	Y-PHASE IND.	(Ø22.5)
			3	B-PHASE IND.	(Ø22.5)
			4	ENERGY METER	□ 92*92
-	CONTROL SECTION	-	5	HMI	□119*93
			6	PANEL LOCAL/REMOTE SSW	(Ø22.5)
			7	ALARM ACCEPT PB	(Ø22.5)
			8	PANEL EMERGENCY STOP PB	(Ø22.5)
			9	DUMMY	(Ø22.5)
1F	RAW EFFLUENT TRANSFER PUMP	1.5kW	10	1F-LOCAL/REMOTE ILSW (GREEN)	(Ø22.5)
2F	PRIMARY TREATED TRANSFER PUMP	0.37kW	11	2F-LOCAL/REMOTE ILSW (GREEN)	(Ø22.5)
3F	FILTER FEED PUMP-P1	1.1kW	12	3F-LOCAL/REMOTE ILSW (GREEN)	(Ø22.5)
4F	FILTER FEED PUMP-P2	1.1kW	13	4F-LOCAL/REMOTE ILSW (GREEN)	(Ø22.5)
5F	SLUDGE WITHDRAW PUMP	0.37W	14	5F-LOCAL/REMOTE ILSW (GREEN)	(Ø22.5)
-	AIR BLOWER-1&2 VFD/DOL	0.75kW	15	6F/7F-1 & 2 SSW	(Ø22.5)
6F	AIR BLOWER-B1	0.75kW	16	6F-LOCAL/REMOTE ILSW1 (GREEN)	(Ø22.5)
7F	AIR BLOWER-B2	0.75kW	17	7F-LOCAL/REMOTE ILSW1 (GREEN)	(Ø22.5)
-	AIR BLOWER-1 VFD	-	18	6F-LOCAL/REMOTE ILSW2 (GREEN)	(Ø22.5)
-	AIR BLOWER-2 VFD	-	19	7F-LOCAL/REMOTE ILSW2 (GREEN)	(Ø22.5)
-	AIR BLOWER-1&2 VFD ON	-	20	ON IND.	(Ø22.5)
-	AIR BLOWER-1&2 VFD TRIP	-	21	TRIP IND.	(Ø22.5)
8F	HYPO DOSING PUMP	0.03kW	22	8F-LOCAL/REMOTE ILSW-1 (GREEN)	(Ø22.5)
8F	AIR COMPRESSOR	0.75kW	23	8F-LOCAL/REMOTE ILSW-2 (GREEN)	(Ø22.5)
-	-	-	24	DUMMY	(Ø22.5)
-	-	-	25	DUMMY	(Ø22.5)
-	-	-	26	HOOTER	□ 90*90

AQUACARESEE PVT. LTD.
OFFICE NO.204, 205 AND 206
VINAYAK ARCADE, 2ND FLOOR
OPP. BAJAJ AUTO, AKURDI,PUNE-411035
www.aquacaresee.co.in
MOB:-9049560684

REVISION	DETAILS	DATE	APPROVED	P.S.B.
03	AS BUILT	24-11-2025		
02	AS PER COMMENTS	01-10-2025		
01	AS PER COMMENTS	29-09-2025	DRAWN BY	N.A.
00	FOR APPROVAL	27-09-2025	CHECKED	V.S.K.

TITLE:- LEGENDS DETAILS

SYSTEM:- EFFLUENT TREATMENT PLANT-10 KLD


PROJECT:- POWER CUM PLC PANEL FOR ETP PLANT

DRG. NO.:- -

SHEET NO. 5 / 27

REV.NO. AS BUILT

SINGLE LINE DIAGRAM

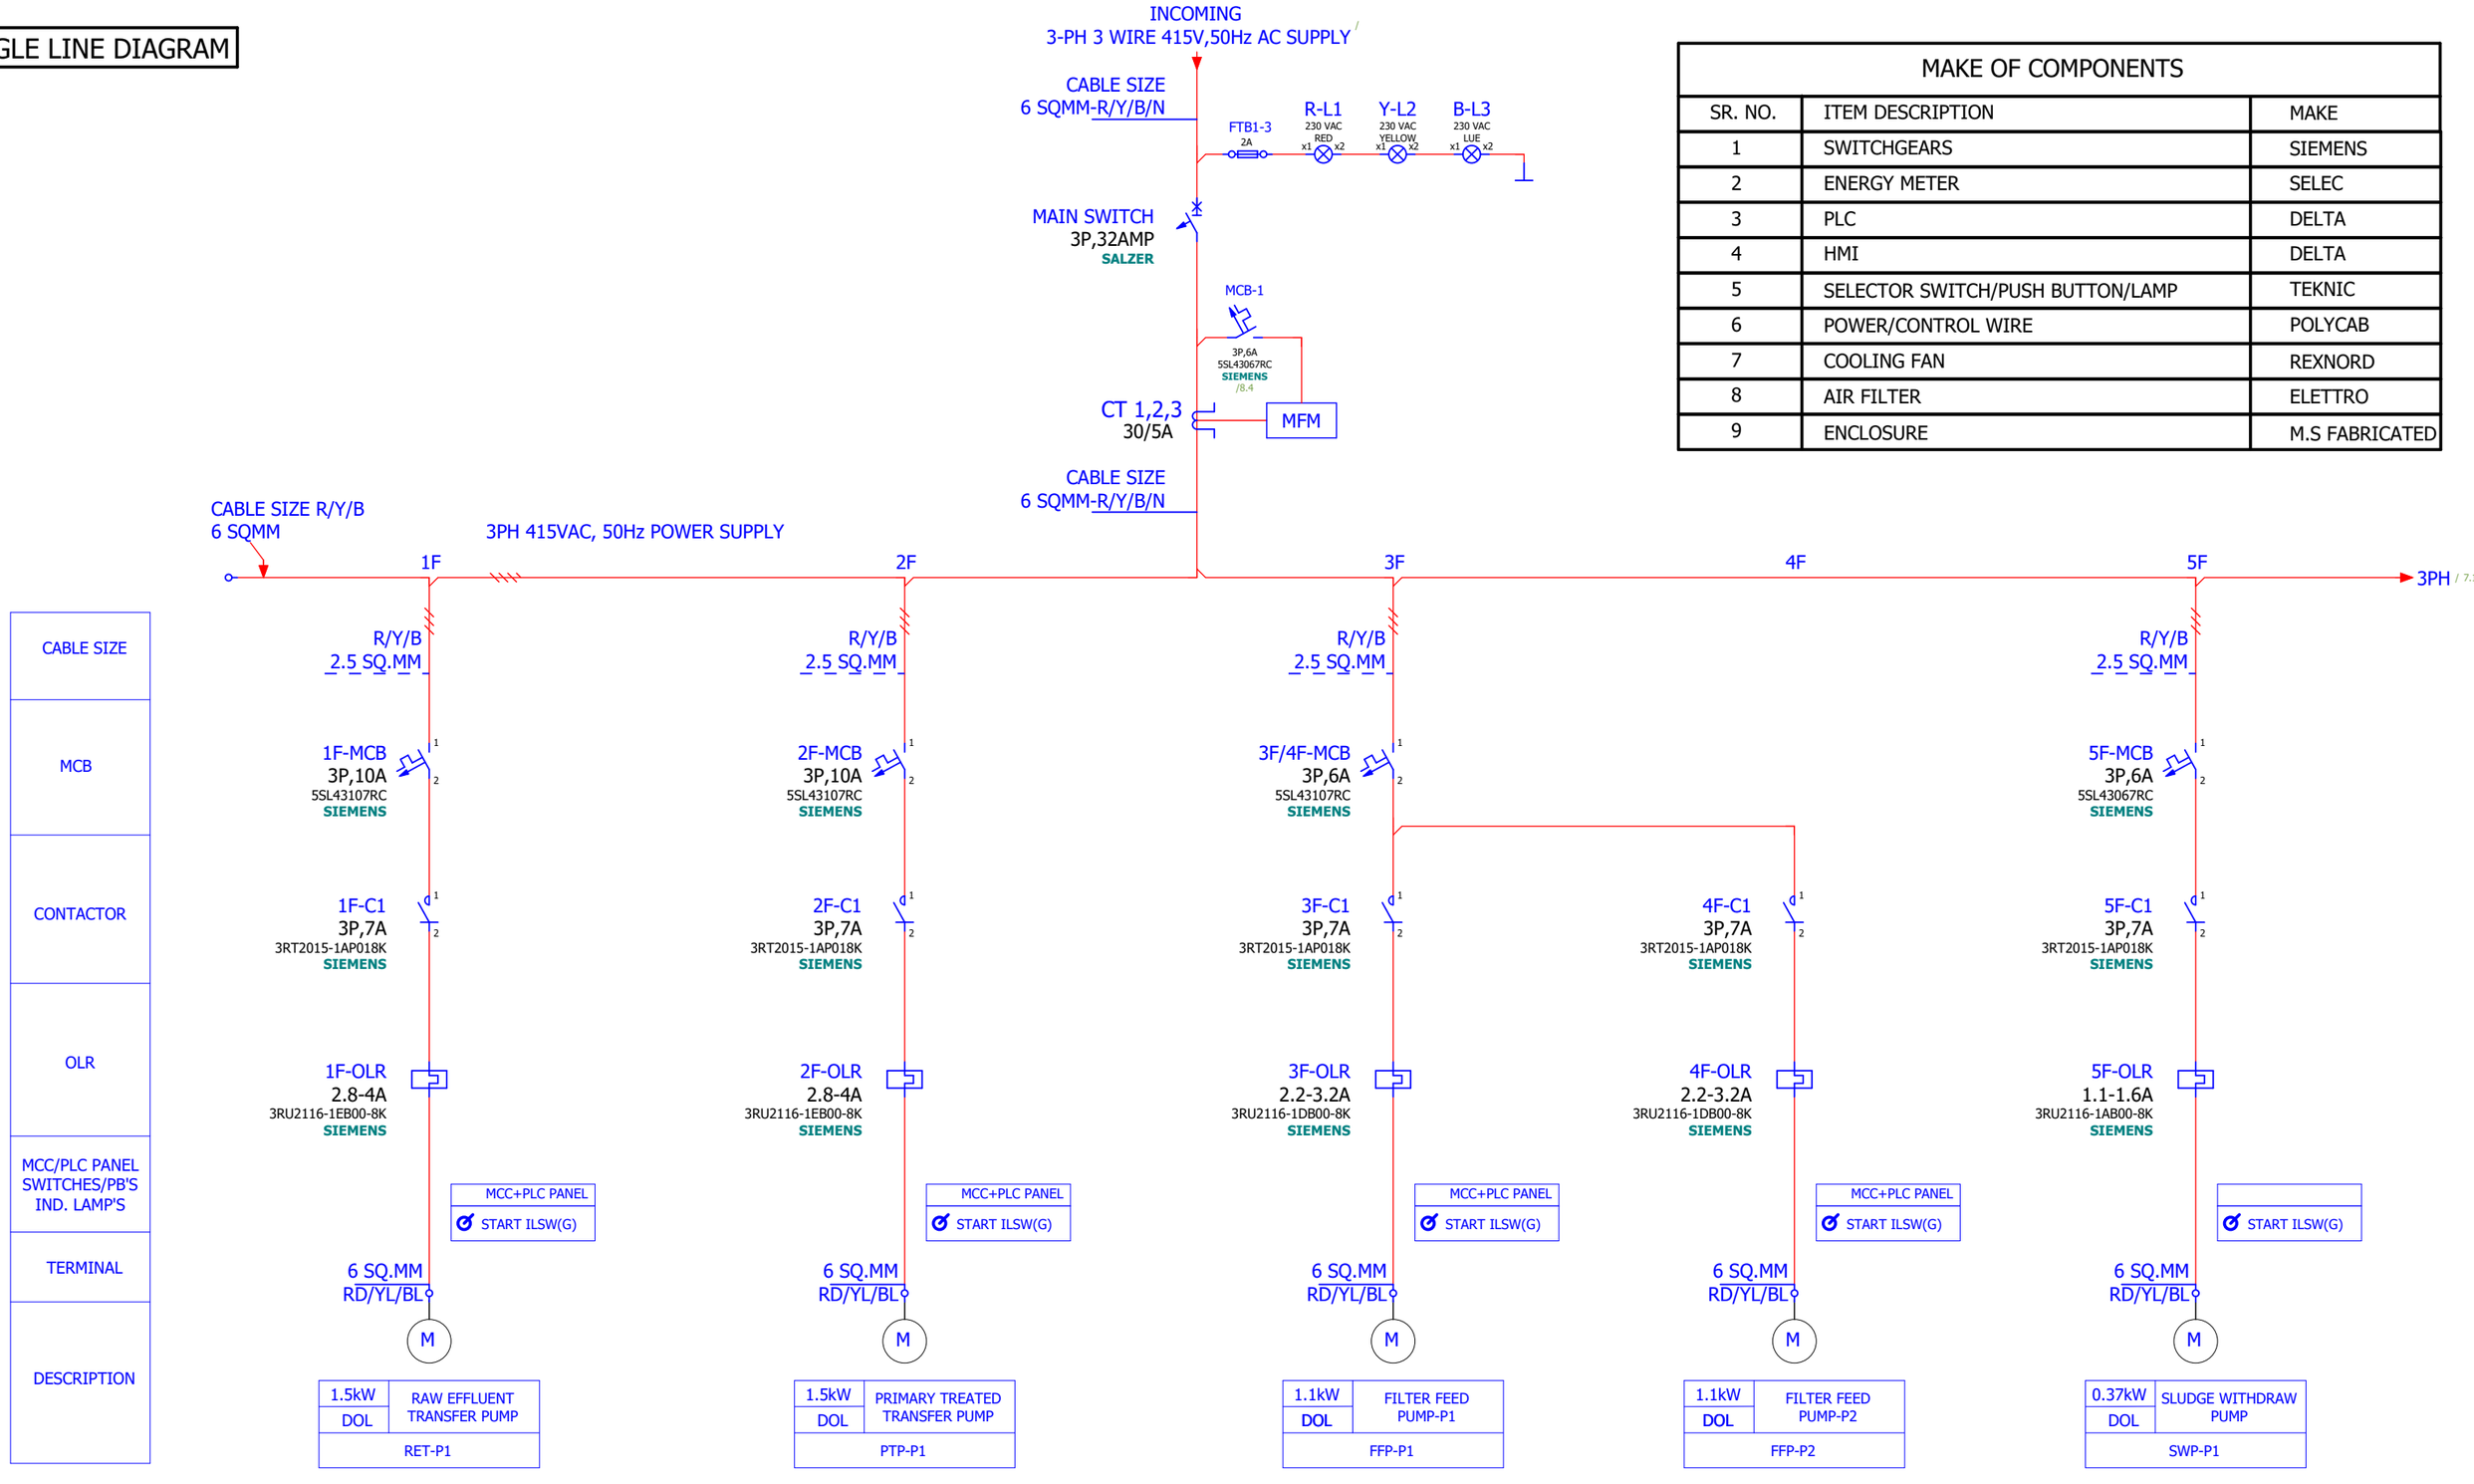

MAKE OF COMPONENTS

SR. NO.	ITEM DESCRIPTION	MAKE
1	SWITCHGEARS	SIEMENS
2	ENERGY METER	SELEC
3	PLC	DELTA
4	HMI	DELTA
5	SELECTOR SWITCH/PUSH BUTTON/LAMP	TEKNIC
6	POWER/CONTROL WIRE	POLYCAB
7	COOLING FAN	REXNORD
8	AIR FILTER	ELETTRO
9	ENCLOSURE	M.S FABRICATED


AQUACARESEE PVT. LTD.
OFFICE NO.204, 205 AND 206
VINAYAK ARCADE, 2ND FLOOR
OPP. BAJAJ AUTO, AKURDI,PUNE-411035
www.aquacaresee.co.in
MOB:-9049560684

REVISION	DETAILS	DATE		
03	AS BUILT	24-11-2025	TITLE:- SINGLE LINE DIAGRAM	
02	AS PER COMMENTS	01-10-2025		
01	AS PER COMMENTS	29-09-2025	DRAWN BY	N.A.
00	FOR APPROVAL	27-09-2025	CHECKED	V.S.K.
			APPROVED	P.S.B.

SYSTEM:-	EFFLUENT TREATMENT PLANT-10 KLD		
PROJECT:-	POWER CUM PLC PANEL FOR ETP PLANT		
DRG. NO.:-	-	SHEET NO. 6 / 27	REV.NO. AS BUILT

SINGLE LINE DIAGRAM

MAKE OF COMPONENTS		
SR. NO.	ITEM DESCRIPTION	MAKE
1	SWITCHGEARS	SIEMENS
2	ENERGY METER	SELEC
3	PLC	DELTA
4	HMI	DELTA
5	SELECTOR SWITCH/PUSH BUTTON/LAMP	TEKNIC
6	POWER/CONTROL WIRE	POLYCAB
7	COOLING FAN	REXNORD
8	AIR FILTER	ELETTRO
9	ENCLOSURE	M.S FABRICATED

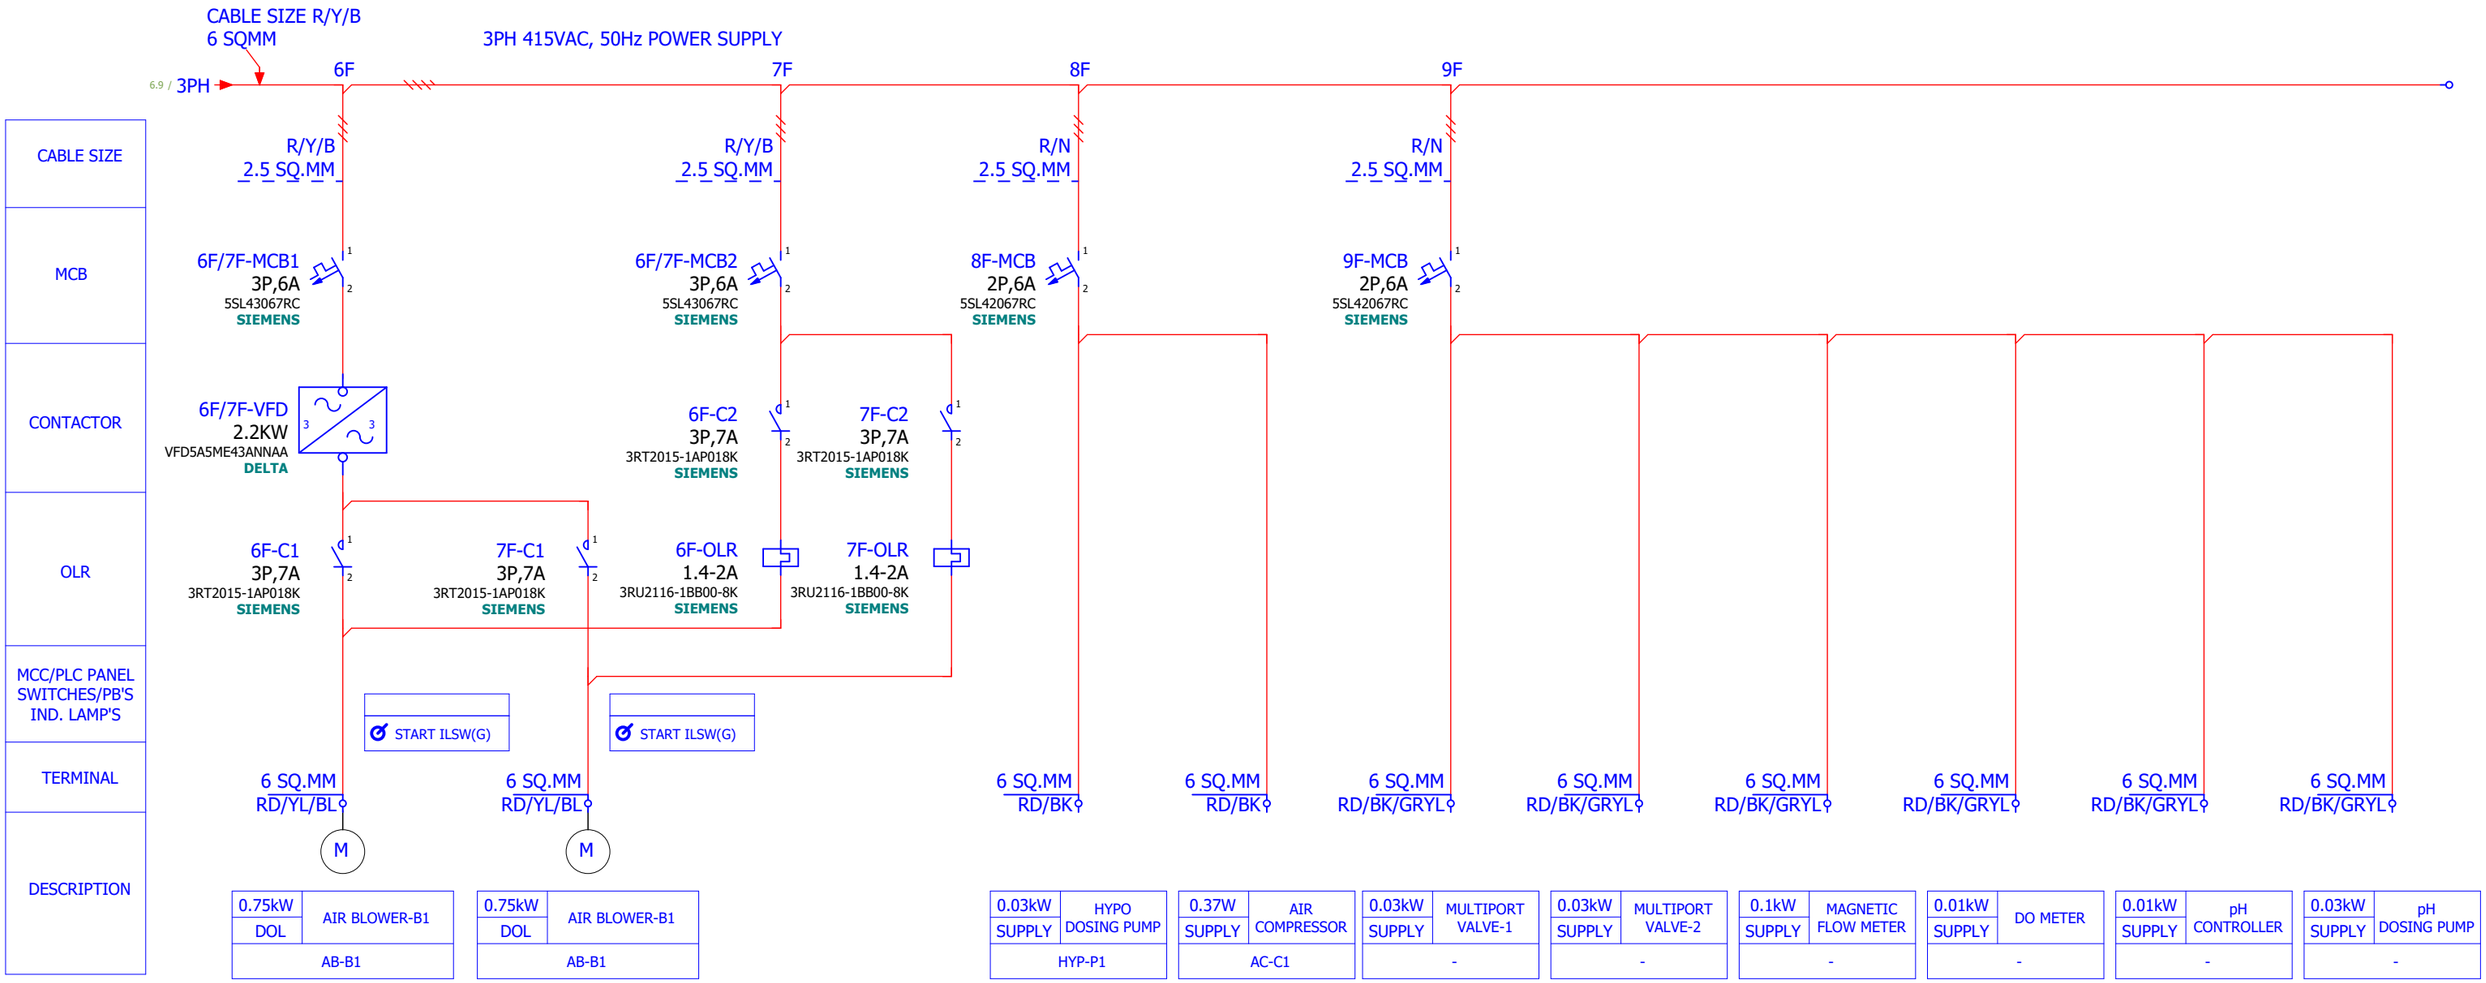

AQUACARESEE PVT. LTD.

OFFICE NO.204, 205 AND 206
VINAYAK ARCADE, 2ND FLOOR
OPP. BAJAJ AUTO, AKURDI,PUNE-411035
www.aquacaresee.co.in
MOB:-9049560684

REVISION	DETAILS	DATE		
03	AS BUILT	24-11-2025	TITLE:- SINGLE LINE DIAGRAM	
02	AS PER COMMENTS	01-10-2025		
01	AS PER COMMENTS	29-09-2025	DRAWN BY	N.A.
00	FOR APPROVAL	27-09-2025	CHECKED	V.S.K.
			APPROVED	P.S.B.


SYSTEM:- EFFLUENT TREATMENT PLANT-10 KLD

PROJECT:- POWER CUM PLC PANEL FOR ETP PLANT

DRG. NO.:- -

SHEET NO. 7 / 27

REV.NO. AS BUILT

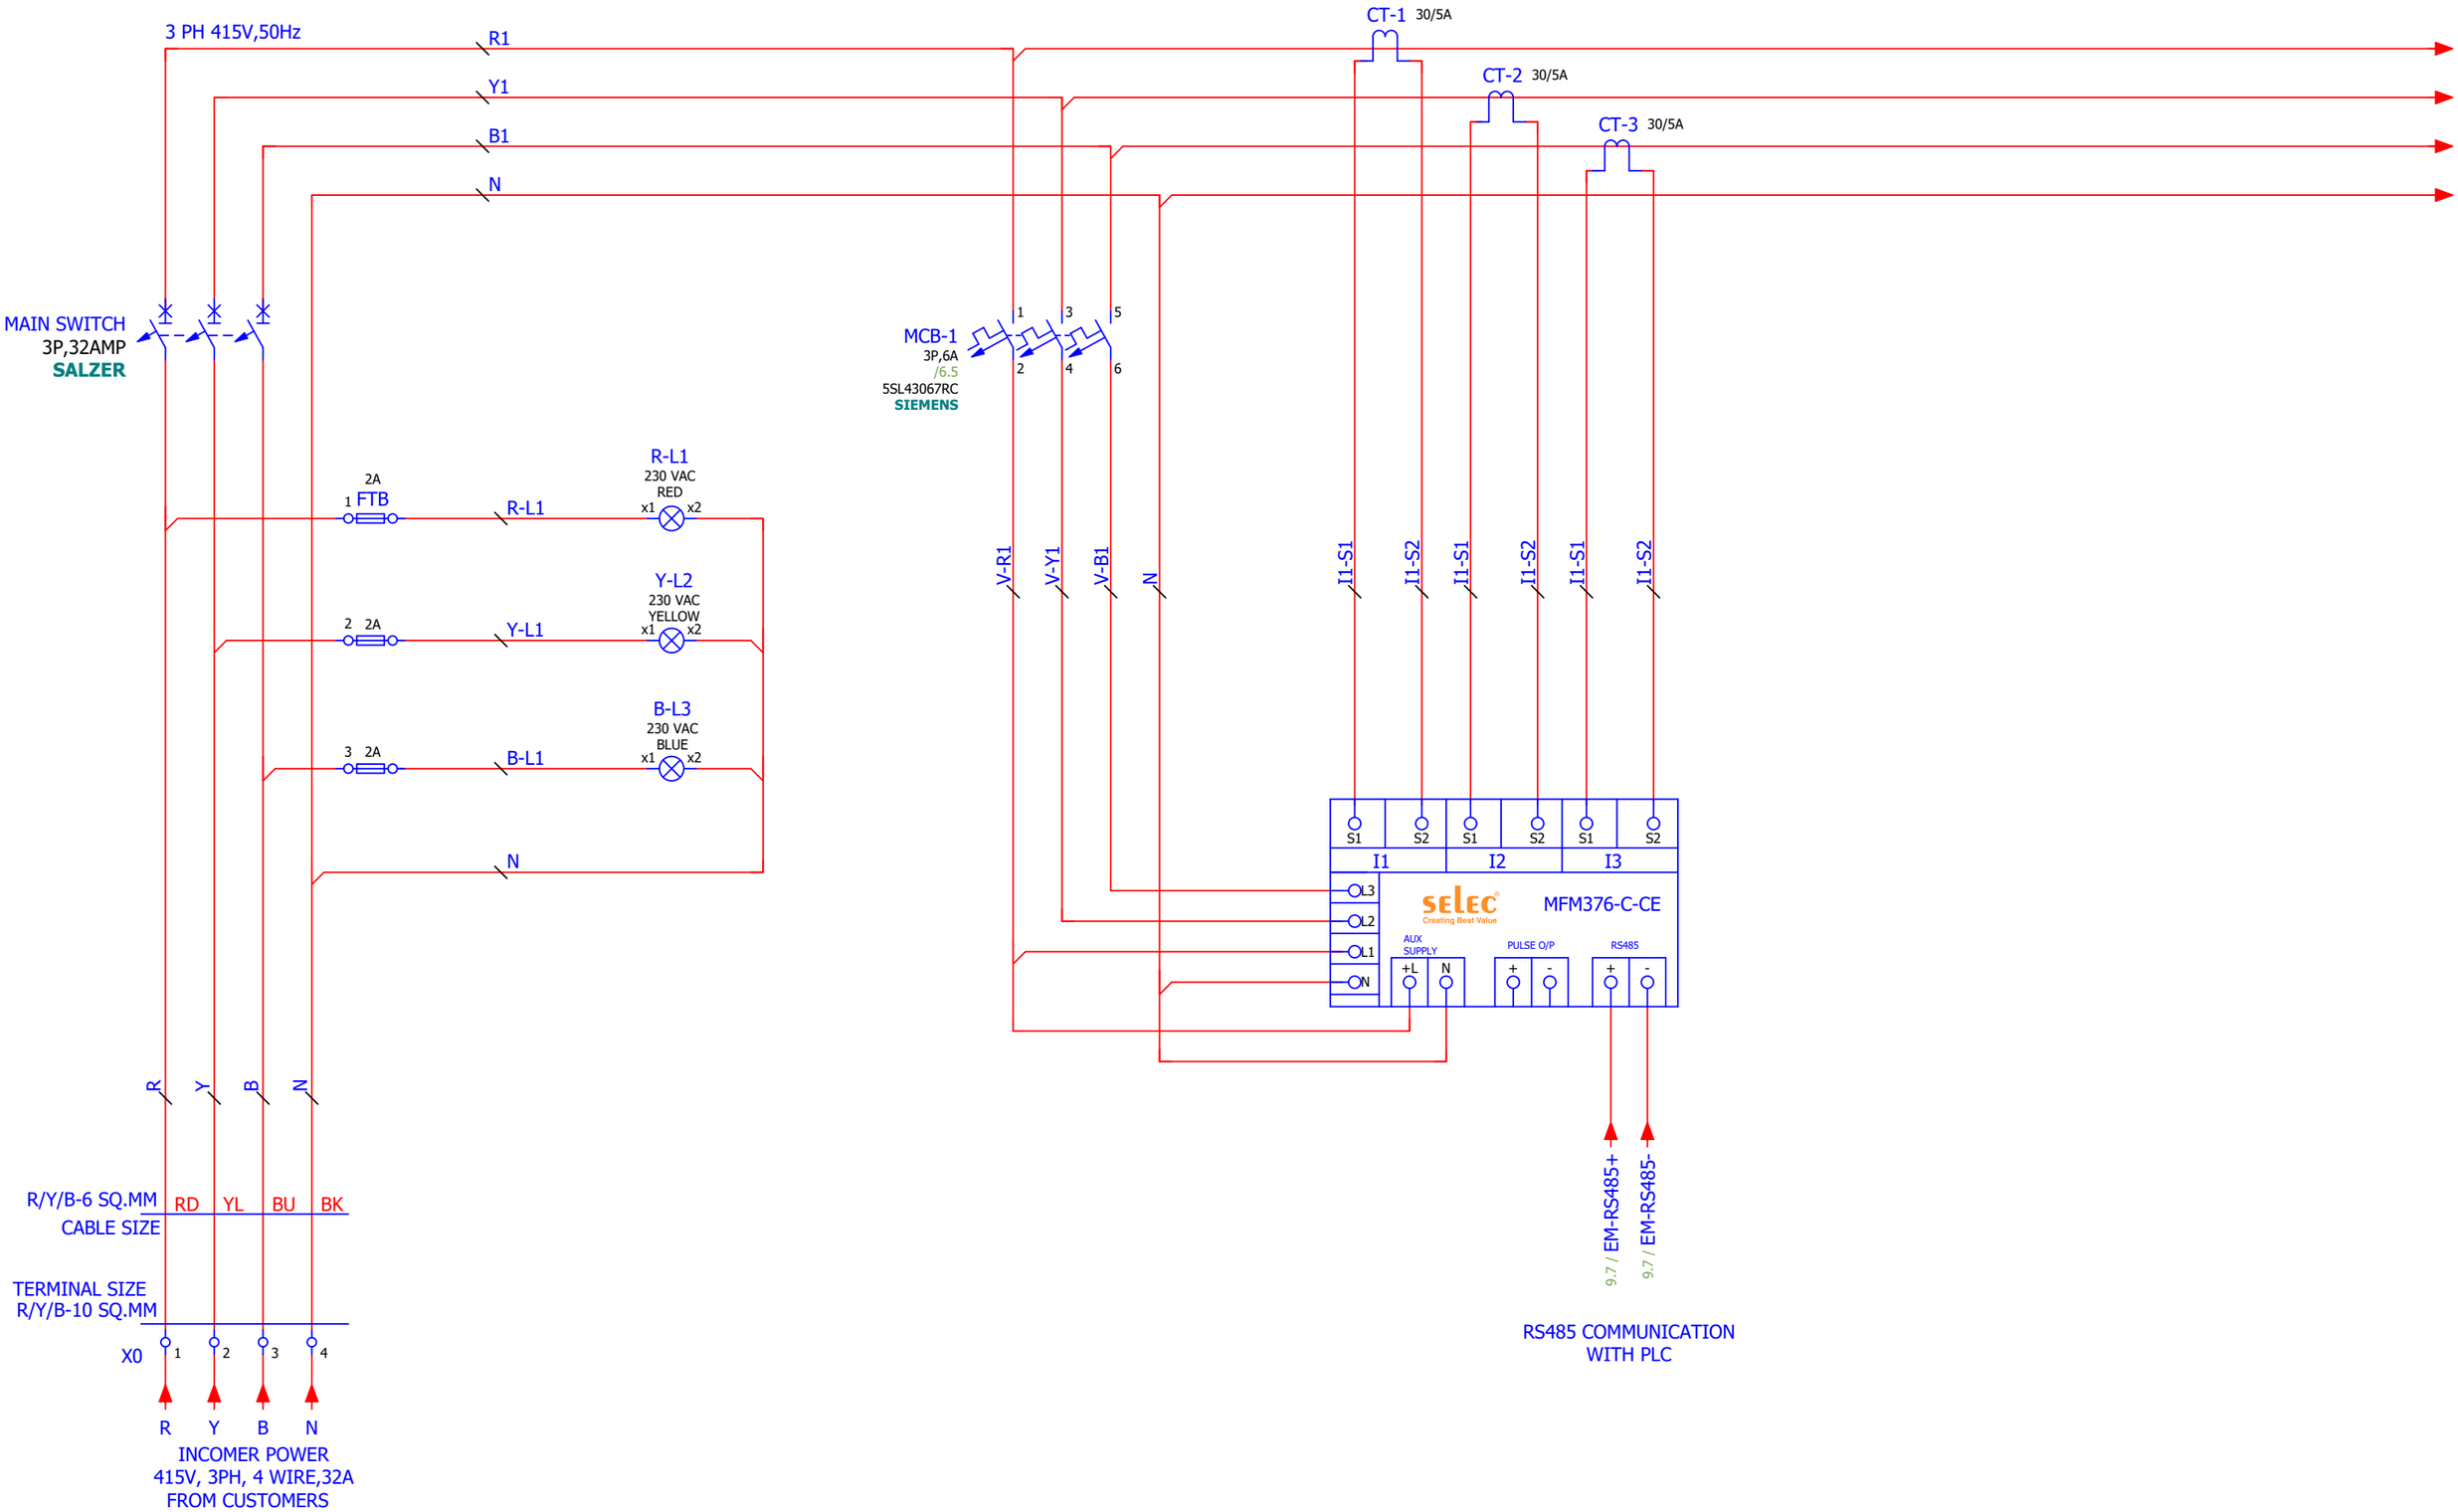

AQUACARESEE PVT. LTD.

OFFICE NO.204, 205 AND 206
VINAYAK ARCADE, 2ND FLOOR
OPP. BAJAJ AUTO, AKURDI,PUNE-411035
www.aquacaresee.co.in
MOB:-9049560684

REVISION	DETAILS	DATE	APPROVED	P.S.B.
03	AS BUILT	24-11-2025	CHECKED	V.S.K.
02	AS PER COMMENTS	01-10-2025	DRAWN BY	N.A.
01	AS PER COMMENTS	29-09-2025		
00	FOR APPROVAL	27-09-2025		

TITLE:- INCOMER WIRING


SYSTEM:- EFFLUENT TREATMENT PLANT-10 KLD

PROJECT:- POWER CUM PLC PANEL FOR ETP PLANT

DRG. NO.:- -

SHEET NO. 8 / 27

REV.NO. AS BUILT

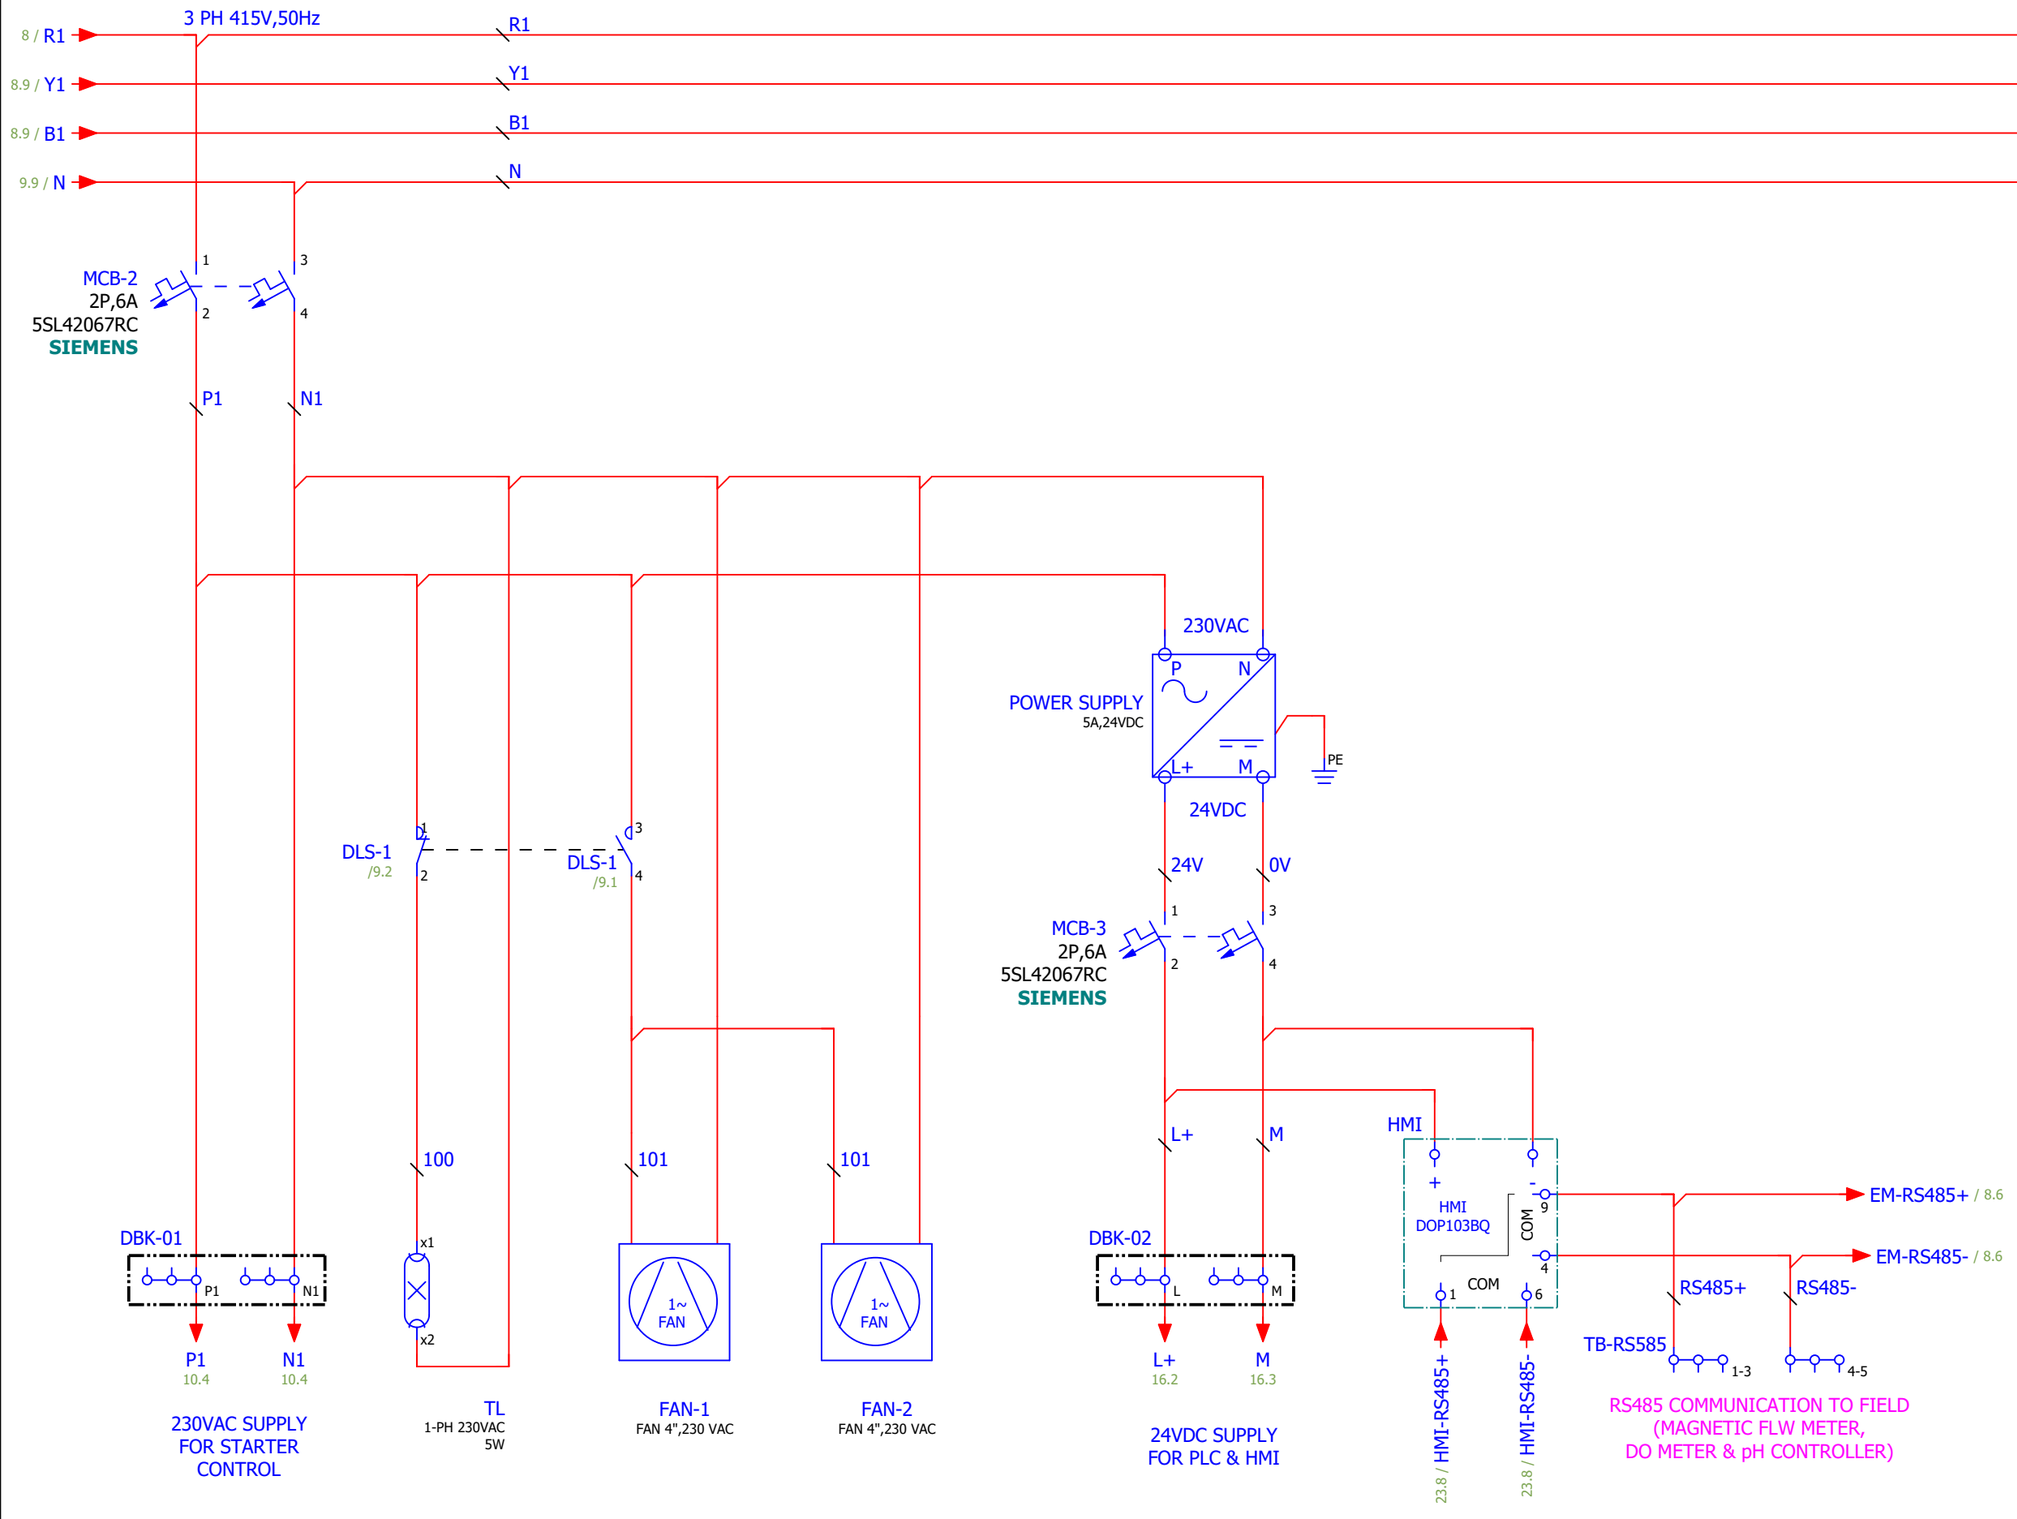

AQUACARESEE PVT. LTD.

OFFICE NO.204, 205 AND 206
VINAYAK ARCADE, 2ND FLOOR
OPP. BAJAJ AUTO, AKURDI,PUNE-411035
www.aquacaresee.co.in
MOB:-9049560684

REVISION	DETAILS	DATE	APPROVED	P.S.B.
03	AS BUILT	24-11-2025		
02	AS PER COMMENTS	01-10-2025		
01	AS PER COMMENTS	29-09-2025	DRAWN BY	N.A.
00	FOR APPROVAL	27-09-2025	CHECKED	V.S.K.

TITLE:- CONTROL WIRING

SYSTEM:- EFFLUENT TREATMENT PLANT-10 KLD


PROJECT:- POWER CUM PLC PANEL FOR ETP PLANT

DRG. NO.:- -

SHEET NO. 9 / 27

REV.NO. AS BUILT

RAW EFFLUENT TRANSFER PUMP

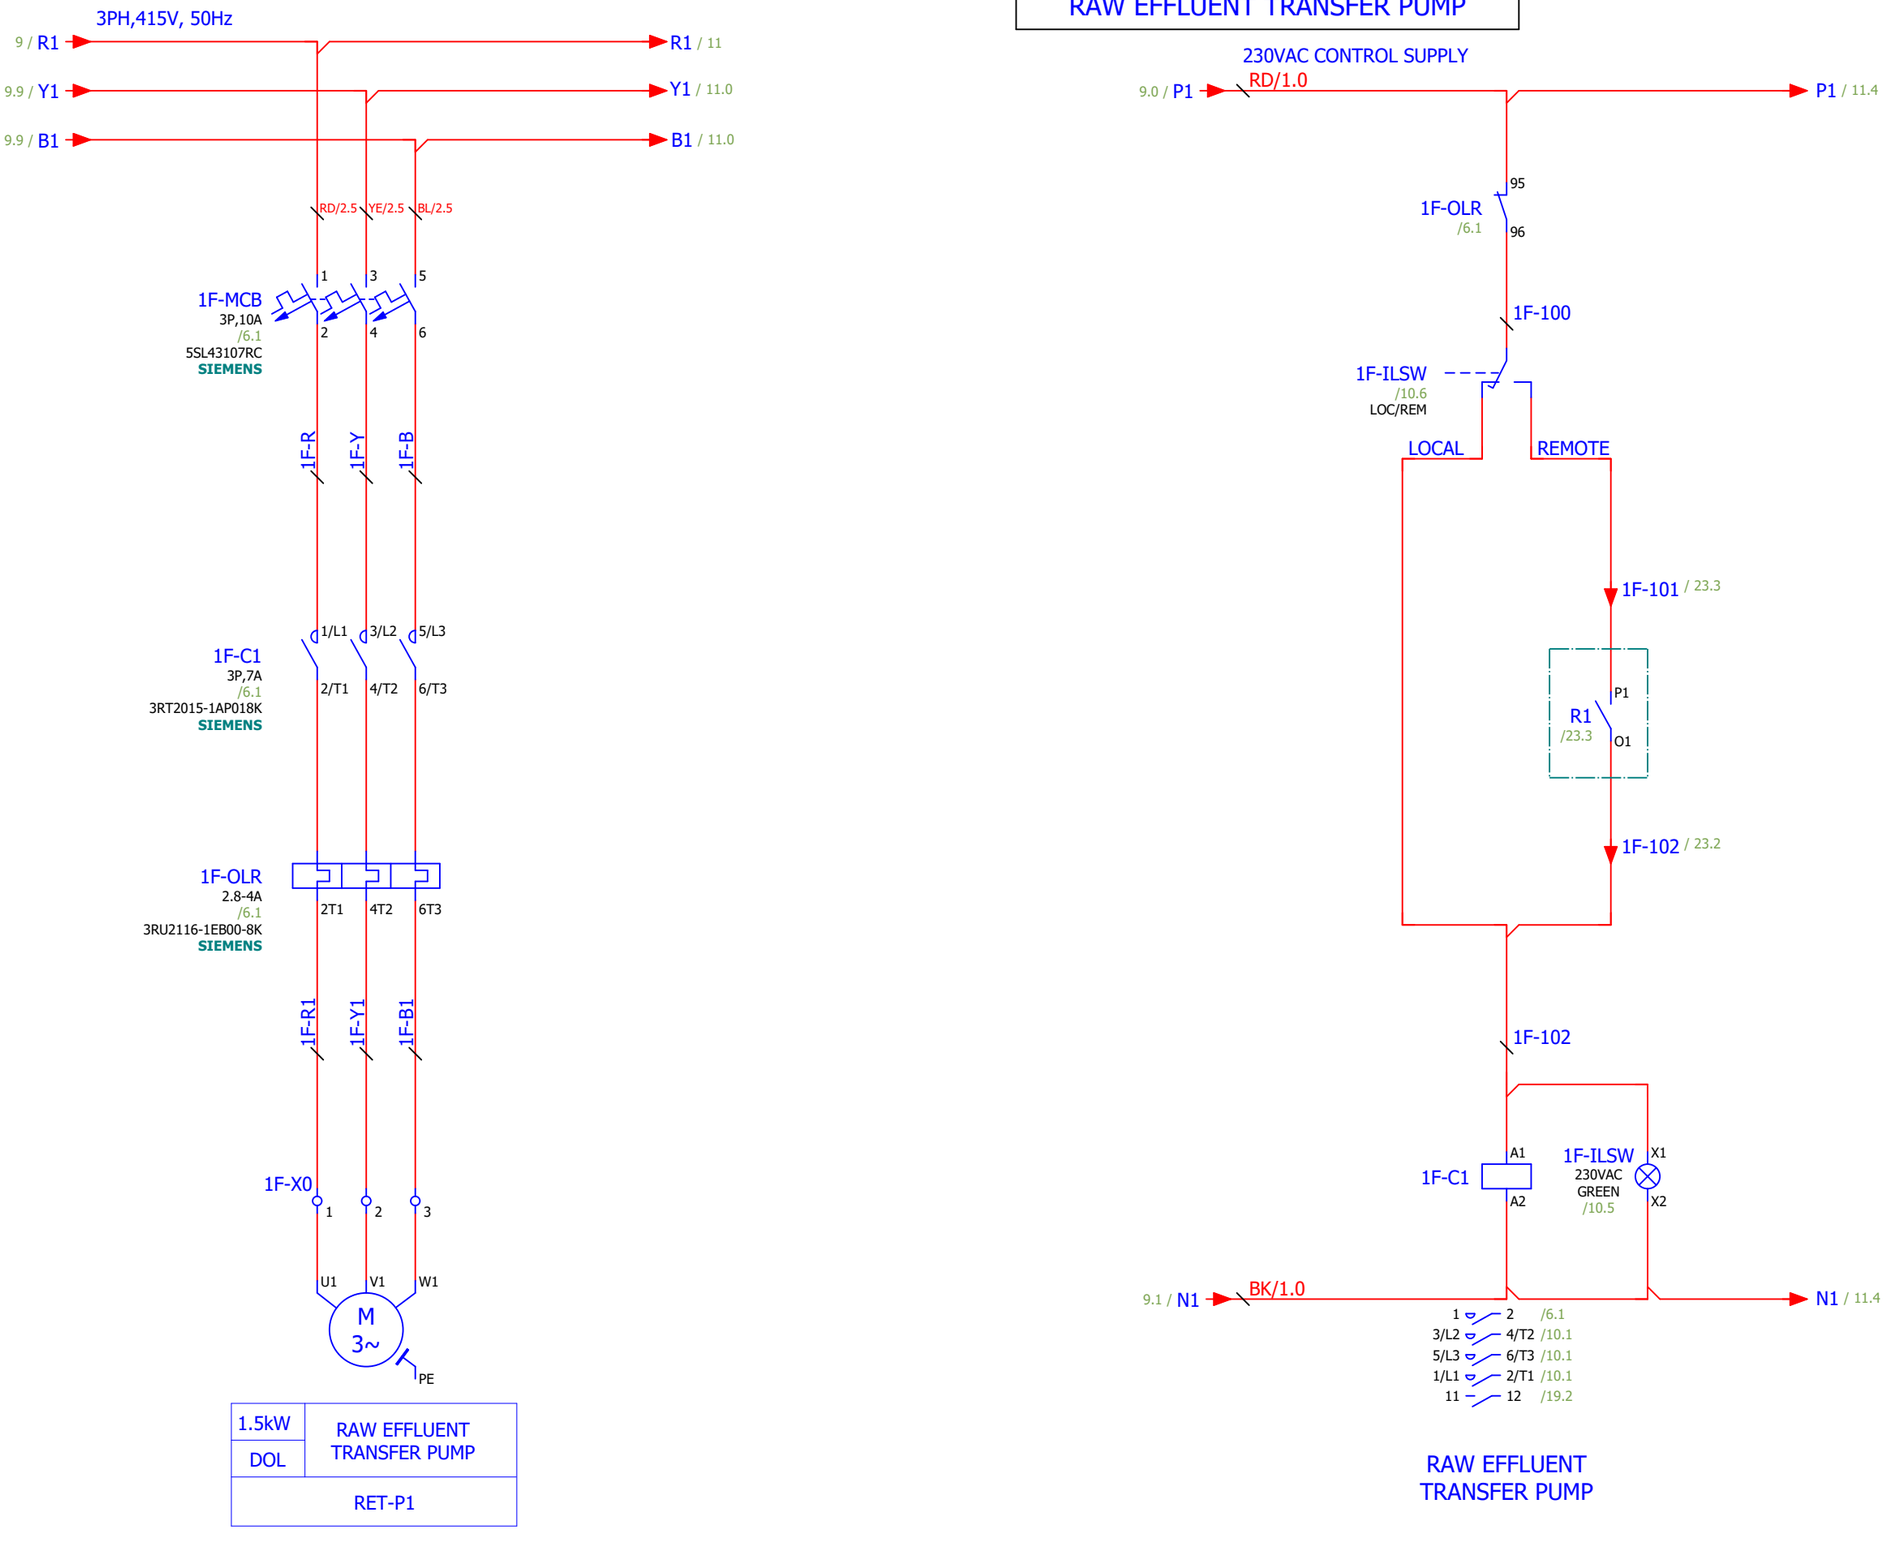

1.5kW	RAW EFFLUENT TRANSFER PUMP
DOL	
RET-P1	

RAW EFFLUENT TRANSFER PUMP

AQUACARESEE PVT. LTD.

OFFICE NO.204, 205 AND 206
VINAYAK ARCADE, 2ND FLOOR
OPP. BAJAJ AUTO, AKURDI,PUNE-411035
www.aquacaresee.co.in
MOB:-9049560684

REVISION	DETAILS	DATE	APPROVED	P.S.B.
03	AS BUILT	24-11-2025		
02	AS PER COMMENTS	01-10-2025		
01	AS PER COMMENTS	29-09-2025	DRAWN BY	N.A.
00	FOR APPROVAL	27-09-2025	CHECKED	V.S.K.

TITLE:- RAW EFFLUENT TRANSFER PUMP POWER & CONTROL WIRING

SYSTEM:- EFFLUENT TREATMENT PLANT-10 KLD


PROJECT:- POWER CUM PLC PANEL FOR ETP PLANT

DRG. NO.:- -


SHEET NO. 10 / 27

REV.NO. AS BUILT

PRIMARY TREATED TRANSFER PUMP

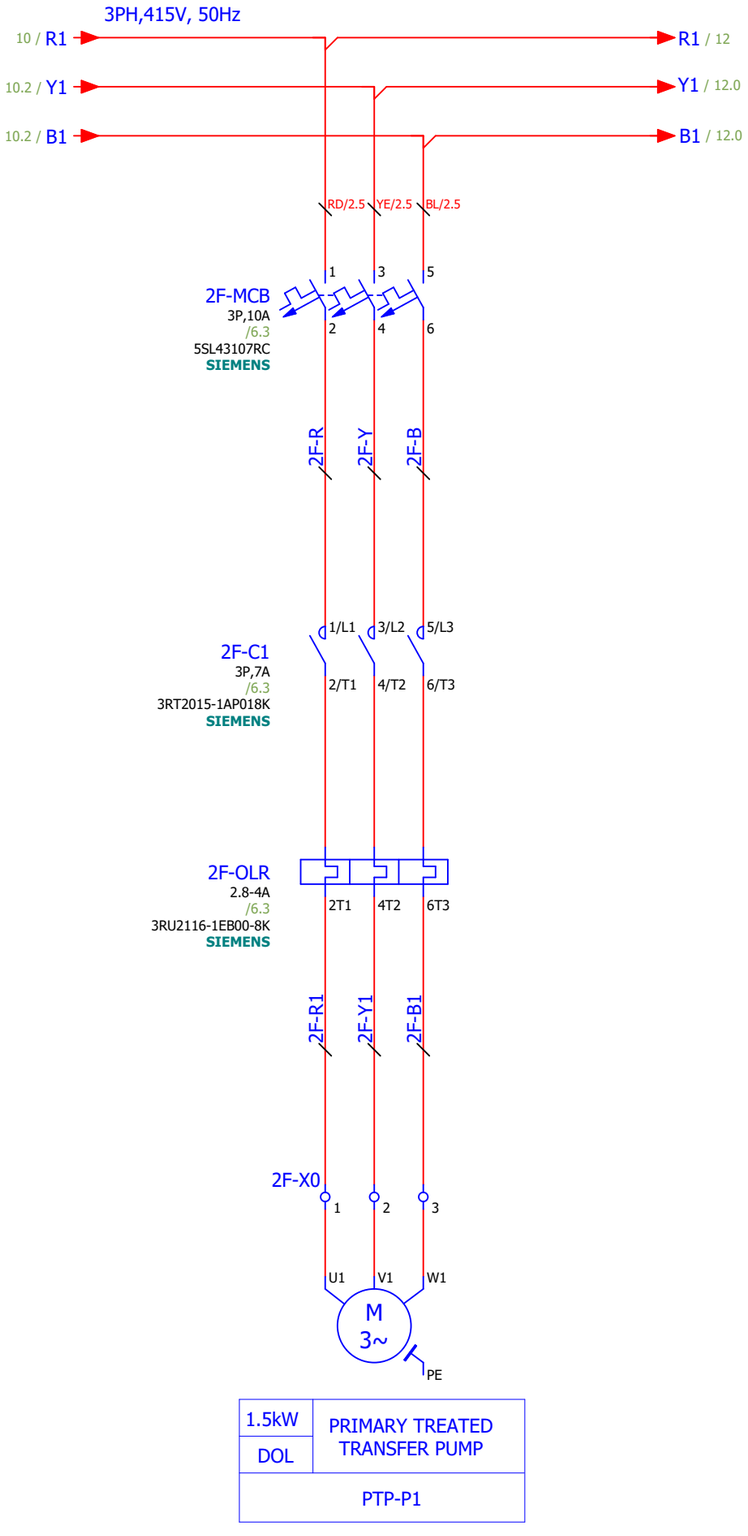

1.5kW	PRIMARY TREATED TRANSFER PUMP
DOL	
PTP-P1	

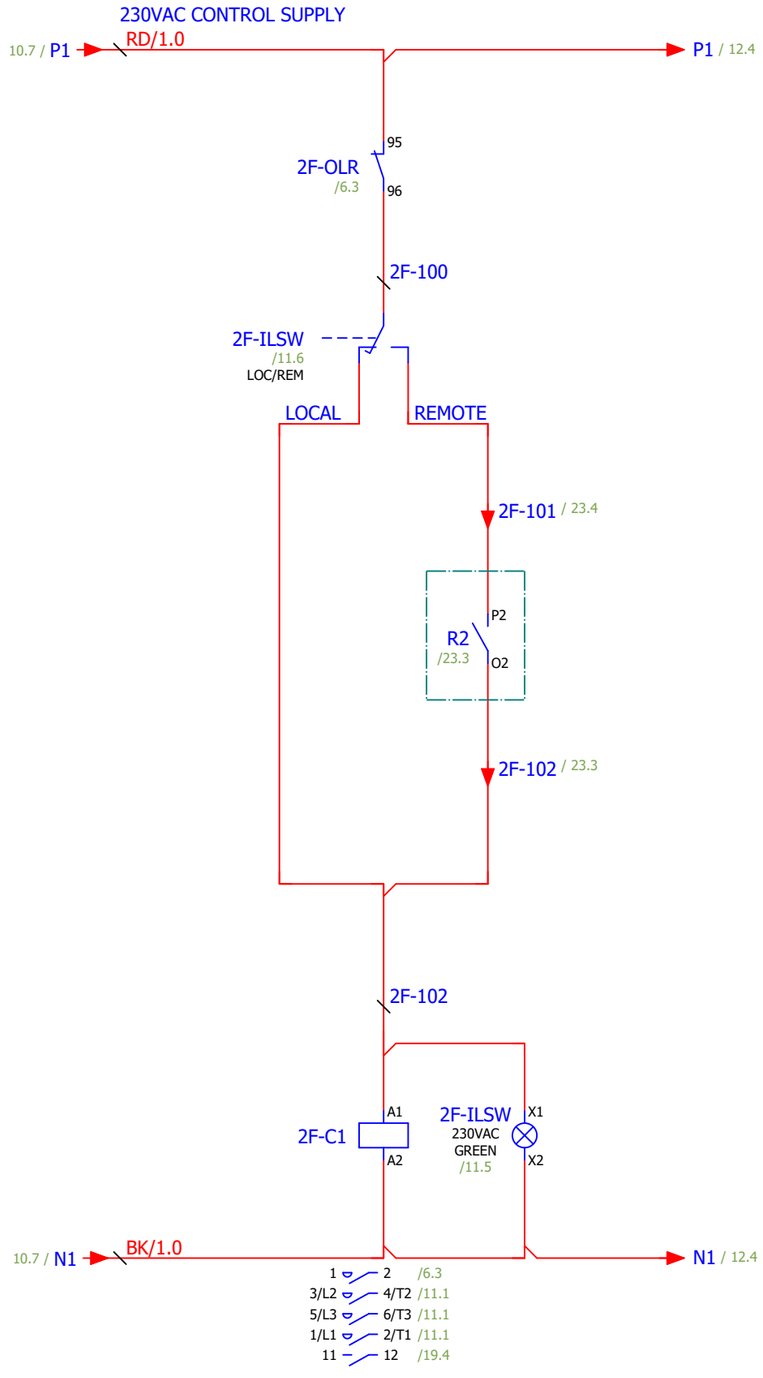


PRIMARY TREATED TRANSFER PUMP

AQUACARESEE PVT. LTD.
OFFICE NO.204, 205 AND 206
VINAYAK ARCADE, 2ND FLOOR
OPP. BAJAJ AUTO, AKURDI,PUNE-411035
www.aquacaresee.co.in
MOB:-9049560684

REVISION	DETAILS	DATE		
03	AS BUILT	24-11-2025	TITLE:- PRIMARY TREATED TRANSFER PUMP POWER & CONTROL WIRING	
02	AS PER COMMENTS	01-10-2025		
01	AS PER COMMENTS	29-09-2025	DRAWN BY	N.A.
00	FOR APPROVAL	27-09-2025	CHECKED	V.S.K.
			APPROVED	P.S.B.

SYSTEM:-	EFFLUENT TREATMENT PLANT-10 KLD		
PROJECT:-	POWER CUM PLC PANEL FOR ETP PLANT		
DRG. NO.:-	-	SHEET NO. 11 / 27	REV.NO. AS BUILT

FILTER FEED PUMP-P1 & P2

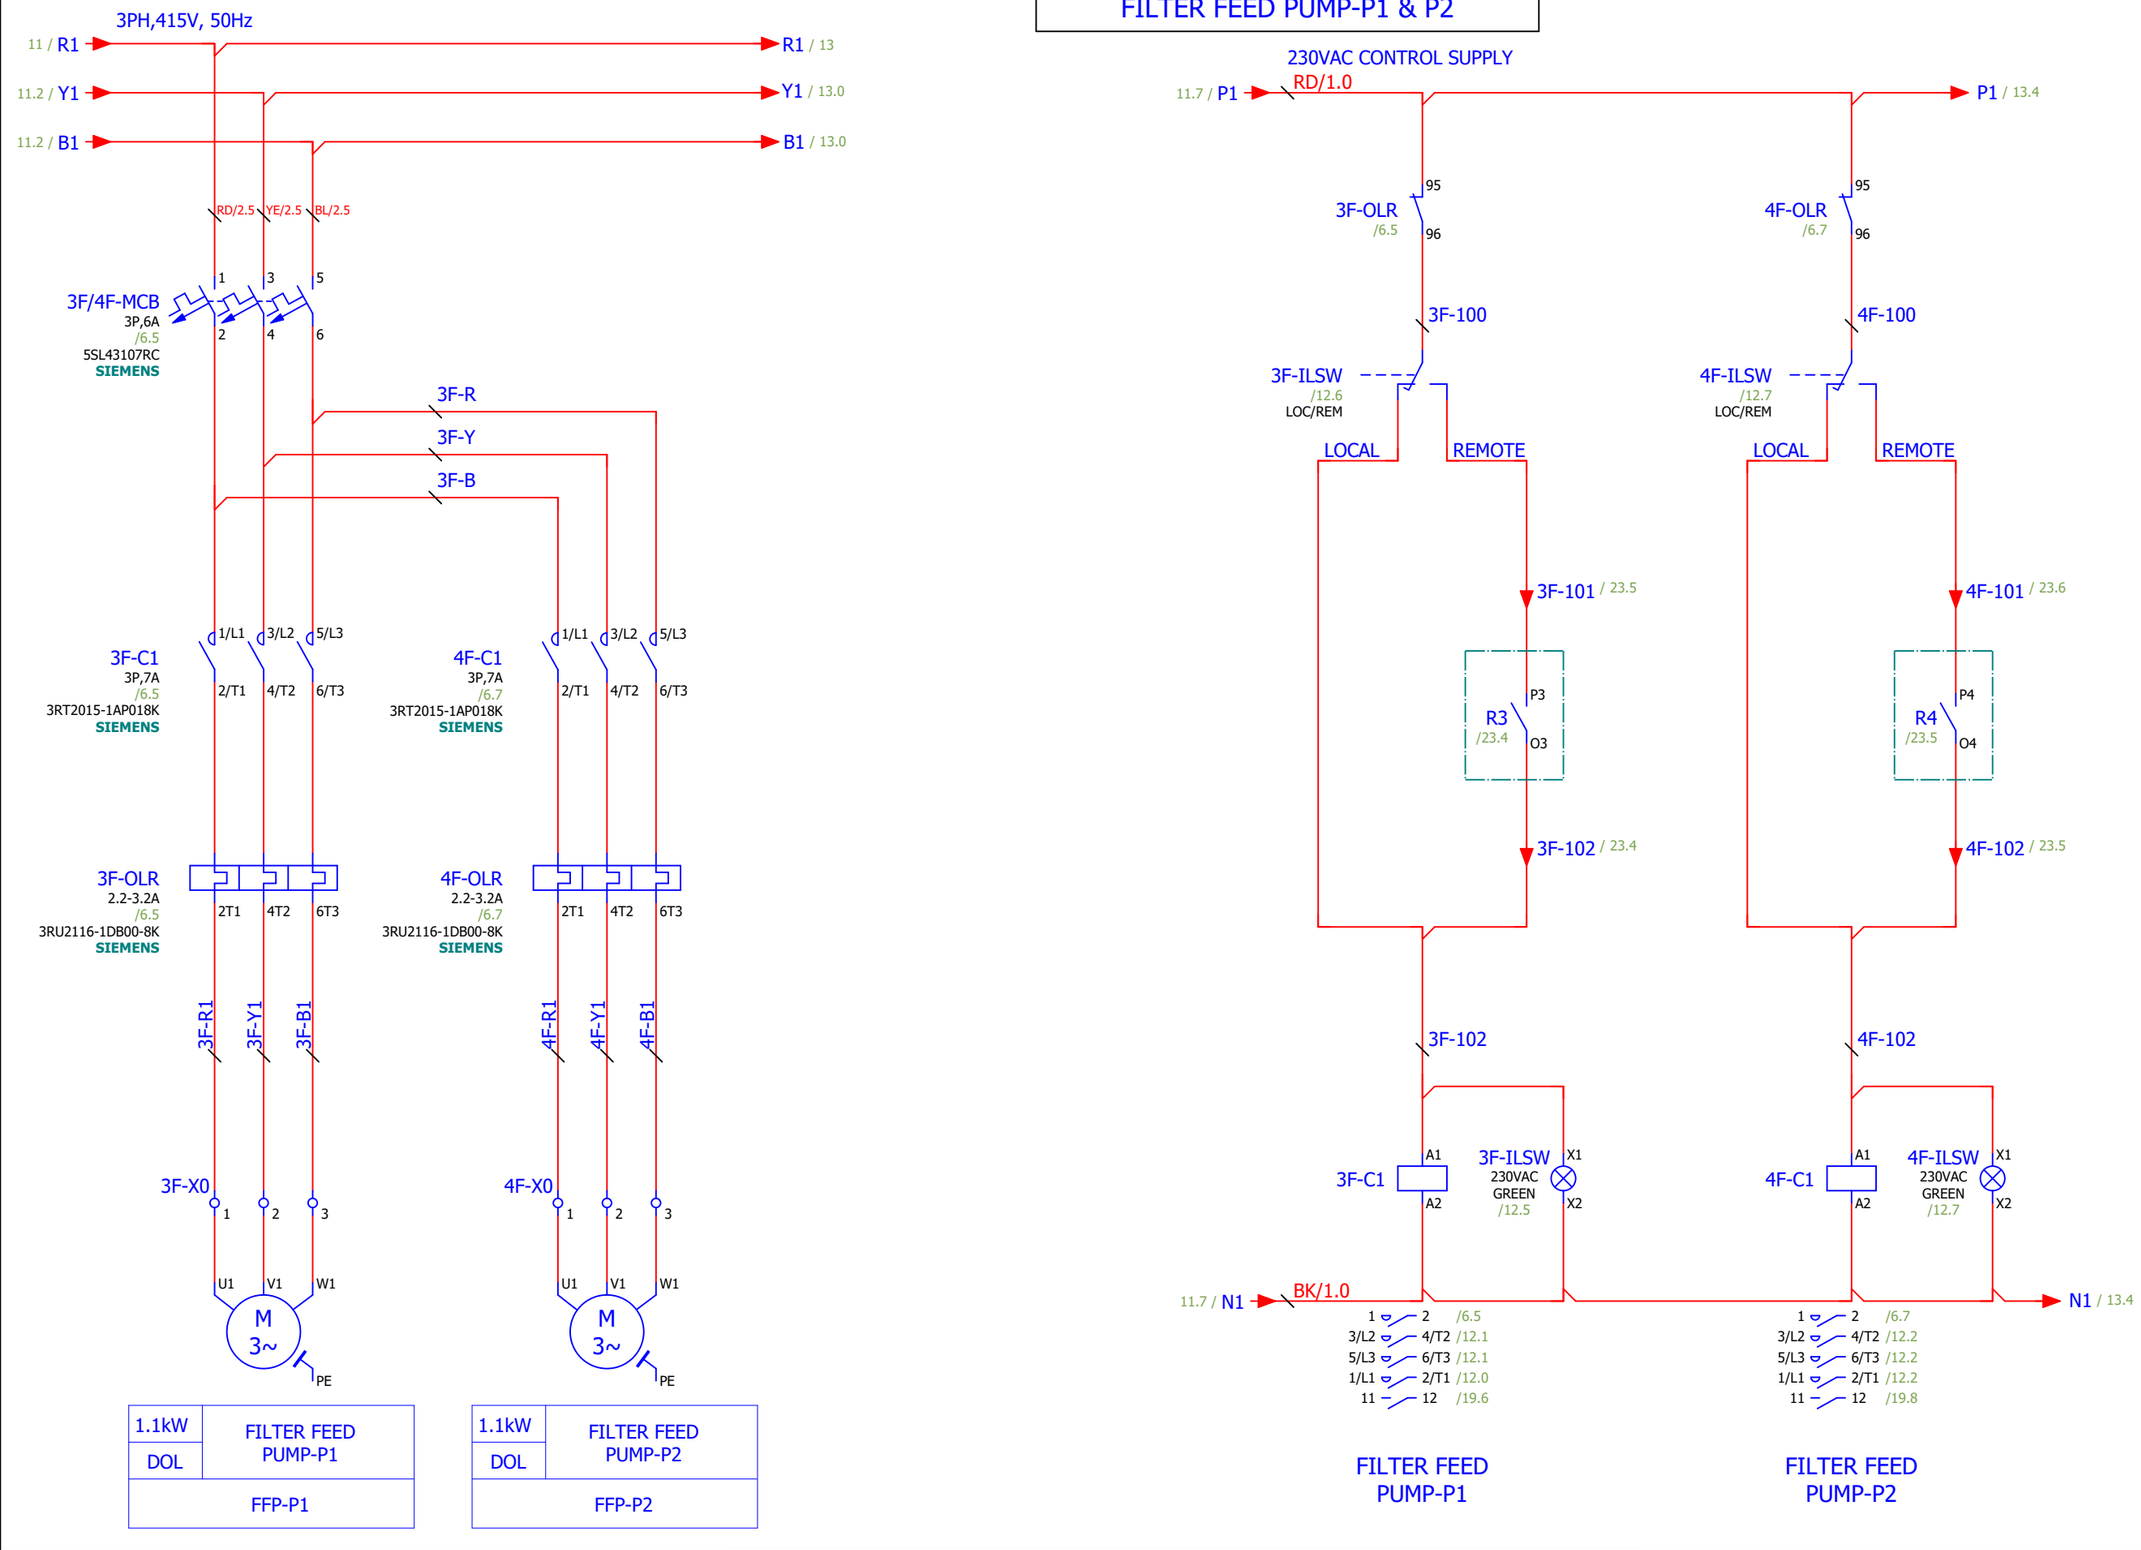

AQUACARESEE PVT. LTD.

OFFICE NO.204, 205 AND 206
VINAYAK ARCADE, 2ND FLOOR
OPP. BAJAJ AUTO, AKURDI,PUNE-411035
www.aquacaresee.co.in
MOB:-9049560684

REVISION	DETAILS	DATE		
03	AS BUILT	24-11-2025		
02	AS PER COMMENTS	01-10-2025		
01	AS PER COMMENTS	29-09-2025	DRAWN BY	N.A.
00	FOR APPROVAL	27-09-2025	CHECKED	V.S.K.
			APPROVED	P.S.B.

TITLE:- FILTER FEED PUMP-P1&P2 POWER & CONTROL WIRING

SYSTEM:- EFFLUENT TREATMENT PLANT-10 KLD


PROJECT:- POWER CUM PLC PANEL FOR ETP PLANT

DRG. NO.:- -

SHEET NO. 12 / 27

REV.NO. AS BUILT

SLUDGE WITHDRAW PUMP

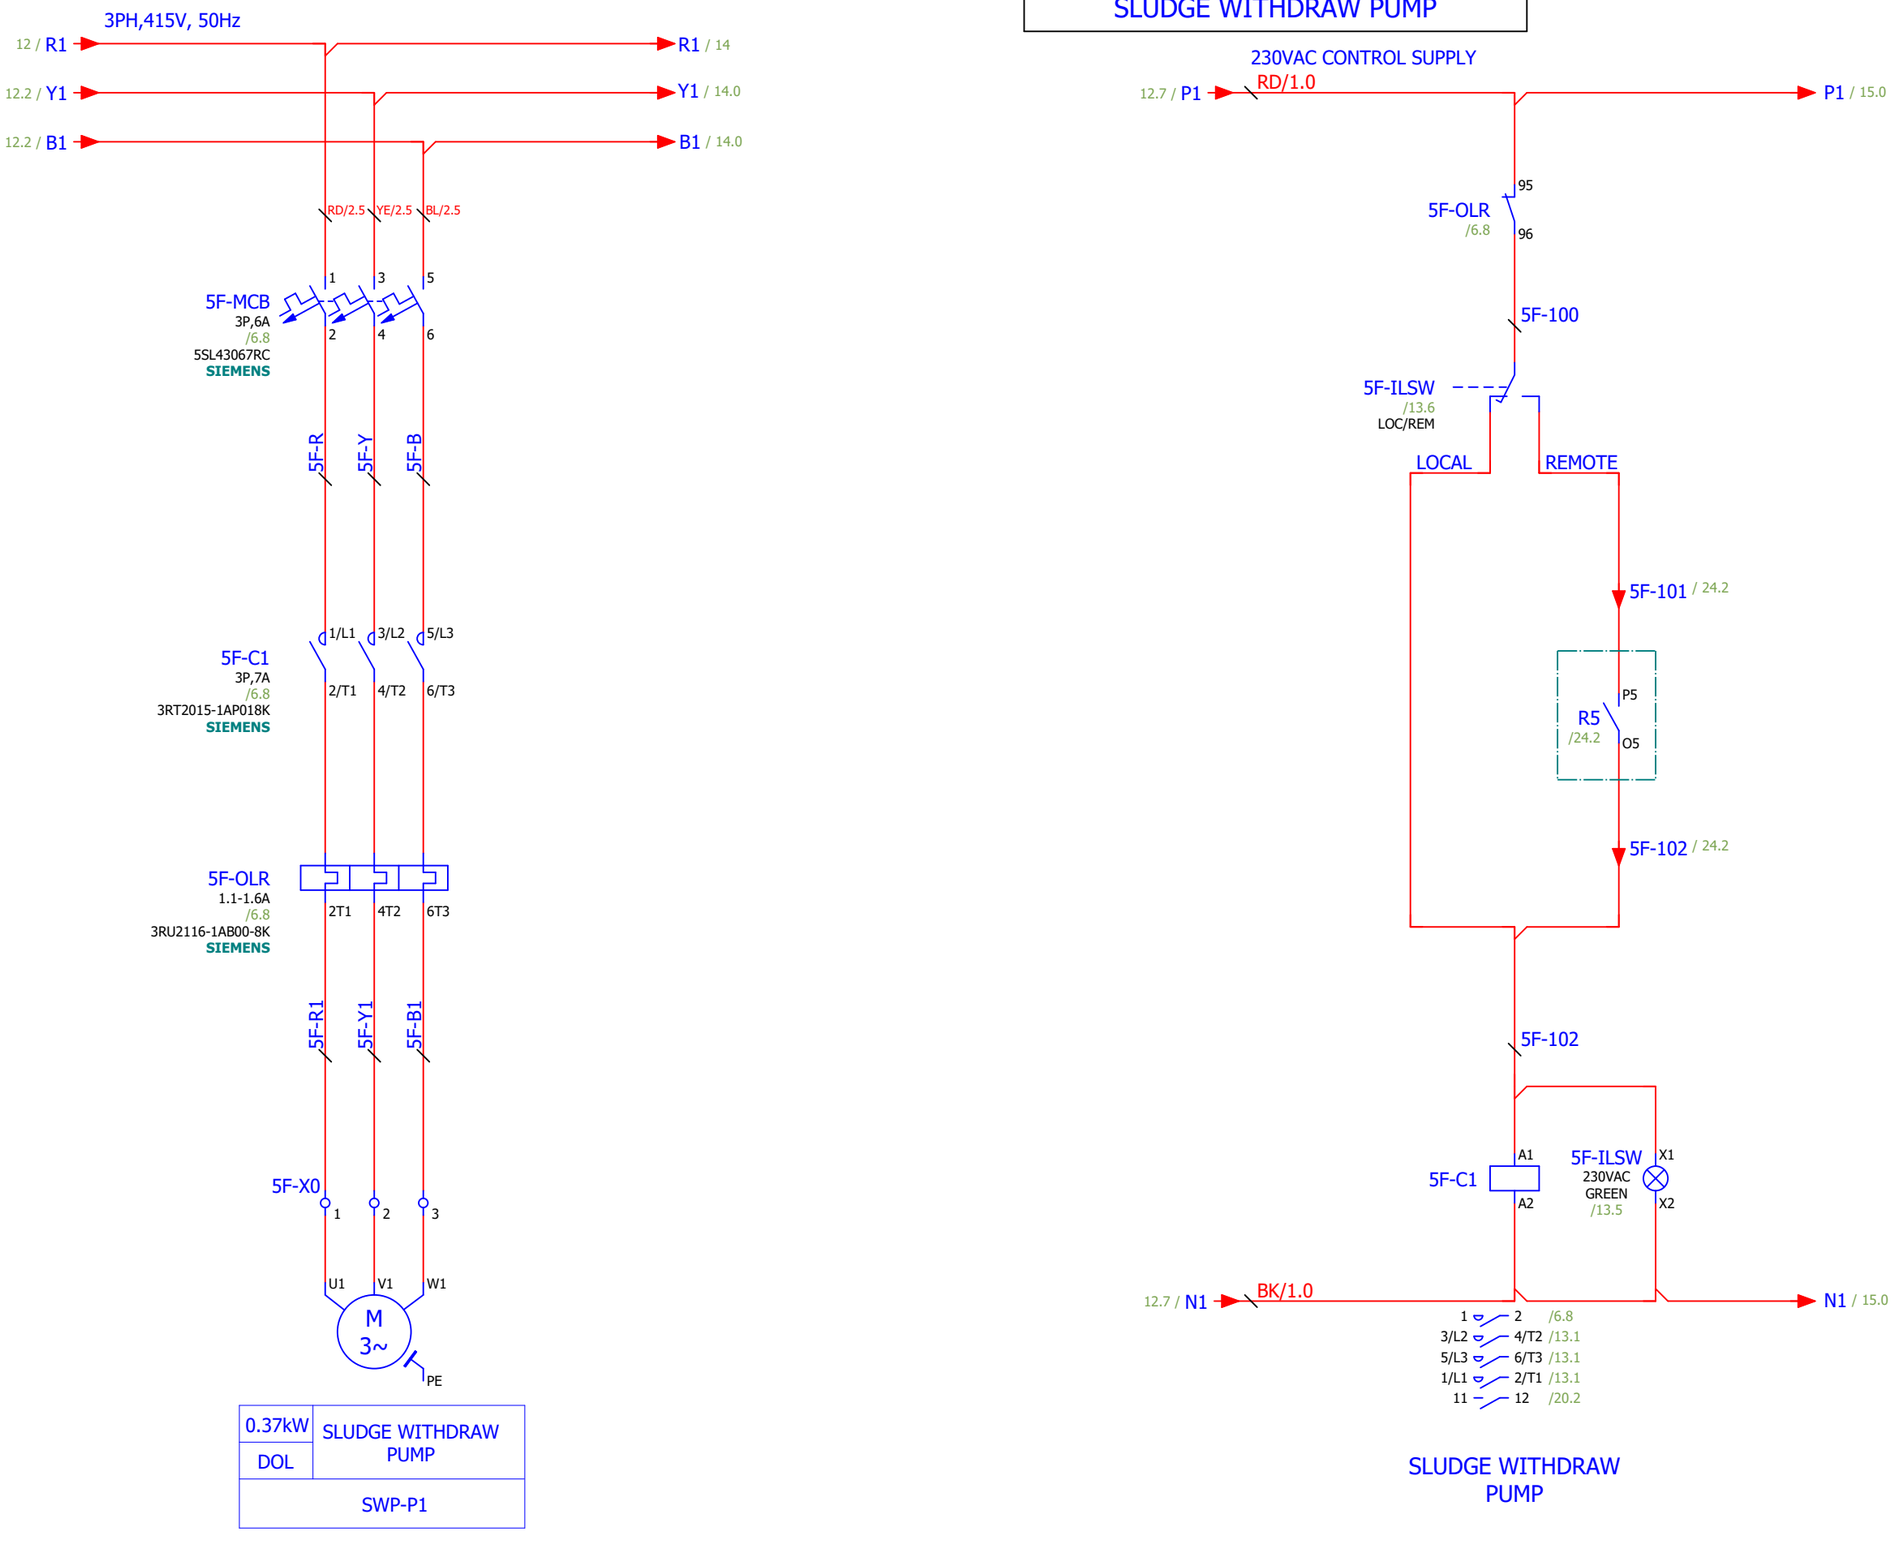

0.37kW	SLUDGE WITHDRAW PUMP
DOL	
SWP-P1	

SLUDGE WITHDRAW PUMP

AQUACARESEE PVT. LTD.
OFFICE NO.204, 205 AND 206
VINAYAK ARCADE, 2ND FLOOR
OPP. BAJAJ AUTO, AKURDI,PUNE-411035
www.aquacaresee.co.in
MOB:-9049560684

REVISION	DETAILS	DATE	APPROVED	P.S.B.
03	AS BUILT	24-11-2025		
02	AS PER COMMENTS	01-10-2025		
01	AS PER COMMENTS	29-09-2025	DRAWN BY	N.A.
00	FOR APPROVAL	27-09-2025	CHECKED	V.S.K.

TITLE:- SLUDGE WITHDRAW PUMP POWER & CONTROL WIRING

SYSTEM:- EFFLUENT TREATMENT PLANT-10 KLD


PROJECT:- POWER CUM PLC PANEL FOR ETP PLANT

DRG. NO.:- -

SHEET NO. 13 / 27

REV.NO. AS BUILT

AIR BLOWER - B1 & B2

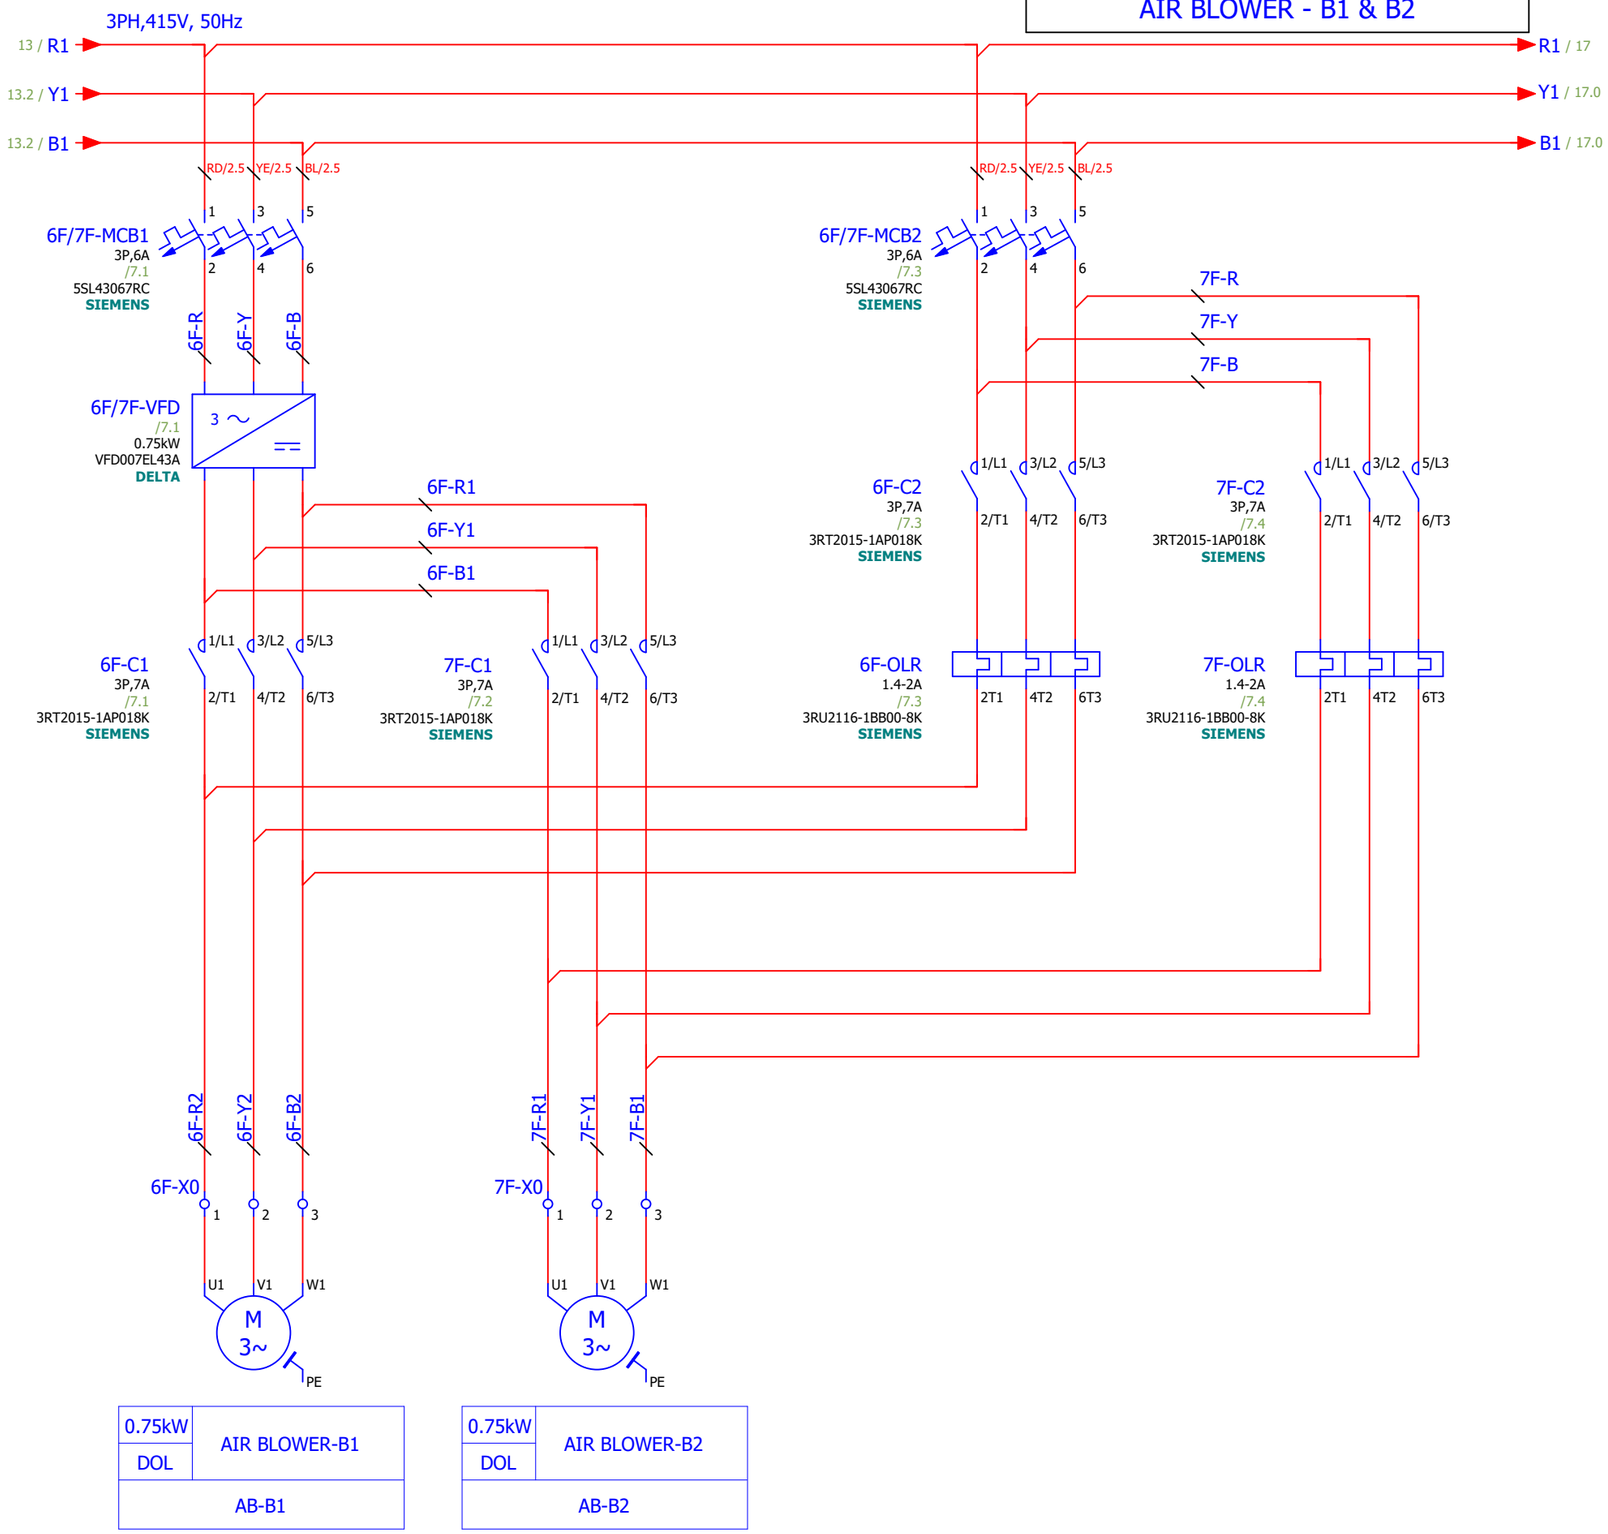

0.75kW	AIR BLOWER-B1
DOL	
AB-B1	

0.75kW	AIR BLOWER-B2
DOL	
AB-B2	

AQUACARESEE PVT. LTD.

OFFICE NO.204, 205 AND 206
VINAYAK ARCADE, 2ND FLOOR
OPP. BAJAJ AUTO, AKURDI,PUNE-411035
www.aquacaresee.co.in
MOB:-9049560684

REVISION	DETAILS	DATE	APPROVED	P.S.B.
03	AS BUILT	24-11-2025		
02	AS PER COMMENTS	01-10-2025		
01	AS PER COMMENTS	29-09-2025	DRAWN BY	N.A.
00	FOR APPROVAL	27-09-2025	CHECKED	V.S.K.

TITLE:- AIR BLOWER - B1 & B2 POWER WIRING

SYSTEM:- EFFLUENT TREATMENT PLANT-10 KLD


PROJECT:- POWER CUM PLC PANEL FOR ETP PLANT

DRG. NO.:- -

SHEET NO. 14 / 27

REV.NO. AS BUILT

AIR BLOWER - B1 & B2

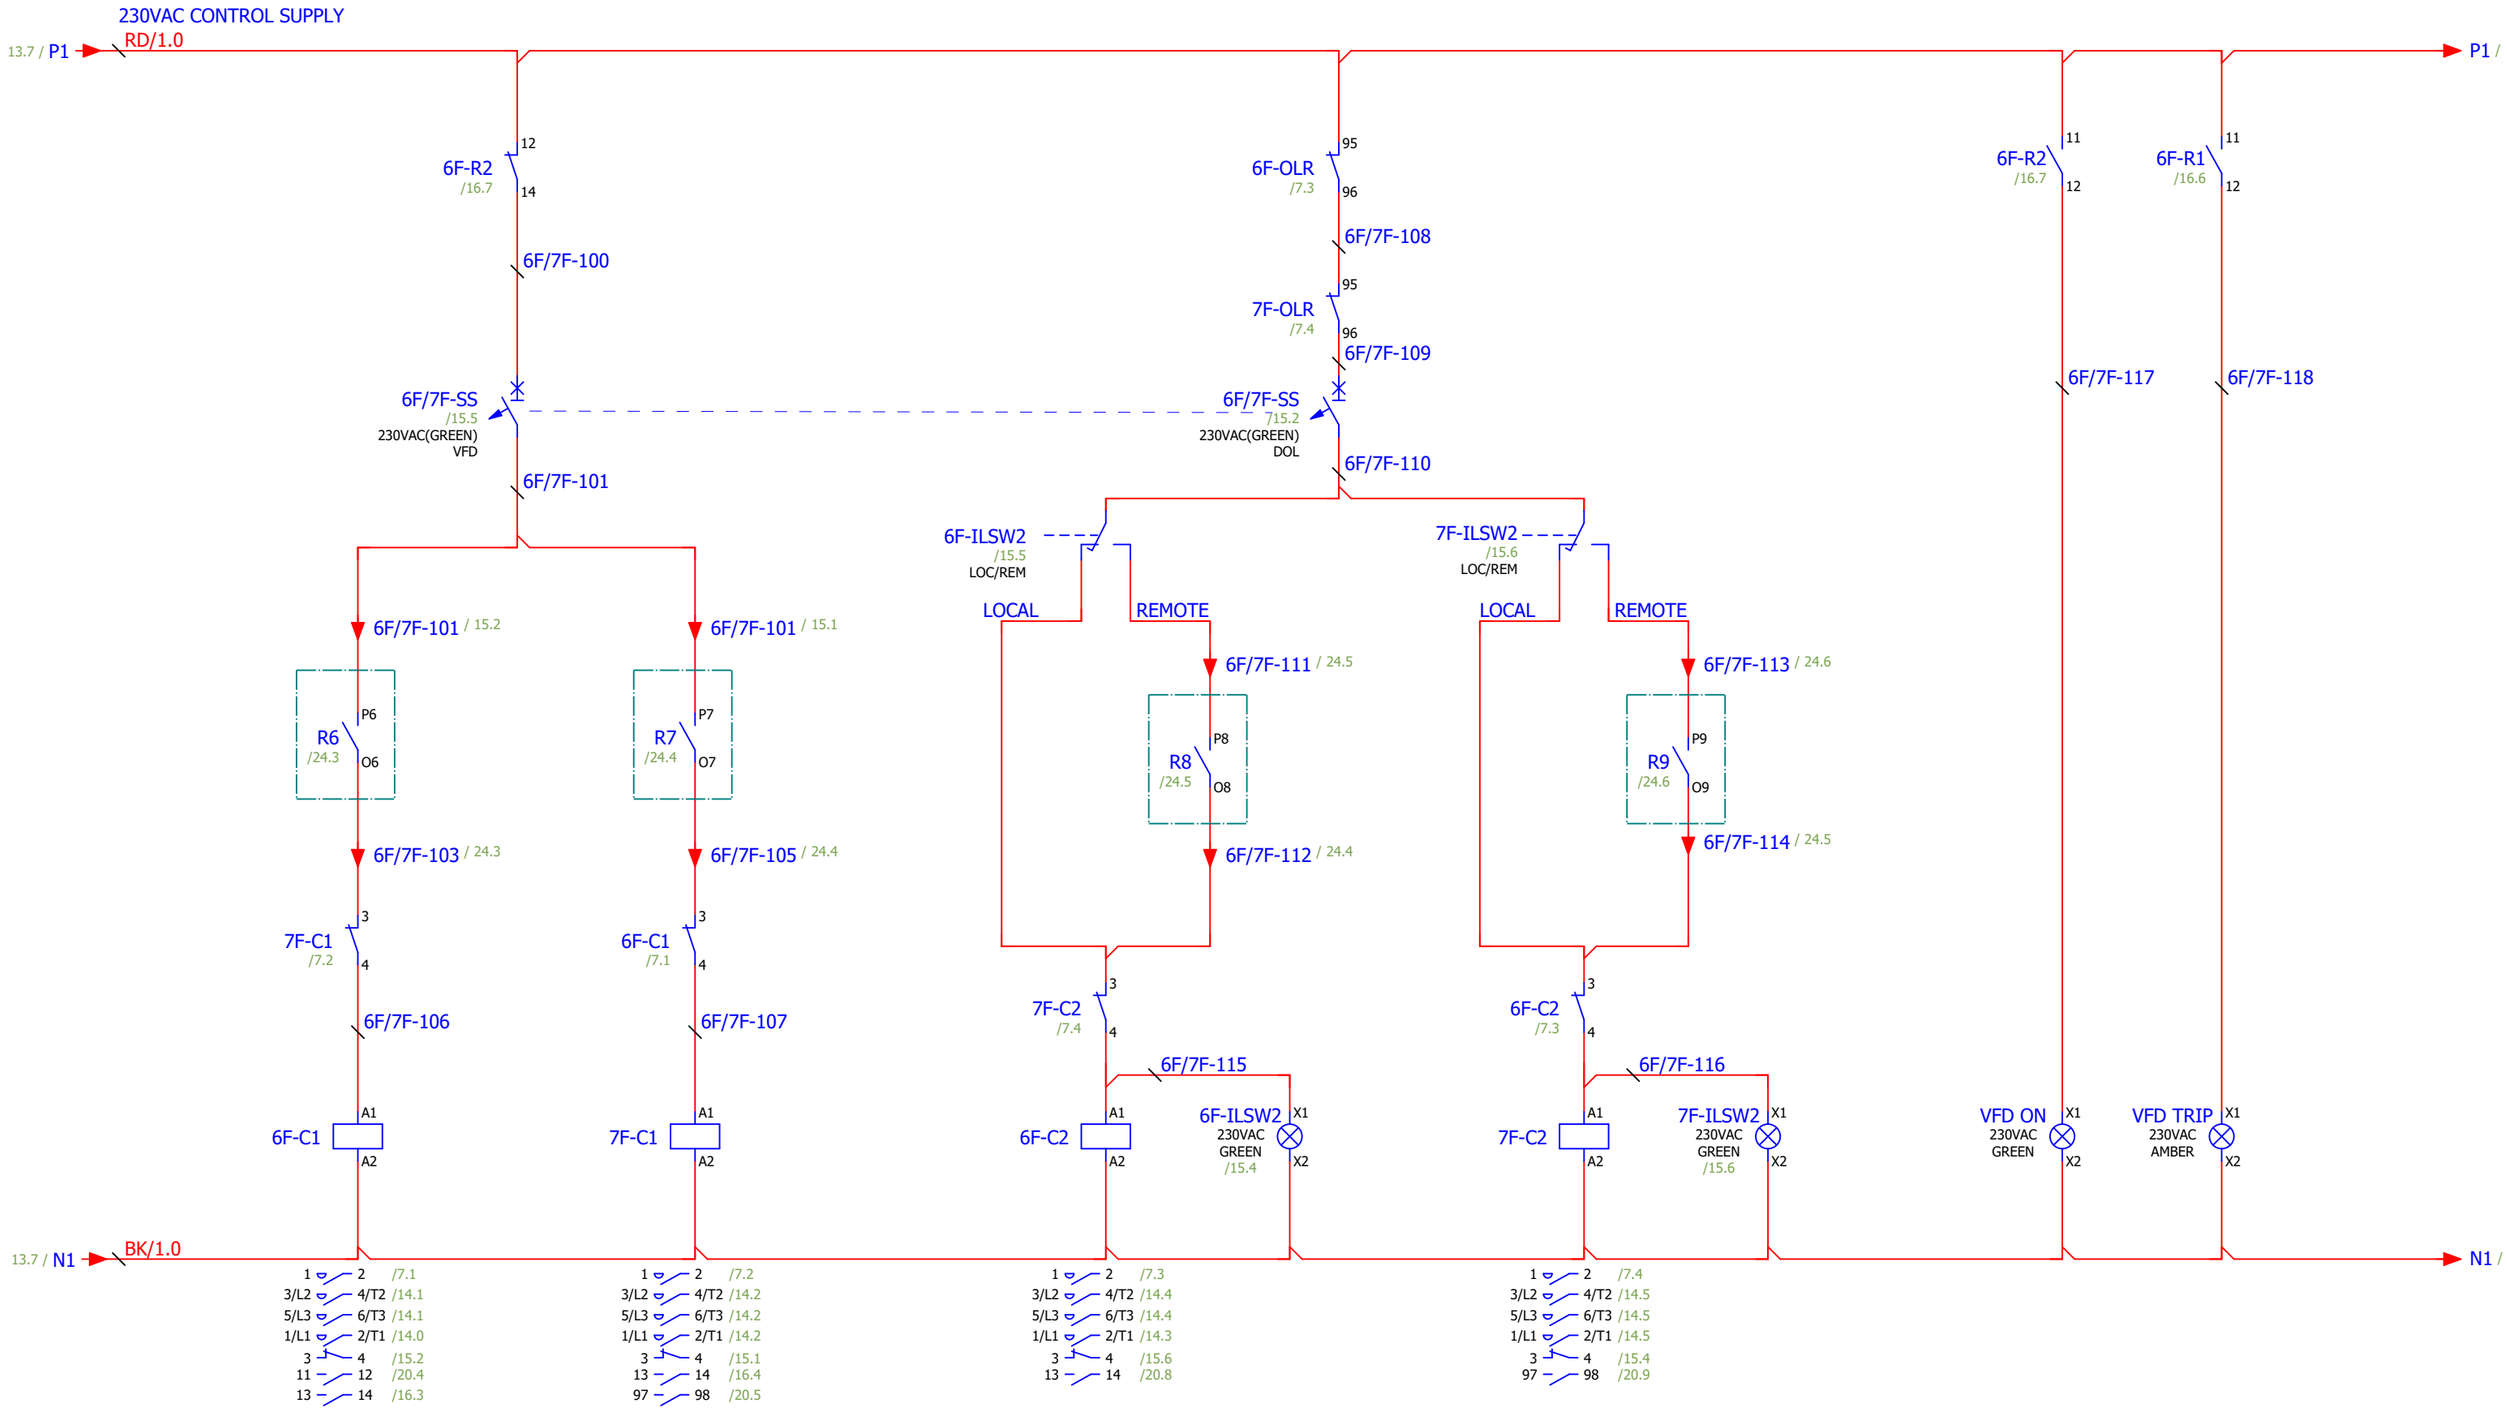


AQUACARESEE PVT. LTD.

OFFICE NO.204, 205 AND 206
VINAYAK ARCADE, 2ND FLOOR
OPP. BAJAJ AUTO, AKURDI,PUNE-411035
www.aquacaresee.co.in
MOB:-9049560684

REVISION	DETAILS	DATE		
03	AS BUILT	24-11-2025	TITLE:- AIR BLOWER - B1 & B2 CONTROL WIRING	
02	AS PER COMMENTS	01-10-2025		
01	AS PER COMMENTS	29-09-2025	DRAWN BY	N.A.
00	FOR APPROVAL	27-09-2025	CHECKED	V.S.K.
			APPROVED	P.S.B.


SYSTEM:-	EFFLUENT TREATMENT PLANT-10 KLD		
PROJECT:-	POWER CUM PLC PANEL FOR ETP PLANT		
DRG. NO.:-	-	SHEET NO. 15 / 27	REV.NO. AS BUILT

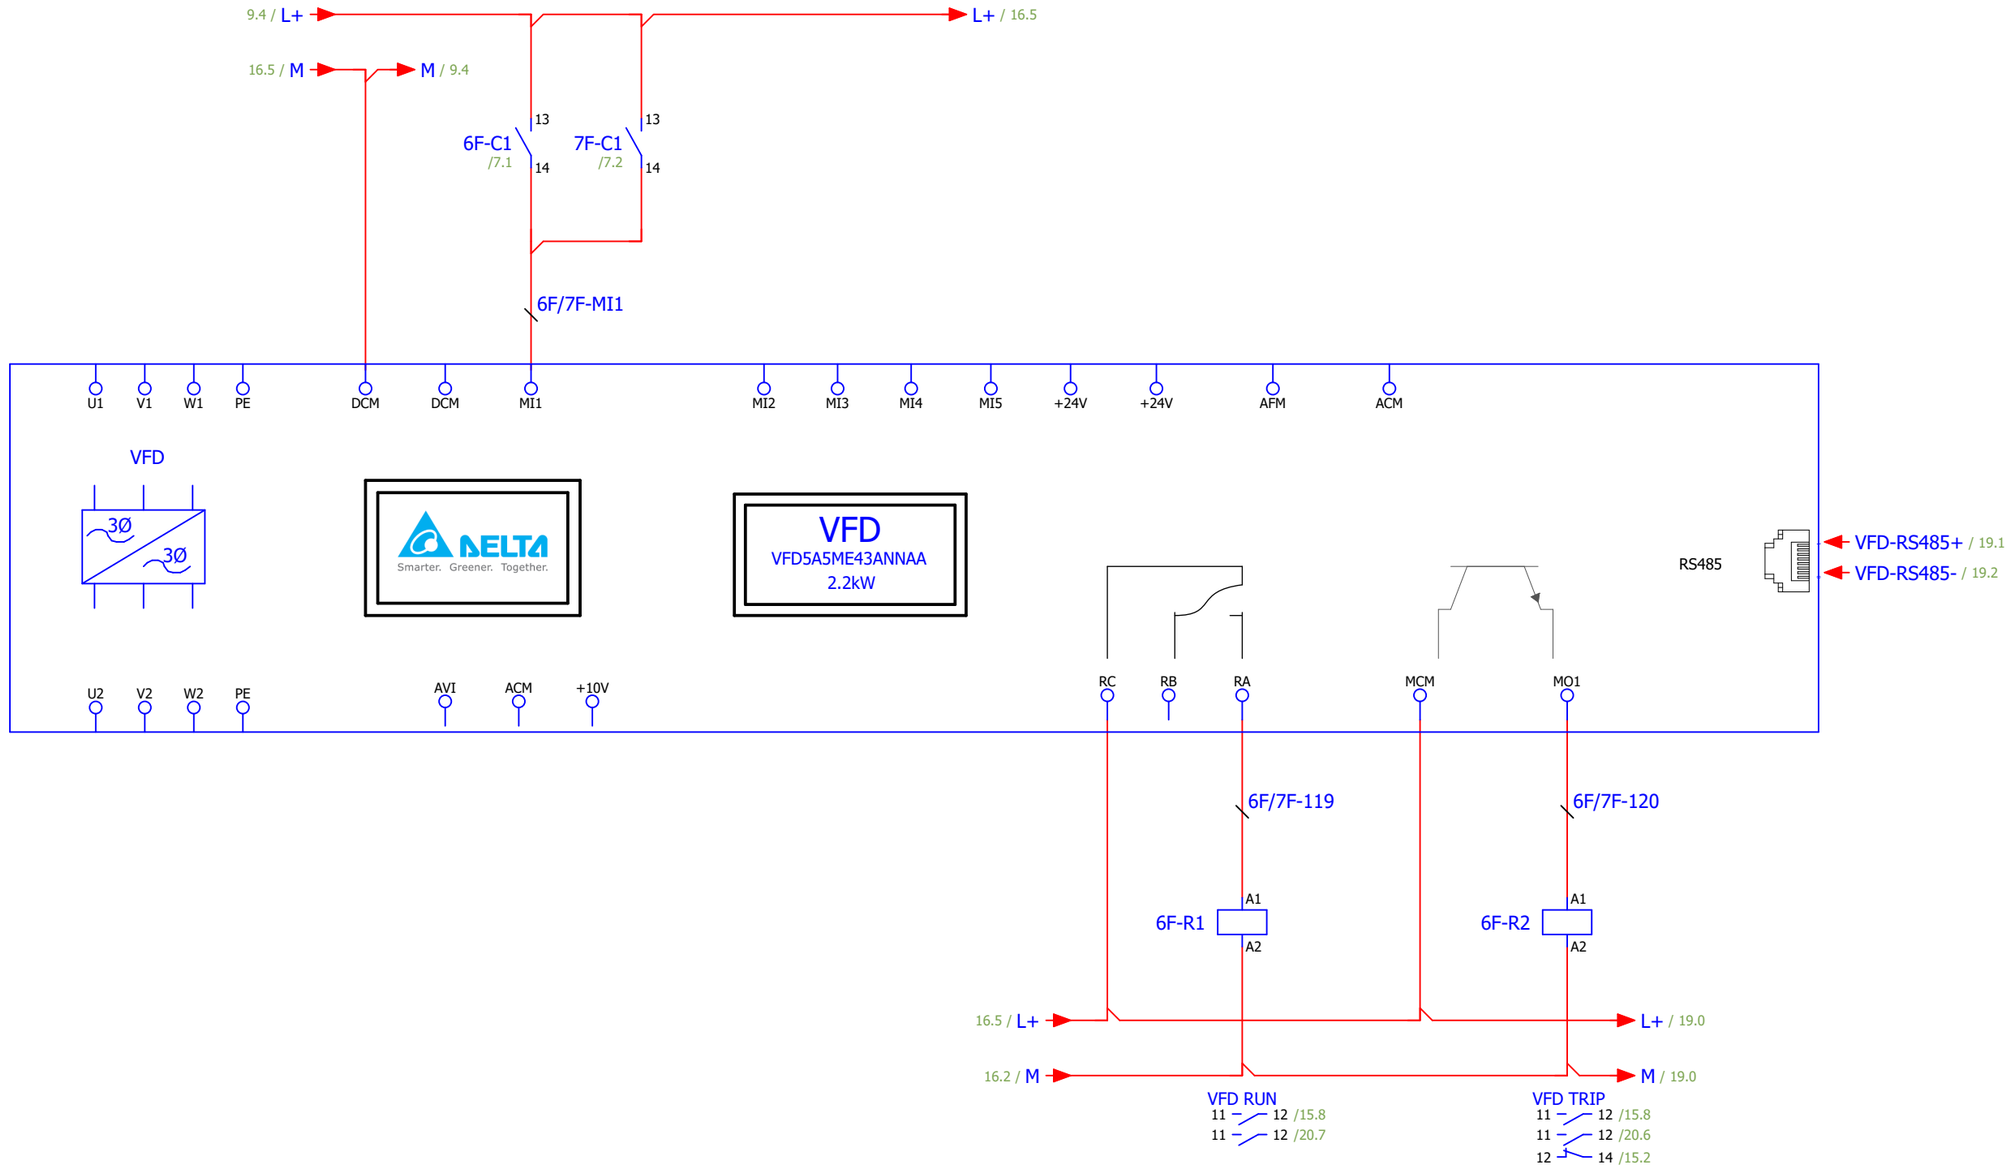

AQUACARESEE PVT. LTD.
OFFICE NO.204, 205 AND 206
VINAYAK ARCADE, 2ND FLOOR
OPP. BAJAJ AUTO, AKURDI,PUNE-411035
www.aquacaresee.co.in
MOB:-9049560684

REVISION	DETAILS	DATE		
03	AS BUILT	24-11-2025	TITLE:- AIR BLOWER - B1 & B2 VFD WIRING	
02	AS PER COMMENTS	01-10-2025		
01	AS PER COMMENTS	29-09-2025	DRAWN BY	N.A.
00	FOR APPROVAL	27-09-2025	CHECKED	V.S.K.
			APPROVED	P.S.B.

SYSTEM:-	EFFLUENT TREATMENT PLANT-10 KLD		
PROJECT:-	POWER CUM PLC PANEL FOR ETP PLANT		
DRG. NO.:-	-	SHEET NO. 16 / 27	REV.NO. AS BUILT

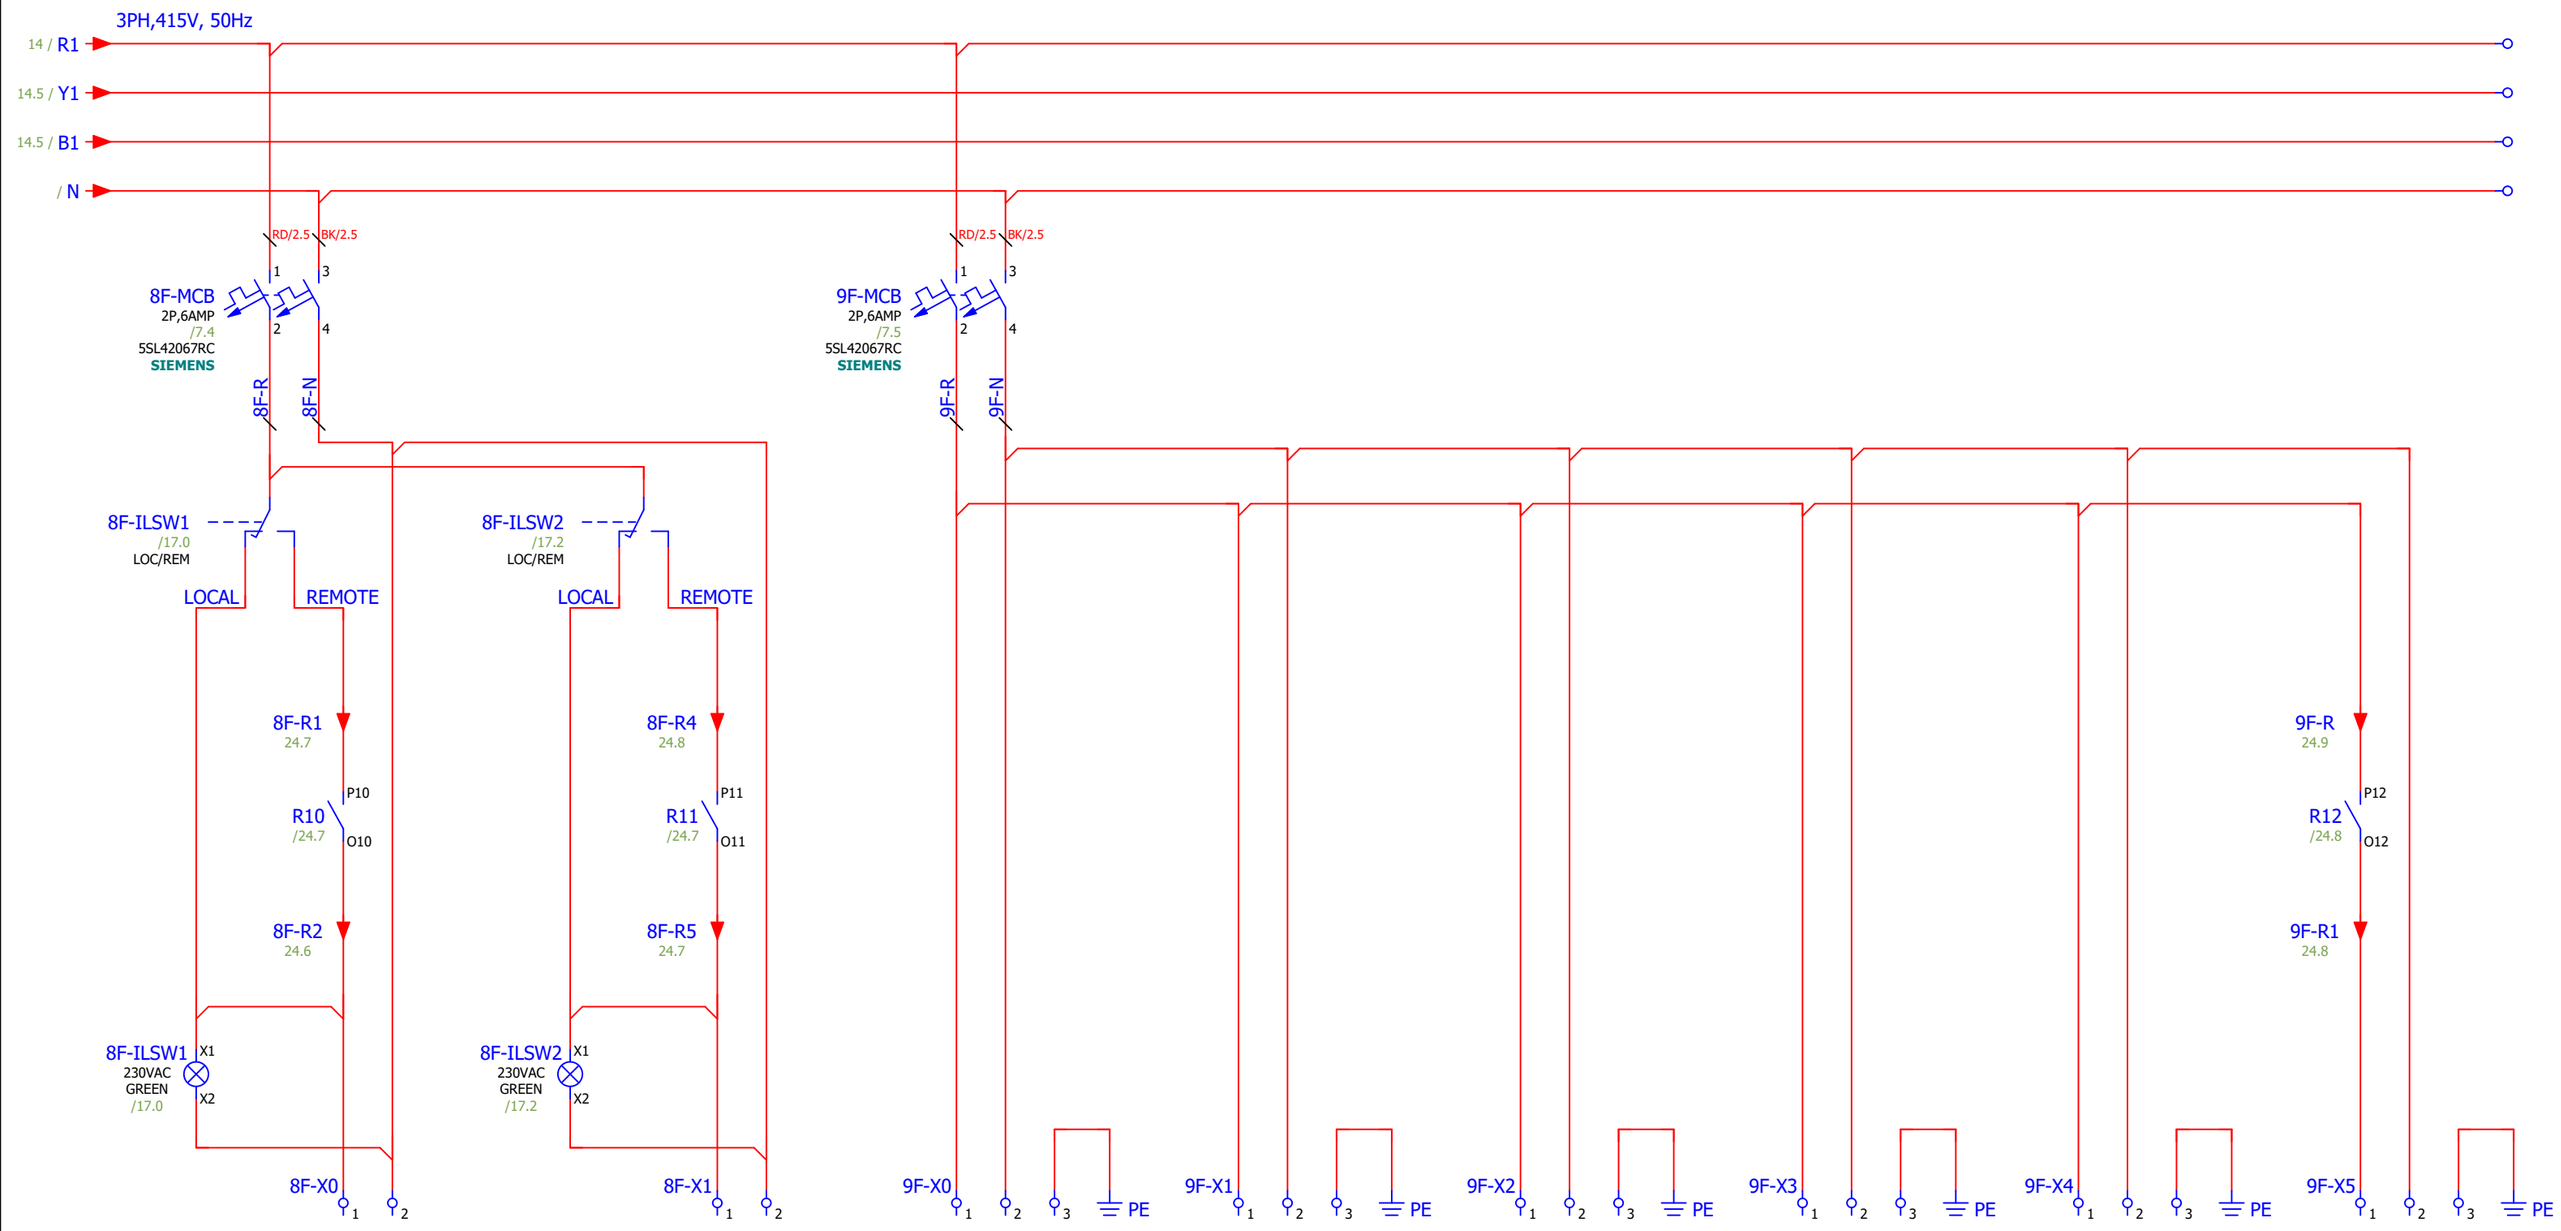

0.03kW	0.37kW	0.03kW	0.03kW	0.1kW	0.01kW	0.01kW	0.03kW
S/F	S/F	S/F	S/F	S/F	S/F	S/F	S/F
HYPO DOSING PUMP	AIR COMPRESSOR	MULTIPORT VALVE-1	MULTIPORT VALVE-2	MAGNETIC FLOW METER	DO METER	pH CONTROLLER	pH DOSING PUMP
HYP-P1	COM-C1	-	-	-	-	-	-

AQUACARESEE PVT. LTD.

OFFICE NO.204, 205 AND 206
VINAYAK ARCADE, 2ND FLOOR
OPP. BAJAJ AUTO, AKURDI,PUNE-411035
www.aquacaresee.co.in
MOB:-9049560684

REVISION	DETAILS	DATE		
03	AS BUILT	24-11-2025		
02	AS PER COMMENTS	01-10-2025		
01	AS PER COMMENTS	29-09-2025	DRAWN BY	N.A.
00	FOR APPROVAL	27-09-2025	CHECKED	V.S.K.
			APPROVED	P.S.B.

TITLE:- SUPPLY FEEDER POWER & CONTROL WIRING

SYSTEM:- EFFLUENT TREATMENT PLANT-10 KLD

PROJECT:- POWER CUM PLC PANEL FOR ETP PLANT

DRG. NO.:- -

SHEET NO. 17 / 27

REV.NO. AS BUILT

PLC WIRING DIAGRAM

AQUACARESEE PVT. LTD.
OFFICE NO.204, 205 AND 206
VINAYAK ARCADE, 2ND FLOOR
OPP. BAJAJ AUTO, AKURDI,PUNE-411035
www.aquacaresee.co.in
MOB:-9049560684


REVISION	DETAILS	DATE			
03	AS BUILT	24-11-2025	TITLE:- PLC WIRING DIAGRAM		
02	AS PER COMMENTS	01-10-2025			
01	AS PER COMMENTS	29-09-2025	DRAWN BY	N.A.	
00	FOR APPROVAL	27-09-2025	CHECKED	V.S.K.	
			APPROVED	P.S.B.	

SYSTEM:- EFFLUENT TREATMENT PLANT-10 KLD

PROJECT:- POWER CUM PLC PANEL FOR ETP PLANT

DRG. NO.:- -

REV.NO. AS BUILT

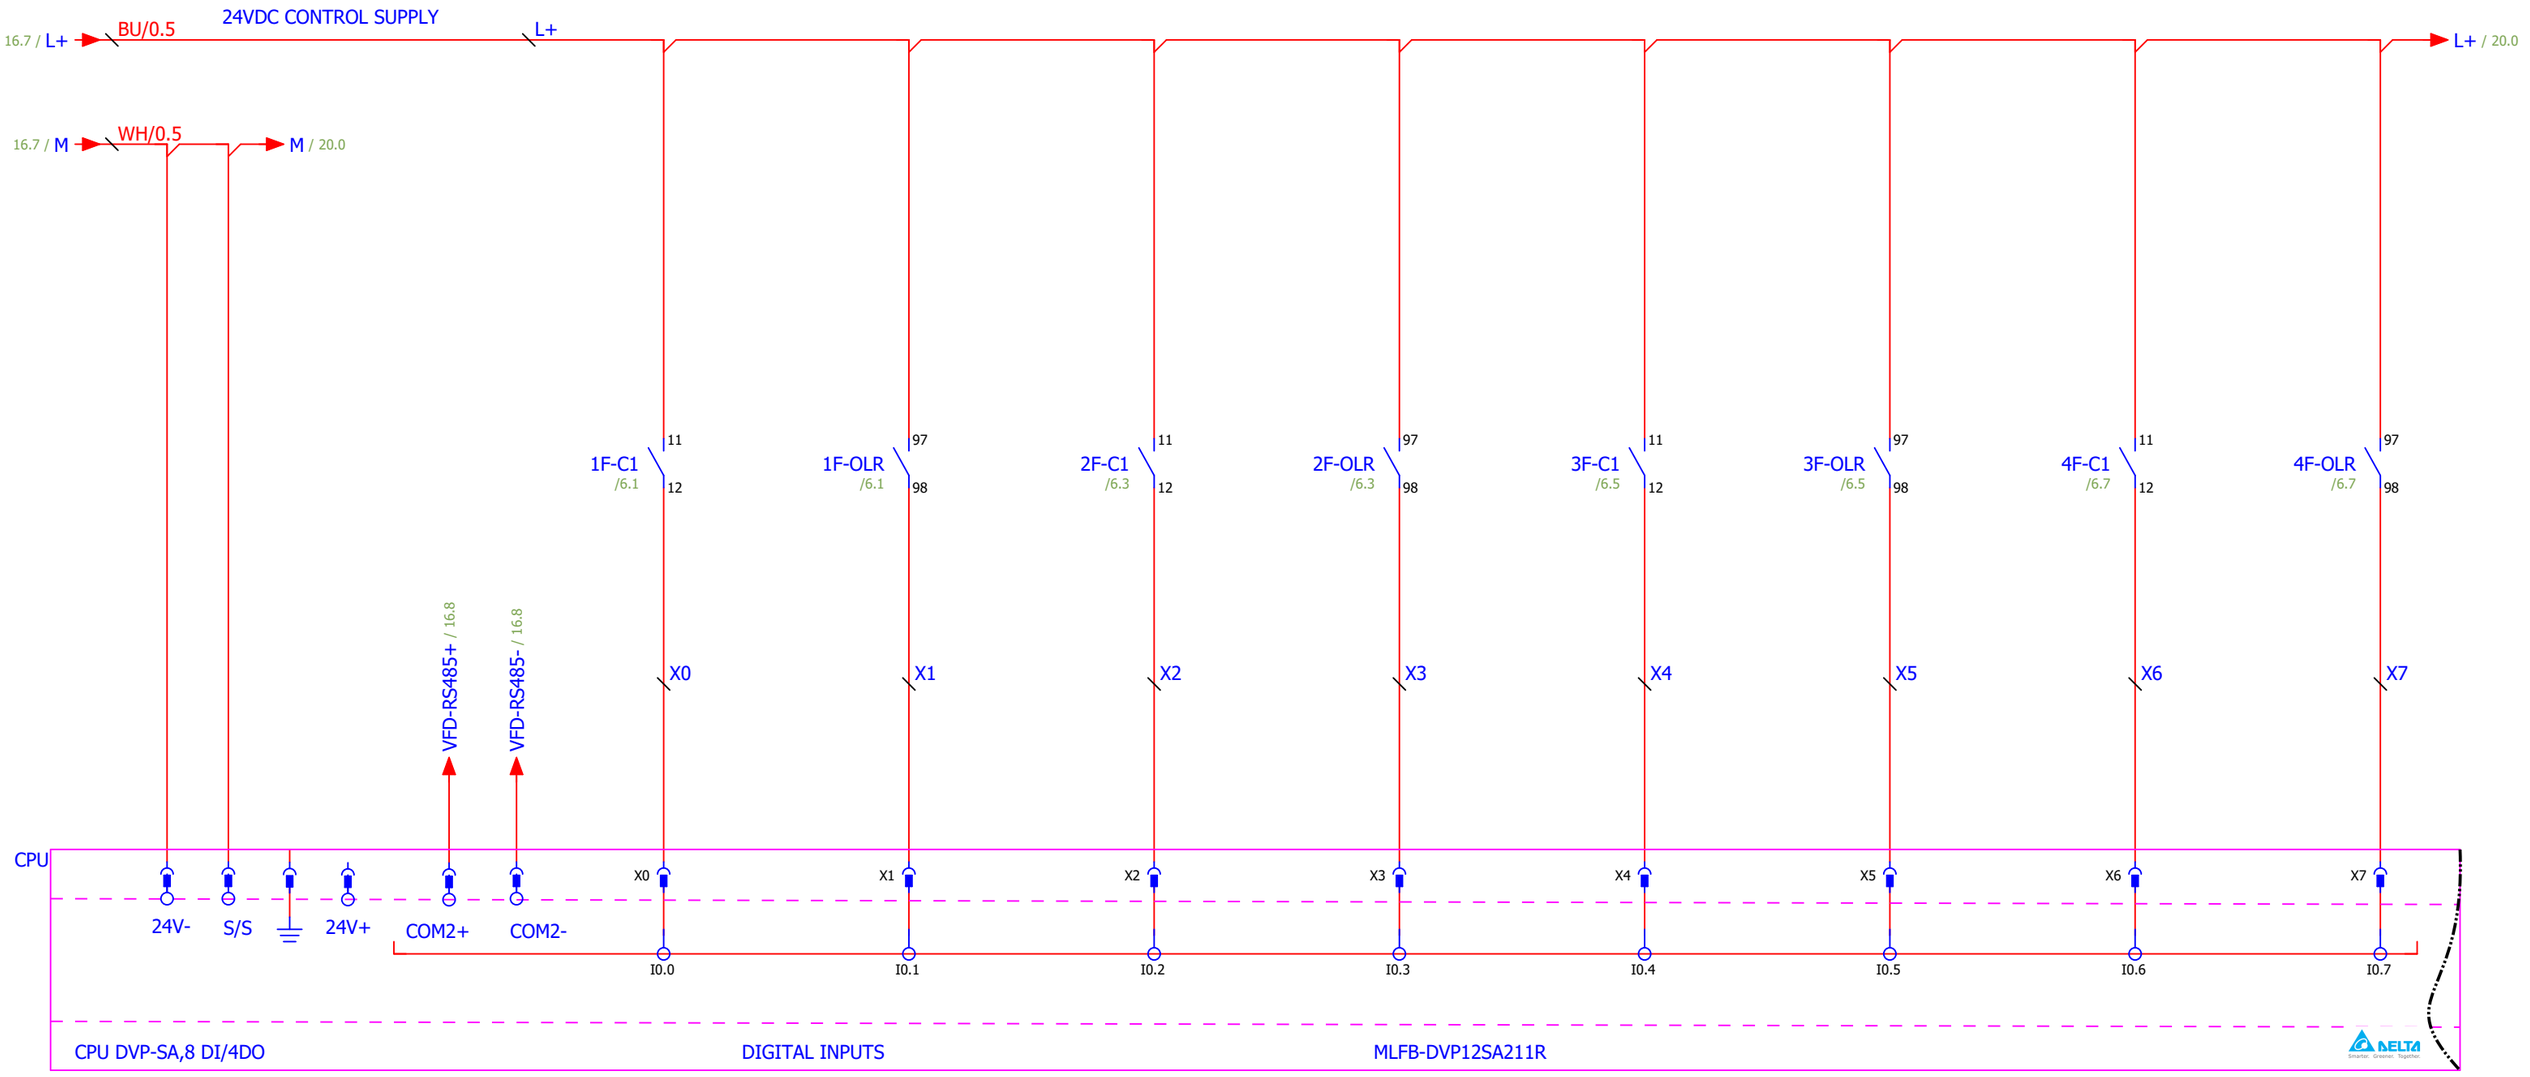

NOTE-TYPE OF TERMINALS USED

1 -NORMAL TERMINAL

2 -FUSED TERMINAL

AQUACARESEE PVT. LTD.

OFFICE NO.204, 205 AND 206
VINAYAK ARCADE, 2ND FLOOR
OPP. BAJAJ AUTO, AKURDI,PUNE-411035
www.aquacaresee.co.in
MOB:-9049560684

REVISION	DETAILS	DATE	APPROVED	P.S.B.
03	AS BUILT	24-11-2025		
02	AS PER COMMENTS	01-10-2025		
01	AS PER COMMENTS	29-09-2025	DRAWN BY	N.A.
00	FOR APPROVAL	27-09-2025	CHECKED	V.S.K.

TITLE:- CPU-DIGITAL INPUT WIRING


SYSTEM:- EFFLUENT TREATMENT PLANT-10 KLD

PROJECT:- POWER CUM PLC PANEL FOR ETP PLANT

DRG. NO.:- -

SHEET NO. 19 / 27

REV.NO. AS BUILT

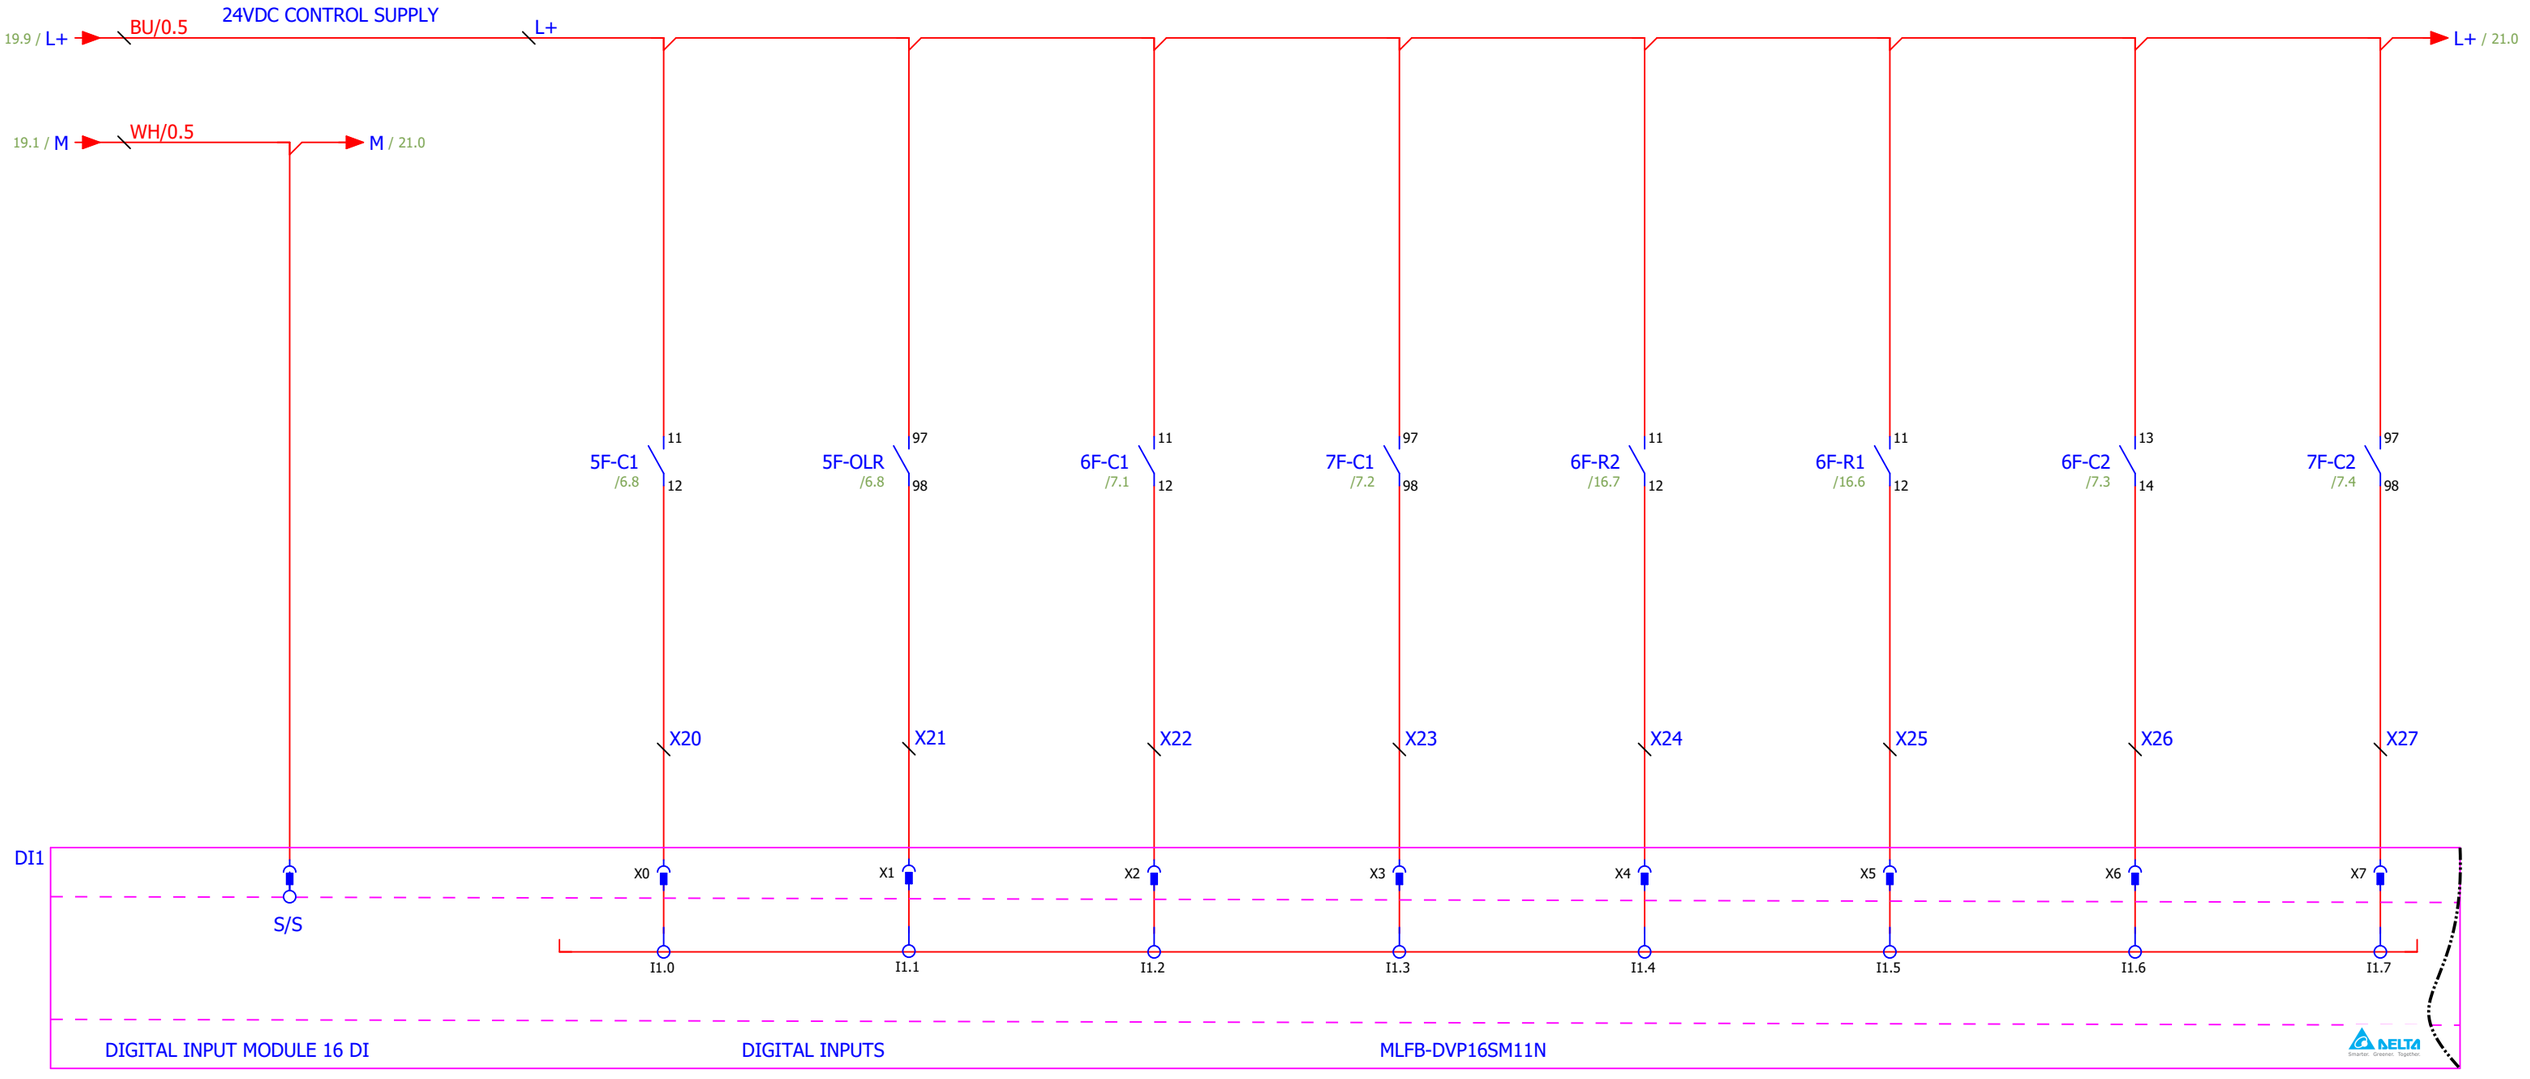

NOTE-TYPE OF TERMINALS USED

1 -NORMAL TERMINAL

2 -FUSED TERMINAL

AQUACARESEE PVT. LTD.

OFFICE NO.204, 205 AND 206
VINAYAK ARCADE, 2ND FLOOR
OPP. BAJAJ AUTO, AKURDI,PUNE-411035
www.aquacaresee.co.in
MOB:-9049560684

REVISION	DETAILS	DATE	APPROVED	P.S.B.
03	AS BUILT	24-11-2025		
02	AS PER COMMENTS	01-10-2025		
01	AS PER COMMENTS	29-09-2025	DRAWN BY	N.A.
00	FOR APPROVAL	27-09-2025	CHECKED	V.S.K.

TITLE:- DIGITAL INPUT MODULE-1 WIRING DIAGRAM


SYSTEM:- EFFLUENT TREATMENT PLANT-10 KLD

PROJECT:- POWER CUM PLC PANEL FOR ETP PLANT

DRG. NO.:- -

SHEET NO. 20 / 27

REV.NO. AS BUILT

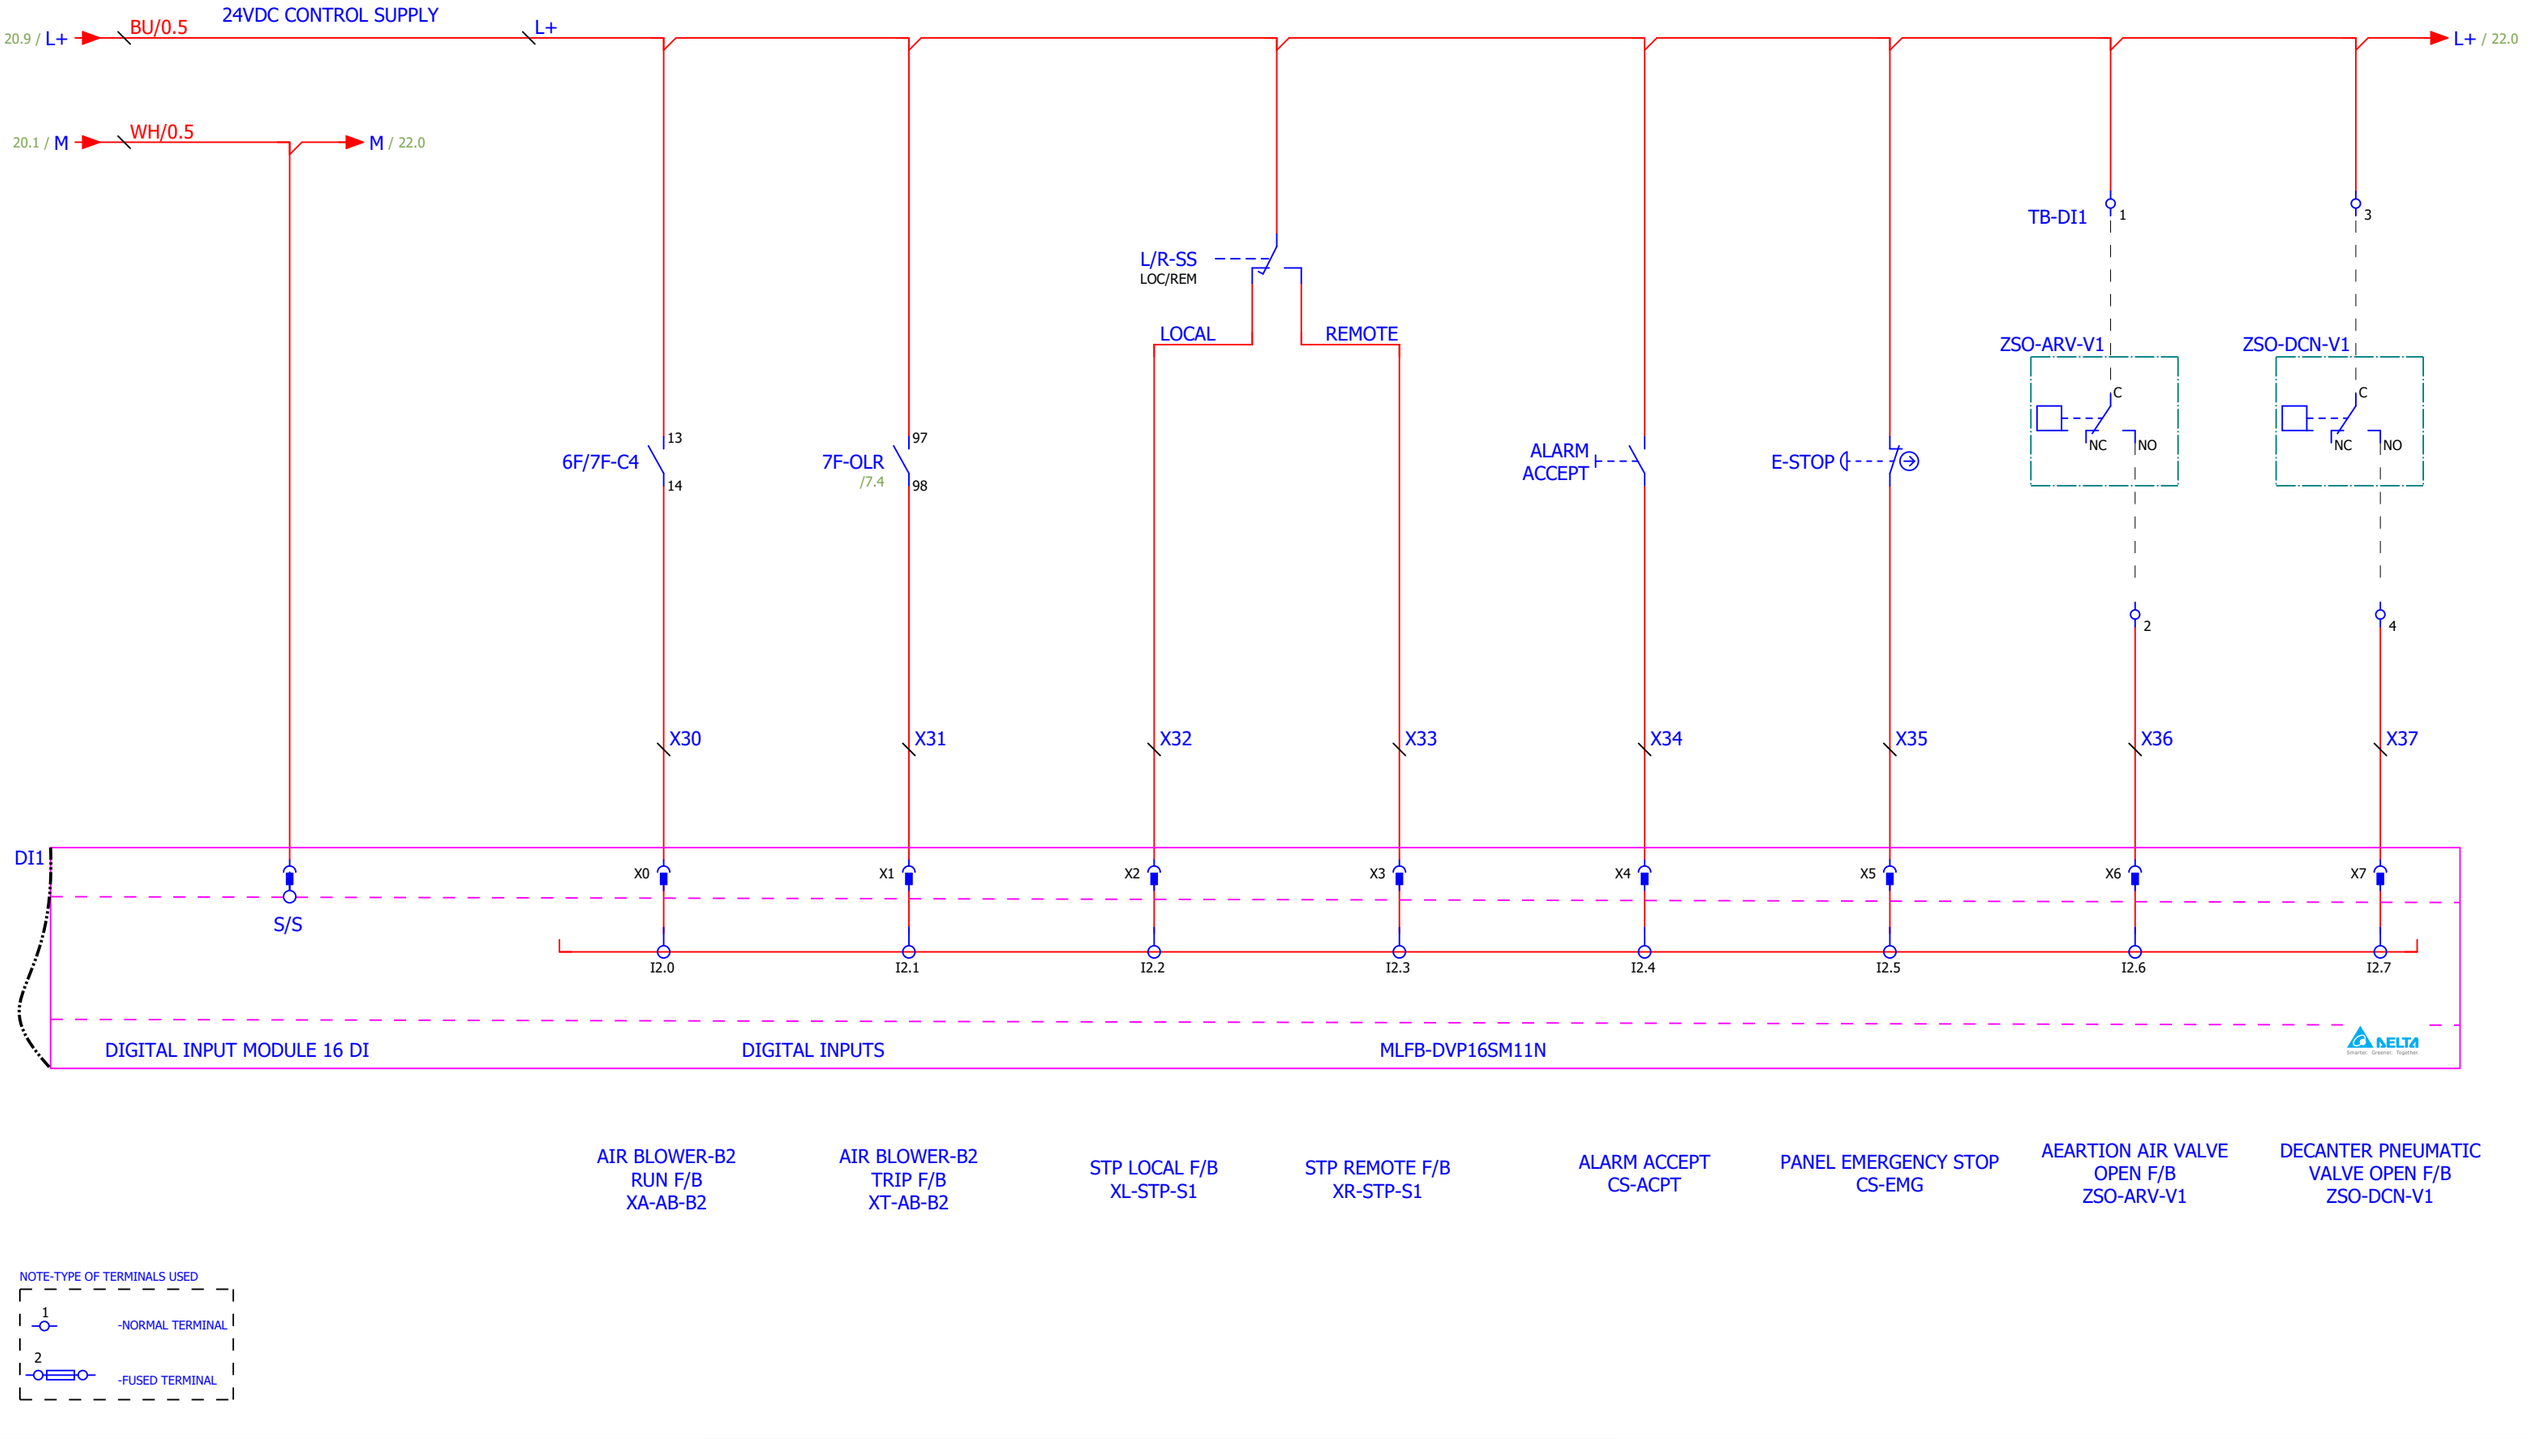

NOTE-TYPE OF TERMINALS USED

1 -NORMAL TERMINAL

2 -FUSED TERMINAL

AQUACARESEE PVT. LTD.

OFFICE NO.204, 205 AND 206
VINAYAK ARCADE, 2ND FLOOR
OPP. BAJAJ AUTO, AKURDI,PUNE-411035
www.aquacaresee.co.in
MOB:-9049560684

REVISION	DETAILS	DATE	APPROVED	P.S.B.
03	AS BUILT	24-11-2025		
02	AS PER COMMENTS	01-10-2025		
01	AS PER COMMENTS	29-09-2025	DRAWN BY	N.A.
00	FOR APPROVAL	27-09-2025	CHECKED	V.S.K.

TITLE:- DIGITAL INPUT MODULE-1 WIRING DIAGRAM


SYSTEM:- EFFLUENT TREATMENT PLANT-10 KLD

PROJECT:- POWER CUM PLC PANEL FOR ETP PLANT

DRG. NO.:- -


SHEET NO. 21 / 27

REV.NO. AS BUILT

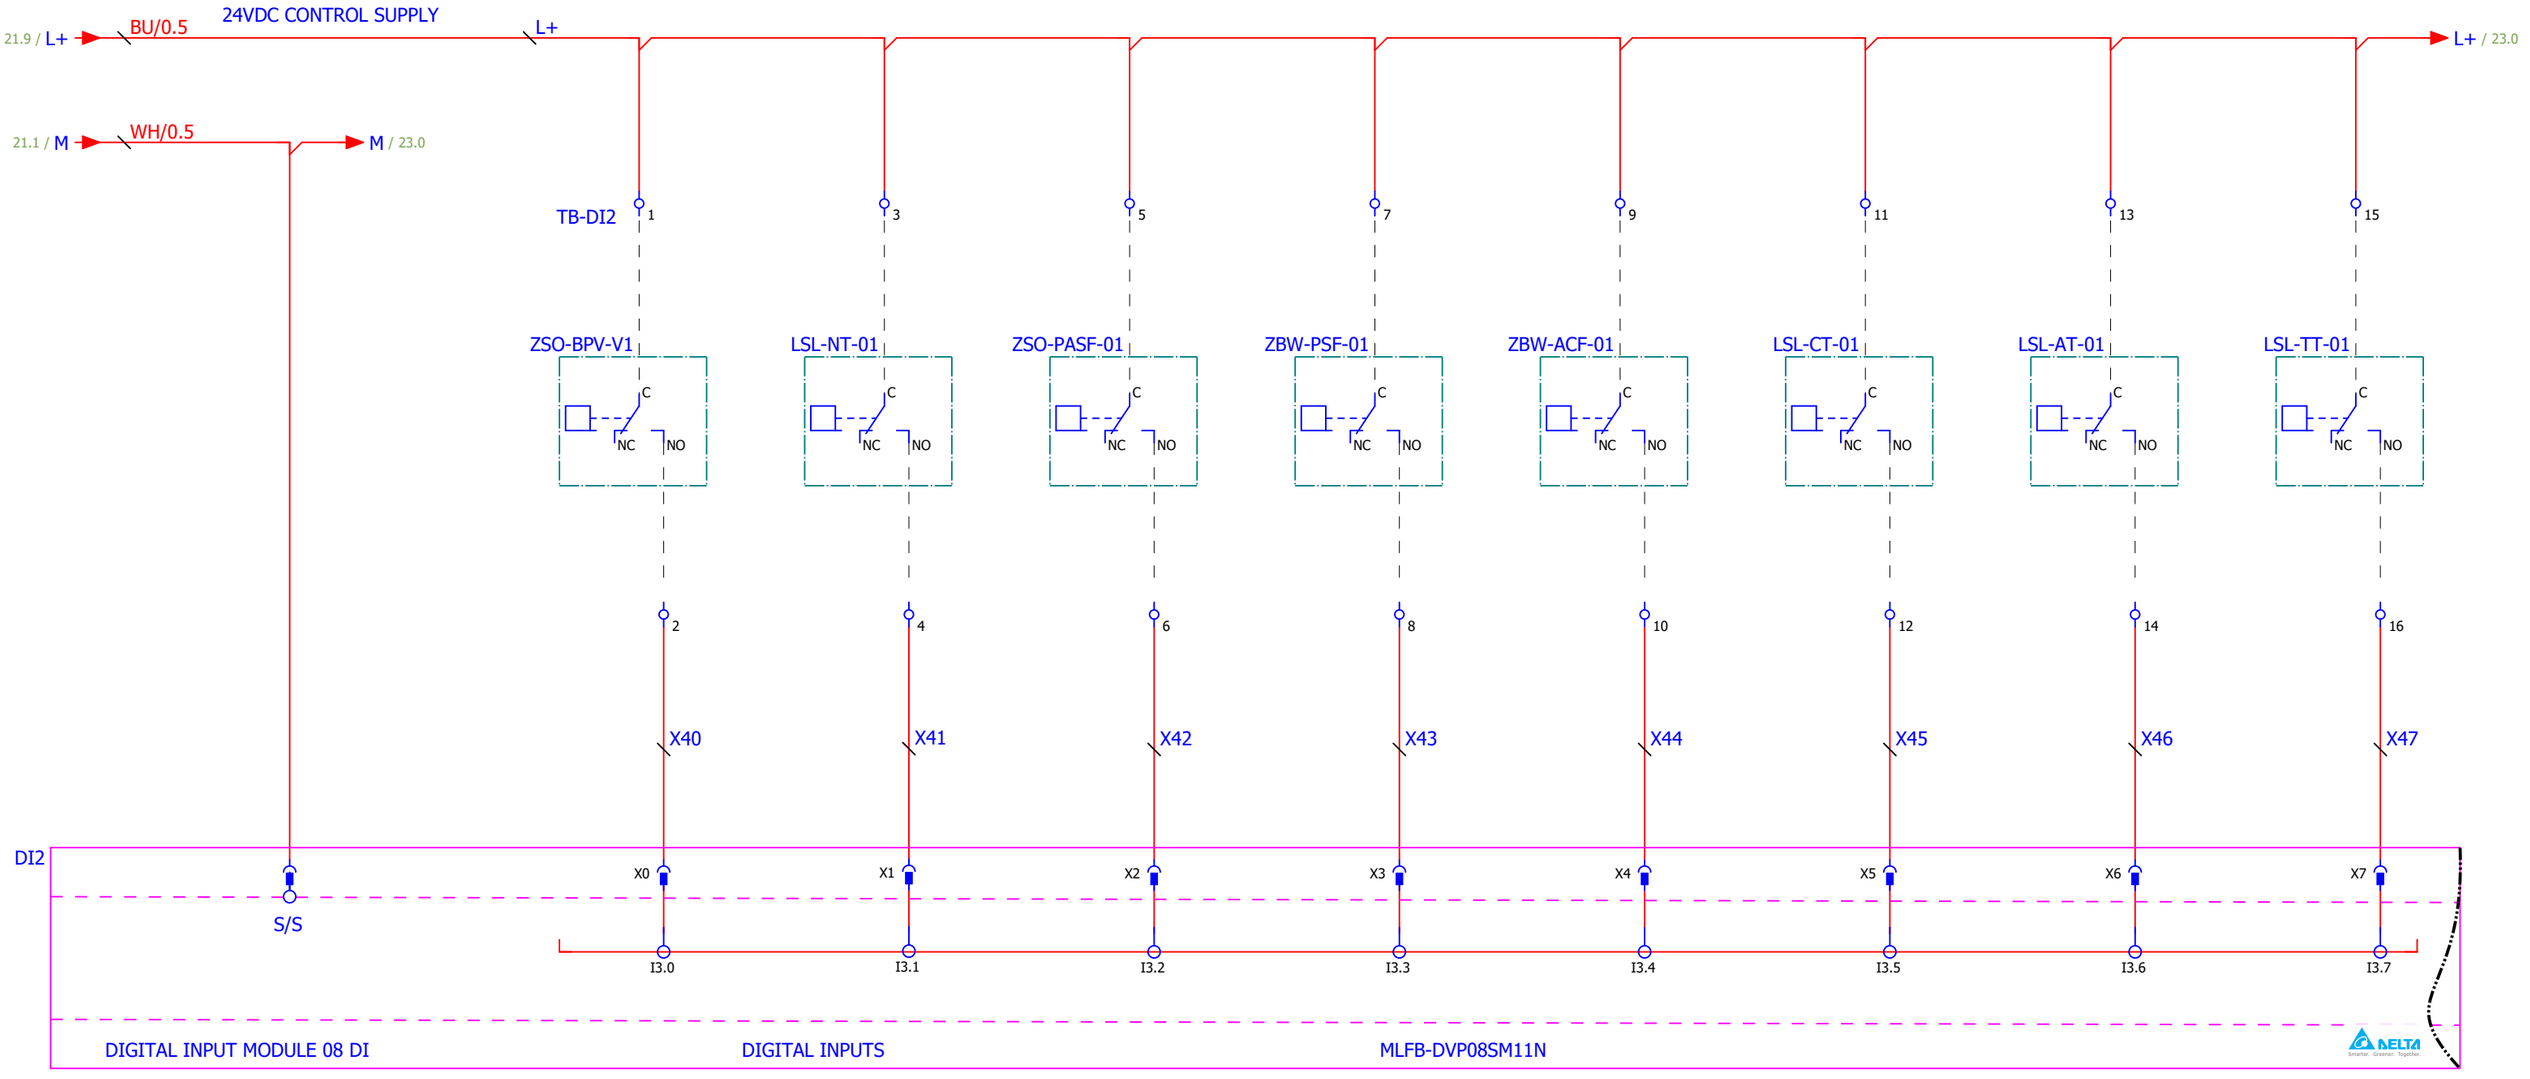

BACKPULSE VALVE OPEN F/B ZSO-BPV-V1	NEUTRALIZATION TANK LEVEL SWITCH LSL-NT-01	PSF MPV 1 & ACF MPV 2 SERVICE MODE F/B ZSO-PASF-01	PSF BACKWASH PRROGRESS ZBW-PSF-01
ACF BACKWASH PROGRESS ZBW-ACF-01	RAW EFFLUENT TANK LEVEL SWITCH LSL-CT-01	AERATION TANK LEVEL SWITCH LSL-AT-01	TREATED WATER TANK LEVEL SWITCH LSL-TT-01

NOTE-TYPE OF TERMINALS USED

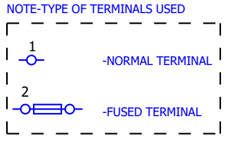

AQUACARESEE PVT. LTD.
OFFICE NO.204, 205 AND 206
VINAYAK ARCADE, 2ND FLOOR
OPP. BAJAJ AUTO, AKURDI,PUNE-411035
www.aquacaresee.co.in
MOB:-9049560684

REVISION	DETAILS	DATE	APPROVED	P.S.B.
03	AS BUILT	24-11-2025		
02	AS PER COMMENTS	01-10-2025		
01	AS PER COMMENTS	29-09-2025	DRAWN BY	N.A.
00	FOR APPROVAL	27-09-2025	CHECKED	V.S.K.

TITLE:- DIGITAL INPUT MODULE-2 WIRING DIAGRAM


SYSTEM:- EFFLUENT TREATMENT PLANT-10 KLD

PROJECT:- POWER CUM PLC PANEL FOR ETP PLANT

DRG. NO.:- -

SHEET NO. 22 / 27

REV.NO. AS BUILT

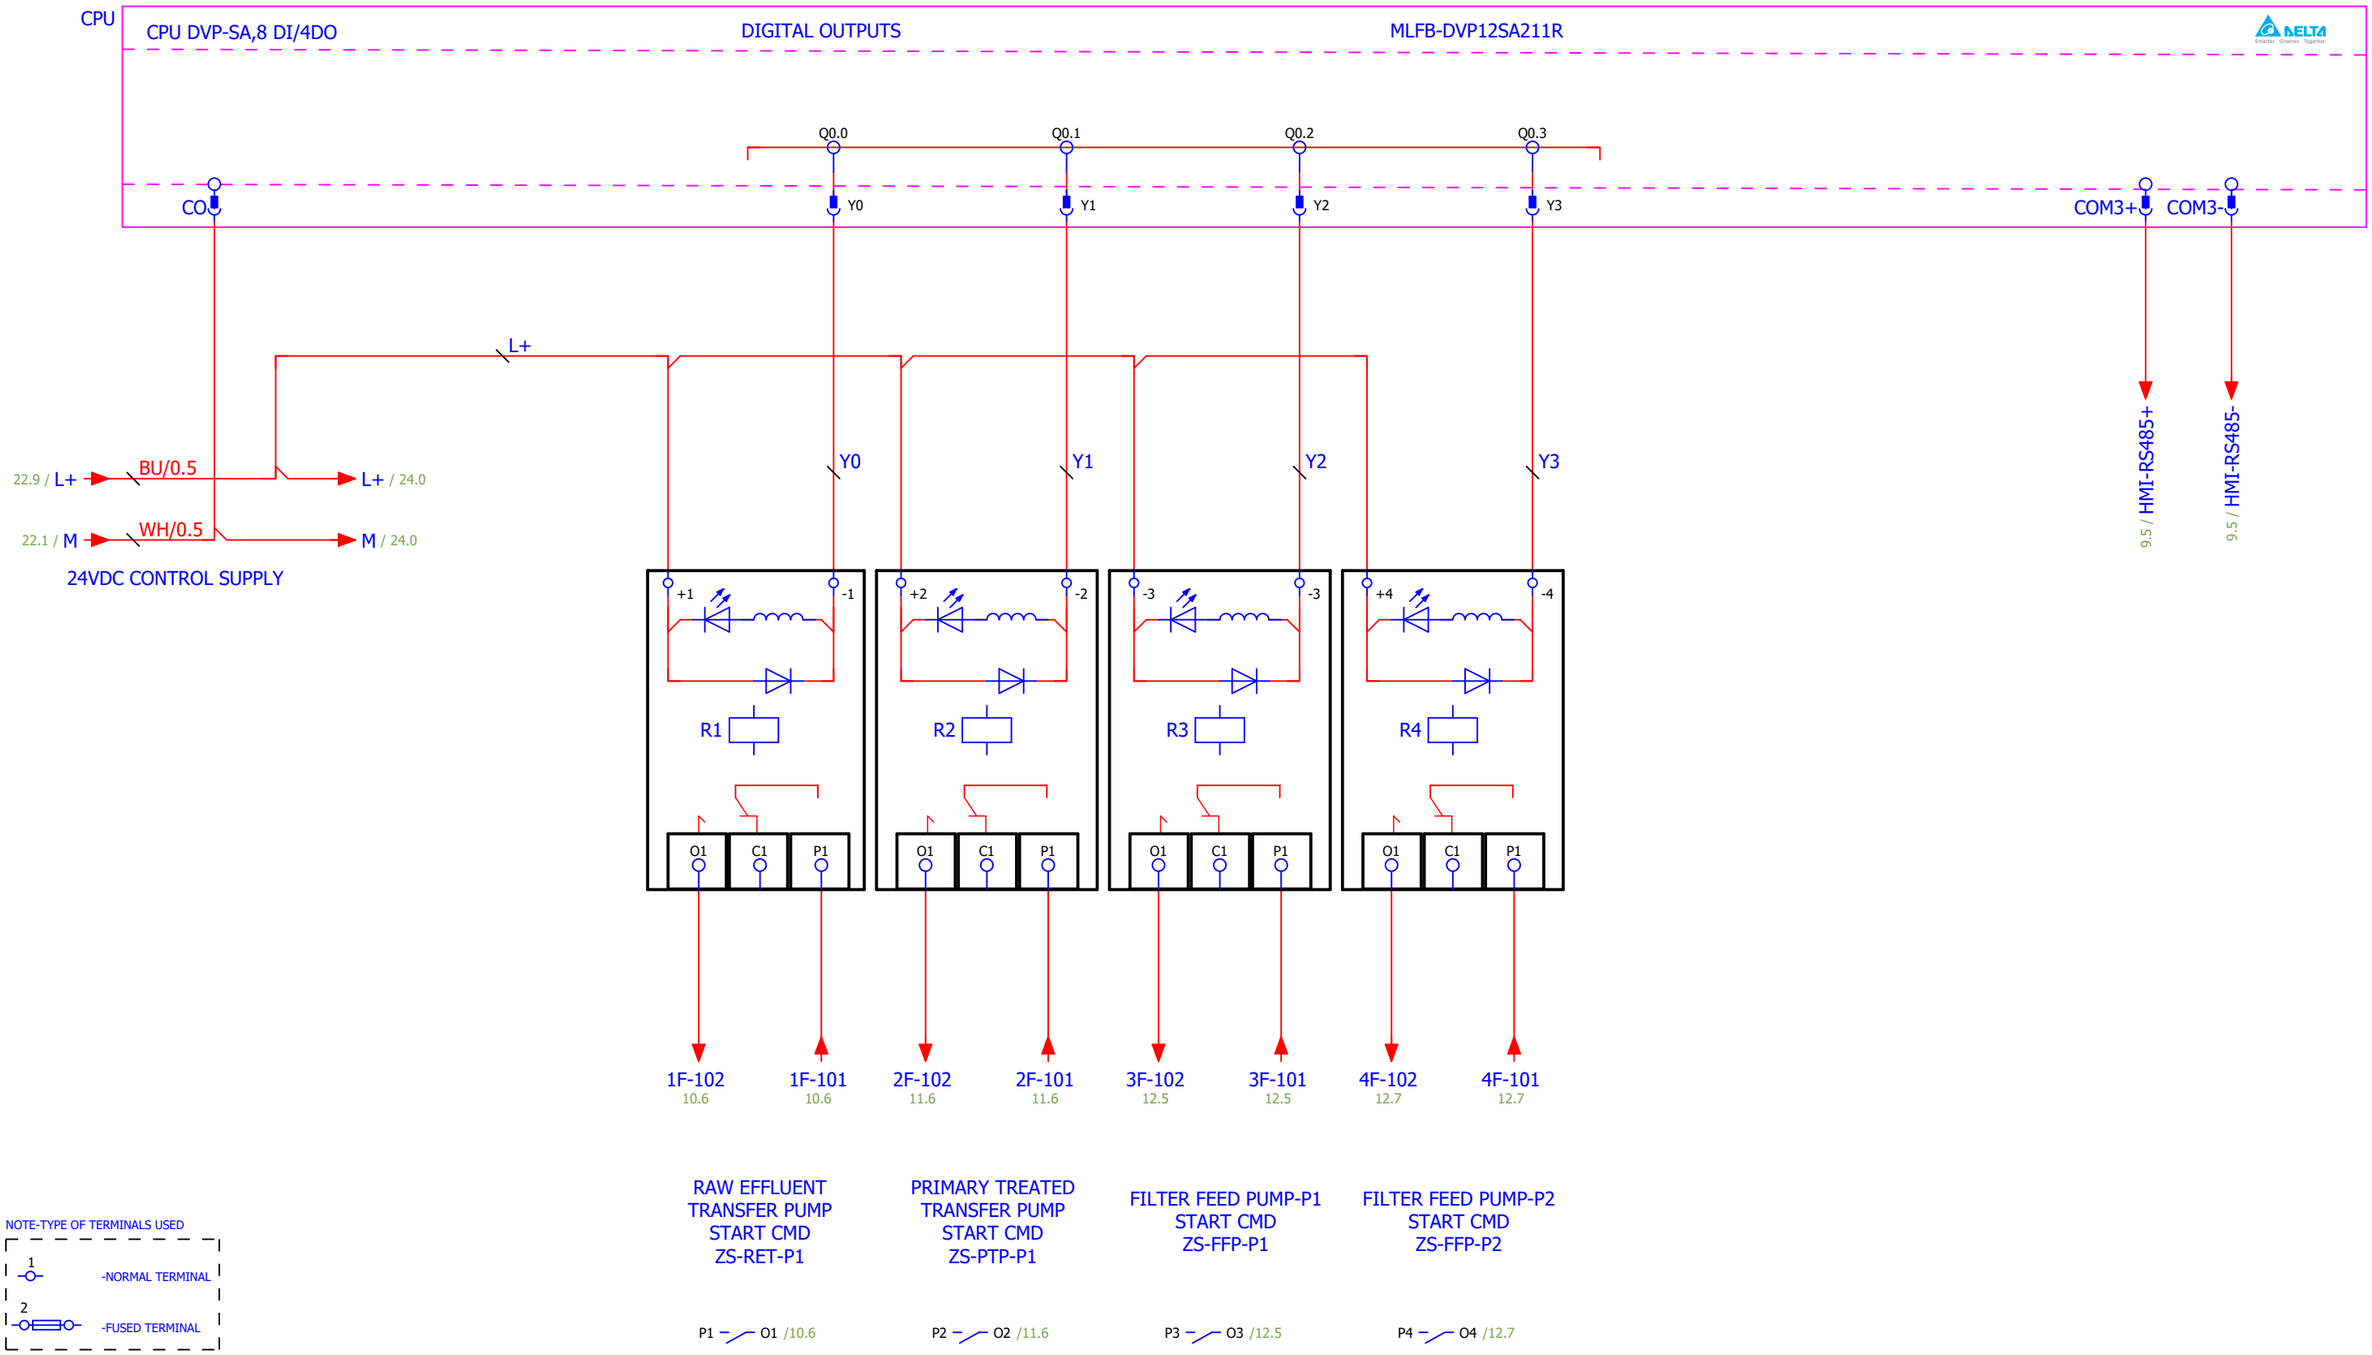

NOTE-TYPE OF TERMINALS USED

1 -NORMAL TERMINAL

2 -FUSED TERMINAL

AQUACARESEE PVT. LTD.


OFFICE NO.204, 205 AND 206
VINAYAK ARCADE, 2ND FLOOR
OPP. BAJAJ AUTO, AKURDI,PUNE-411035
www.aquacaresee.co.in
MOB:-9049560684

REVISION	DETAILS	DATE		
03	AS BUILT	24-11-2025	TITLE:- CPU DIGITAL OUTPUT WIRING	
02	AS PER COMMENTS	01-10-2025		
01	AS PER COMMENTS	29-09-2025	DRAWN BY	N.A.
00	FOR APPROVAL	27-09-2025	CHECKED	V.S.K.
			APPROVED	P.S.B.

SYSTEM:- EFFLUENT TREATMENT PLANT-10 KLD

PROJECT:- POWER CUM PLC PANEL FOR ETP PLANT

DRG. NO.:- - | SHEET NO. 23 / 27 | REV.NO. AS BUILT

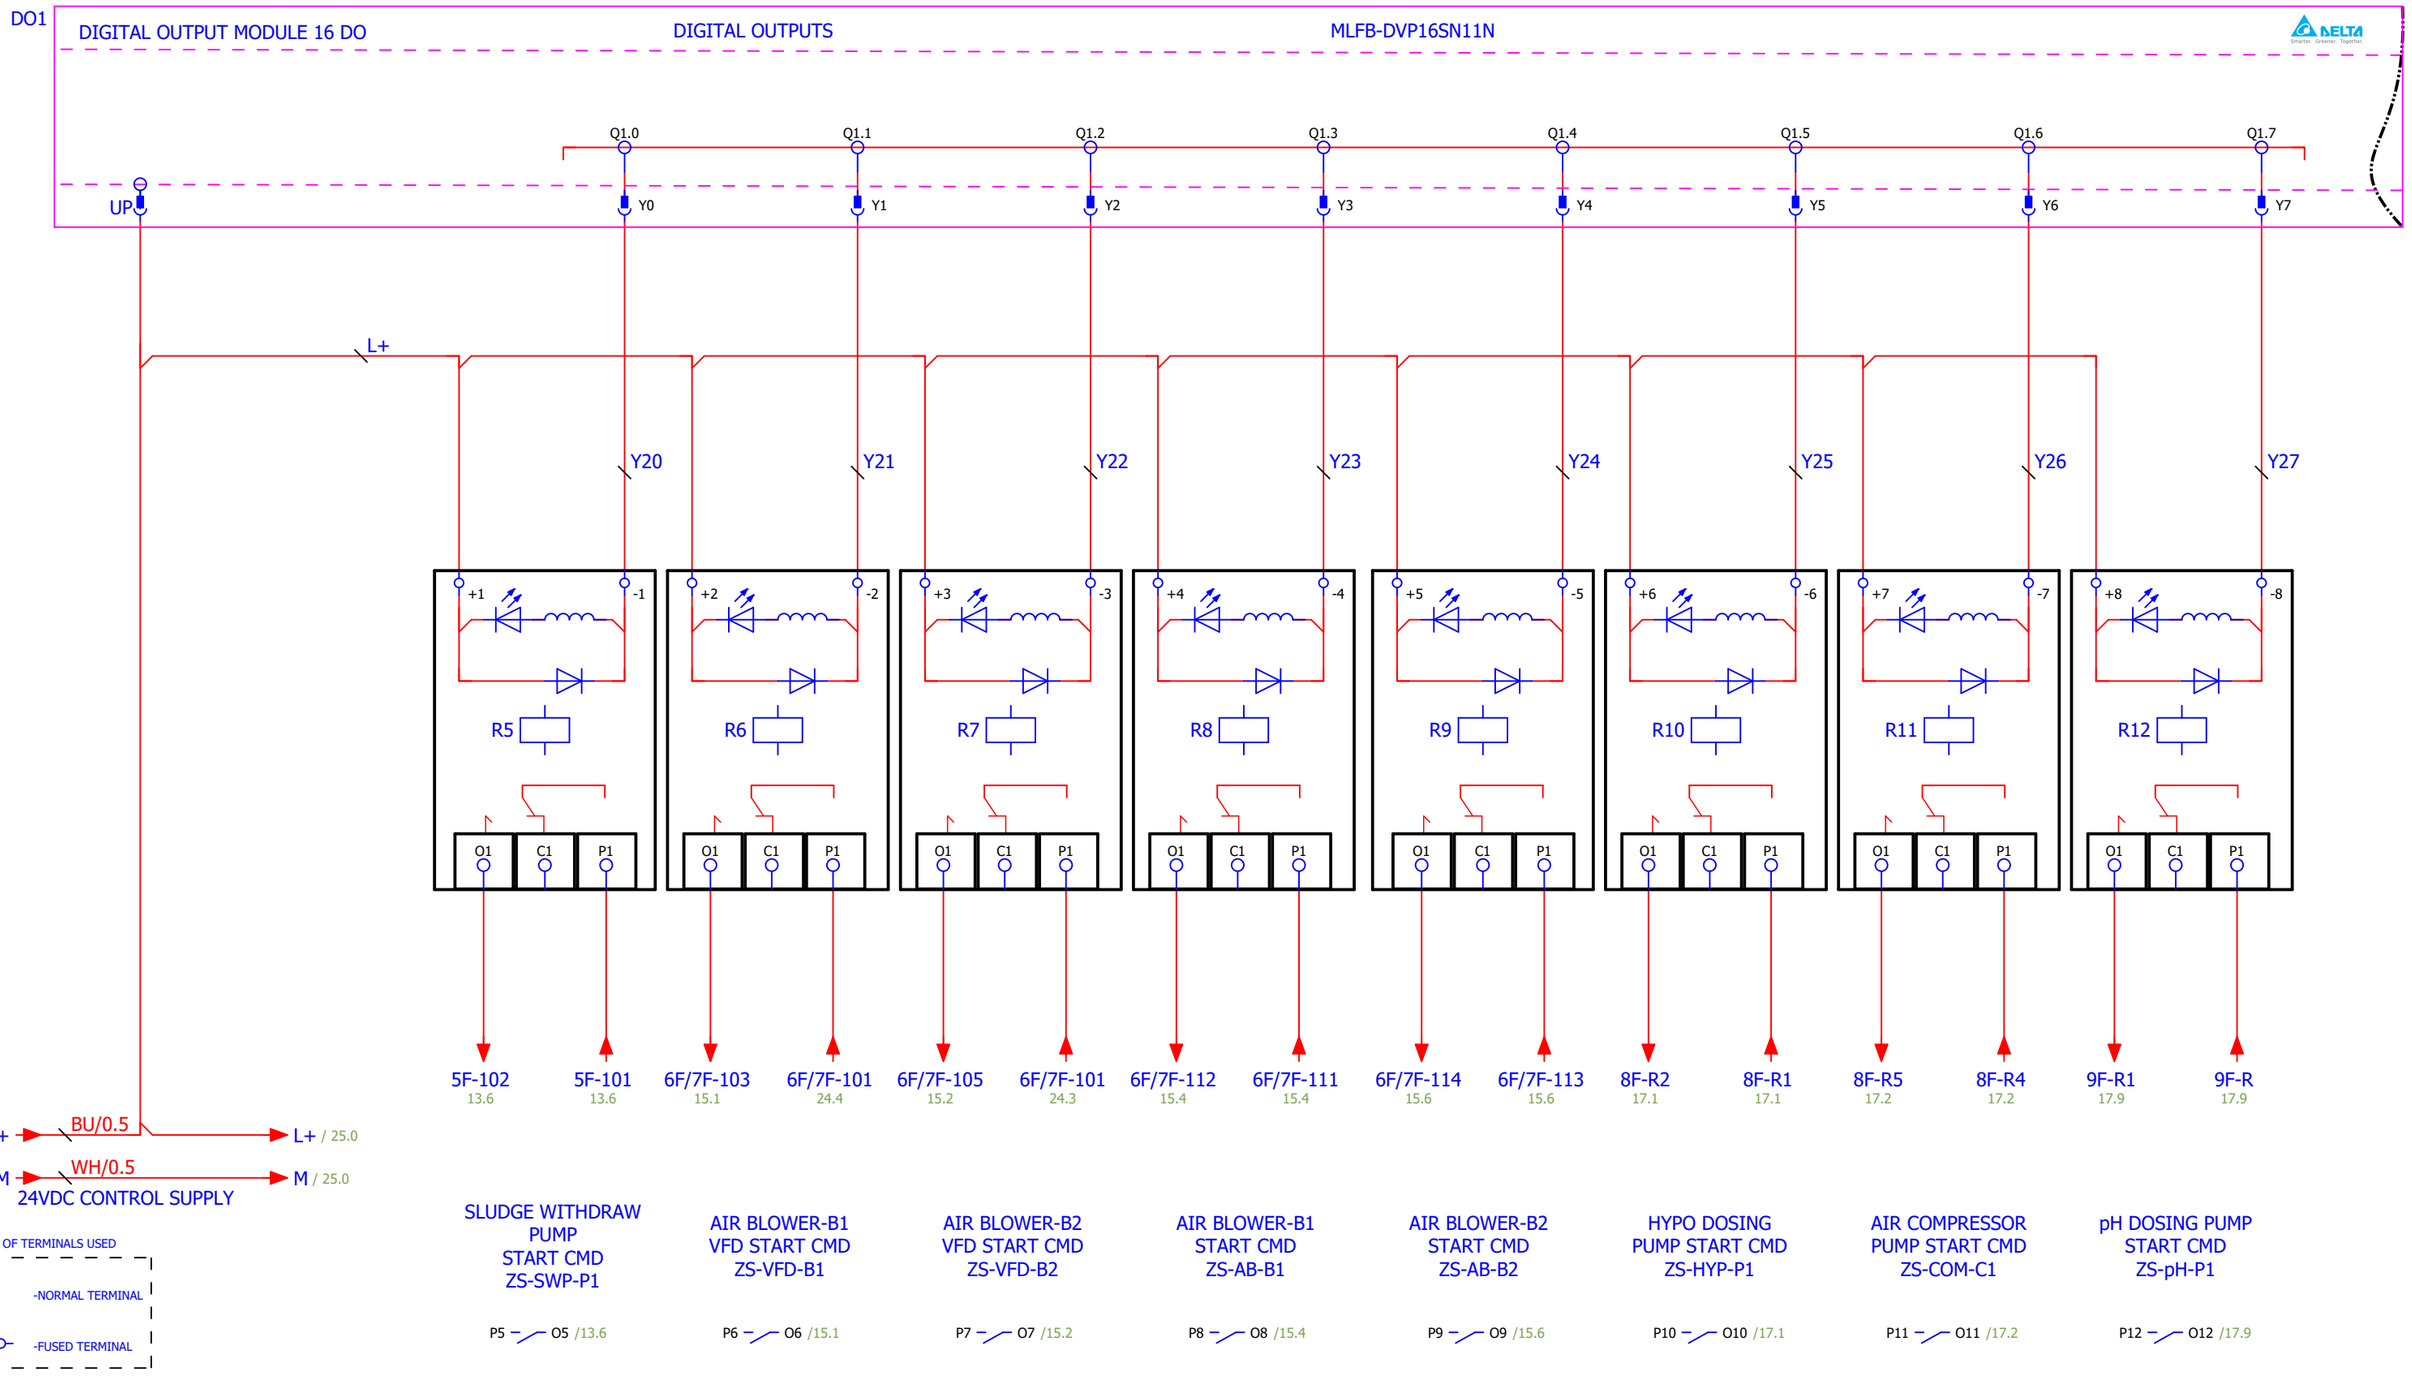

AQUACARESEE PVT. LTD.
OFFICE NO.204, 205 AND 206
VINAYAK ARCADE, 2ND FLOOR
OPP. BAJAJ AUTO, AKURDI,PUNE-411035
www.aquacaresee.co.in
MOB:-9049560684

REVISION	DETAILS	DATE		
03	AS BUILT	24-11-2025	TITLE:- DIGITAL OUTPUT MODULE-1 WIRING DIAGRAM	
02	AS PER COMMENTS	01-10-2025		
01	AS PER COMMENTS	29-09-2025	DRAWN BY	N.A.
00	FOR APPROVAL	27-09-2025	CHECKED	V.S.K.
			APPROVED	P.S.B.


SYSTEM:- EFFLUENT TREATMENT PLANT-10 KLD

PROJECT:- POWER CUM PLC PANEL FOR ETP PLANT

DRG. NO.:- -

SHEET NO. 24 / 27

REV.NO. AS BUILT

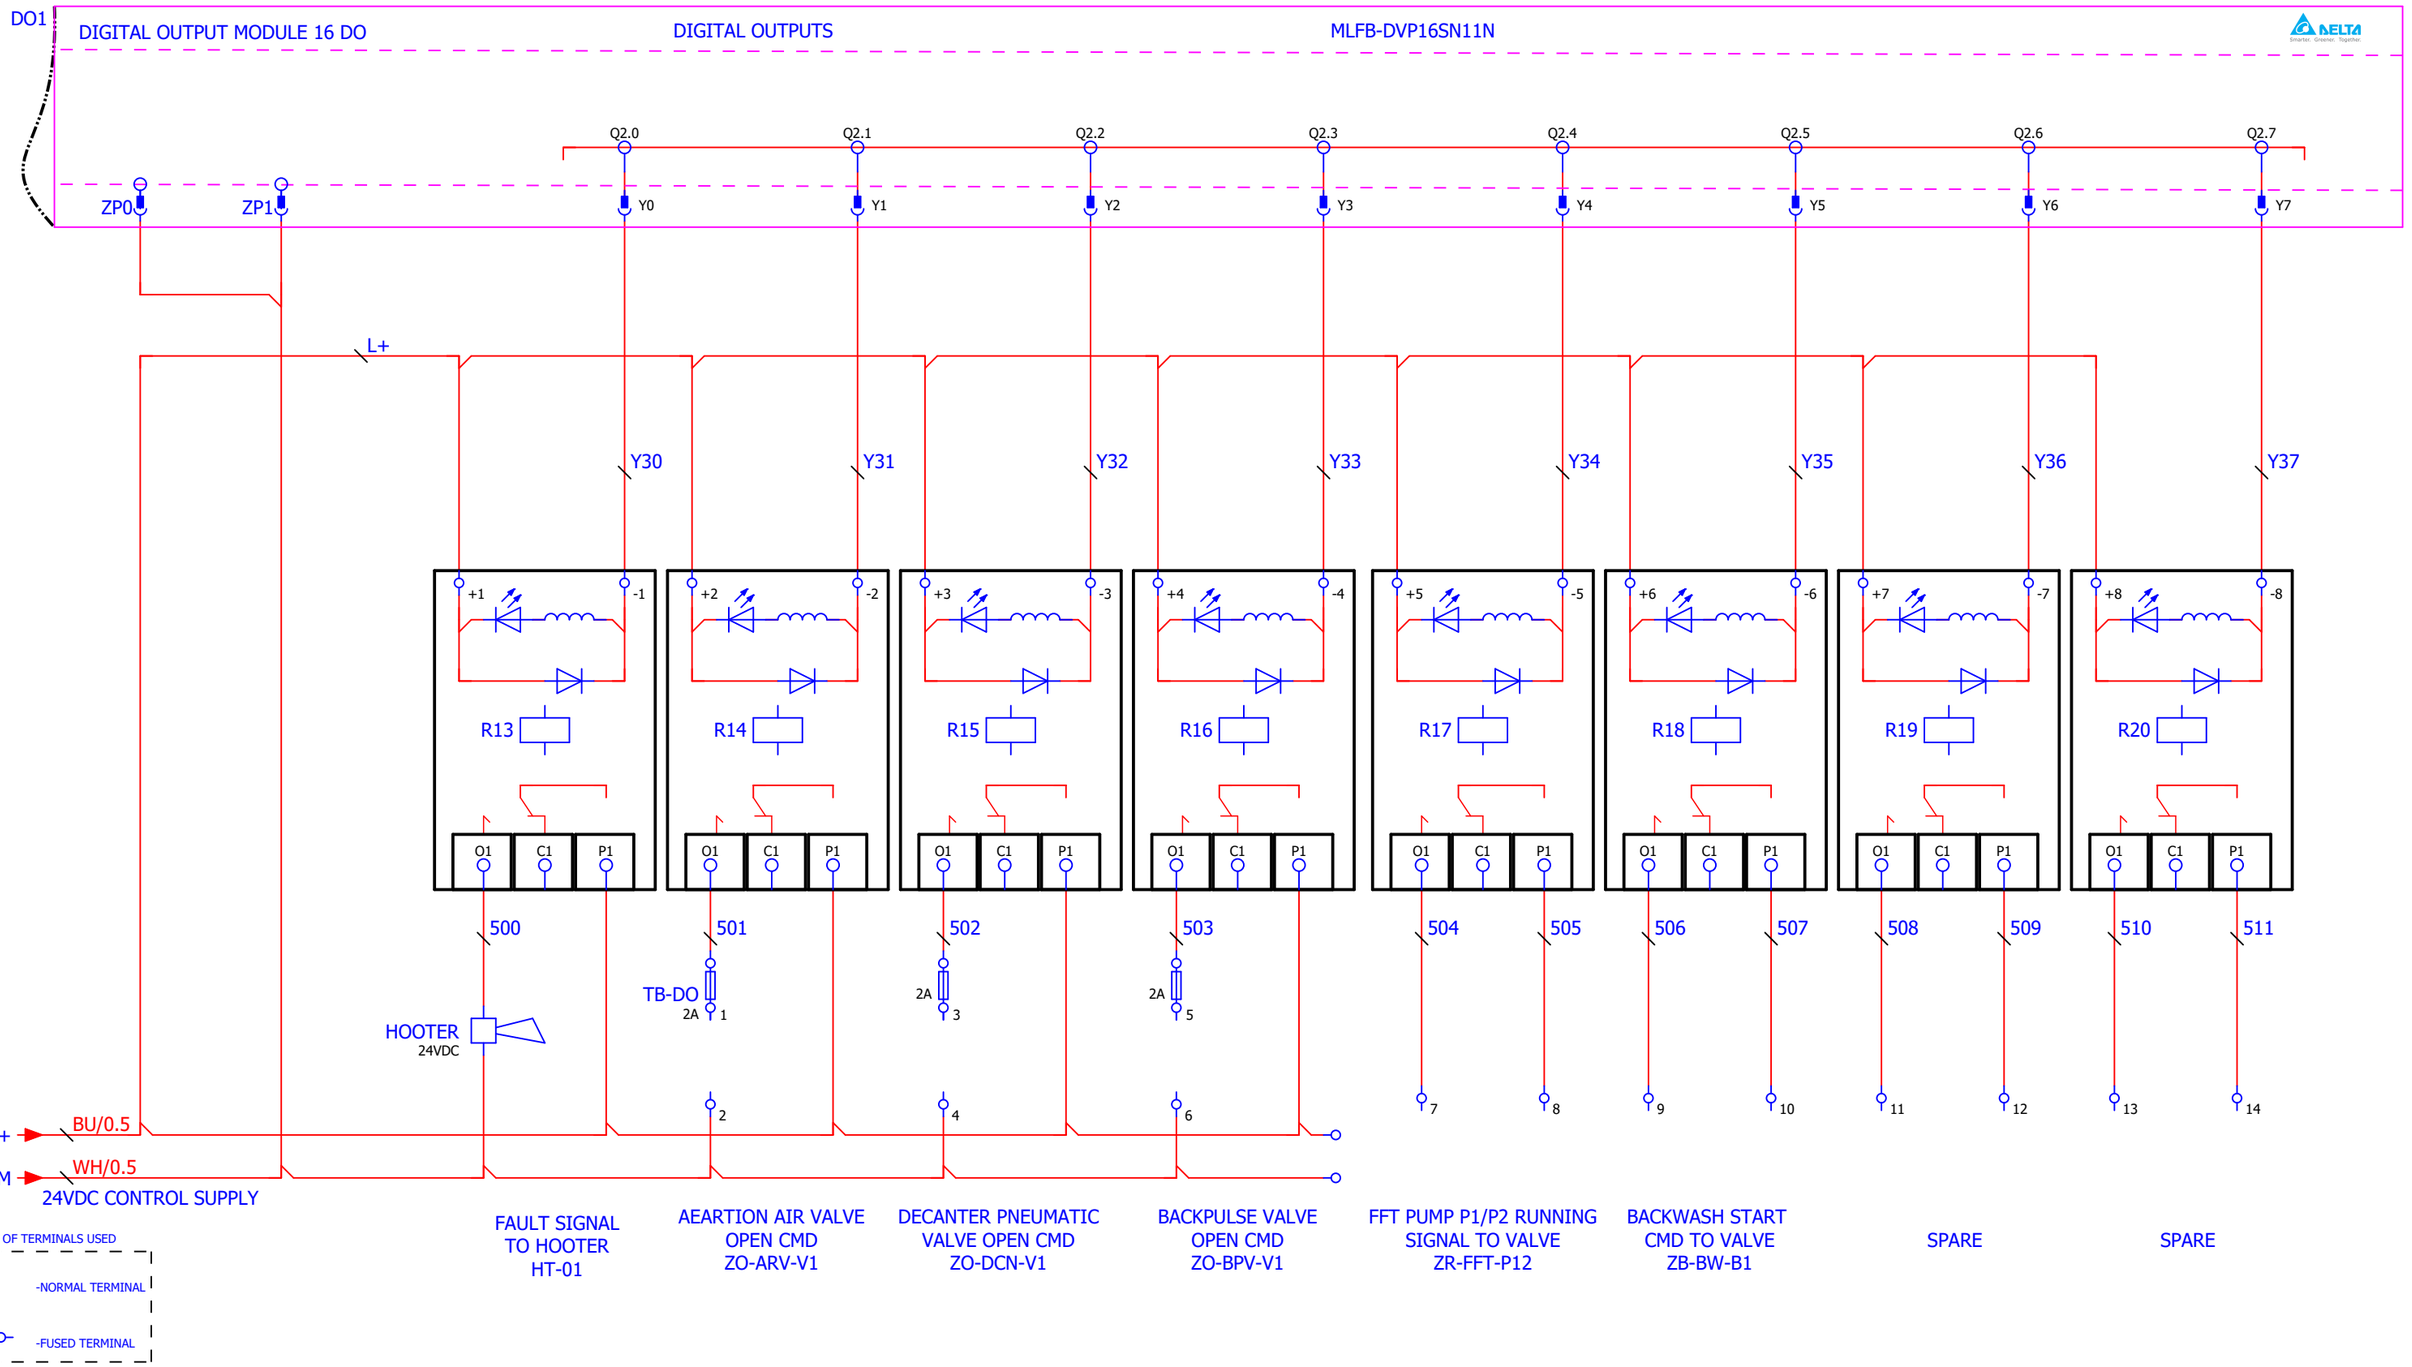


AQUACARESEE PVT. LTD.

OFFICE NO.204, 205 AND 206
VINAYAK ARCADE, 2ND FLOOR
OPP. BAJAJ AUTO, AKURDI,PUNE-411035
www.aquacaresee.co.in
MOB:-9049560684

REVISION	DETAILS	DATE		
03	AS BUILT	24-11-2025	TITLE:- DIGITAL OUTPUT MODULE-1 WIRING DIAGRAM	
02	AS PER COMMENTS	01-10-2025		
01	AS PER COMMENTS	29-09-2025	DRAWN BY	N.A.
00	FOR APPROVAL	27-09-2025	CHECKED	V.S.K.
			APPROVED	P.S.B.

SYSTEM:- EFFLUENT TREATMENT PLANT-10 KLD		
PROJECT:- POWER CUM PLC PANEL FOR ETP PLANT		
DRG. NO.:- -	SHEET NO. 25 / 27	REV.NO. AS BUILT

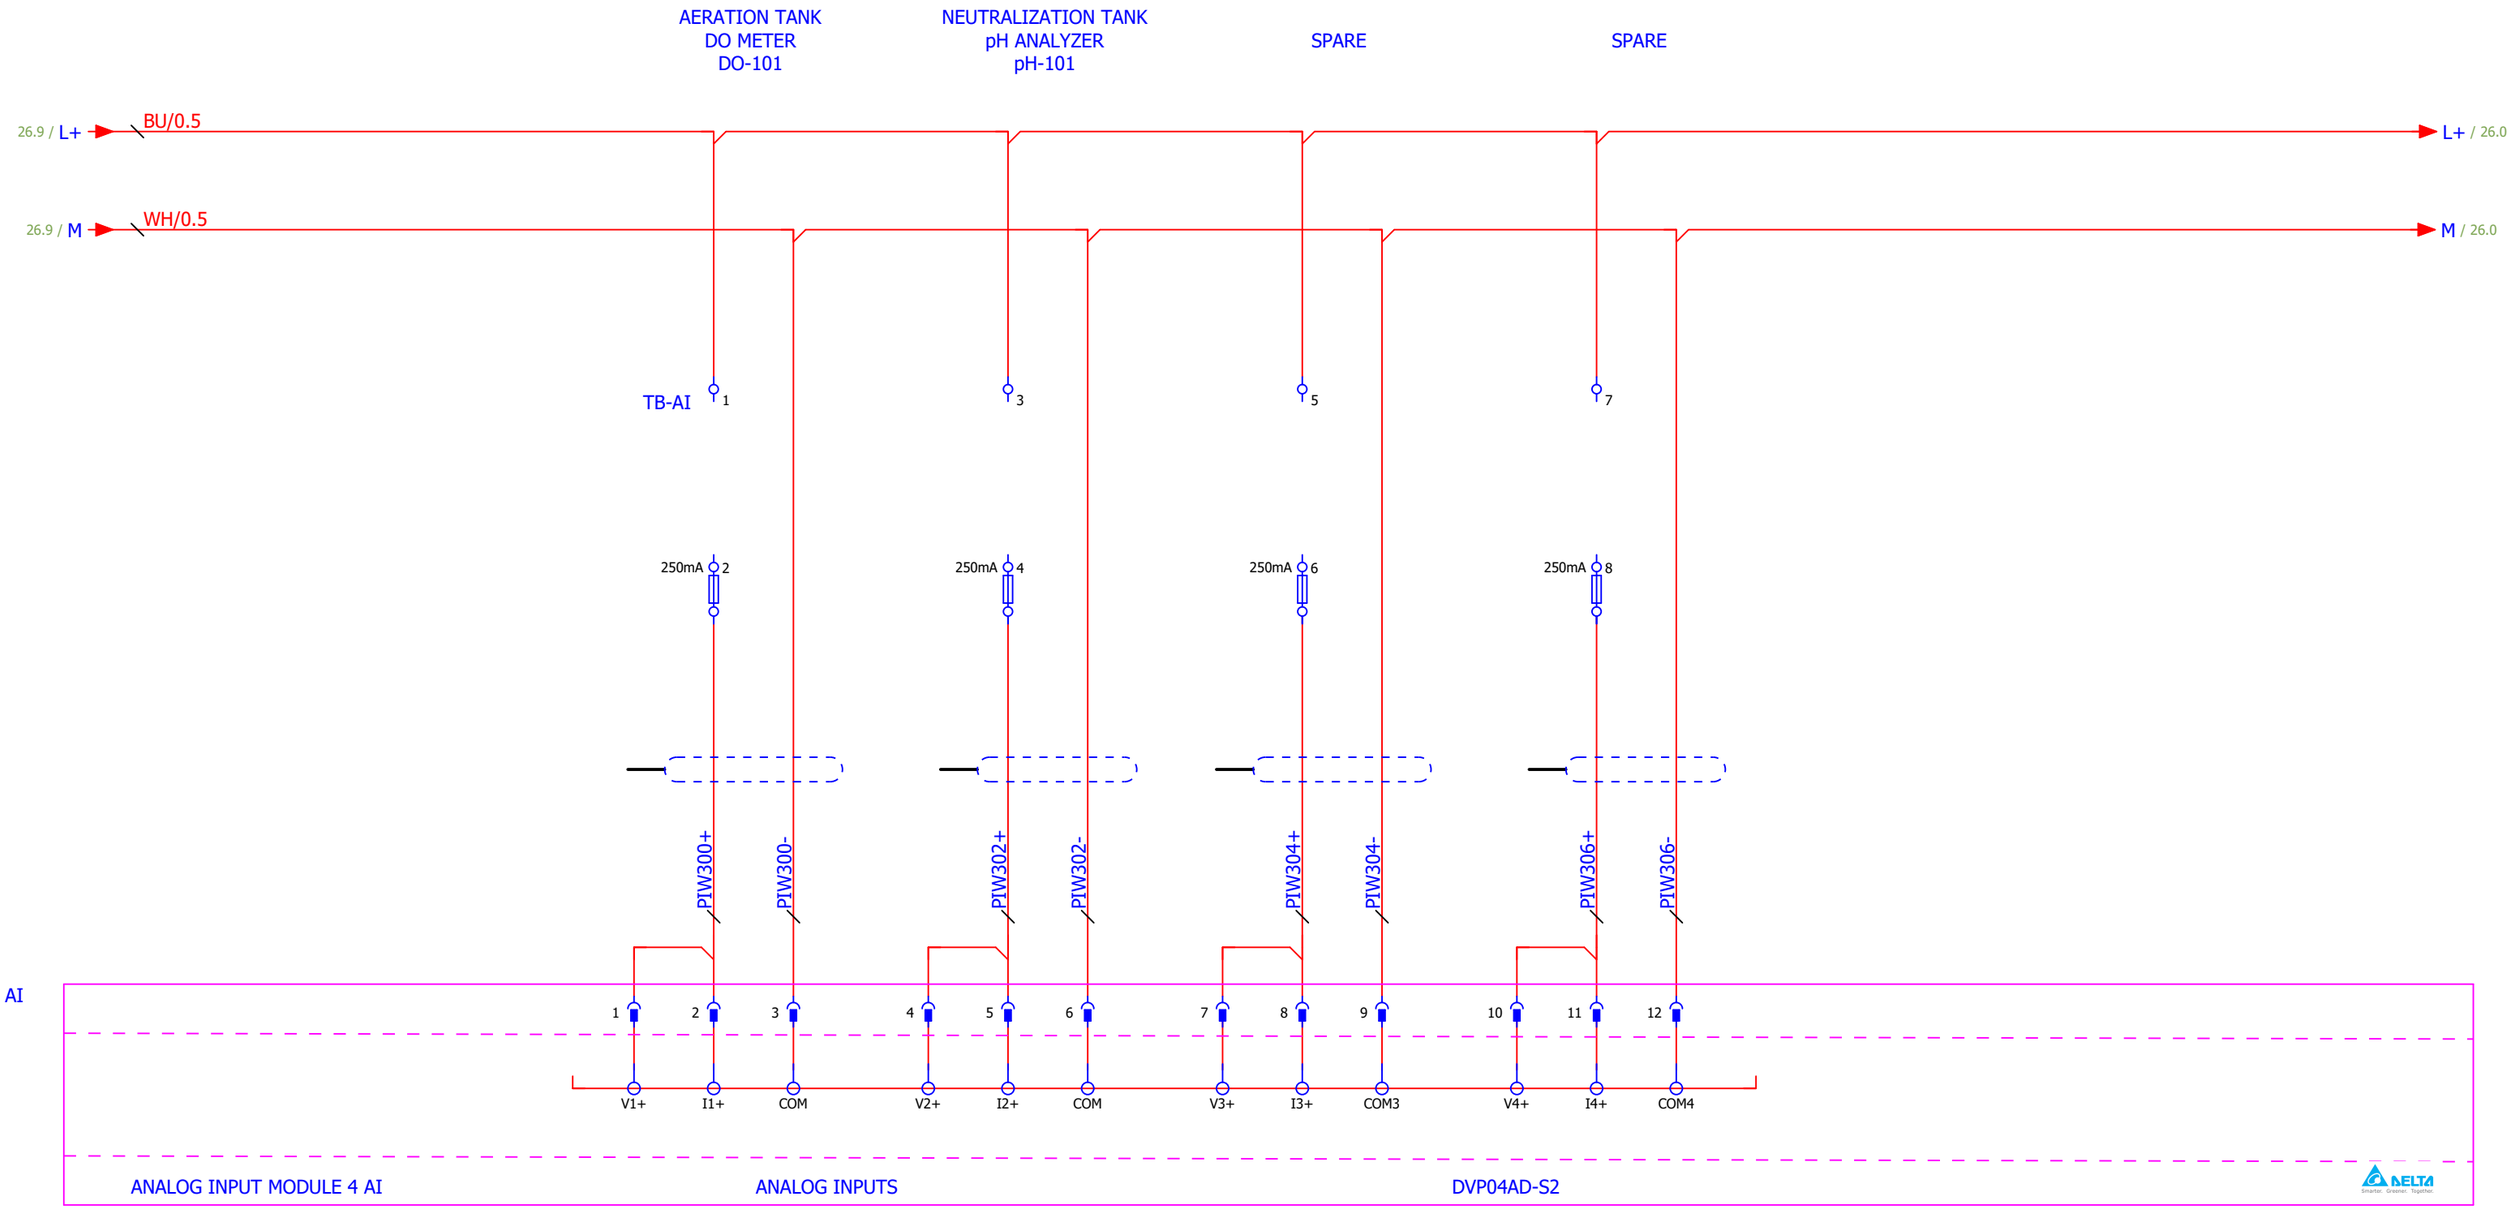

AQUACARESEE PVT. LTD.
OFFICE NO.204, 205 AND 206
VINAYAK ARCADE, 2ND FLOOR
OPP. BAJAJ AUTO, AKURDI,PUNE-411035
www.aquacaresee.co.in
MOB:-9049560684

REVISION	DETAILS	DATE	APPROVED	P.S.B.
03	AS BUILT	24-11-2025		
02	AS PER COMMENTS	01-10-2025		
01	AS PER COMMENTS	29-09-2025	DRAWN BY	N.A.
00	FOR APPROVAL	27-09-2025	CHECKED	V.S.K.

TITLE:- ANALOG INPUT WIRING DIAGRAM

SYSTEM:- EFFLUENT TREATMENT PLANT-10 KLD

PROJECT:- POWER CUM PLC PANEL FOR ETP PLANT

DRG. NO.:- -

SHEET NO. 26 / 27

REV.NO. AS BUILT

TERMINAL DETAILS

IN PANEL	ON FIELD

X0

10SQ.MM

R	1	RD	INCOMER POWER 415V, 3PH,32A FROM CUSTOMERS
Y	2	YL	
B	3	BL	
N	4	BK	

1F-X0

25SQ.MM

1F-R1	1	RD	RAW EFFLUENT TRANSFER PUMP
1F-Y1	2	YL	
1F-Y1	3	BL	

2F-X0

6SQ.MM

2F-R1	1	RD	PRIMARY TREATED TRANSFER PUMP
2F-Y1	2	YL	
2F-Y1	3	BL	

3F-X0

6SQ.MM

3F-R1	1	RD	FILTER FEED PUMP-P1
3F-Y1	2	YL	
3F-Y1	3	BL	

4F-X0

6SQ.MM

4F-R1	1	RD	FILTER FEED PUMP-P2
4F-Y1	2	YL	
4F-Y1	3	BL	

5F-X0

6SQ.MM

5F-R1	1	RD	SLUDGE WITHDRAW PUMP
5F-Y1	2	YL	
5F-Y1	3	BL	

6F-X0

6SQ.MM

6F-R2	1	RD	AIR BLOWER-B1
6F-Y2	2	YL	
6F-Y2	3	BL	

7F-X0

6SQ.MM

7F-R1	1	RD	AIR BLOWER-B2
7F-Y1	2	YL	
7F-Y1	3	BL	

TERMINAL DETAILS

IN PANEL	ON FIELD

8F-X0

6SQ.MM

8F-R2	1	RD	HYPO DOSING PUMP
8F-N	2	BK	

8F-X1

6SQ.MM

8F-R5	1	RD	AIR COMPRESSOR
8F-N	2	BK	

9F-X0

6SQ.MM

9F-R	1	RD	MULTIPORT VALVE-1
9F-N	2	BK	
PE	3	GRYL	

9F-X1

6SQ.MM

9F-R	1	RD	MULTIPORT VALVE-2
9F-N	2	BK	
PE	3	GRYL	

9F-X2

6SQ.MM

9F-R	1	RD	MAGNETIC FLOW METER
9F-N	2	BK	
PE	3	GRYL	

9F-X3

6SQ.MM

9F-R	1	RD	DO METER
9F-N	2	BK	
PE	3	GRYL	

9F-X4

6SQ.MM

9F-R	1	RD	pH CONTROLLER
9F-N	2	BK	
PE	3	GRYL	

9F-X5

6SQ.MM

9F-R1	1	RD	pH DOSING PUMP
9F-N	2	BK	
PE	3	GRYL	

TERMINAL DETAILS

IN PANEL	ON FIELD

TB-DI1

2.5 SQ.MM

L+	1	BL	AEARTION AIR VALVE OPEN F/B ZSO-ARV-V1
X36	2	BL	
L+	3	BL	DECANTER PNEUMATIC VALVE OPEN F/B ZSO-DCN-V1
X37	4	BL	

TB-DI2

2.5 SQ.MM

L+	1	BL	BACKPULSE VALVE OPEN F/B ZSO-BPV-V1
X40	2	BL	
L+	3	BL	NEUTRALIZATION TANK LEVEL SWITCH LSL-NT-01
X41	4	BL	
L+	5	BL	PSF MPV 1 & ACF MPV 2 SERVICE MODE F/B ZSO-PASF-01
X42	6	BL	
L+	7	BL	PSF BACKWASH PRROGRESS ZBW-PSF-01
X43	8	BL	
L+	9	BL	ACF BACKWASH PROGRESS ZBW-ACF-01
X44	10	BL	
L+	11	BL	RAW EFFLUENT TANK LEVEL SWITCH LSL-CT-01
X45	12	BL	
L+	13	BL	AERATION TANK LEVEL SWITCH LSL-AT-01
X46	14	BL	
L+	15	BL	TREATED WATER TANK LEVEL SWITCH LSL-TT-01
X47	16	BL	

TB-DO

2.5 SQ.MM

501	1	BL	AEARTION AIR VALVE OPEN CMD ZO-ARV-V1
M	2	WH	
502	3	BL	DECANTER PNEUMATIC VALVE OPEN CMD ZO-DCN-V1
M	4	WH	
503	5	BL	BACKPULSE VALVE OPEN CMD ZO-BPV-V1
M	6	WH	
504	7	GY	FFT PUMP P1/P2 RUNNING SIGNAL TO VALVE ZR-FFT-P12
505	8	GY	
506	9	GY	BACKWASH START CMD TO VALVE ZB-BW-B1
507	10	GY	
508	11	GY	SPARE
509	12	GY	
510	13	GY	SPARE
511	14	GY	

TERMINAL DETAILS

IN PANEL	ON FIELD

TB-RS485-DBK

2.5 SQ.MM

RS485+	1	BL	RS485 COMMUNICATION TO FIELD (MAGNETIC FLW METER, DO METER & pH CONTROLLER)
RS485+	2	BL	
RS485+	3	BL	
RS485-	4	WH	
RS485-	5	WH	
RS485-	6	WH	

TB-AI

2.5 SQ.MM

L+	1	BL	AERATION TANK DO METER DO-101
PIW300+	2	OG	
L+	3	BL	NEUTRALIZATION TANK pH ANALYZER pH-101
PIW302+	4	OG	
L+	5	BL	SPARE
PIW304+	6	OG	
L+	7	BL	SPARE
PIW306+	8	OG	

AQUACARESEE PVT. LTD.

OFFICE NO.204, 205 AND 206
VINAYAK ARCADE, 2ND FLOOR
OPP. BAJAJ AUTO, AKURDI,PUNE-411035
www.aquacaresee.co.in
MOB:-9049560684

REVISION	DETAILS	DATE		
03	AS BUILT	24-11-2025	TITLE:- TERMINATION	
02	AS PER COMMENTS	01-10-2025		
01	AS PER COMMENTS	29-09-2025	DRAWN BY	N.A.
00	FOR APPROVAL	27-09-2025	CHECKED	V.S.K.
			APPROVED	P.S.B.

SYSTEM:-	EFFLUENT TREATMENT PLANT-10 KLD		
PROJECT:-	POWER CUM PLC PANEL FOR ETP PLANT		
DRG. NO.:-	-	SHEET NO. 27 / 27	REV.NO. AS BUILT