**AQUACARESEE PVT. LTD.**
OFFICE NO.204, 205 AND 206
VINAYAK ARCADE, 2ND FLOOR
OPP. BAJAJ AUTO, AKURDI,PUNE-411035
www.aquacaresee.co.in
MOB:-9049560684
**www.aquacaresee.co.in**

| | |
|---|---|
| PROJECT CODE | 375 KLD MBR STP |
| CLIENT | MARVEL RESORTS PVT.LTD. |
| SYSTEM | 375 KLD MBR STP |
| DOCUMENT | ASEE 25-26-21 STP |
| YEAR OF MFG | YEAR 2025-26 |

Edit date 23-01-2026 CREATOR SYSTEM TUSHAR.AHER 47

# Table of contents

Column X: An automatically generated page was edited

F06_001


| Page | Page description | supplementary page field | Date | Edited by | X |
|---|---|---|---|---|---|
| /1 | TITLE PAGE | | 23-01-2026 | TUSHAR.AHER | X |
| /2 | Table of contents : /1 - /31 | | 23-01-2026 | TUSHAR.AHER | |
| /2.a | Table of contents : /32 - /46 | | 23-01-2026 | TUSHAR.AHER | |
| /3 | GENERAL SPECIFICATIONS | | 23-01-2026 | TUSHAR.AHER | |
| /4 | EXTERNAL GENERAL ARRANGEMENT | | 23-01-2026 | TUSHAR.AHER | |
| /5 | INTERNAL GENERAL ARRANGEMENT | | 23-01-2026 | TUSHAR.AHER | |
| /6 | LEGENDS DETAILS | | 23-01-2026 | TUSHAR.AHER | |
| /7 | SINGLE LINE DIAGRAM | | 23-01-2026 | TUSHAR.AHER | |
| /8 | SINGLE LINE DIAGRAM | | 23-01-2026 | TUSHAR.AHER | |
| /9 | SINGLE LINE DIAGRAM | | 23-01-2026 | TUSHAR.AHER | |
| /10 | SINGLE LINE DIAGRAM | | 23-01-2026 | TUSHAR.AHER | |
| /11 | SINGLE LINE DIAGRAM | | 23-01-2026 | TUSHAR.AHER | |
| /12 | SINGLE LINE DIAGRAM | | 23-01-2026 | TUSHAR.AHER | |
| /13 | INCOMER WIRING | | 23-01-2026 | TUSHAR.AHER | |
| /14 | 230VAC & 24VDC DISTRIBUTION | | 23-01-2026 | TUSHAR.AHER | |
| /15 | OIL SKIMEER PUMP-P1 & SUMP PUMP-P1 & P2 POWER & CONTROL WIRING (1F ,2F & 3F) | | 23-01-2026 | TUSHAR.AHER | |
| /16 | RAW SEWAGE TR. PUMP-P1 & P2 & ROTARY FINE DRUM SCREEN PUMP-P1 POWER & CONTROL WIRING (4F & 5F & 6F) | | 23-01-2026 | TUSHAR.AHER | |
| /17 | MBR AIR BLOWER -B1 & B2 POWER & CONTROL WIRING (7F & 8F) | | 23-01-2026 | TUSHAR.AHER | |
| /18 | AERATION AIR BLOWER PUMP - B1 POWER & CONTROL WIRING (9F) | | 23-01-2026 | TUSHAR.AHER | |
| /19 | AERATION AIR BLOWER PUMP - B2 POWER & CONTROL WIRING (10F) | | 23-01-2026 | TUSHAR.AHER | |
| /20 | MBR PERMEATE PUMP- P1 & P2 POWER & CONTROL WIRING (11F & 12F) | | 23-01-2026 | TUSHAR.AHER | |
| /21 | MBR BACKWASH PUMP PUMP- P1 & P2 POWER & CONTROL WIRING (13F & 14F) | | 23-01-2026 | TUSHAR.AHER | |
| /22 | SLUDGE RECIRCULATION PUMP- P1 & P2,CENTRIFUGE POWER & CONTROL WIRING (15F,16F &17F) | | 23-01-2026 | TUSHAR.AHER | |
| /23 | POLY DOSING TANK AGITATOR PUMP- P1 & CENFG. FEED PUMP-P1 & P2 POWER & CONTROL WIRING (18F,19F & 20F) | | 23-01-2026 | TUSHAR.AHER | |
| /24 | ANOXIC RECIRCULATION PUMP P1 &P2-POWER & CONTROL WIRING (21F & 22F) | | 23-01-2026 | TUSHAR.AHER | |
| /25 | DOSING & CITRIC PUMPS & SUPPLY FEEDER | | 23-01-2026 | TUSHAR.AHER | |
| /26 | DOSING & CITRIC PUMPS & SUPPLY FEEDER | | 23-01-2026 | TUSHAR.AHER | |
| /27 | PLC WIRING DIAGRAM | | 23-01-2026 | TUSHAR.AHER | |
| /28 | CPU-DIGITAL INPUT WIRING | | 23-01-2026 | TUSHAR.AHER | |
| /29 | DIGITAL INPUT MODULE-1 WIRING DIAGRAM | | 23-01-2026 | TUSHAR.AHER | |
| /30 | DIGITAL INPUT MODULE-1 WIRING DIAGRAM | | 23-01-2026 | TUSHAR.AHER | |
| /31 | DIGITAL INPUT MODULE-2 WIRING DIAGRAM | | 23-01-2026 | TUSHAR.AHER | |



**AQUACARESEE PVT. LTD.**

**OFFICE NO.204, 205 AND 206**
**VINAYAK ARCADE, 2ND FLOOR**
**OPP. BAJAJ AUTO, AKURDI,PUNE-411035**
**www.aquacaresee.co.in**


| REVISION | DETAILS | DATE |
|---|---|---|
| | | |
| 00 | AS BUILT | 23-01-2025 |
| 01 | AS PER COMMENTS | 09-12-2025 |
| 00 | FOR APPROVAL | 04-12-2025 |

TITLE:- Table of contents : /1 - /31

| | |
|---|---|
| DRAWN BY | N.J. |
| CHECKED | V.K. |
| APPROVED | P.B. |

SYSTEM:-375 KLD MBR STP

PROJECT:- 375 KLD MBR STP PLANT CONTROL PANEL

DRG. NO.:PRG-2526-637 | SHEET NO. 2 / 47 | REV.NO. AS BUILT

# Table of contents

Column X: An automatically generated page was edited

F06_001


| Page | Page description | supplementary page field | Date | Edited by | X |
|---|---|---|---|---|---|
| /32 | DIGITAL INPUT MODULE-2 WIRING DIAGRAM | | 23-01-2026 | TUSHAR.AHER | |
| /33 | DIGITAL INPUT MODULE-3 WIRING DIAGRAM | | 23-01-2026 | TUSHAR.AHER | |
| /34 | DIGITAL INPUT MODULE-3 WIRING DIAGRAM | | 23-01-2026 | TUSHAR.AHER | |
| /35 | DIGITAL INPUT MODULE-4 WIRING DIAGRAM | | 23-01-2026 | TUSHAR.AHER | |
| /36 | DIGITAL INPUT MODULE-4 WIRING DIAGRAM | | 23-01-2026 | TUSHAR.AHER | |
| /37 | CPU DIGITAL OUTPUT WIRING | | 23-01-2026 | TUSHAR.AHER | |
| /38 | DIGITAL OUTPUT MODULE-1 WIRING DIAGRAM | | 23-01-2026 | TUSHAR.AHER | |
| /39 | DIGITAL OUTPUT MODULE-1 WIRING DIAGRAM | | 23-01-2026 | TUSHAR.AHER | |
| /40 | DIGITAL OUTPUT MODULE-2 WIRING DIAGRAM | | 23-01-2026 | TUSHAR.AHER | |
| /41 | DIGITAL OUTPUT MODULE-2 WIRING DIAGRAM | | 23-01-2026 | TUSHAR.AHER | |
| /42 | ANALOG INPUT WIRING DIAGRAM | | 23-01-2026 | TUSHAR.AHER | |
| /43 | ANALOG INPUT WIRING DIAGRAM | | 23-01-2026 | TUSHAR.AHER | |
| /44 | TERMINAL DETAILS | | 23-01-2026 | TUSHAR.AHER | |
| /45 | TERMINAL DETAILS | | 23-01-2026 | TUSHAR.AHER | |
| /46 | TERMINAL DETAILS | | 23-01-2026 | TUSHAR.AHER | |



**AQUACARESEE PVT. LTD.**

**OFFICE NO.204, 205 AND 206**
**VINAYAK ARCADE, 2ND FLOOR**
**OPP. BAJAJ AUTO, AKURDI,PUNE-411035**
**www.aquacaresee.co.in**


| REVISION | DETAILS | DATE | | |
|---|---|---|---|---|
| 00 | AS BUILT | 23-01-2025 | | |
| 01 | AS PER COMMENTS | 09-12-2025 | DRAWN BY | N.J. |
| 00 | FOR APPROVAL | 04-12-2025 | CHECKED | V.K. |
| | | | APPROVED | P.B. |

TITLE:- Table of contents : /32 - /46

SYSTEM:-375 KLD MBR STP

PROJECT:- 375 KLD MBR STP PLANT CONTROL PANEL

DRG. NO.:PRG-2526-637

SHEET NO. 3 / 47

REV.NO. AS BUILT

# GENERAL SPECIFICATIONS

## A. REFERENCES

| | | | |
|---|---|---|---|
| 01 | CUSTOMER NAME | : | MARVEL RESORTS PVT.LTD. |
| 02 | PROJECT | : | 375 KLD MBR STP |

## B. SYSTEM PARAMETERS

| | | | |
|---|---|---|---|
| 01 | RATED INCOMING | : | 415VAC, 3PH. 4WIRE |
| 02 | RATED CONTROL | : | 230VAC |
| 03 | VOLTAGE VARIATION, % | : | ± 10% |
| 04 | TYPE OF SYSTEM | : | POWER CUM PLC PANEL |
| 05 | RATED FREQUENCY, Hz. | : | 50 Hz ± 5% |
| 06 | AMBIENT TEMP. | : | 40°C |

## C. CONSTRUCTION

| | | | | | |
|---|---|---|---|---|---|
| 01 | MAKE OF PANEL | : | M.S FABRICATED | | |
| 02 | DIMENSIONS IN MM. | : | 2000+75(H)X1400(W)X350(D) | | |
| 03 | THICKNESS OF SHEET | : | ENCLOSURE | : | 1.6MM (CRCA SHEET) |
| | | : | DOORS | : | 1.6MM (CRCA SHEET) |
| | | : | MOUNTING PLATE | : | 2.0MM (CRCA SHEET) |
| | | : | GLAND PLATE. | : | 3.0MM (CRCA SHEET) |
| 04 | GLAND PLATE | : | UNDRILLED GLAND PLATE FIXED WITH SCREWS AT TOP | | |
| 05 | GLAND MOUNTING | : | AT SITE | | |
| 06 | CABLE ENTRY | : | FROM TOP SIDE | | |
| 07 | PANEL COLOUR | : | SIEMENS GREY RAL 7035 ,STRUCTURE FINISH | | |
| 08 | MOUNTING PLATE | : | DIP ORANGE | | |
| 09 | LIFTING EYEBOLTS | : | PROVIDED AT TOP | | |
| 10 | REAR ACCESS | : | NO | | |
| 11 | DOORS | : | FRONT DOOR OPENING | | |
| 12 | DEGREE OF PROTECTION | : | IP-42 INDOOR | | |

## D. EQUIPMENT

| | | | |
|---|---|---|---|
| 01 | CONTROL/PROTECTION | : | MCCB'S,MCB'S FUSES USED |
| 02 | LABEL STICKERS | : | ALL LEGEND INSIDE PANEL WILL BE YELLOW STICKERS. YELLOW BACKGROUND WITH BLACK PRINTED LETTERS. |
| | | : | ALL LEGEND OUTSIDE PANEL WILL BE ALLUMINIUM LABELS. BLACK BACKGROUND WITH WHITE PRINTED LETTERS. |

| | | | | | | |
|---|---|---|---|---|---|---|
| 03 | WIRING COLOUR CODING | | | | | |
| | 415V AC, 3Ph INCOMING | : | 3.5C 16 SQ.MM AL ARMD. | : | RED,YELLOW,BLUE & BLACK | |
| | 415V AC, 3Ph (POWER WIRING) | : | FOR 0.37-3.7kW FEEDER | : | 2.5 SQ.MM RED/YELLOW/BLUE | |
| | 415V AC, 3Ph (POWER WIRING) | : | FOR 15kW FEEDER | : | 10/6 SQ.MM RED/YELLOW/BLUE | |
| | POWER EARTH | : | 2.5 mm² | : | YELLOW/GREEN | |
| 04 | CONTROL WIRING | : | 230VAC | : | 1 mm² | |
| | 230V AC PHASE | : | 1 mm² | : | RED | |
| | 230V NEUTRAL | : | 1 mm² | : | BLACK | |
| | 24VDC COMMON | : | 0.5 mm² | : | WHITE | |
| | 24VDC PLC I/P | : | 0.5 mm² | : | BLUE | |
| 05 | FERRULES | : | NUMBERS | | | |
| | FERRULING TYPE | : | BLACK LETTER ON WHITE SLEEVE (PRINTED FERRULE) | | | |
| 06 | TERMINAL COLOUR CODING | | | | | |
| | 415V AC, 3Ph (POWER TERMINAL) | : | FOR 0.37-3.7kW FEEDER | : | 6 SQ.MM RED/YELLOW/BLUE | |
| | 415V AC, 3Ph (POWER TERMINAL) | : | FOR 15kW FEEDER | : | 16 SQ.MM RED/YELLOW/BLUE | |
| 07 | CONTROL TERMINAL | | | | | |
| | DIGITAL INPUT | : | 2.5 mm² | : | GREY | |
| | DIGITAL OUTPUT | : | 2.5 mm² | : | GREY | |

**AQUACARESEE PVT. LTD.**
OFFICE NO.204, 205 AND 206
VINAYAK ARCADE, 2ND FLOOR
OPP. BAJAJ AUTO, AKURDI,PUNE-411035
www.aquacaresee.co.in

| REVISION | DETAILS | DATE |
|---|---|---|
| | | |
| 00 | AS BUILT | 23-01-2025 |
| 01 | AS PER COMMENTS | 09-12-2025 |
| 00 | FOR APPROVAL | 04-12-2025 |


| | | | |
|---|---|---|---|
| TITLE:- GENERAL SPECIFICATIONS | | | |
| DRAWN BY | N.J. | | |
| CHECKED | V.K. | | |
| APPROVED | P.B. | | |

SYSTEM:-375 KLD MBR STP

PROJECT:-375 KLD MBR STP PLANT CONTROL PANEL

| DRG. NO.:PRG-2526-637 | SHEET NO. 4/47 | REV.NO. AS BUILT |
|---|---|---|

# EXTERNAL GENERAL ARANGEMENT DRAWING

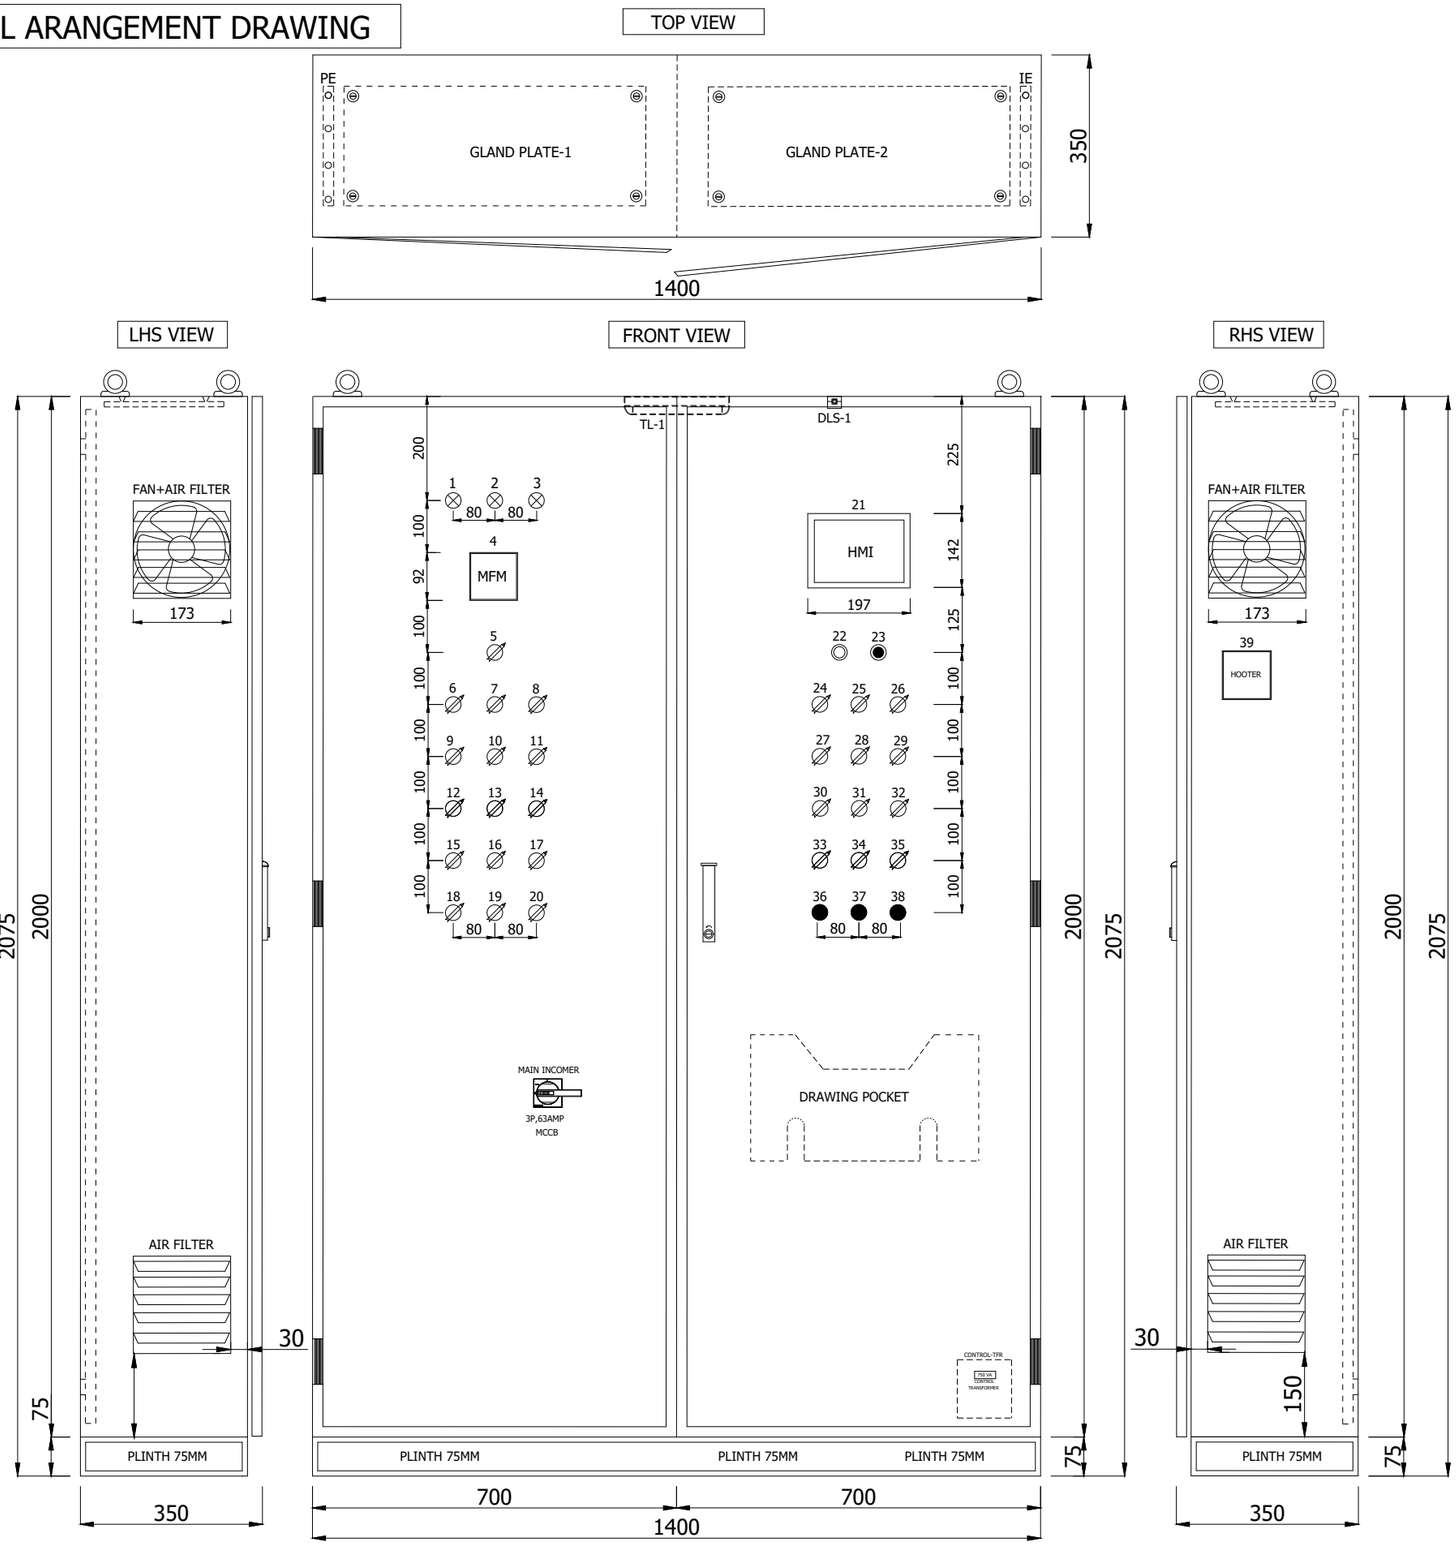


| PANEL DETAILS | |
|---|---|
| MAKE OF PANEL | M.S FABRICATED |
| DIMENSIONS IN MM. | 2000+75(H)+X1400(W)X 350(D) |
| THICKNESS OF SHEET<br>ENCLOSURE<br>DOORS<br>MOUNTING PLATE<br>GLAND PLATE. | <br>1.6MM (CRCA SHEET)<br>1.6MM (CRCA SHEET)<br>2.0MM (CRCA SHEET)<br>3.0MM (CRCA SHEET) |
| GLAND PLATE | UNDRILLED GLAND PLATE FIXED WITH SCREWS AT TOP |
| GLAND MOUNTING | AT SITE |
| CABLE ENTRY | AT TOP |
| PANEL COLOUR | SIEMENS GREY RAL 7035 |
| MOUNTING PLATE | DIP ORANGE |
| LIFTING EYEBOLTS | PROVIDED AT TOP |
| REAR ACCESS | NO |
| DOORS | HINGED DOORS WITH FRONT OPENING |
| DEGREE OF PROTECTION | IP- 42 INDOOR |


**AQUACARESEE PVT. LTD.**
**OFFICE NO.204, 205 AND 206**
**VINAYAK ARCADE, 2ND FLOOR**
**OPP. BAJAJ AUTO, AKURDI,PUNE-411035**
**www.aquacaresee.co.in**


| REVISION | DETAILS | DATE |
|---|---|---|
| | | |
| 00 | AS BUILT | 23-01-2025 |
| 01 | AS PER COMMENTS | 09-12-2025 |
| 00 | FOR APPROVAL | 04-12-2025 |

TITLE:- EXTERNAL GENERAL ARRANGEMENT

| | |
|---|---|
| DRAWN BY | N.J. |
| CHECKED | V.K. |
| APPROVED | P.B. |

SYSTEM:-375 KLD MBR STP


PROJECT:- 375 KLD MBR STP PLANT CONTROL PANEL

DRG. NO.:PRG-2526-637 | SHEET NO. 5 / 47 | REV.NO. AS BUILT

| 0 | 1 | 2 | 3 | 4 | 5 | 6 | 7 | 8 | 9 |
|---|---|---|---|---|---|---|---|---|---|

# INTERNAL GENERAL ARANGEMENT DRAWING

## MOUNTING VIEW

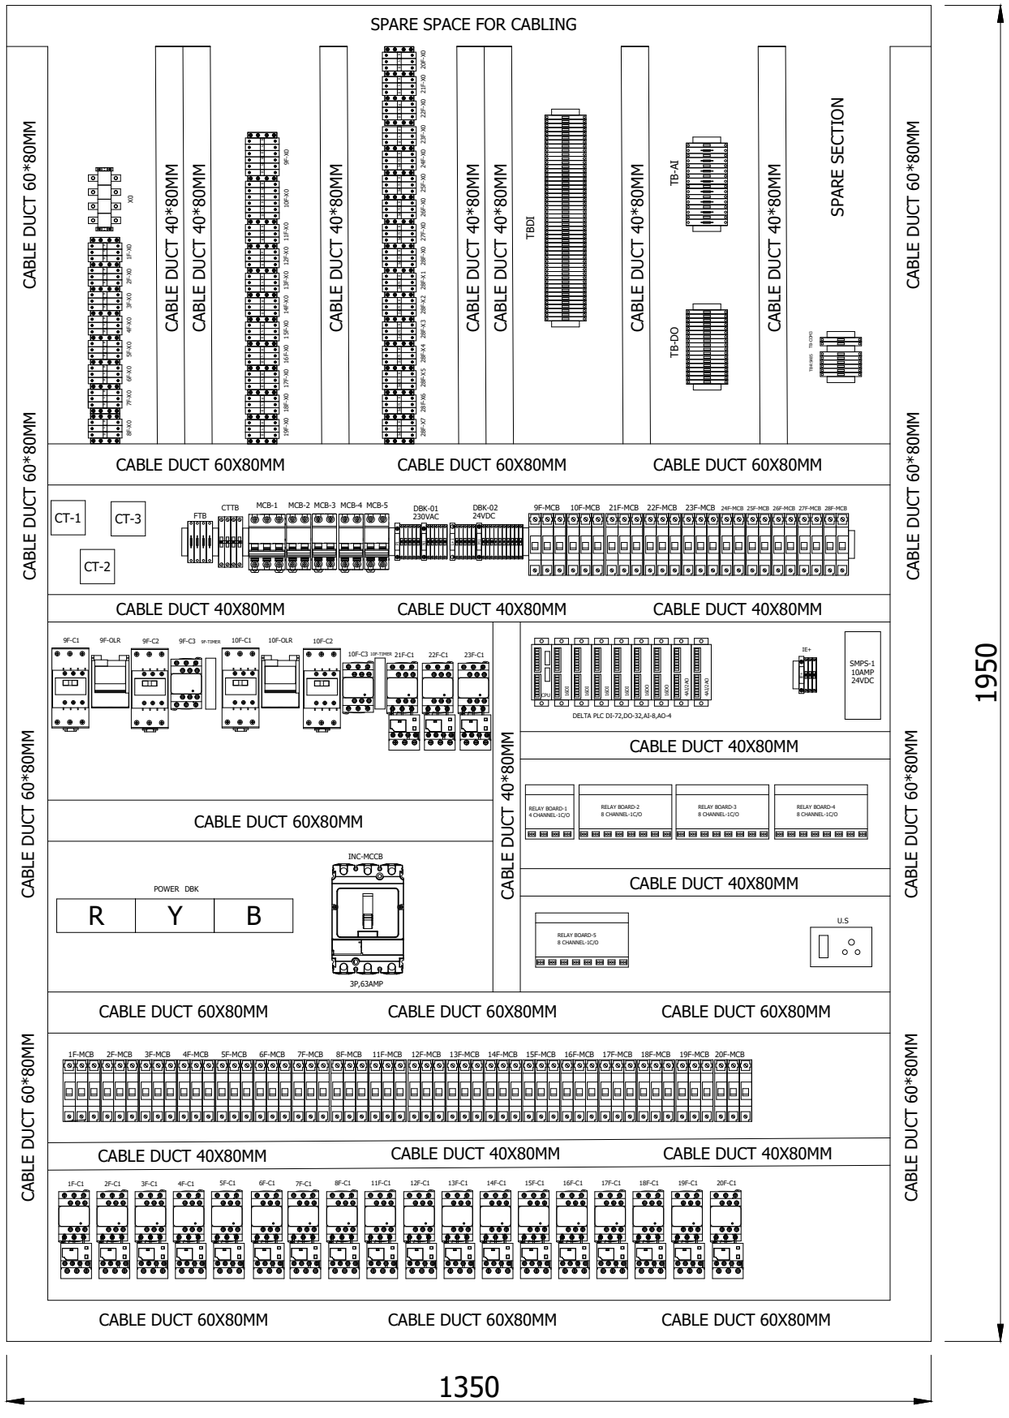


| | | | | | |
|---|---|---|---|---|---|
| **AQUACARESEE PVT. LTD.**<br>**OFFICE NO.204, 205 AND 206**<br>**VINAYAK ARCADE, 2ND FLOOR**<br>**OPP. BAJAJ AUTO, AKURDI,PUNE-411035**<br>**www.aquacaresee.co.in** | | | | TITLE:- INTERNAL GENERAL ARRANGEMENT | SYSTEM:-375 KLD MBR STP |
| | 00 | AS BUILT | 23-01-2025 | | |
| | 01 | AS PER COMMENTS | 09-12-2025 | DRAWN BY N.J. | PROJECT:- 375 KLD MBR STP PLANT CONTROL PANEL |
| | 00 | FOR APPROVAL | 04-12-2025 | CHECKED V.K. | DRG. NO.:PRG-2526-637 / SHEET NO. 6 / 47 / REV.NO. AS BUILT |
| | REVISION | DETAILS | DATE | APPROVED P.B. | |

# MCC+PLC PANEL LEGENDS DETAILS

| FEEDER NO. | FEEDER NAME | RATING | SR. NO. | CUTOUT DETAILS ( ∅ 22.5 ) |
|---|---|---|---|---|
| | | | 1 | R PHASE (RED) |
| | | | 2 | Y PHASE (YELLOW) |
| | | | 3 | B PHASE (BLUE) |
| | | | 4 | MFM METER |
| | | | 5 | LOCAL/REMOTE SW |
| 1F | OIL SKIMMER | 0.18kW | 6 | 1F-ILSW-1 START (GREEN) |
| 2F | SUMP PUMP P1 | 1.5kW | 7 | 2F-ILSW-1 START (GREEN) |
| 3F | SUMP PUMP P2 | 1.5kW | 8 | 3F-ILSW-1 START (GREEN) |
| 4F | RAW SEWAGE PUMP P1 | 2.2kW | 9 | 4F-ILSW-1 START (GREEN) |
| 5F | RAW SEWAGE PUMP P2 | 2.2kW | 10 | 5F-ILSW-1 START (GREEN) |
| 6F | ROTARY FINE DRUM SCREEN | 0.37kW | 11 | 6F-ILSW-1 START (GREEN) |
| 7F | MBR AIR BLOWER B1 | 3.7kW | 12 | 7F-ILSW-1 START (GREEN) |
| 8F | MBR AIR BLOWER B2 | 3.7kW | 13 | 8F-ILSW-1 START (GREEN) |
| 9F | AERATION AIR BLOWER PUMP B1 | 15kW | 14 | 9F-ILSW-1 START (GREEN) |
| 10F | AERATION AIR BLOWER PUMP B2 | 15kW | 15 | 10F-ILSW-1 START (GREEN) |
| 11F | MBR PERMEATE PUMP P1 | 1.5kW | 16 | 11F-ILSW-1 START (GREEN) |
| 12F | MBR PERMEATE PUMP P2 | 1.5kW | 17 | 12F-ILSW-1 START (GREEN) |
| 13F | MBR BACKWASH PUMP P1 | 3.7kW | 18 | 13F-ILSW-1 START (GREEN) |
| 14F | MBR BACKWASH PUMP P2 | 3.7kW | 19 | 14F-ILSW-1 START (GREEN) |
| 15F | SLUDGE RECIRCULATION PUMP P1 | 3.7kW | 20 | 15F-ILSW-1 START (GREEN) |

| FEEDER NO. | FEEDER NAME | RATING | SR. NO. | CUTOUT DETAILS ( ∅ 22.5 ) |
|---|---|---|---|---|
| | | | 21 | HMI |
| - | - | - | 22 | ALARM ACCEPT |
| - | - | - | 23 | EM STOP |
| 16F | SLUDGE RECIRCULATION PUMP P2 | 3.7kW | 24 | 16F-ILSW-1 START (GREEN) |
| 17F | CENTRIFUGE PUMP | 1.5kW | 25 | 17F-ILSW-1 START (GREEN) |
| 18F | POLY DOSING TANK AGITATOR | 0.37kW | 26 | 18F-ILSW-1 START (GREEN) |
| 19F | CENTRIFUGE FEED PUMP P1 | 0.75kW | 27 | 19F-ILSW-1 START (GREEN) |
| 20F | CENTRIFUGE FEED PUMP P2 | 0.75kW | 28 | 20F-ILSW-1 START (GREEN) |
| 21F | ANOXIC RECIRCULATION PUMP P1 | 2.2kW | 29 | 21F-ILSW-1 START (GREEN) |
| 22F | ANOXIC RECIRCULATION PUMP P2 | 2.2kW | 30 | 22F-ILSW-1 START (GREEN) |
| 23F | SPARE PUMP-1 | 2.2kW | 31 | 23F-ILSW-1 START (GREEN) |
| 24F | POLY DOSING PUMP | 0.1kW | 32 | 24F-ILSW-1 START (GREEN) |
| 25F | HYPO DOSING PUMP | 0.1kW | 33 | 25F-ILSW-1 START (GREEN) |
| 26F | CITRIC DOSING PUMP | 0.1kW | 34 | 26F-ILSW-1 START (GREEN) |
| 27F | AIR COMPRESSOR | 0.75kW | 35 | 27F-ILSW-1 START (GREEN) |
| - | - | - | 36 | DUMMY |
| - | - | - | 37 | DUMMY |
| | | | 38 | DUMMY |
| - | - | - | 39 | HOOTER |


**AQUACARESEE PVT. LTD.**
**OFFICE NO.204, 205 AND 206**
**VINAYAK ARCADE, 2ND FLOOR**
**OPP. BAJAJ AUTO, AKURDI,PUNE-411035**
**www.aquacaresee.co.in**


| REVISION | DETAILS | DATE |
|---|---|---|
| | | |
| 00 | AS BUILT | 23-01-2025 |
| 01 | AS PER COMMENTS | 09-12-2025 |
| 00 | FOR APPROVAL | 04-12-2025 |

TITLE:- LEGENDS DETAILS


| | |
|---|---|
| DRAWN BY | N.J. |
| CHECKED | V.K. |
| APPROVED | P.B. |

SYSTEM:-375 KLD MBR STP

PROJECT:- 375 KLD MBR STP PLANT CONTROL PANEL

DRG. NO.:PRG-2526-637 | SHEET NO. 7 / 47 | REV.NO. AS BUILT

# SINGLE LINE DIAGRAM

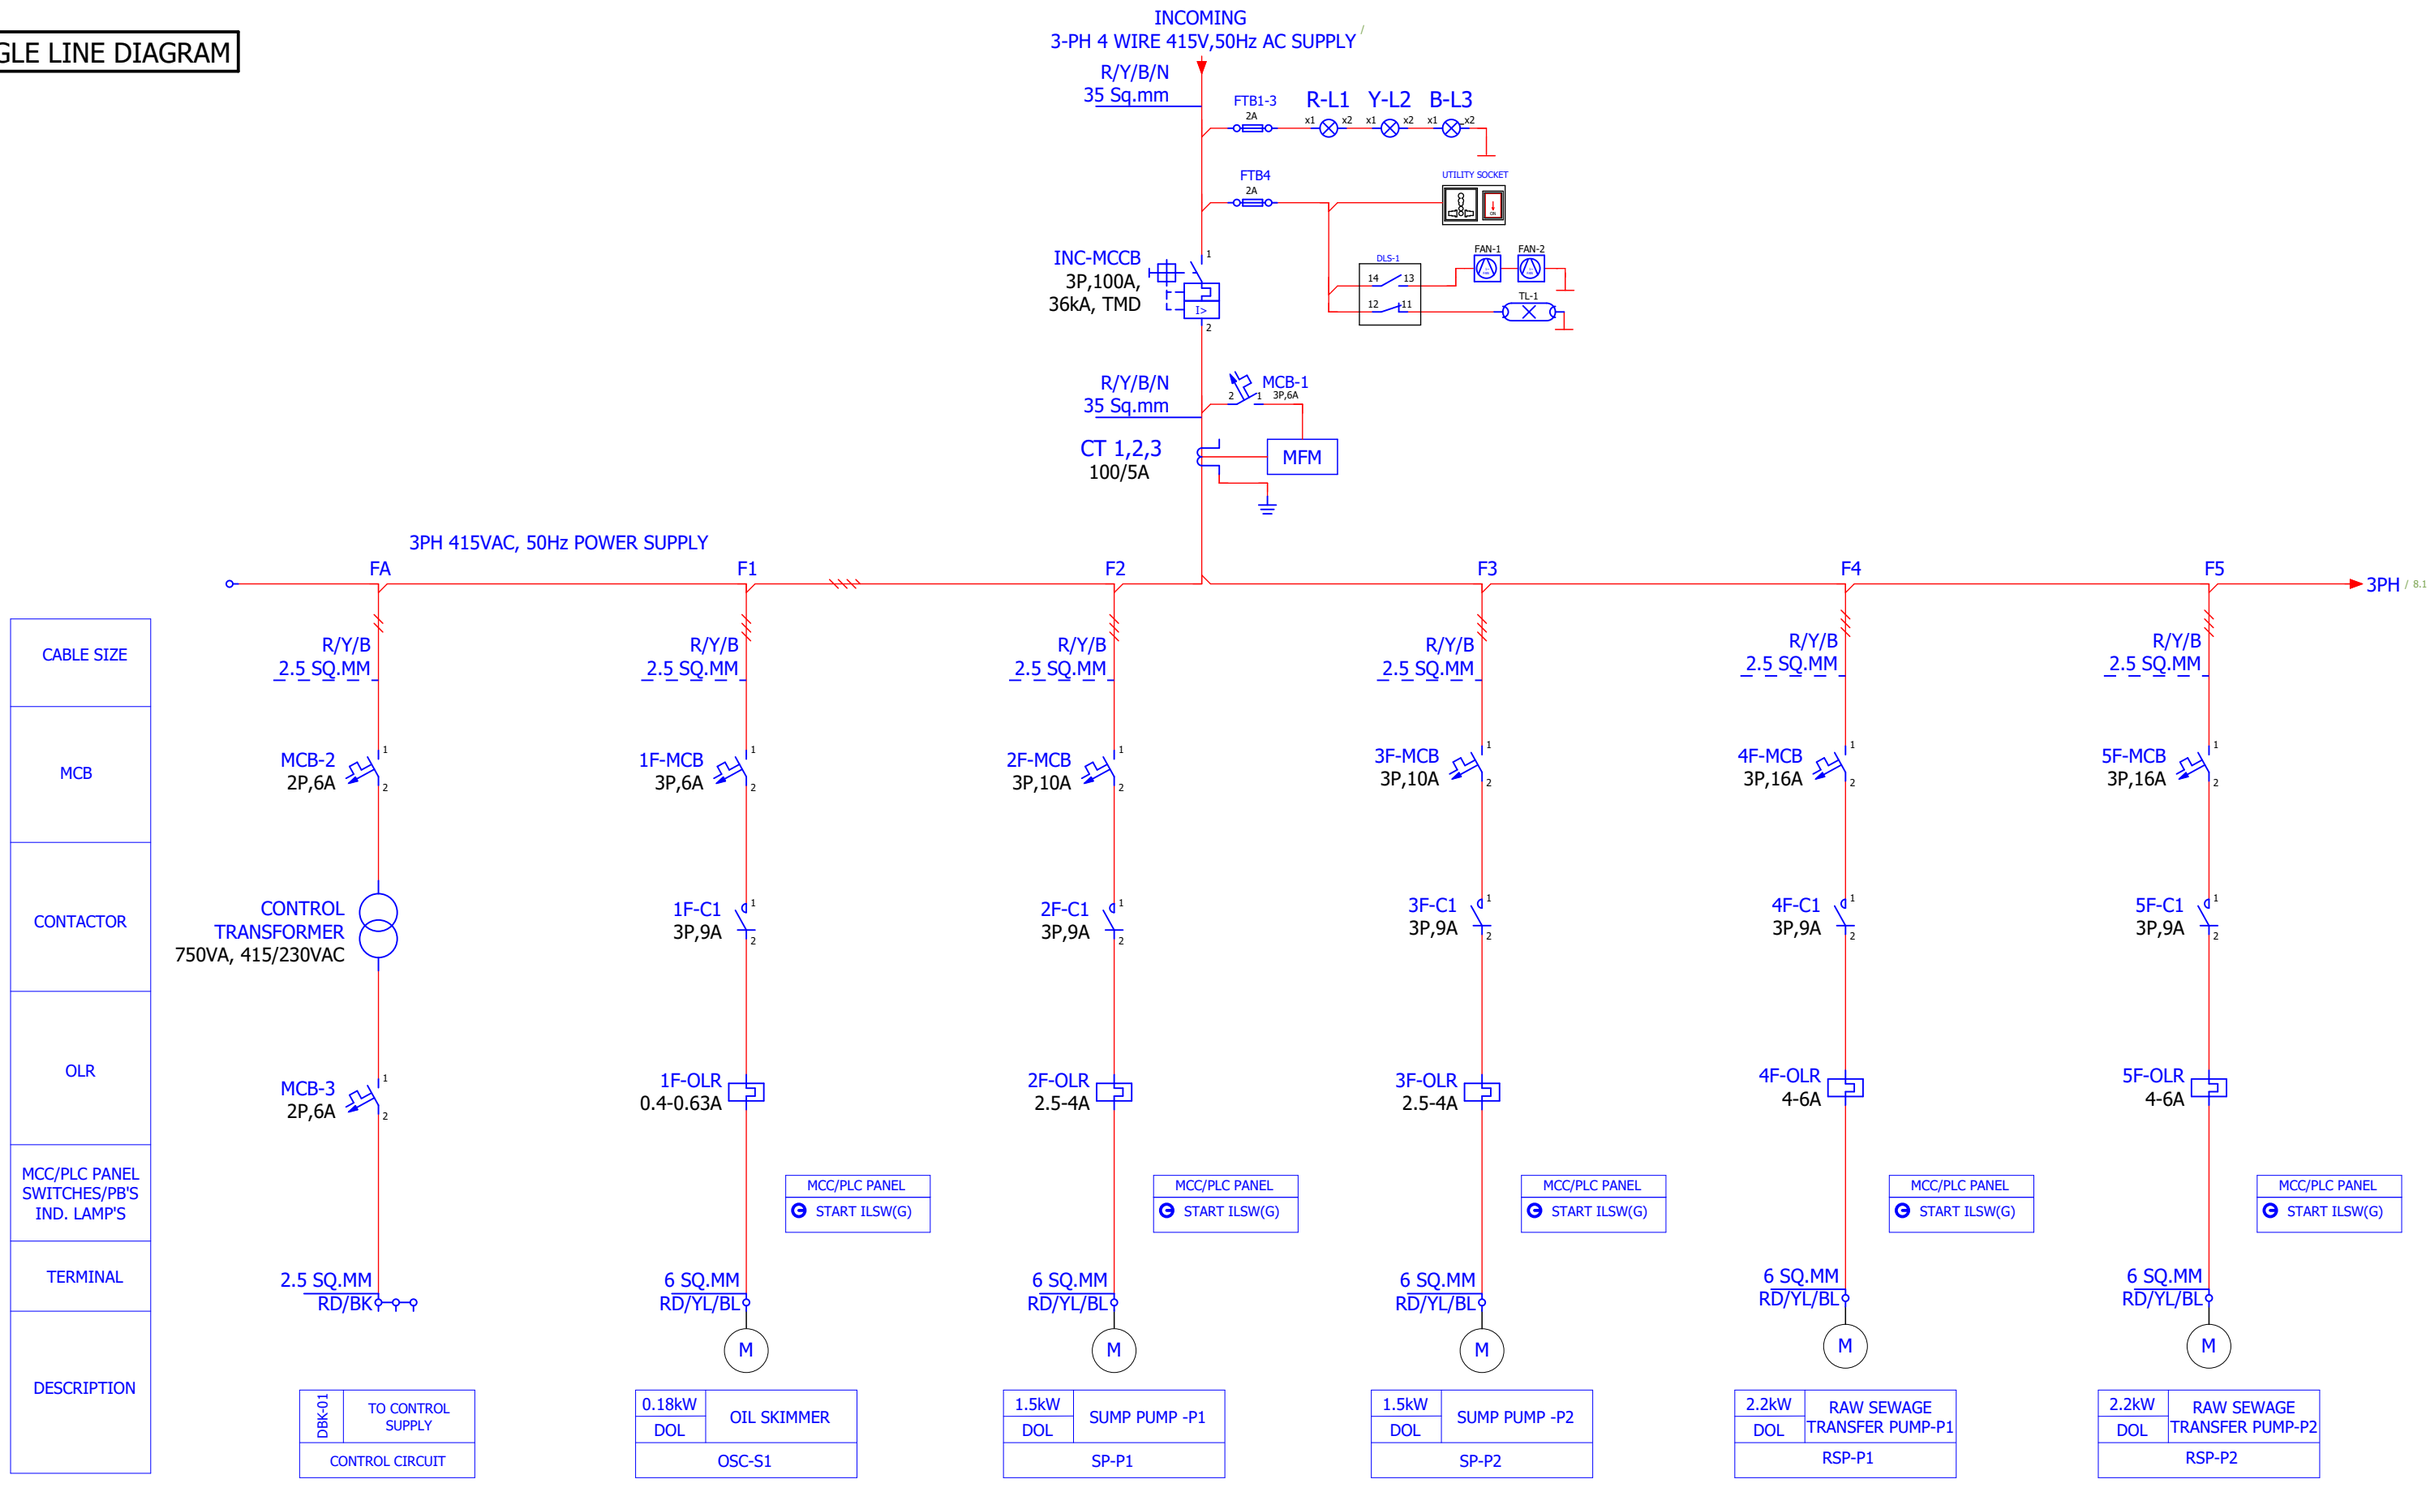



**AQUACARESEE PVT. LTD.**

**OFFICE NO.204, 205 AND 206**
**VINAYAK ARCADE, 2ND FLOOR**
**OPP. BAJAJ AUTO, AKURDI,PUNE-411035**
**www.aquacaresee.co.in**


| REVISION | DETAILS | DATE |
|---|---|---|
| 00 | AS BUILT | 23-01-2025 |
| 01 | AS PER COMMENTS | 09-12-2025 |
| 00 | FOR APPROVAL | 04-12-2025 |

| | |
|---|---|
| DRAWN BY | N.J. |
| CHECKED | V.K. |
| APPROVED | P.B. |


TITLE:- SINGLE LINE DIAGRAM

SYSTEM:-375 KLD MBR STP

PROJECT:- 375 KLD MBR STP PLANT CONTROL PANEL

DRG. NO.:PRG-2526-637 | SHEET NO. 8 / 47 | REV.NO. AS BUILT

# SINGLE LINE DIAGRAM

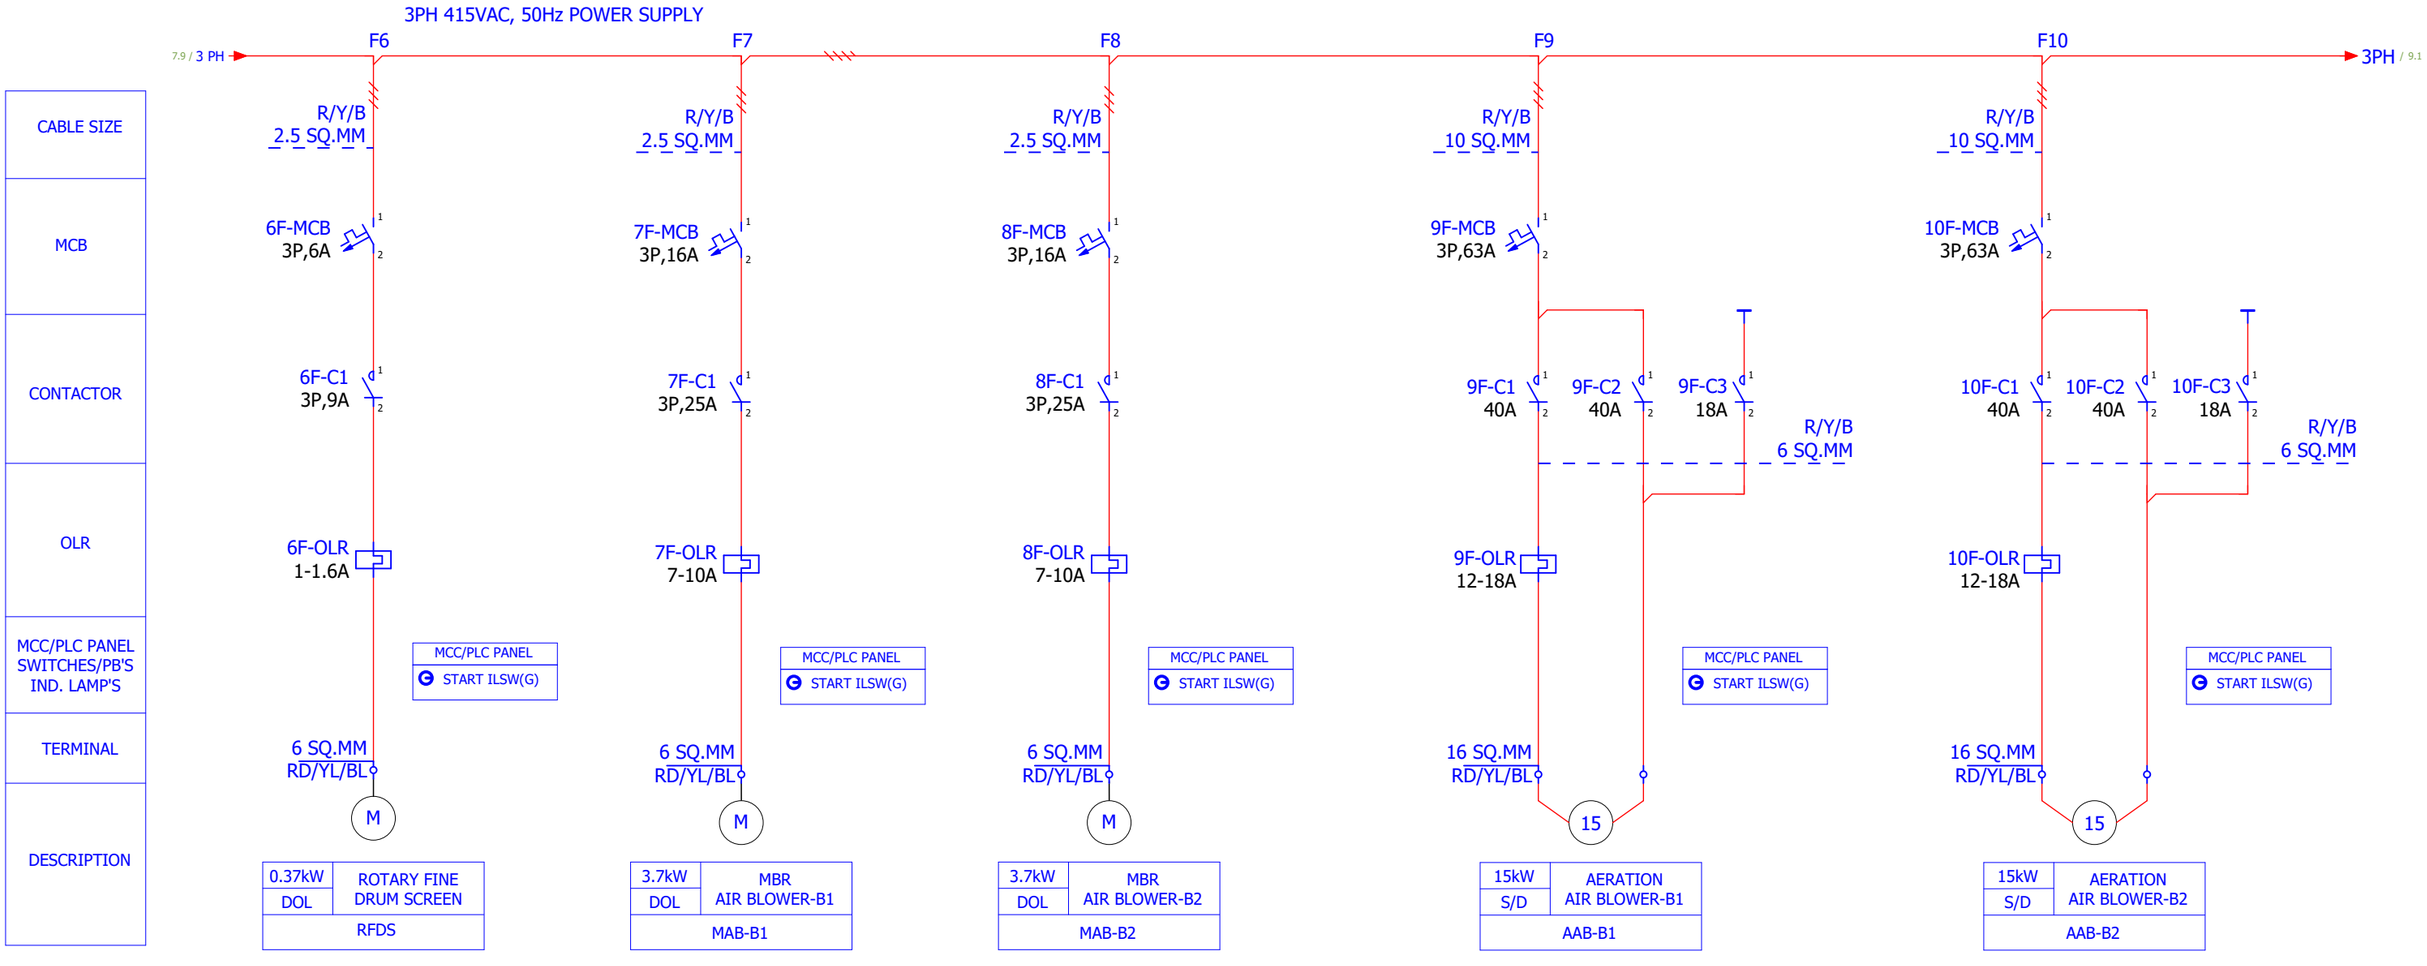


**AQUACARESEE PVT. LTD.**
**OFFICE NO.204, 205 AND 206**
**VINAYAK ARCADE, 2ND FLOOR**
**OPP. BAJAJ AUTO, AKURDI,PUNE-411035**
**www.aquacaresee.co.in**

| REVISION | DETAILS | DATE |
|---|---|---|
| 00 | AS BUILT | 23-01-2025 |
| 01 | AS PER COMMENTS | 09-12-2025 |
| 00 | FOR APPROVAL | 04-12-2025 |

| | |
|---|---|
| DRAWN BY | N.J. |
| CHECKED | V.K. |
| APPROVED | P.B. |


TITLE:- SINGLE LINE DIAGRAM

SYSTEM:-375 KLD MBR STP

PROJECT:- 375 KLD MBR STP PLANT CONTROL PANEL

DRG. NO.:PRG-2526-637 | SHEET NO. 9 / 47 | REV.NO. AS BUILT

# SINGLE LINE DIAGRAM

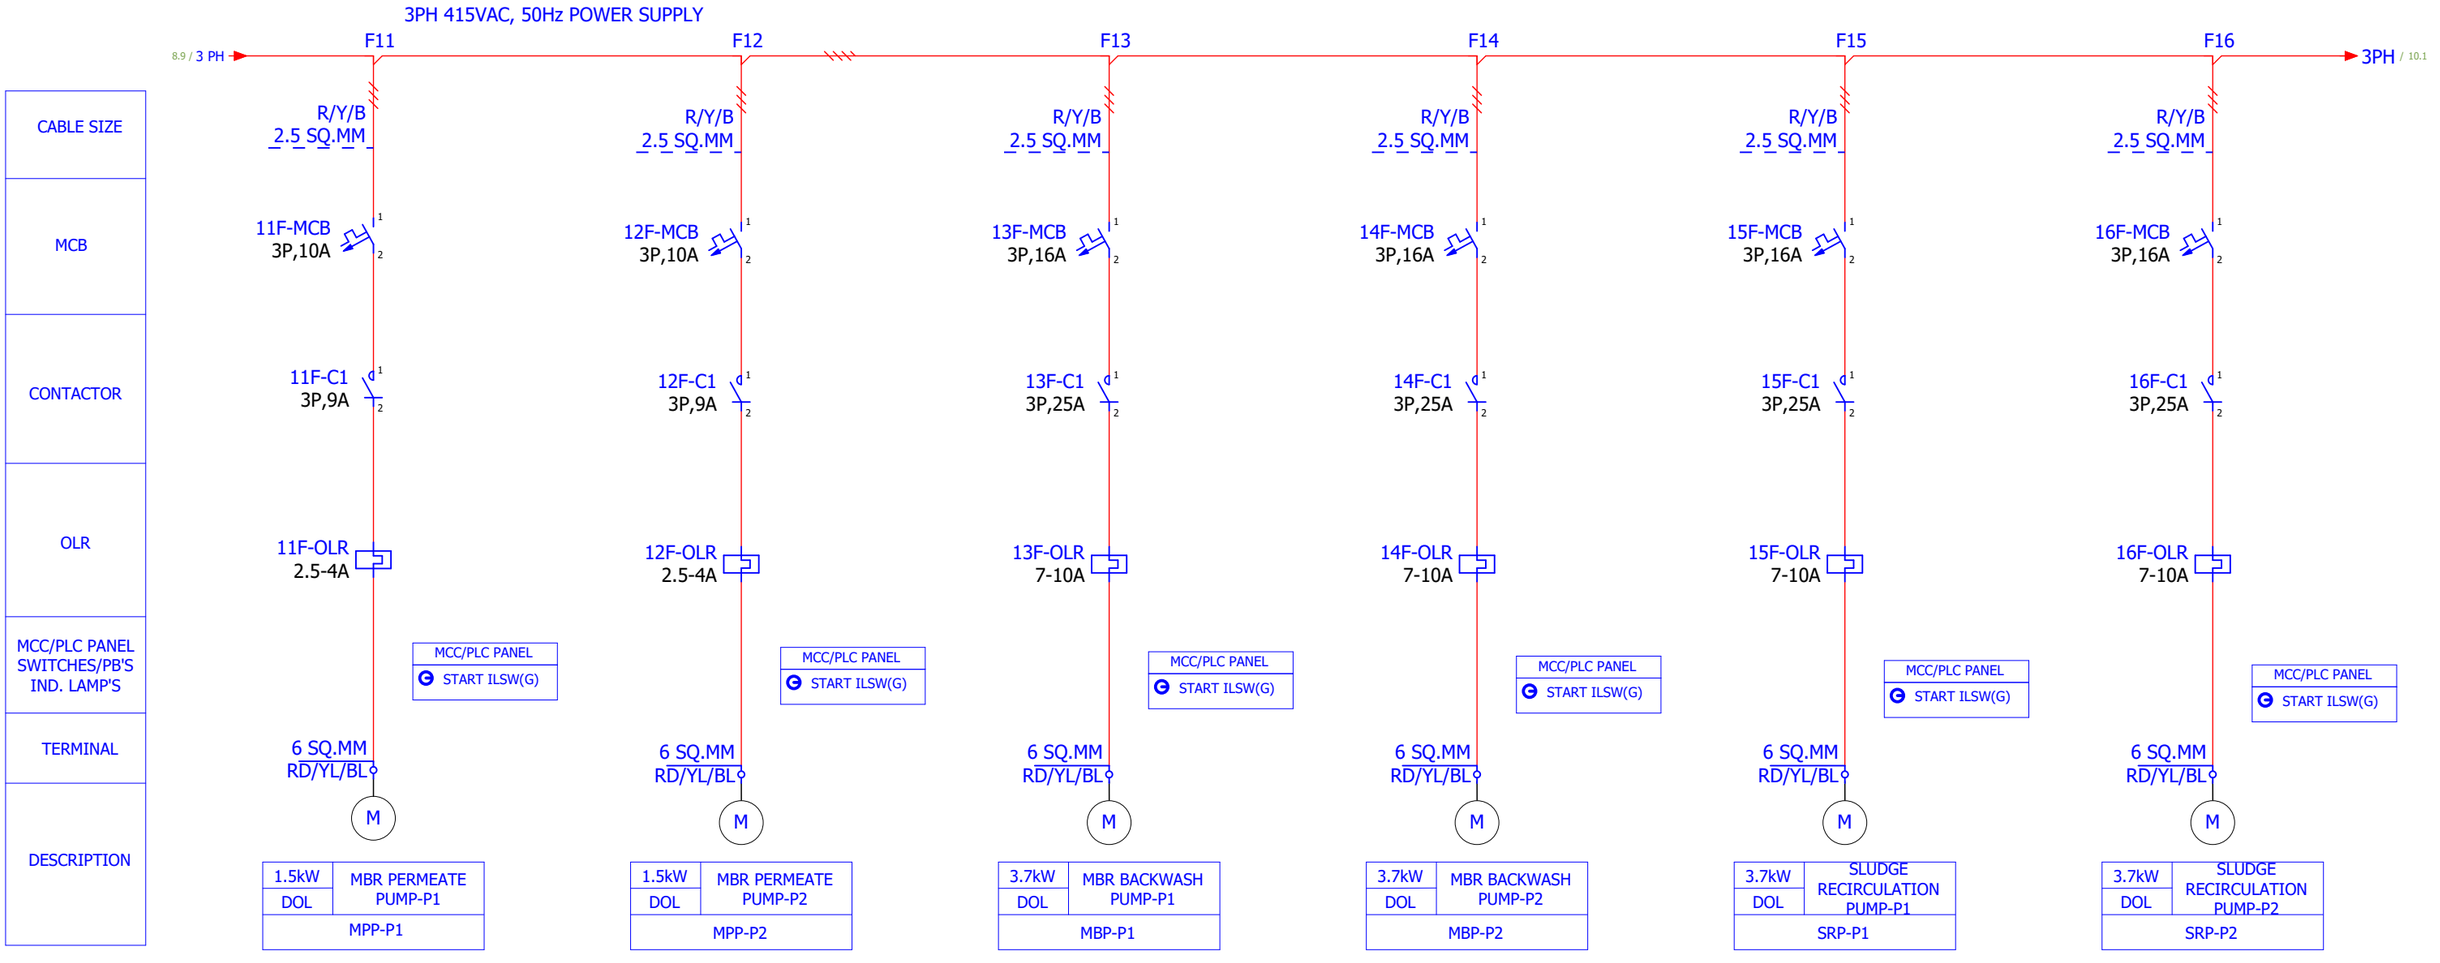


**AQUACARESEE PVT. LTD.**
**OFFICE NO.204, 205 AND 206**
**VINAYAK ARCADE, 2ND FLOOR**
**OPP. BAJAJ AUTO, AKURDI,PUNE-411035**
**www.aquacaresee.co.in**

| REVISION | DETAILS | DATE |
|---|---|---|
| 00 | AS BUILT | 23-01-2025 |
| 01 | AS PER COMMENTS | 09-12-2025 |
| 00 | FOR APPROVAL | 04-12-2025 |


| | |
|---|---|
| DRAWN BY | N.J. |
| CHECKED | V.K. |
| APPROVED | P.B. |

TITLE:- SINGLE LINE DIAGRAM

SYSTEM:-375 KLD MBR STP

PROJECT:- 375 KLD MBR STP PLANT CONTROL PANEL

DRG. NO.:PRG-2526-637 | SHEET NO. 10 / 47 | REV.NO. AS BUILT

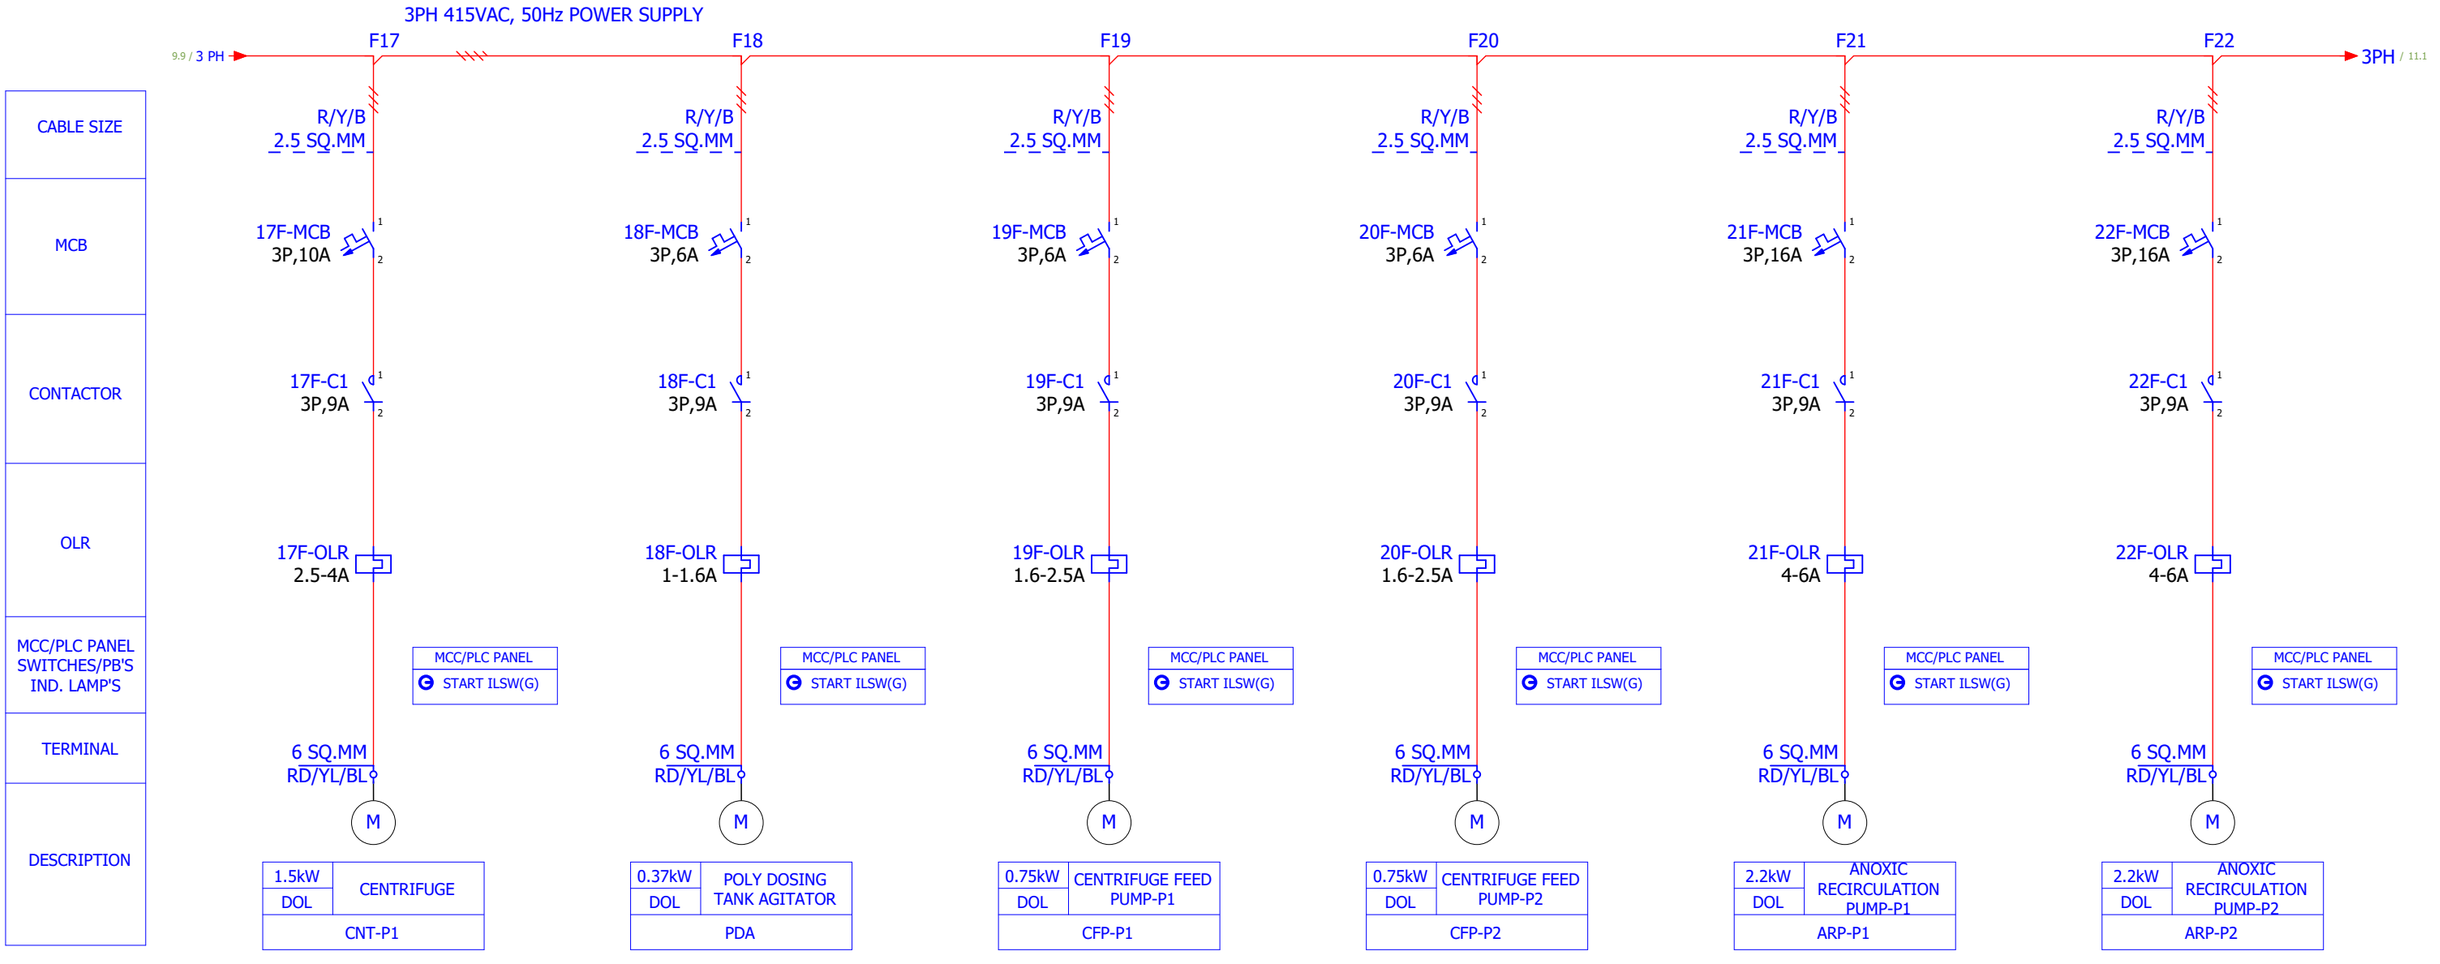


**AQUACARESEE PVT. LTD.**
**OFFICE NO.204, 205 AND 206**
**VINAYAK ARCADE, 2ND FLOOR**
**OPP. BAJAJ AUTO, AKURDI,PUNE-411035**
**www.aquacaresee.co.in**

| REVISION | DETAILS | DATE |
|---|---|---|
| 00 | AS BUILT | 23-01-2025 |
| 01 | AS PER COMMENTS | 09-12-2025 |
| 00 | FOR APPROVAL | 04-12-2025 |


| | |
|---|---|
| DRAWN BY | N.J. |
| CHECKED | V.K. |
| APPROVED | P.B. |

TITLE:- SINGLE LINE DIAGRAM

SYSTEM:-375 KLD MBR STP

PROJECT:- 375 KLD MBR STP PLANT CONTROL PANEL

DRG. NO.:PRG-2526-637 | SHEET NO. 11 / 47 | REV.NO. AS BUILT

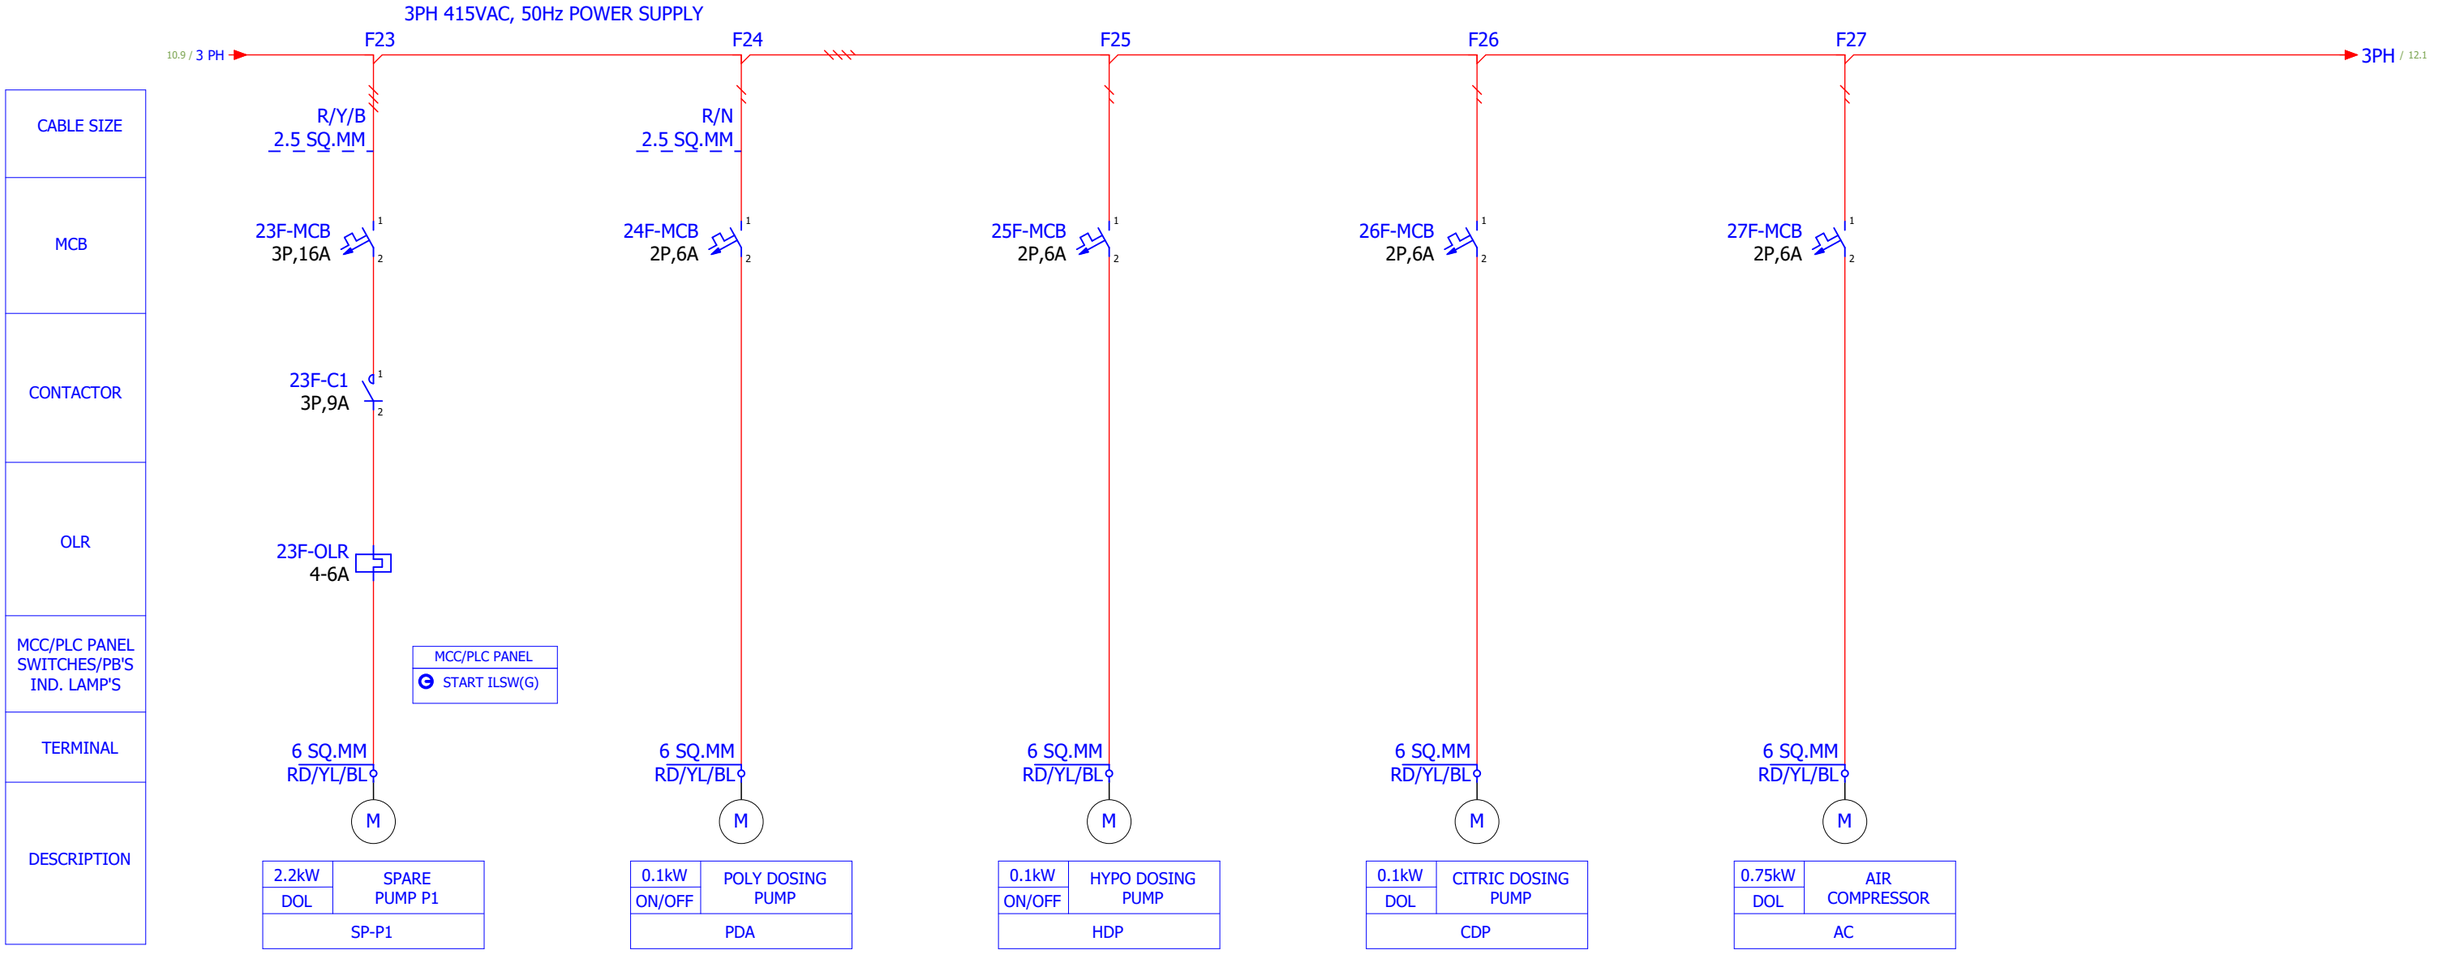


**AQUACARESEE PVT. LTD.**
**OFFICE NO.204, 205 AND 206**
**VINAYAK ARCADE, 2ND FLOOR**
**OPP. BAJAJ AUTO, AKURDI,PUNE-411035**
**www.aquacaresee.co.in**

| REVISION | DETAILS | DATE |
|---|---|---|
| 00 | AS BUILT | 23-01-2025 |
| 01 | AS PER COMMENTS | 09-12-2025 |
| 00 | FOR APPROVAL | 04-12-2025 |


| | |
|---|---|
| DRAWN BY | N.J. |
| CHECKED | V.K. |
| APPROVED | P.B. |

TITLE:- SINGLE LINE DIAGRAM

SYSTEM:-375 KLD MBR STP

PROJECT:- 375 KLD MBR STP PLANT CONTROL PANEL

DRG. NO.:PRG-2526-637 | SHEET NO. 12 / 47 | REV.NO. AS BUILT

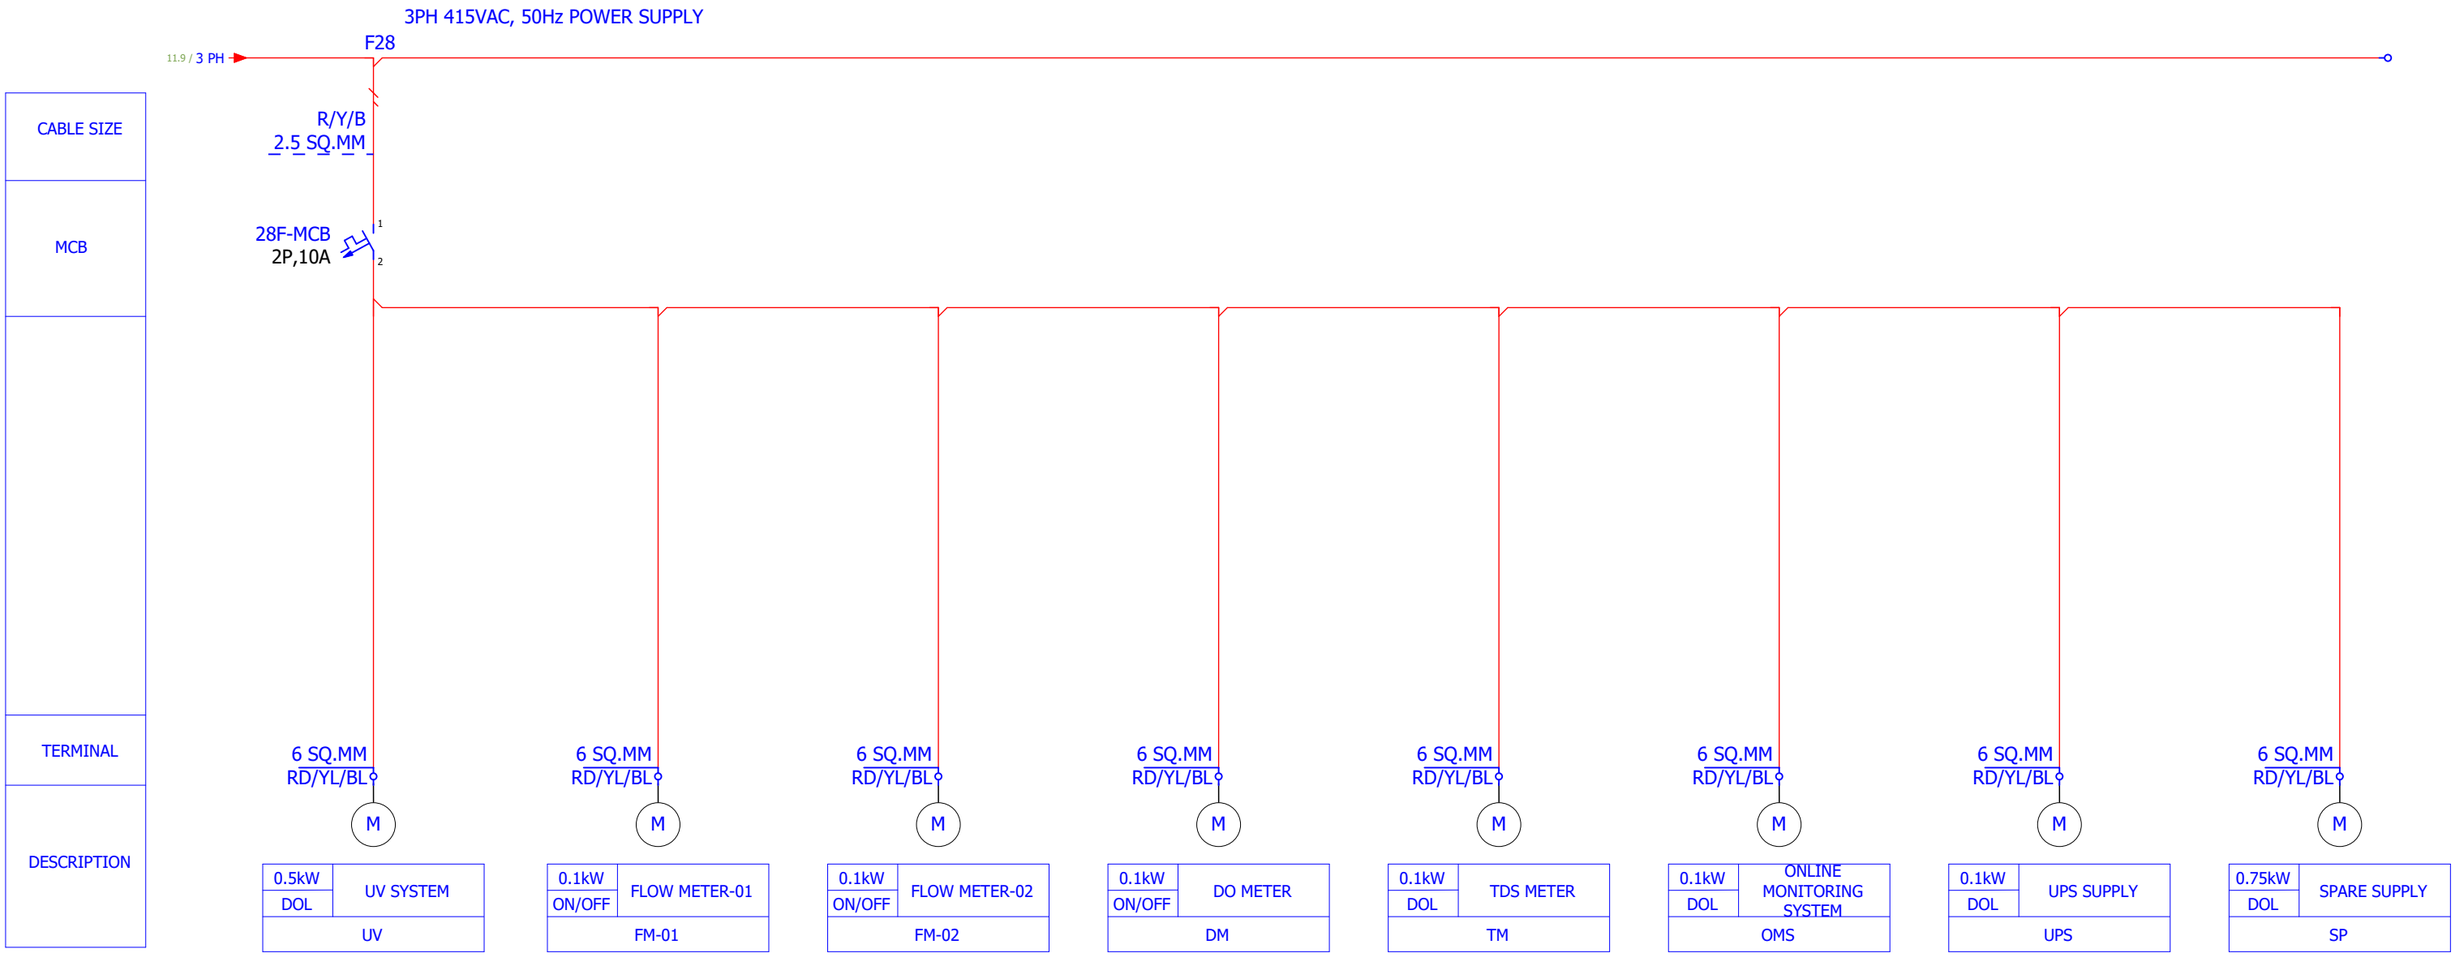


**AQUACARESEE PVT. LTD.**
**OFFICE NO.204, 205 AND 206**
**VINAYAK ARCADE, 2ND FLOOR**
**OPP. BAJAJ AUTO, AKURDI,PUNE-411035**
**www.aquacaresee.co.in**

| REVISION | DETAILS | DATE |
|---|---|---|
| 00 | AS BUILT | 23-01-2025 |
| 01 | AS PER COMMENTS | 09-12-2025 |
| 00 | FOR APPROVAL | 04-12-2025 |


TITLE:- SINGLE LINE DIAGRAM

| | |
|---|---|
| DRAWN BY | N.J. |
| CHECKED | V.K. |
| APPROVED | P.B. |


SYSTEM:-375 KLD MBR STP

PROJECT:- 375 KLD MBR STP PLANT CONTROL PANEL


DRG. NO.:PRG-2526-637 | SHEET NO. 13 / 47 | REV.NO. AS BUILT

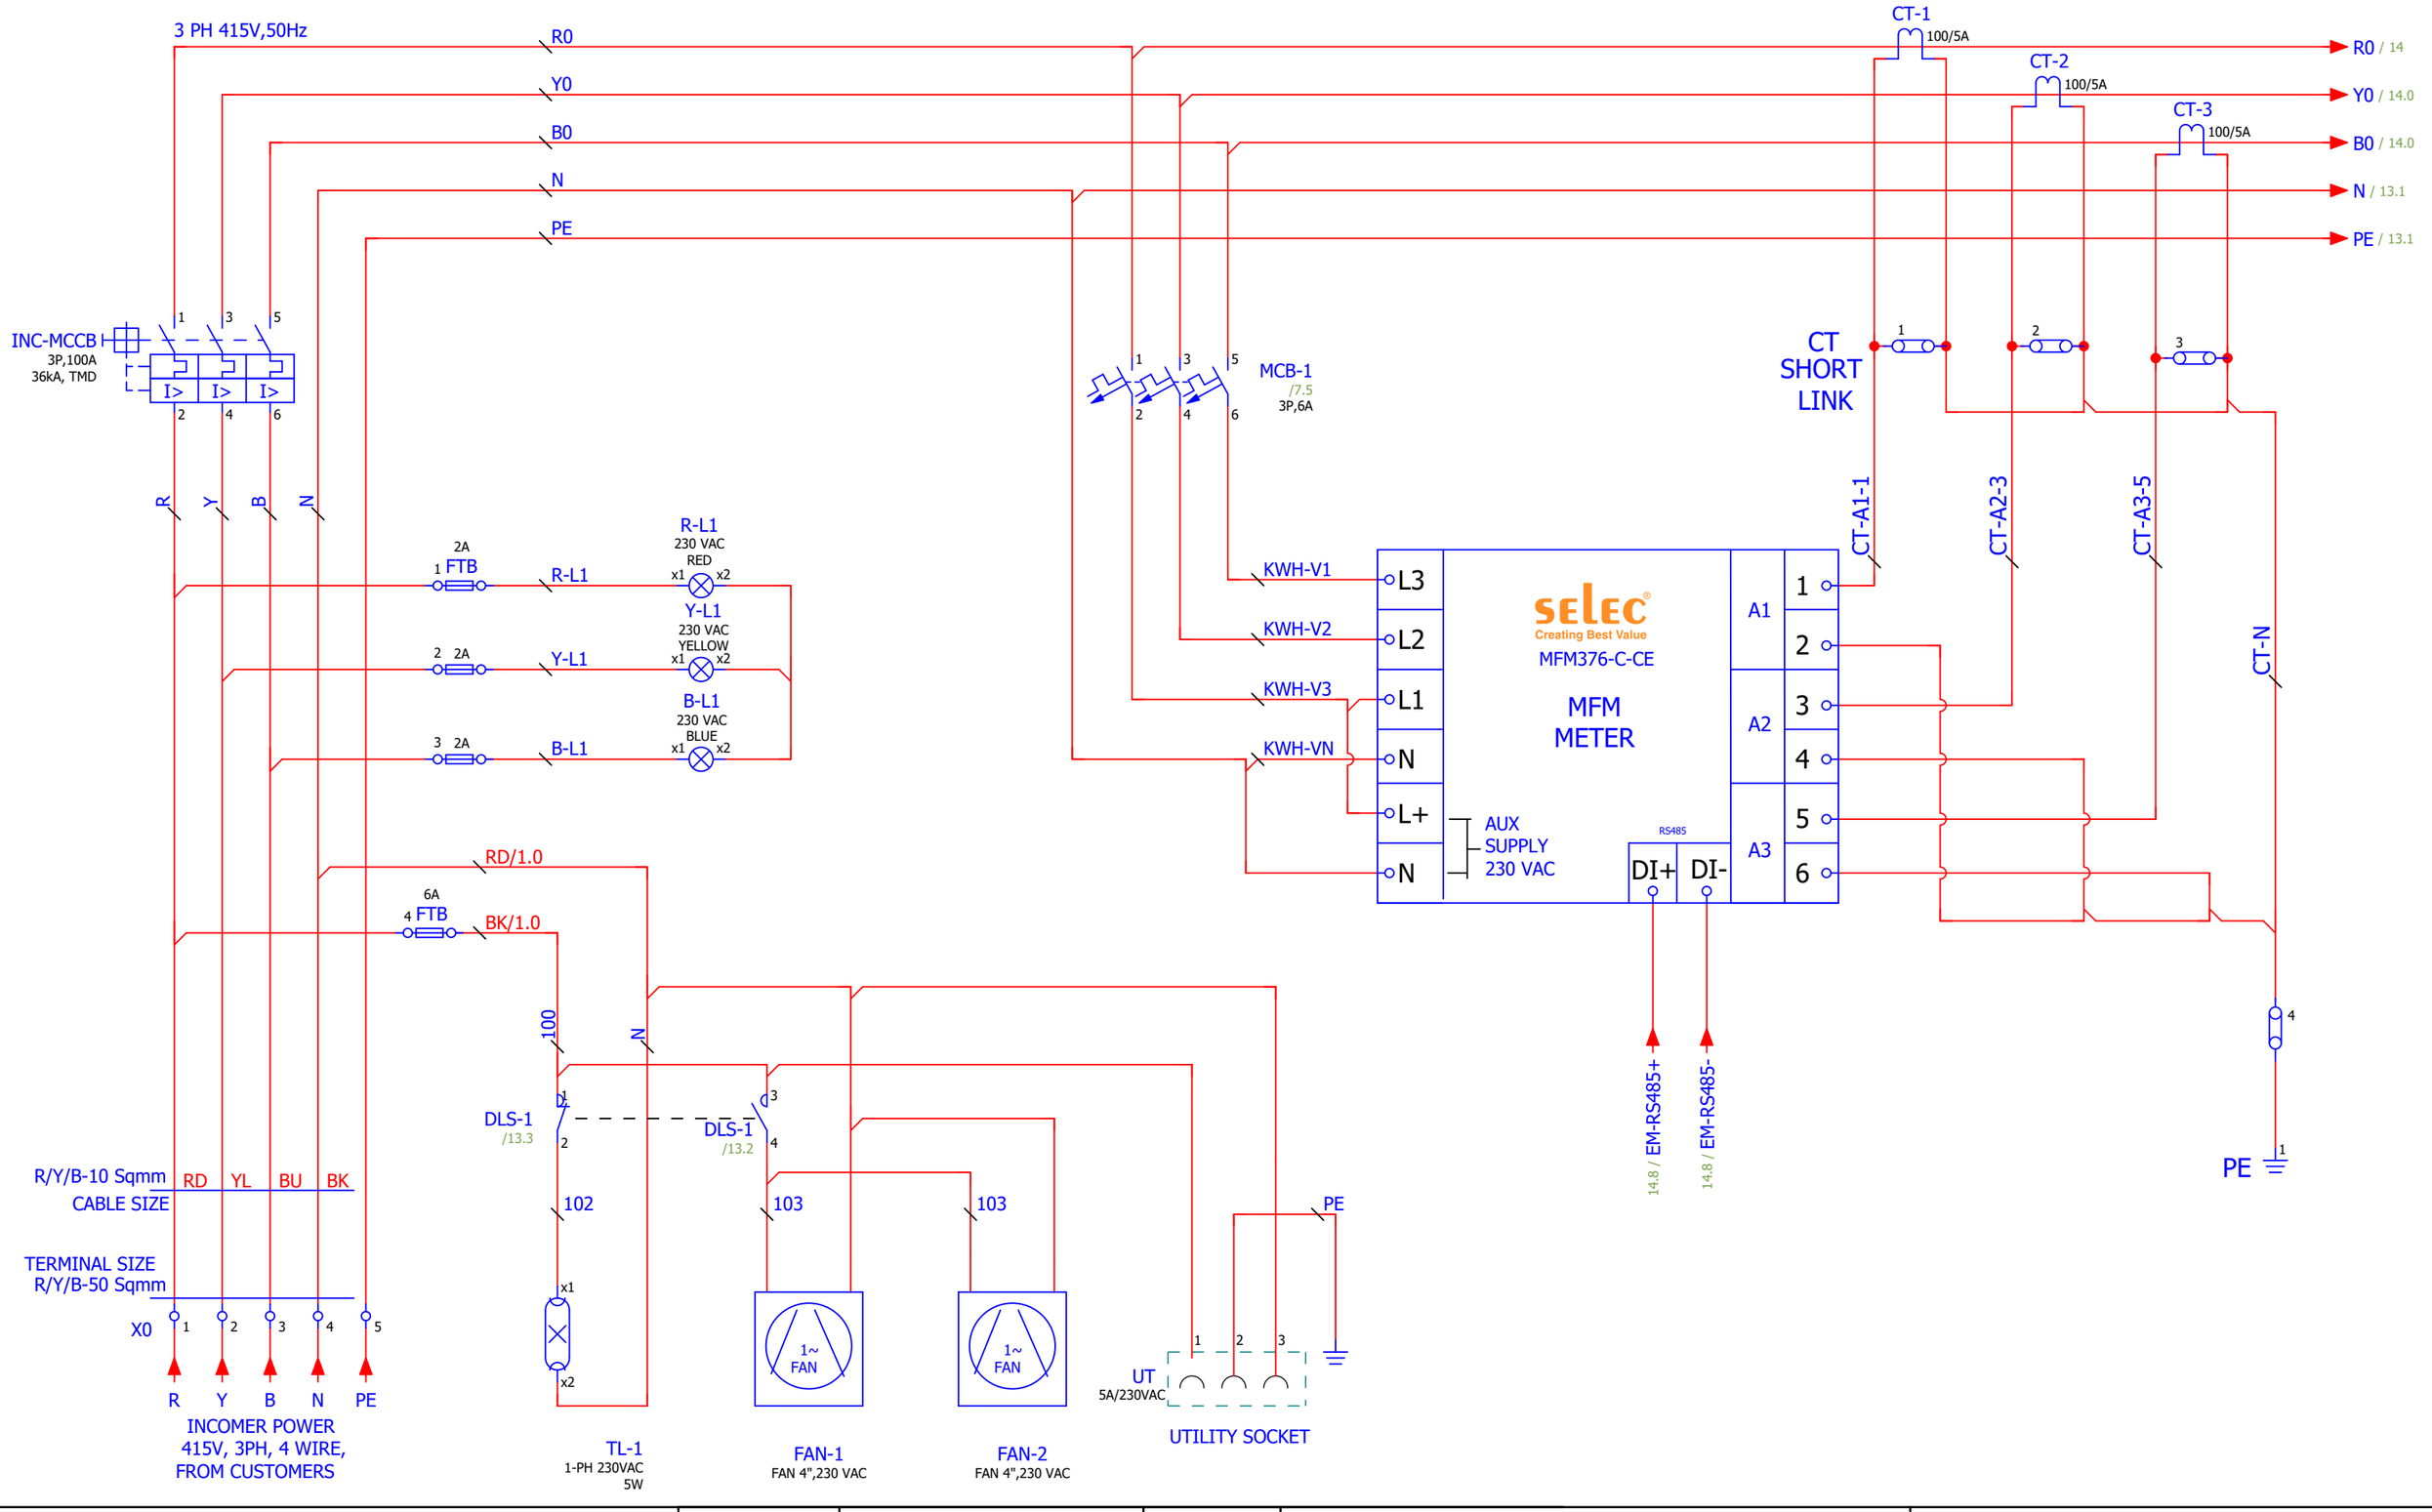



| | | | | | |
|---|---|---|---|---|---|
| **AQUACARESEE PVT. LTD.**<br>**OFFICE NO.204, 205 AND 206**<br>**VINAYAK ARCADE, 2ND FLOOR**<br>**OPP. BAJAJ AUTO, AKURDI,PUNE-411035**<br>**www.aquacaresee.co.in** | | | | TITLE:- INCOMER WIRING | SYSTEM:-375 KLD MBR STP |
| | 00 | AS BUILT | 23-01-2025 | | PROJECT:- 375 KLD MBR STP PLANT CONTROL PANEL |
| | 01 | AS PER COMMENTS | 09-12-2025 | DRAWN BY N.J. | DRG. NO.:PRG-2526-637 / SHEET NO. 14 / 47 / REV.NO. AS BUILT |
| | 00 | FOR APPROVAL | 04-12-2025 | CHECKED V.K. | |
| | REVISION | DETAILS | DATE | APPROVED P.B. | |

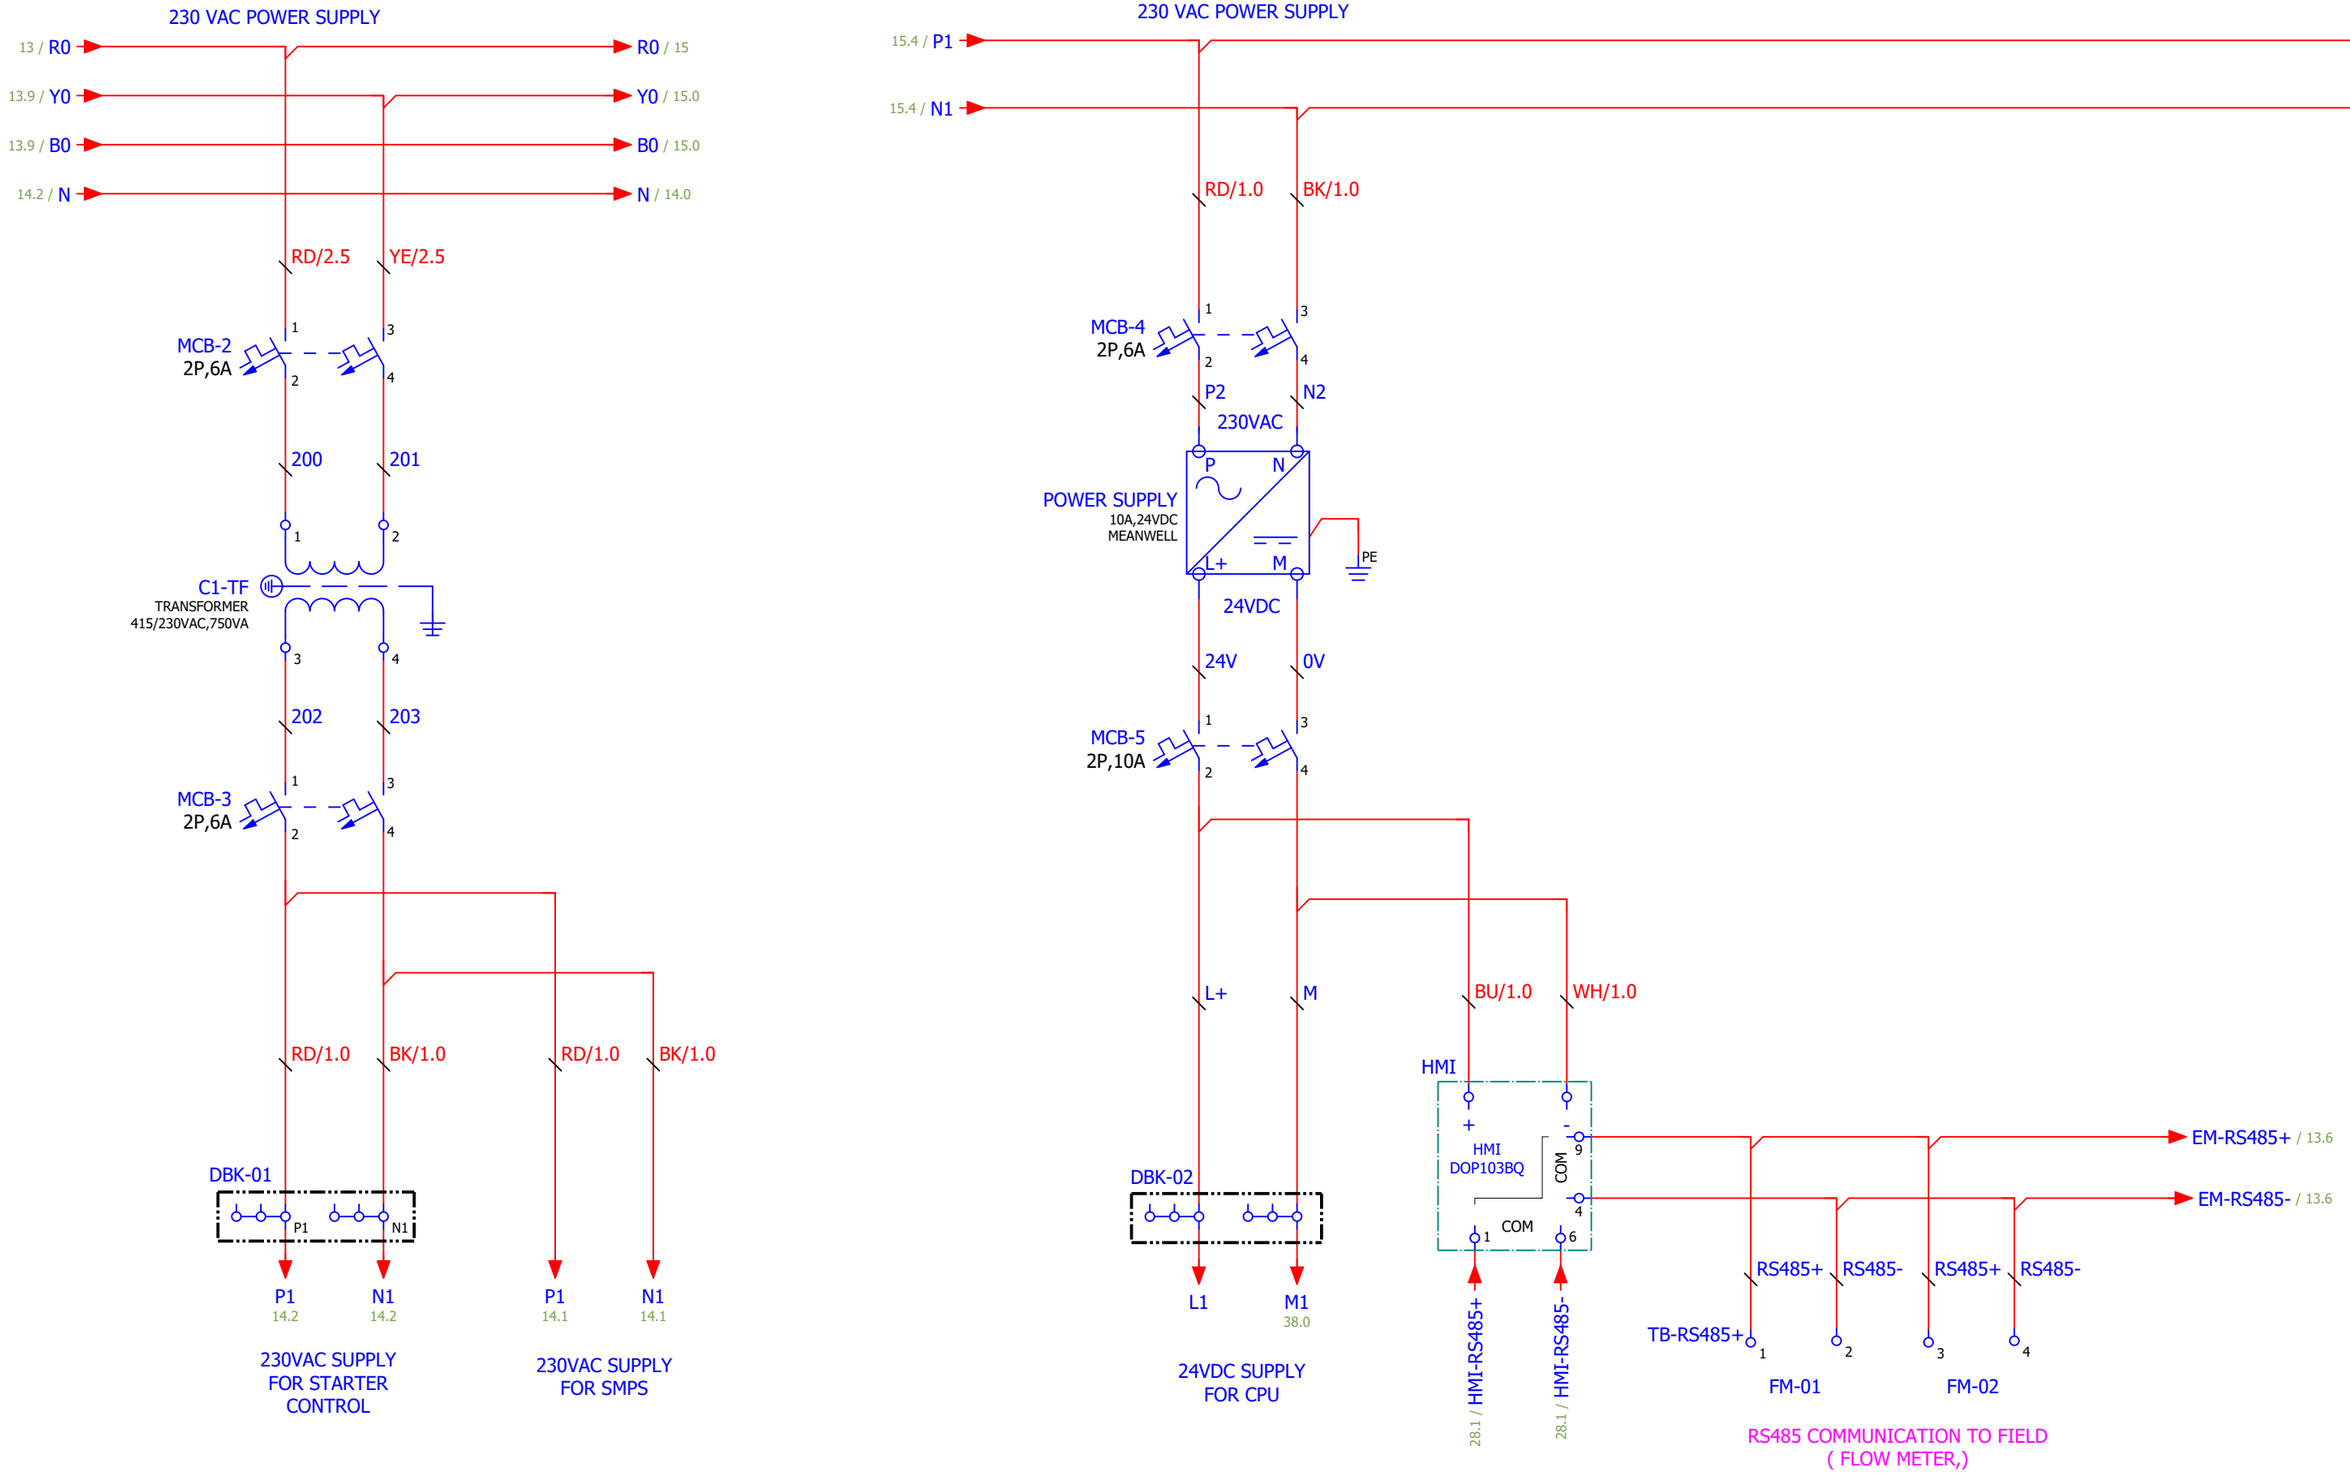


| | | | | | |
|---|---|---|---|---|---|
| **AQUACARESEE PVT. LTD.**<br>**OFFICE NO.204, 205 AND 206**<br>**VINAYAK ARCADE, 2ND FLOOR**<br>**OPP. BAJAJ AUTO, AKURDI,PUNE-411035**<br>**www.aquacaresee.co.in** | | | | TITLE:- 230VAC & 24VDC DISTRIBUTION | SYSTEM:-375 KLD MBR STP |
| | 00 | AS BUILT | 23-01-2025 | | PROJECT:- 375 KLD MBR STP PLANT CONTROL PANEL |
| | 01 | AS PER COMMENTS | 09-12-2025 | DRAWN BY N.J. | |
| | 00 | FOR APPROVAL | 04-12-2025 | CHECKED V.K. | DRG. NO.:PRG-2526-637 / SHEET NO. 15 / 47 / REV.NO. AS BUILT |
| | REVISION | DETAILS | DATE | APPROVED P.B. | |

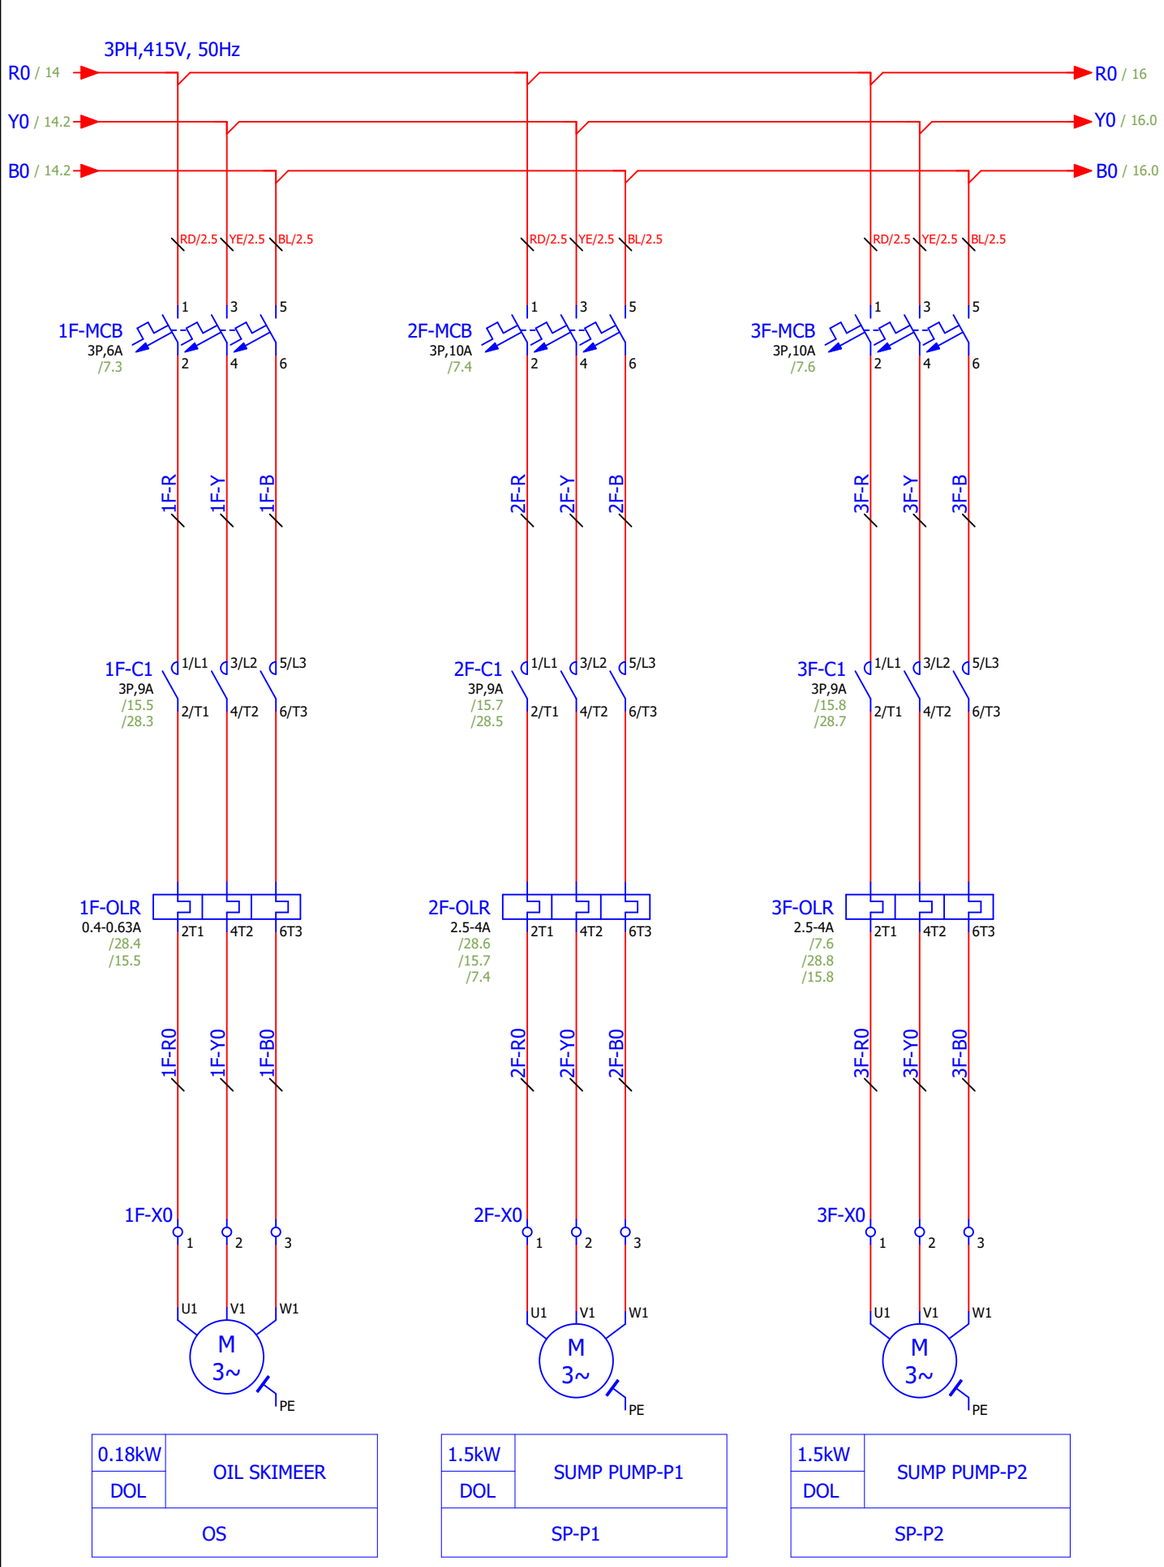

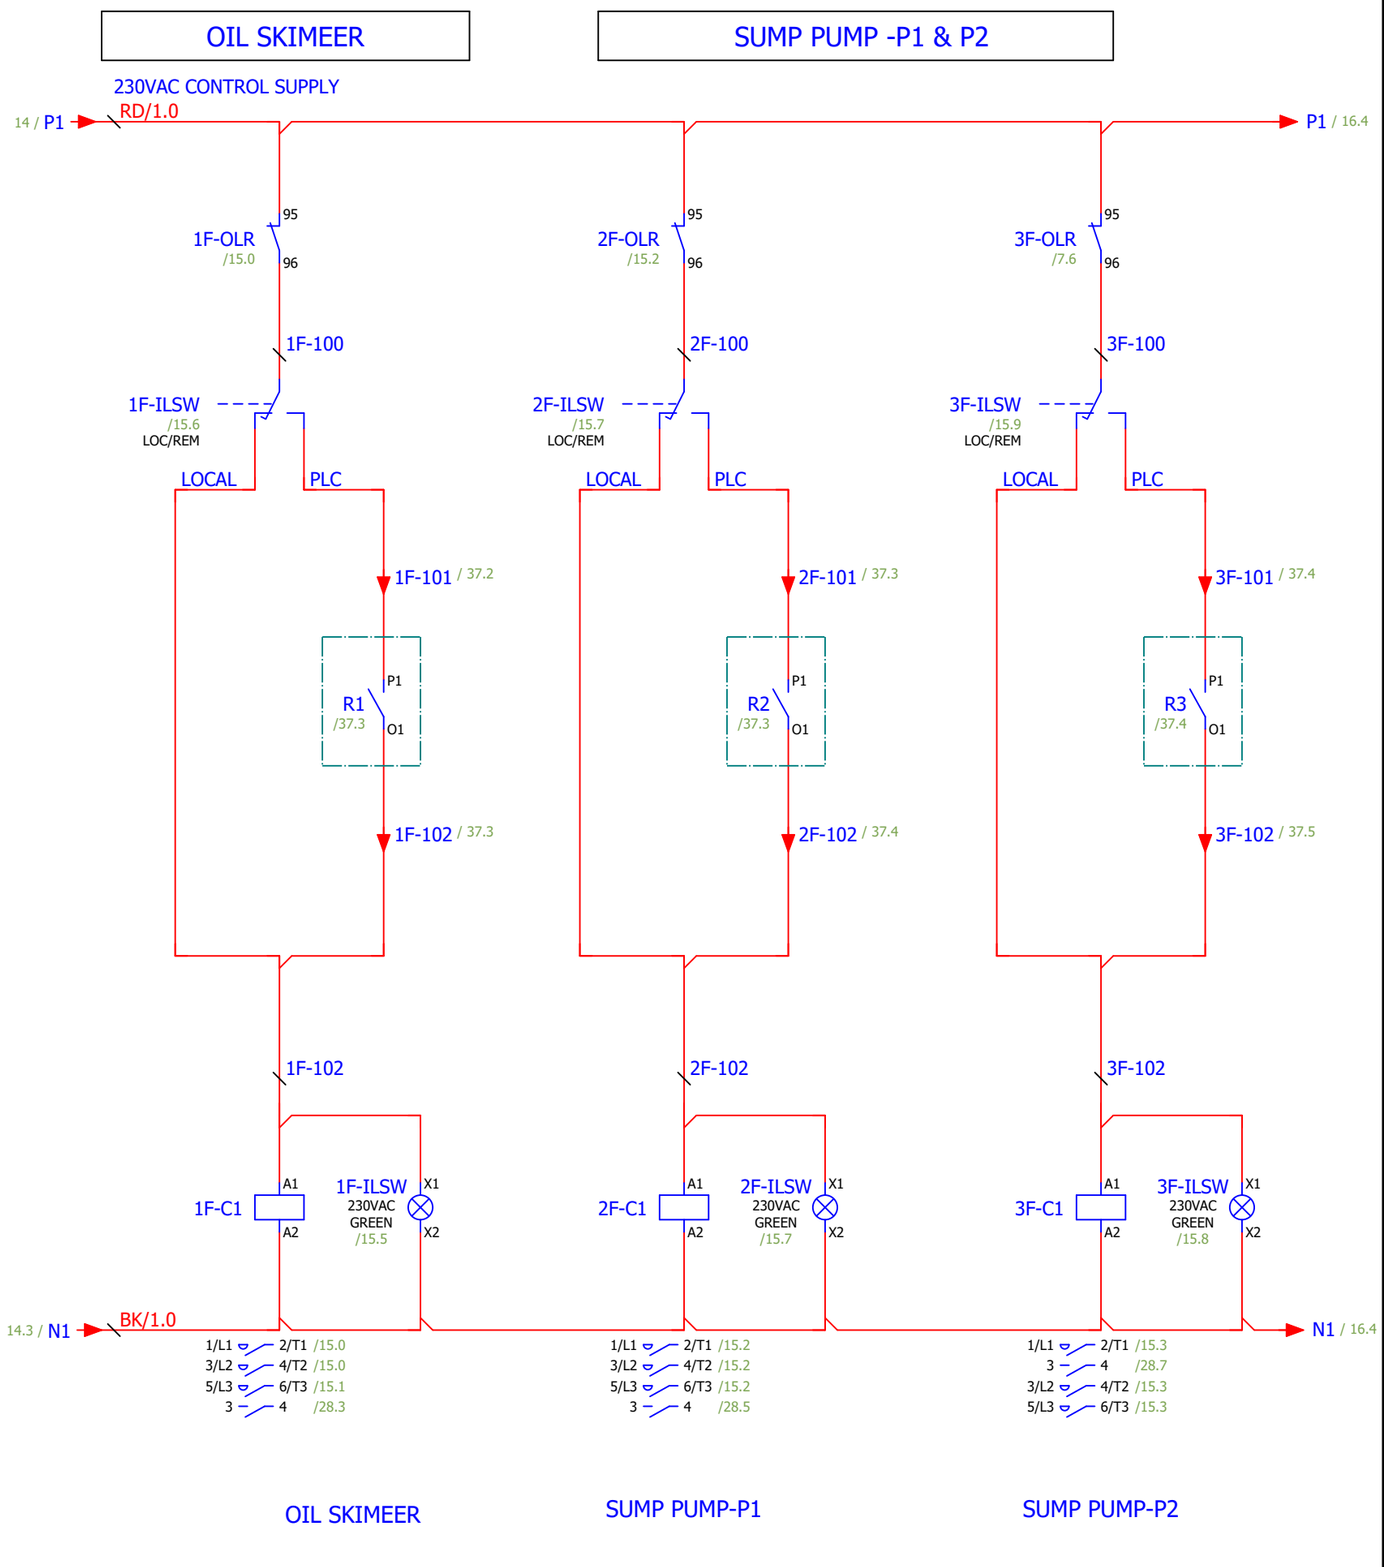
**AQUACARESEE PVT. LTD.**
**OFFICE NO.204, 205 AND 206**
**VINAYAK ARCADE, 2ND FLOOR**
**OPP. BAJAJ AUTO, AKURDI,PUNE-411035**
**www.aquacaresee.co.in**

| REVISION | DETAILS | DATE |
|---|---|---|
| 00 | AS BUILT | 23-01-2025 |
| 01 | AS PER COMMENTS | 09-12-2025 |
| 00 | FOR APPROVAL | 04-12-2025 |


TITLE:- OIL SKIMEER PUMP-P1 & SUMP PUMP-P1 & P2 POWER & CONTROL WIRING (1F ,2F & 3F)


| | |
|---|---|
| DRAWN BY | N.J. |
| CHECKED | V.K. |
| APPROVED | P.B. |

SYSTEM:-375 KLD MBR STP

PROJECT:- 375 KLD MBR STP PLANT CONTROL PANEL

DRG. NO.:PRG-2526-637 | SHEET NO. 16 / 47 | REV.NO. AS BUILT

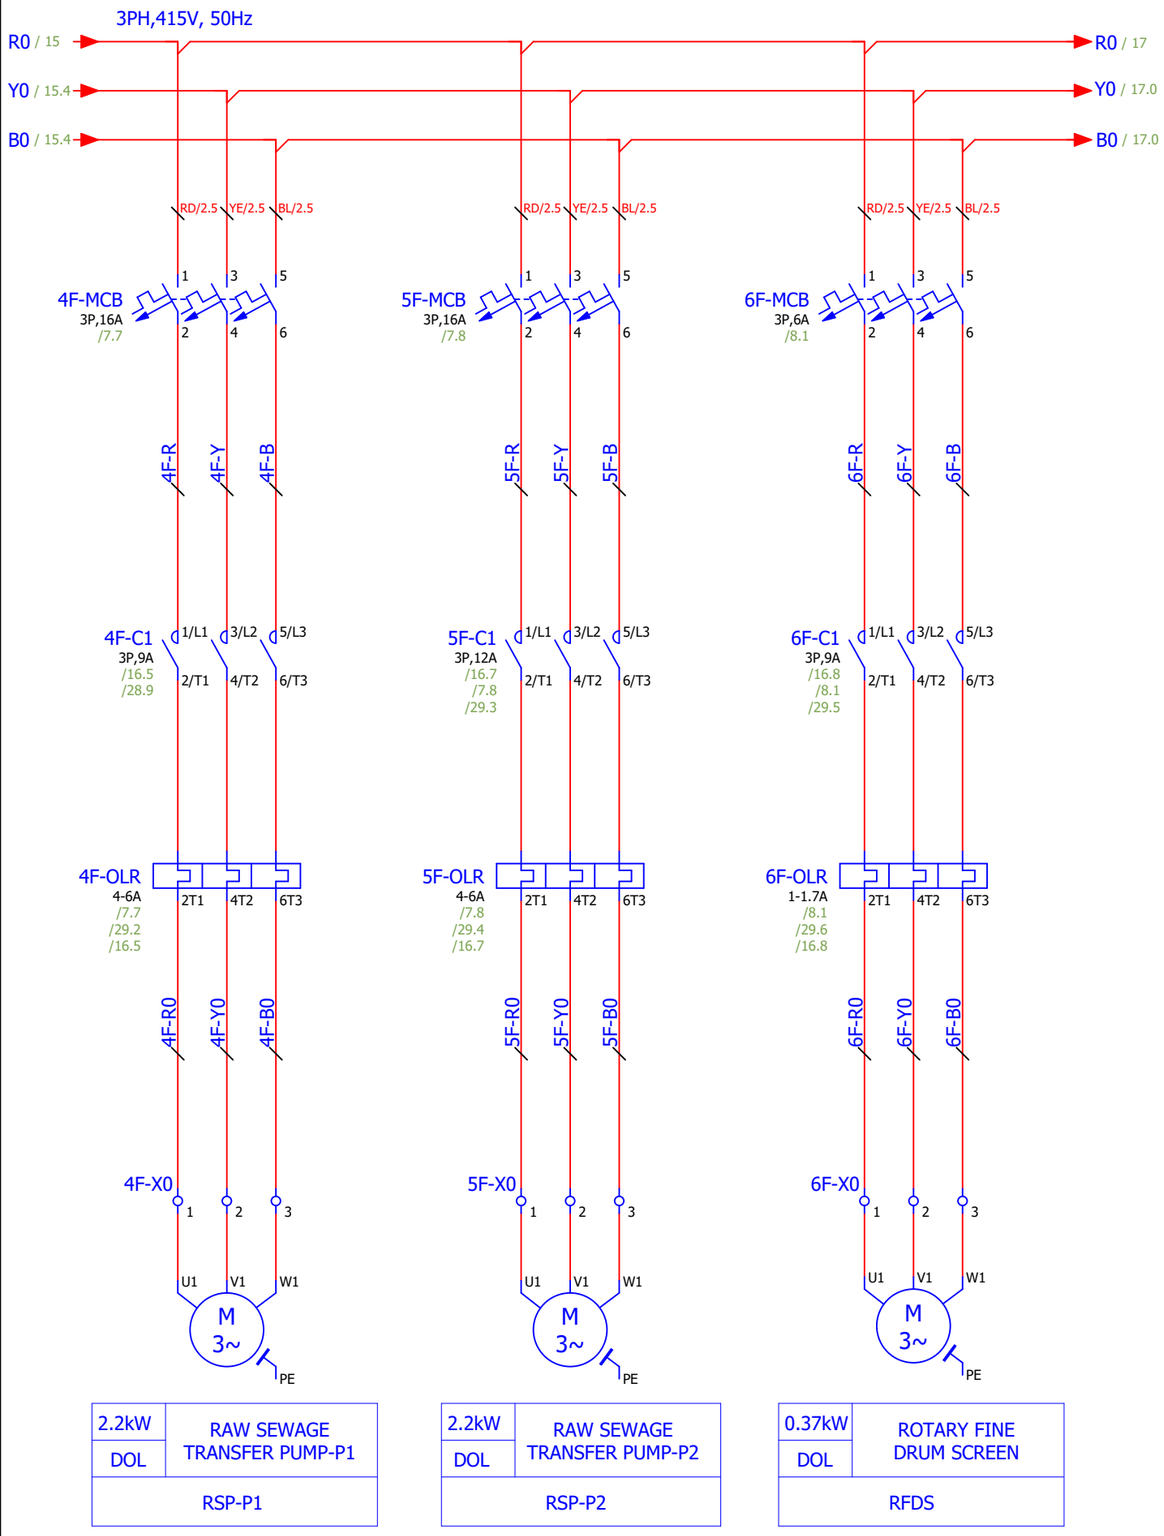

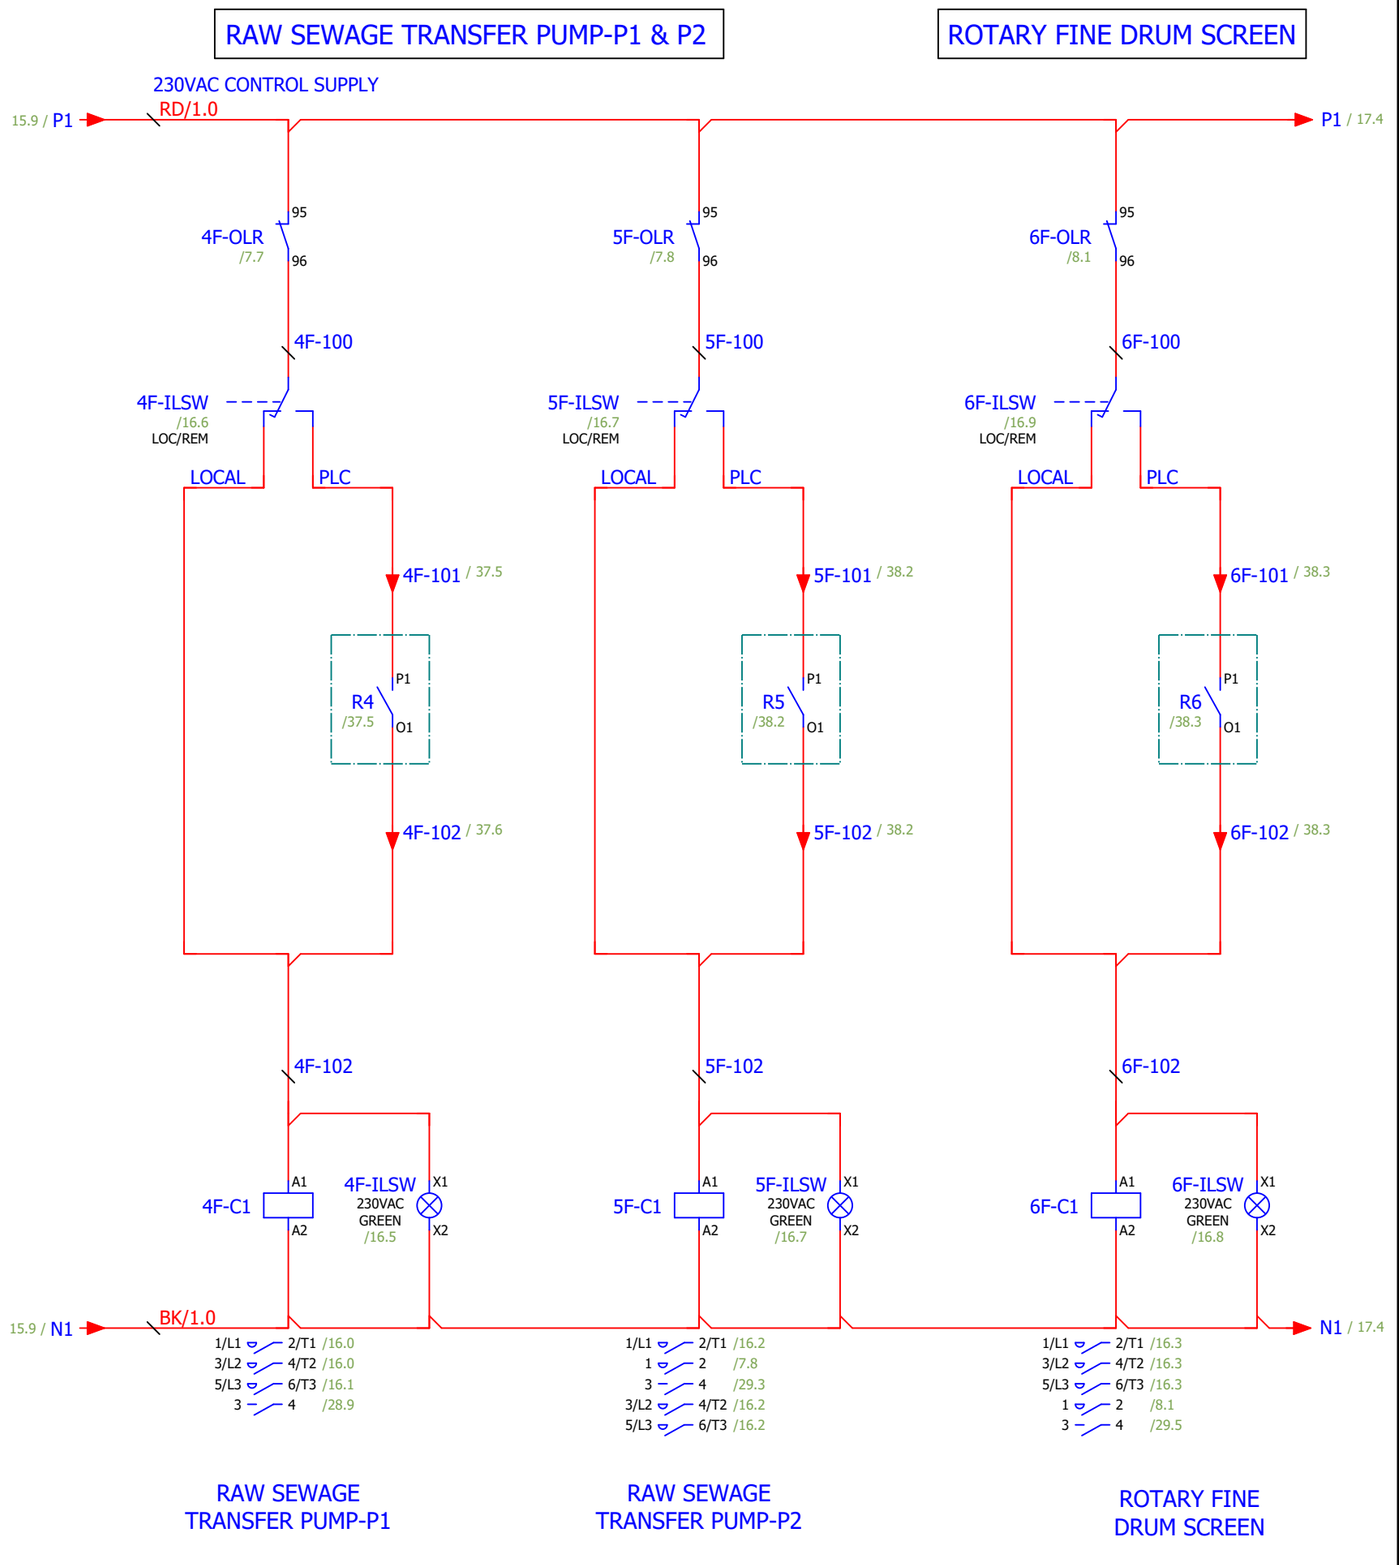
**AQUACARESEE PVT. LTD.**
OFFICE NO.204, 205 AND 206
VINAYAK ARCADE, 2ND FLOOR
OPP. BAJAJ AUTO, AKURDI,PUNE-411035
www.aquacaresee.co.in

| REVISION | DETAILS | DATE |
|---|---|---|
| 00 | AS BUILT | 23-01-2025 |
| 01 | AS PER COMMENTS | 09-12-2025 |
| 00 | FOR APPROVAL | 04-12-2025 |

TITLE:- RAW SEWAGE TR. PUMP-P1 & P2 & ROTARY FINE DRUM SCREEN PUMP-P1 POWER & CONTROL WIRING (4F & 5F & 6F)


| | |
|---|---|
| DRAWN BY | N.J. |
| CHECKED | V.K. |
| APPROVED | P.B. |

SYSTEM:-375 KLD MBR STP

PROJECT:- 375 KLD MBR STP PLANT CONTROL PANEL

| DRG. NO.:PRG-2526-637 | SHEET NO. | REV.NO. |
|---|---|---|
| | 17 / 47 | AS BUILT |

# MBR AIR BLOWER PUMP-B1 & B2

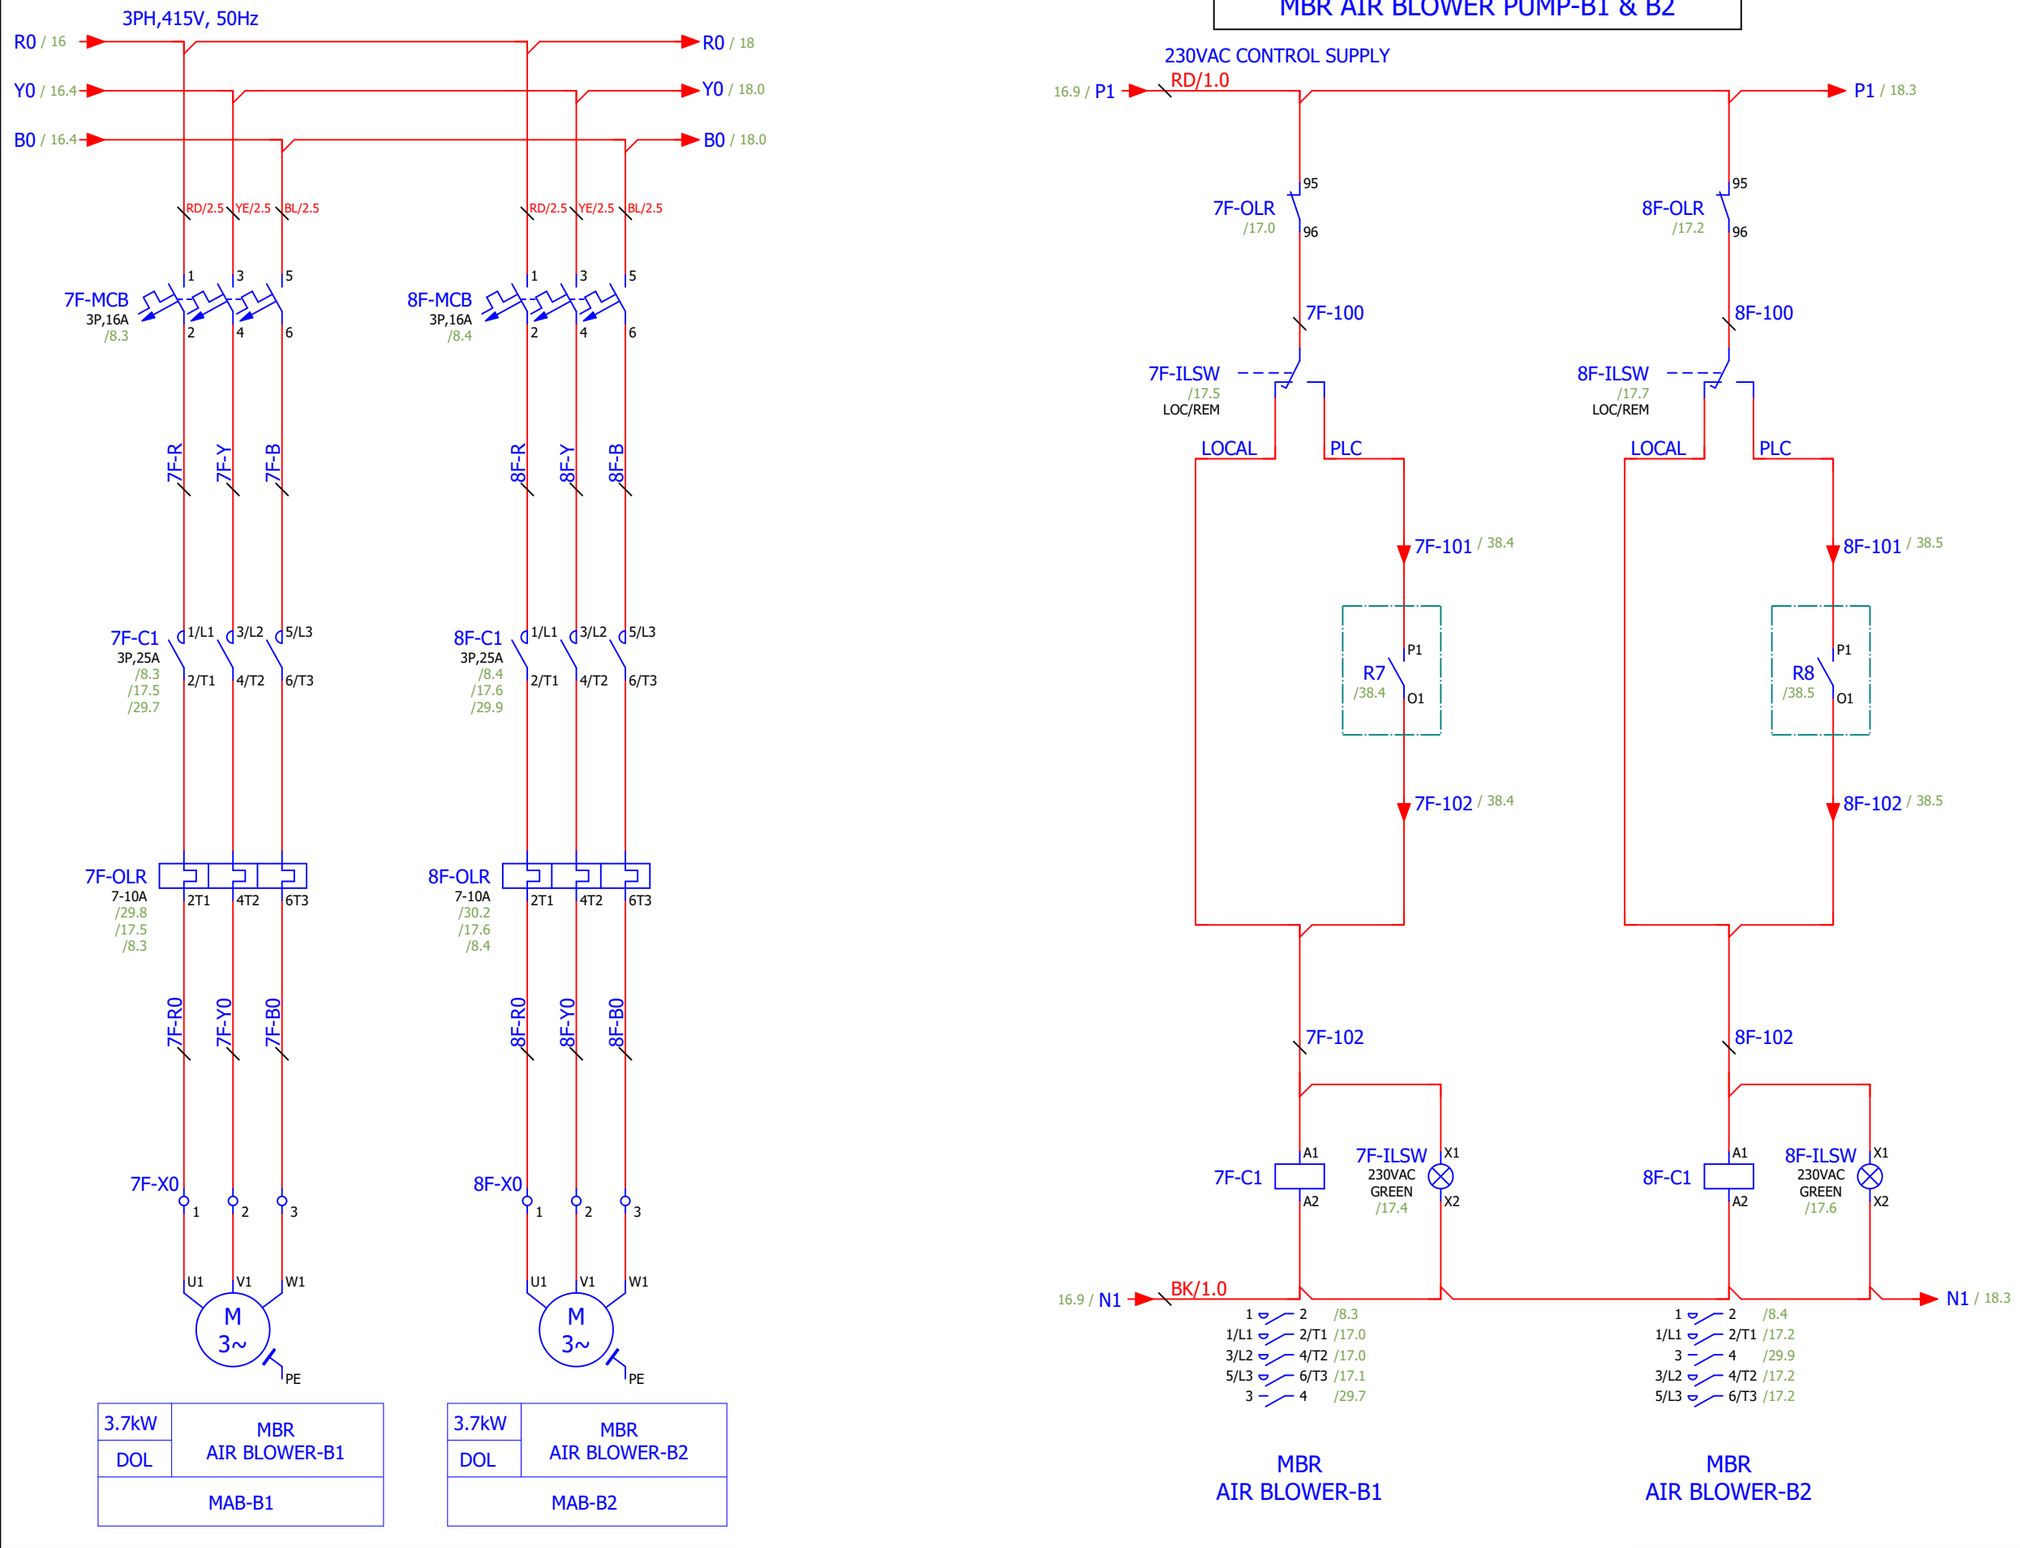





| | | | | | |
|---|---|---|---|---|---|
| | | | TITLE:- MBR AIR BLOWER -B1 & B2 POWER & CONTROL WIRING (7F & 8F) | | SYSTEM:-375 KLD MBR STP |
| 00 | AS BUILT | 23-01-2025 | | | PROJECT:- 375 KLD MBR STP PLANT CONTROL PANEL |
| 01 | AS PER COMMENTS | 09-12-2025 | DRAWN BY | N.J. | |
| 00 | FOR APPROVAL | 04-12-2025 | CHECKED | V.K. | DRG. NO.:PRG-2526-637 / SHEET NO. 18 / 47 / REV.NO. AS BUILT |
| REVISION | DETAILS | DATE | APPROVED | P.B. | |

**AQUACARESEE PVT. LTD.**
OFFICE NO.204, 205 AND 206
VINAYAK ARCADE, 2ND FLOOR
OPP. BAJAJ AUTO, AKURDI,PUNE-411035
www.aquacaresee.co.in

# AERATION AIR BLOWER B1

3PH,415V, 50Hz

R0 / 17 → R0 / 19

Y0 / 17.2 → Y0 / 19.0

B0 / 17.2 → B0 / 19.0

RD/2.5 YE/2.5 BL/2.5

9F-MCB
3P,63A
/8.6
1 3 5
2 4 6

9F-R 9F-Y 9F-B

STAR-9F

9F-C1
3P,40A
/18.6
/8.6
/18.5
1/L1 3/L2 5/L3
2/T1 4/T2 6/T3

9F-C2
3P,40A
/18.7
/8.6
/18.4
/30.3
1/L1 3/L2 5/L3
2/T1 4/T2 6/T3

9F-C3
3P,18A
/18.4
/8.7
/18.7
/18.6
1/L1 3/L2 5/L3
2/T1 4/T2 6/T3

9F-OLR
12-18A
/30.4
/18.5
/8.6
2T1 4T2 6T3

9F-R0 9F-Y0 9F-B0 9F-R1 9F-Y1 9F-B1

9F-X0
1 2 3 4 5 6

M
3~
U1 W2 V1 U2 W1 V2
PE

PE

| | |
|---|---|
| 15kW | AERATION AIR BLOWER B1 |
| S/D | |
| AAB-B1 | |

230VAC CONTROL SUPPLY
RD/1.0

17.7 / P1 → P1 / 19.3

9F-OLR
/18.0
95
96

9F-100

9F-ILSW
/18.7
LOC/REM

LOCAL PLC

9F-101 / 38.5

R9
/38.6
P1
O1

9F-102 / 38.6

9F-102

9F-T1
/18.7
/18.4
STAR
1
2
9F-103

9F-C2
/18.1
1
2
9F-104

9F-C1
/18.0
3
4

9F-C3
/18.2
3
4
9F-105

9F-T1
/18.4
DELTA
3
4
9F-106

9F-C3
/18.2
1
2
9F-107

9F-T1 A1 A2
9F-C3 A1 A2
9F-C1 A1 A2
9F-C2 A1 A2

9F-ILSW
230VAC
GREEN
/18.5
X1
X2

BK/1.0

17.7 / N1 → N1 / 19.3

## AERATION AIR BLOWER B1

1 2 /18.4
3 4 /18.7

1/L1 2/T1 /18.2
3/L2 4/T2 /18.3
5/L3 6/T3 /18.3
1 2 /8.7
1 2 /18.7
3 4 /18.6

1/L1 2/T1 /18.0
3/L2 4/T2 /18.0
5/L3 6/T3 /18.1
1 2 /8.6
3 4 /18.5

1/L1 2/T1 /18.1
3/L2 4/T2 /18.1
5/L3 6/T3 /18.2
1 2 /8.6
1 2 /18.4
3 4 /30.3


**AQUACARESEE PVT. LTD.**
OFFICE NO.204, 205 AND 206
VINAYAK ARCADE, 2ND FLOOR
OPP. BAJAJ AUTO, AKURDI,PUNE-411035
www.aquacaresee.co.in


| REVISION | DETAILS | DATE |
|---|---|---|
| 00 | AS BUILT | 23-01-2025 |
| 01 | AS PER COMMENTS | 09-12-2025 |
| 00 | FOR APPROVAL | 04-12-2025 |

TITLE:- AERATION AIR BLOWER PUMP - B1 POWER & CONTROL WIRING (9F)

| | |
|---|---|
| DRAWN BY | N.J. |
| CHECKED | V.K. |
| APPROVED | P.B. |

SYSTEM:-375 KLD MBR STP

PROJECT:- 375 KLD MBR STP PLANT CONTROL PANEL

DRG. NO.:PRG-2526-637 | SHEET NO. 19 / 47 | REV.NO. AS BUILT

# AERATION AIR BLOWER B2

3PH,415V, 50Hz

R0 / 18 → R0 / 20

Y0 / 18.2 → Y0 / 20.0

B0 / 18.2 → B0 / 20.0

RD/2.5 YE/2.5 BL/2.5

10F-MCB
3P,63A
/8.8
1 3 5
2 4 6

10F-R 10F-Y 10F-B

STAR-10F

10F-C1
3P,40A
/19.6
/8.8
/19.5
1/L1 3/L2 5/L3
2/T1 4/T2 6/T3

10F-C2
3P,40A
/19.7
/8.8
/19.4
/30.5
1/L1 3/L2 5/L3
2/T1 4/T2 6/T3

10F-C3
3P,18A
/19.4
/8.9
/19.7
/19.6
1/L1 3/L2 5/L3
2/T1 4/T2 6/T3

10F-OLR
12-18A
/30.6
/19.5
/8.8
2T1 4T2 6T3

10F-R0 10F-Y0 10F-B0 10F-R1 10F-Y1 10F-B1

10F-X0
1 2 3 4 5 6

M
3~
U1 W2 V1 U2 W1 V2

PE

PE

| | |
|---|---|
| 15kW | AERATION AIR BLOWER B2 |
| S/D | |
| AAB-B2 | |

230VAC CONTROL SUPPLY
RD/1.0

18.8 / P1 → P1 / 20.4

10F-OLR
/19.0
95
96

10F-100

10F-ILSW
/19.7
LOC/REM

LOCAL PLC

10F-101 / 38.6

R10
/38.7
P1
O1

10F-102 / 38.7

10F-102

10F-T1
/19.7
/19.4
STAR
1
2

10F-103

10F-C2
/19.1
1
2

10F-104

10F-C1
/19.0
3
4

10F-105

10F-C3
/19.2
3
4

10F-T1
/19.4
DELTA
3
4

10F-106

10F-C3
/19.2
1
2

10F-107

10F-T1 A1 A2

10F-C3 A1 A2

10F-C1 A1 A2

10F-C2 A1 A2

10F-ILSW
230VAC
GREEN
/19.5
X1 X2

18.8 / N1 → N1 / 20.4

BK/1.0

## AERATION AIR BLOWER B2

1 2 /19.4
3 4 /19.7

1/L1 2/T1 /19.2
3/L2 4/T2 /19.3
5/L3 6/T3 /19.3
1 2 /8.9
1 2 /19.7
3 4 /19.6

1/L1 2/T1 /19.0
3/L2 4/T2 /19.0
5/L3 6/T3 /19.1
1 2 /8.8
3 4 /19.5

1/L1 2/T1 /19.1
3/L2 4/T2 /19.1
5/L3 6/T3 /19.2
1 2 /8.8
1 2 /19.4
3 4 /30.5


**AQUACARESEE PVT. LTD.**
OFFICE NO.204, 205 AND 206
VINAYAK ARCADE, 2ND FLOOR
OPP. BAJAJ AUTO, AKURDI,PUNE-411035
www.aquacaresee.co.in


| REVISION | DETAILS | DATE |
|---|---|---|
| 00 | AS BUILT | 23-01-2025 |
| 01 | AS PER COMMENTS | 09-12-2025 |
| 00 | FOR APPROVAL | 04-12-2025 |

TITLE:- AERATION AIR BLOWER PUMP - B2 POWER & CONTROL WIRING (10F)


| | |
|---|---|
| DRAWN BY | N.J. |
| CHECKED | V.K. |
| APPROVED | P.B. |


SYSTEM:-375 KLD MBR STP

PROJECT:-375 KLD MBR STP PLANT CONTROL PANEL

DRG. NO.:PRG-2526-637 | SHEET NO. 20 / 47 | REV.NO. AS BUILT

# MBR PERMEATE PUMP P1 & P2

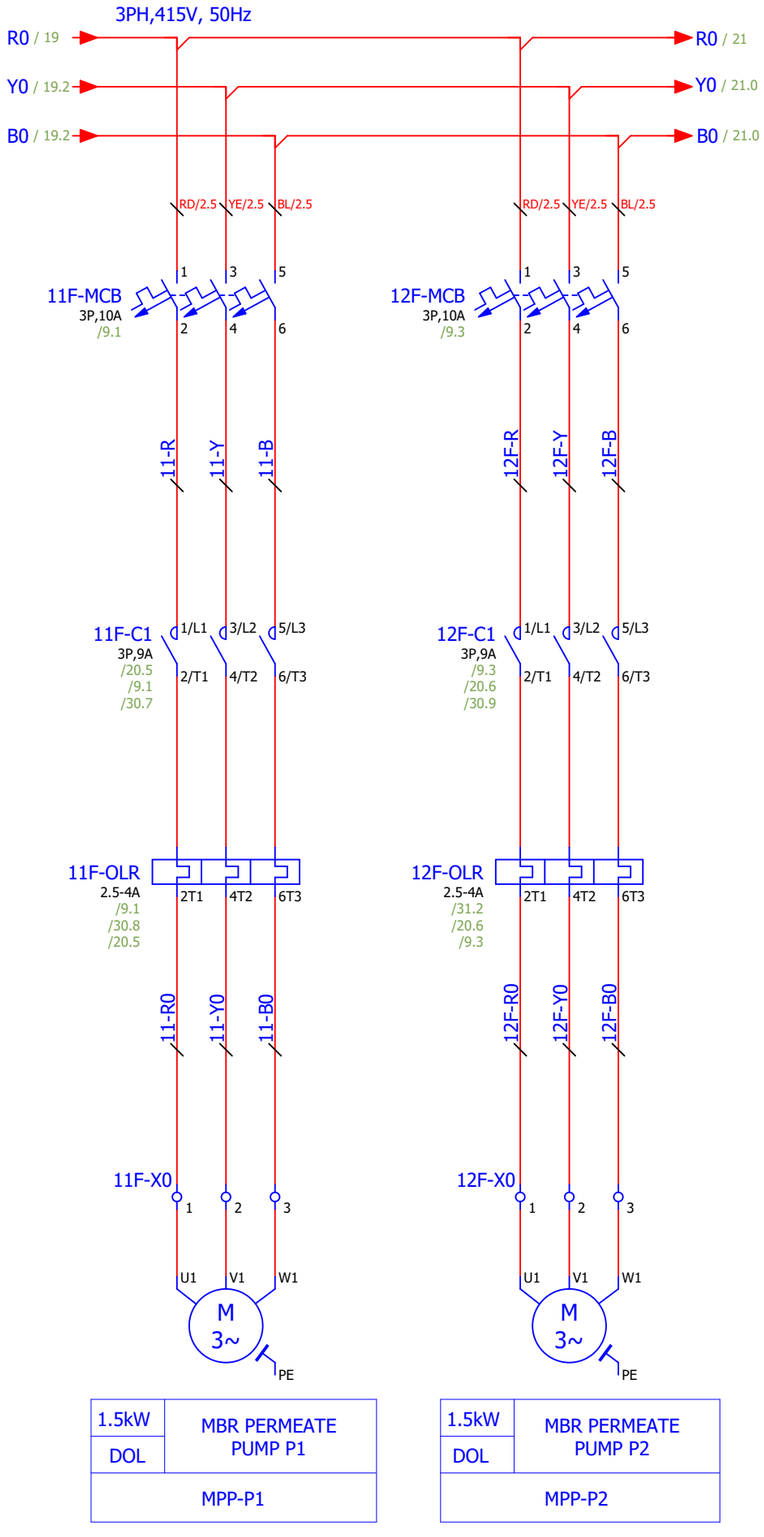


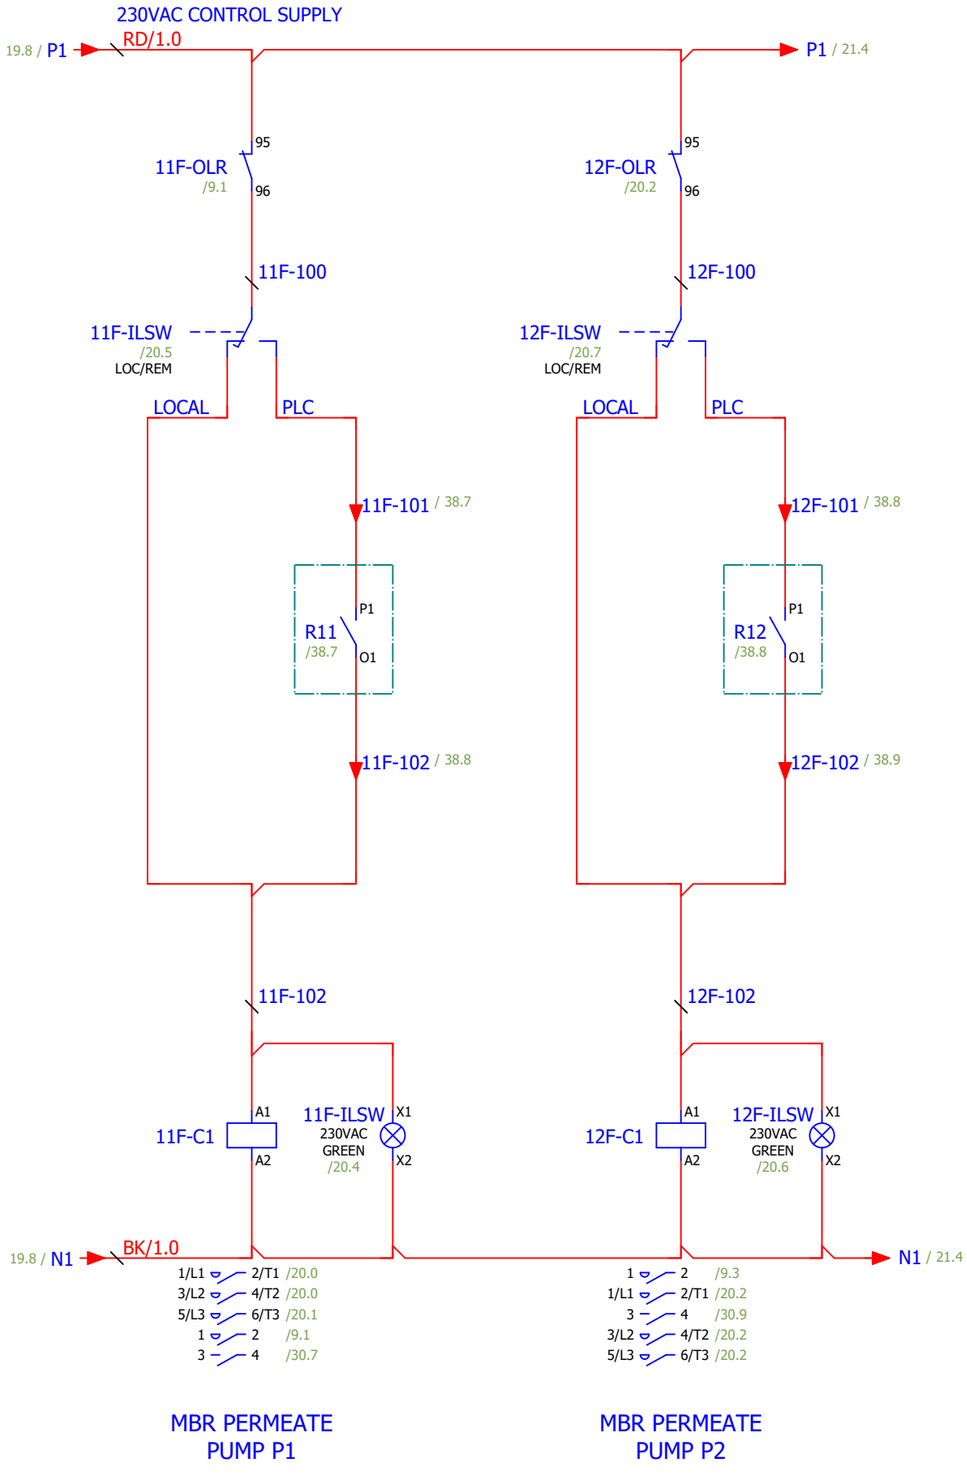




| | | | | | |
|---|---|---|---|---|---|
| | | | TITLE:- MBR PERMEATE PUMP- P1 & P2 POWER & CONTROL WIRING (11F & 12F) | | SYSTEM:-375 KLD MBR STP |
| 00 | AS BUILT | 23-01-2025 | | | PROJECT:- 375 KLD MBR STP PLANT CONTROL PANEL |
| 01 | AS PER COMMENTS | 09-12-2025 | DRAWN BY | N.J. | DRG. NO.:PRG-2526-637 / SHEET NO. 21 / 47 / REV.NO. AS BUILT |
| 00 | FOR APPROVAL | 04-12-2025 | CHECKED | V.K. | |
| REVISION | DETAILS | DATE | APPROVED | P.B. | |


**AQUACARESEE PVT. LTD.**
OFFICE NO.204, 205 AND 206
VINAYAK ARCADE, 2ND FLOOR
OPP. BAJAJ AUTO, AKURDI,PUNE-411035
www.aquacaresee.co.in

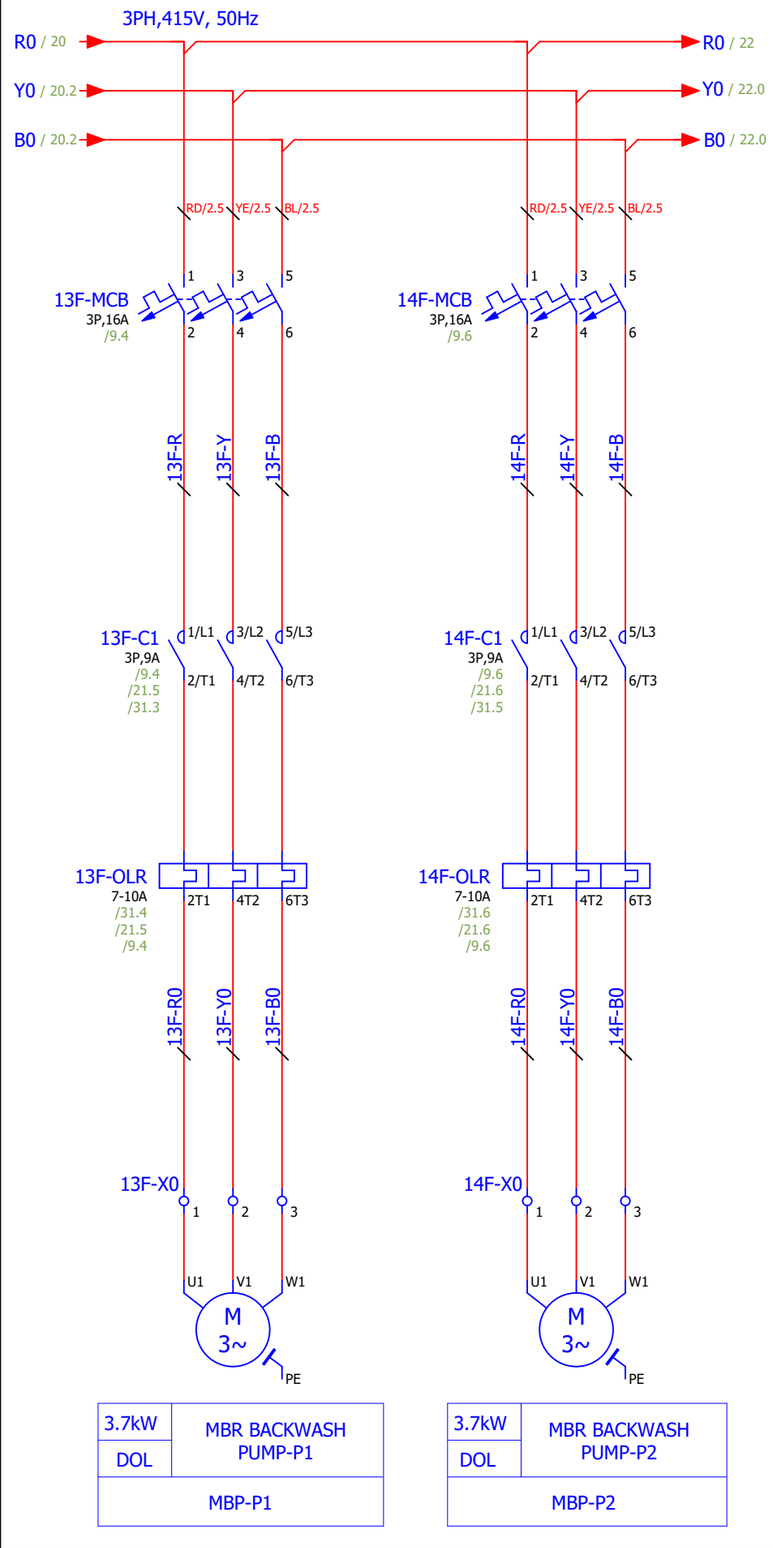
# MBR BACKWASH PUMP-P1 & P2

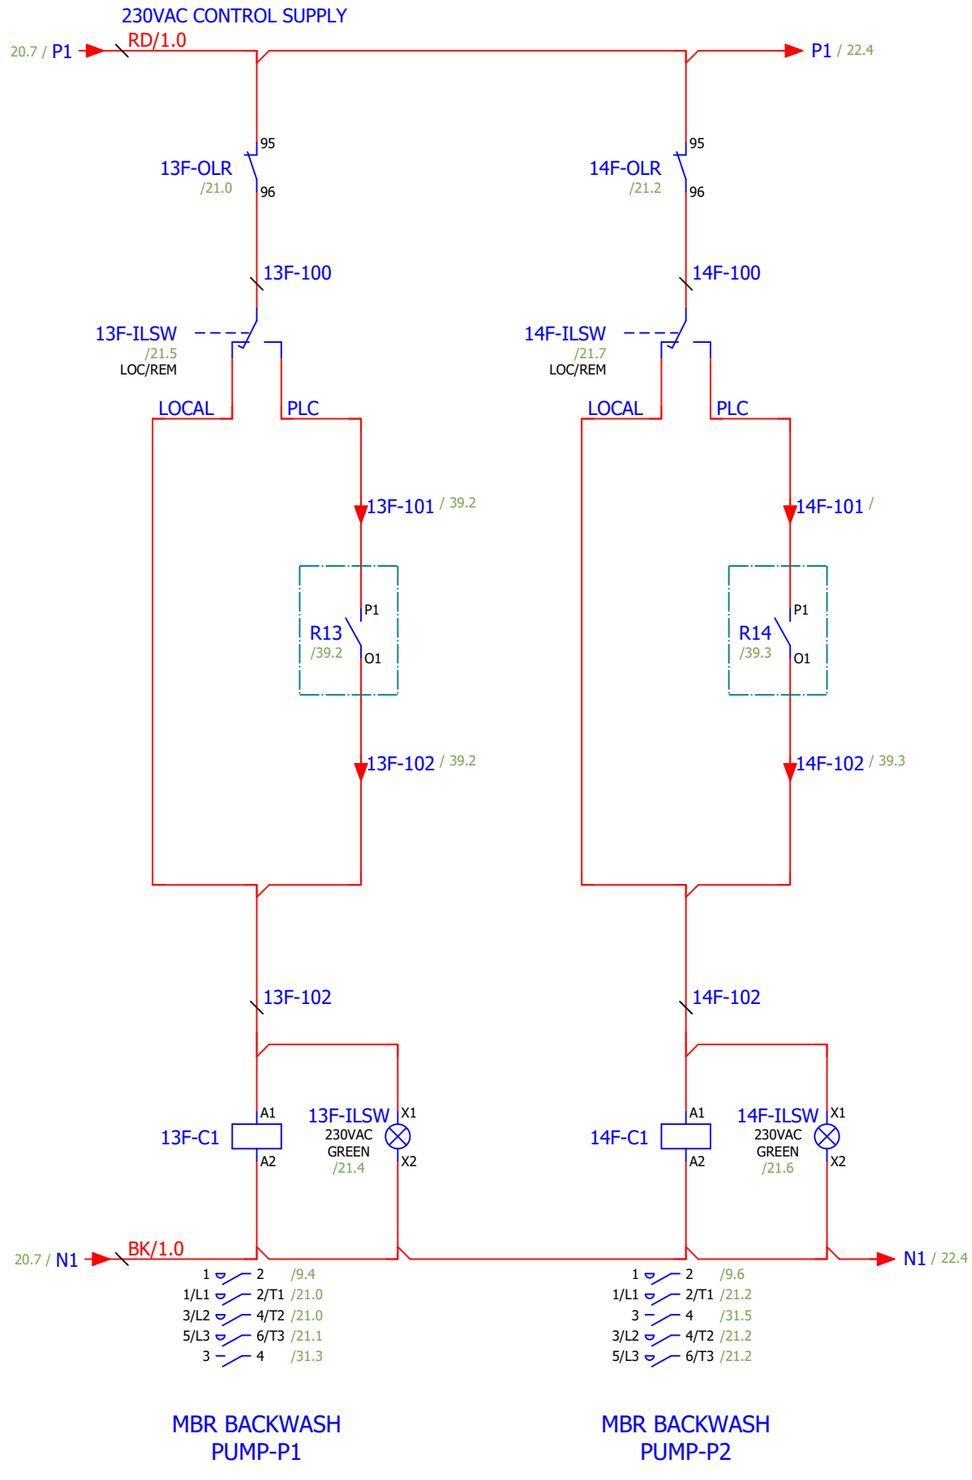



| | | | | | |
|---|---|---|---|---|---|
| | | | TITLE:- MBR BACKWASH PUMP PUMP- P1 & P2 POWER & CONTROL WIRING (13F & 14F) | | SYSTEM:-375 KLD MBR STP |
| 00 | AS BUILT | 23-01-2025 | | | PROJECT:- 375 KLD MBR STP PLANT CONTROL PANEL |
| 01 | AS PER COMMENTS | 09-12-2025 | DRAWN BY | N.J. | |
| 00 | FOR APPROVAL | 04-12-2025 | CHECKED | V.K. | DRG. NO.:PRG-2526-637 / SHEET NO. 22 / 47 / REV.NO. AS BUILT |
| REVISION | DETAILS | DATE | APPROVED | P.B. | |

**AQUACARESEE PVT. LTD.**
**OFFICE NO.204, 205 AND 206**
**VINAYAK ARCADE, 2ND FLOOR**
**OPP. BAJAJ AUTO, AKURDI,PUNE-411035**
**www.aquacaresee.co.in**

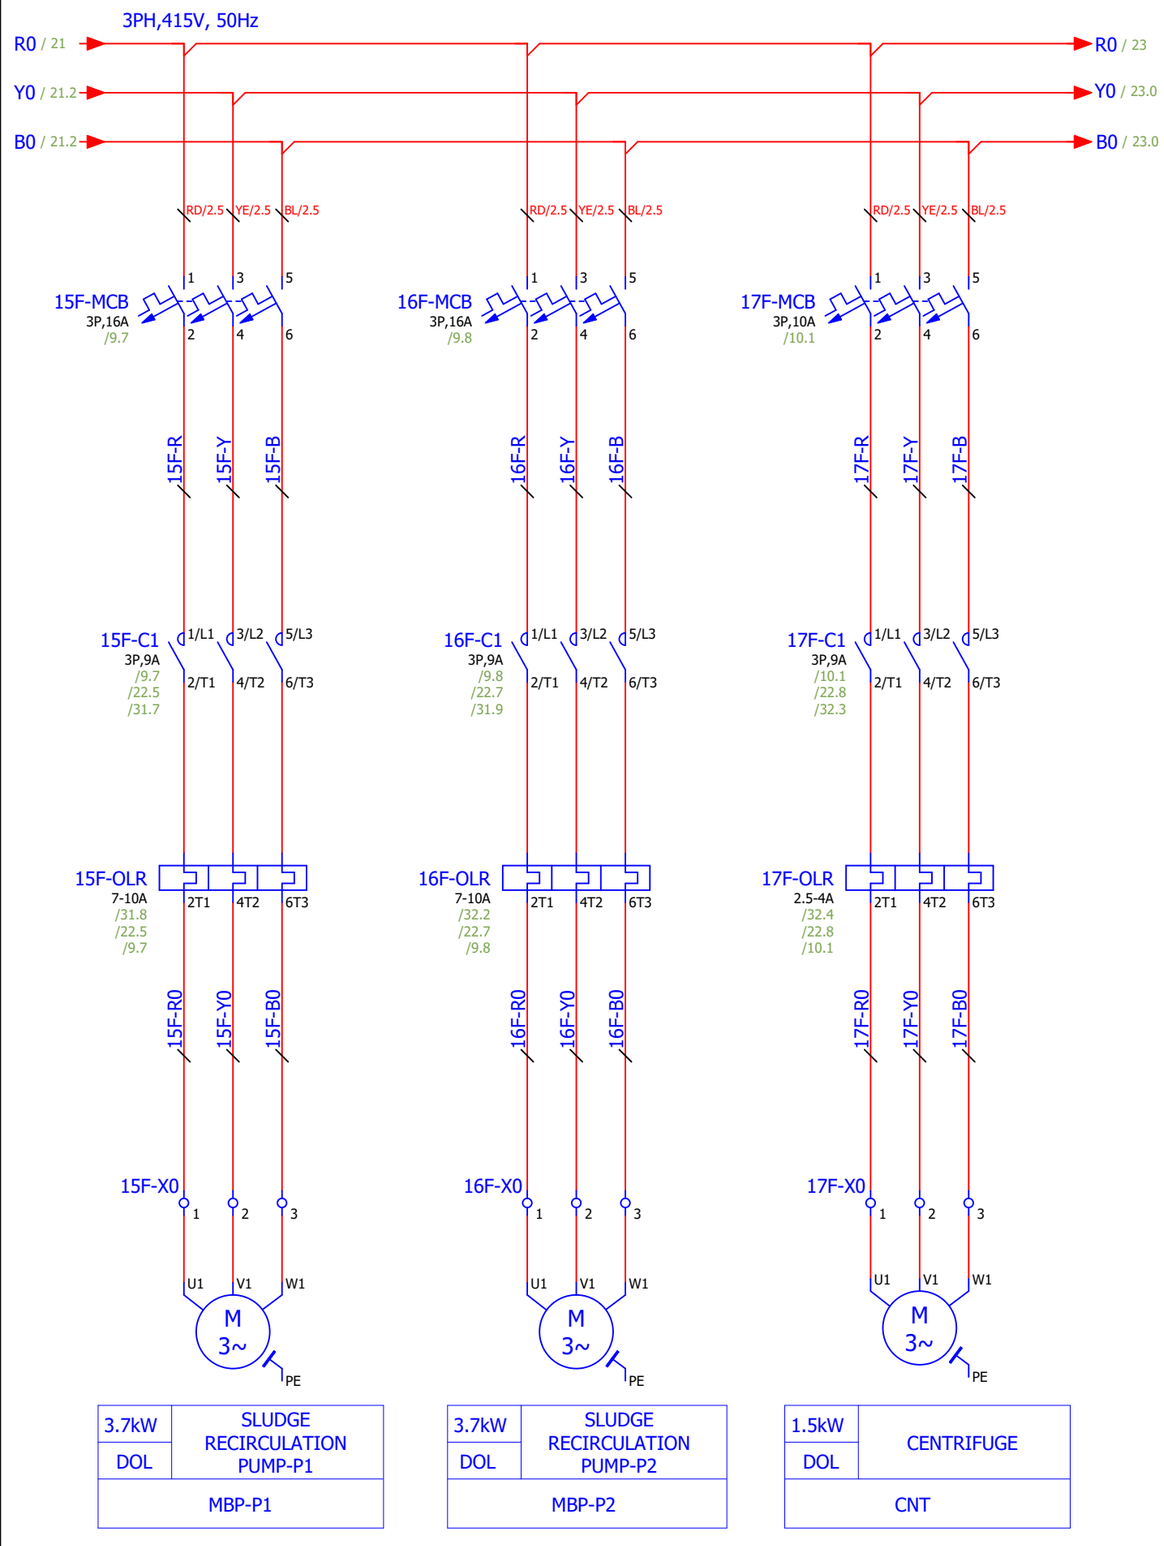


**AQUACARESEE PVT. LTD.**
**OFFICE NO.204, 205 AND 206**
**VINAYAK ARCADE, 2ND FLOOR**
**OPP. BAJAJ AUTO, AKURDI,PUNE-411035**
**www.aquacaresee.co.in**
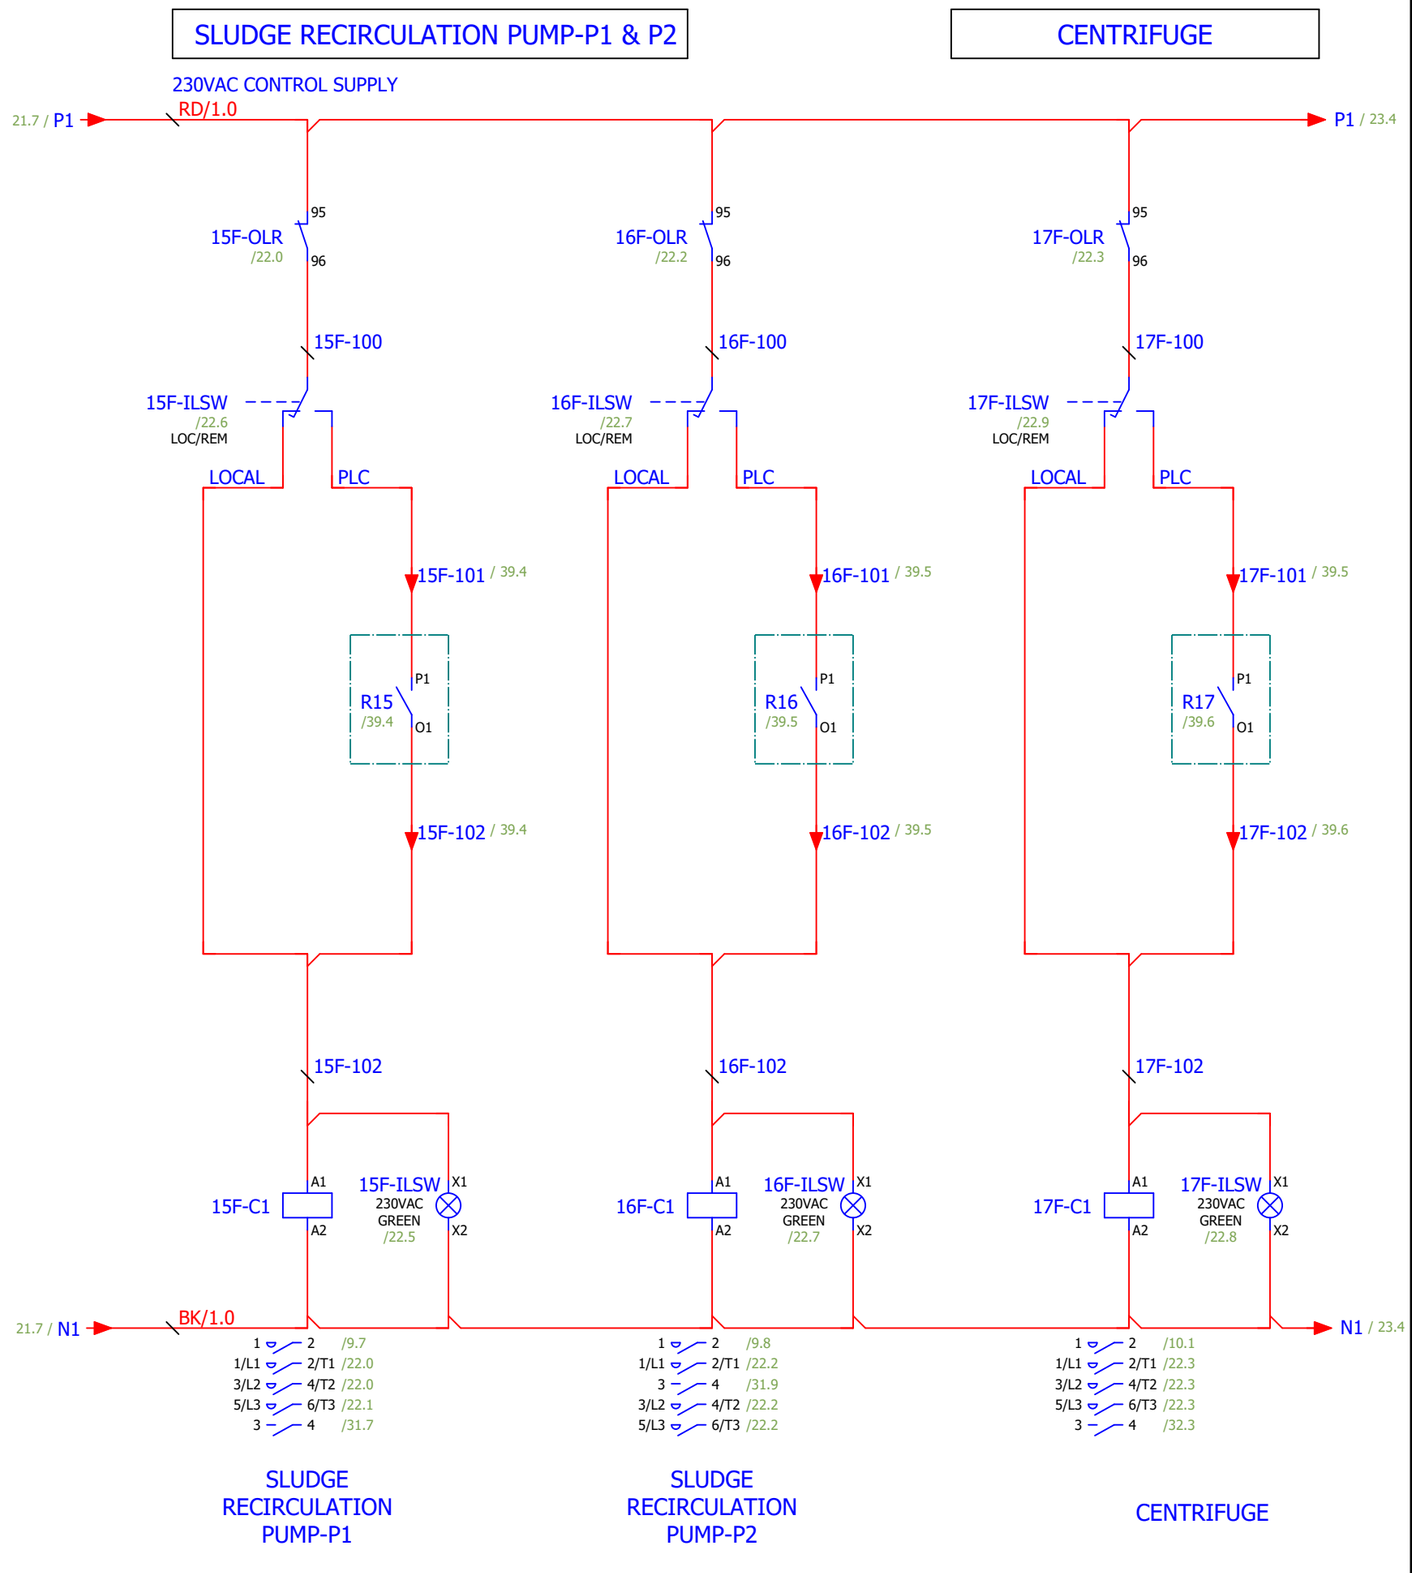
| REVISION | DETAILS | DATE |
|---|---|---|
| 00 | AS BUILT | 23-01-2025 |
| 01 | AS PER COMMENTS | 09-12-2025 |
| 00 | FOR APPROVAL | 04-12-2025 |


TITLE:- SLUDGE RECIRCULATION PUMP- P1 & P2,CENTRIFUGE POWER & CONTROL WIRING (15F,16F &17F)


| | |
|---|---|
| DRAWN BY | N.J. |
| CHECKED | V.K. |
| APPROVED | P.B. |

SYSTEM:-375 KLD MBR STP

PROJECT:- 375 KLD MBR STP PLANT CONTROL PANEL

| DRG. NO.:PRG-2526-637 | SHEET NO. 23 / 47 | REV.NO. AS BUILT |
|---|---|---|

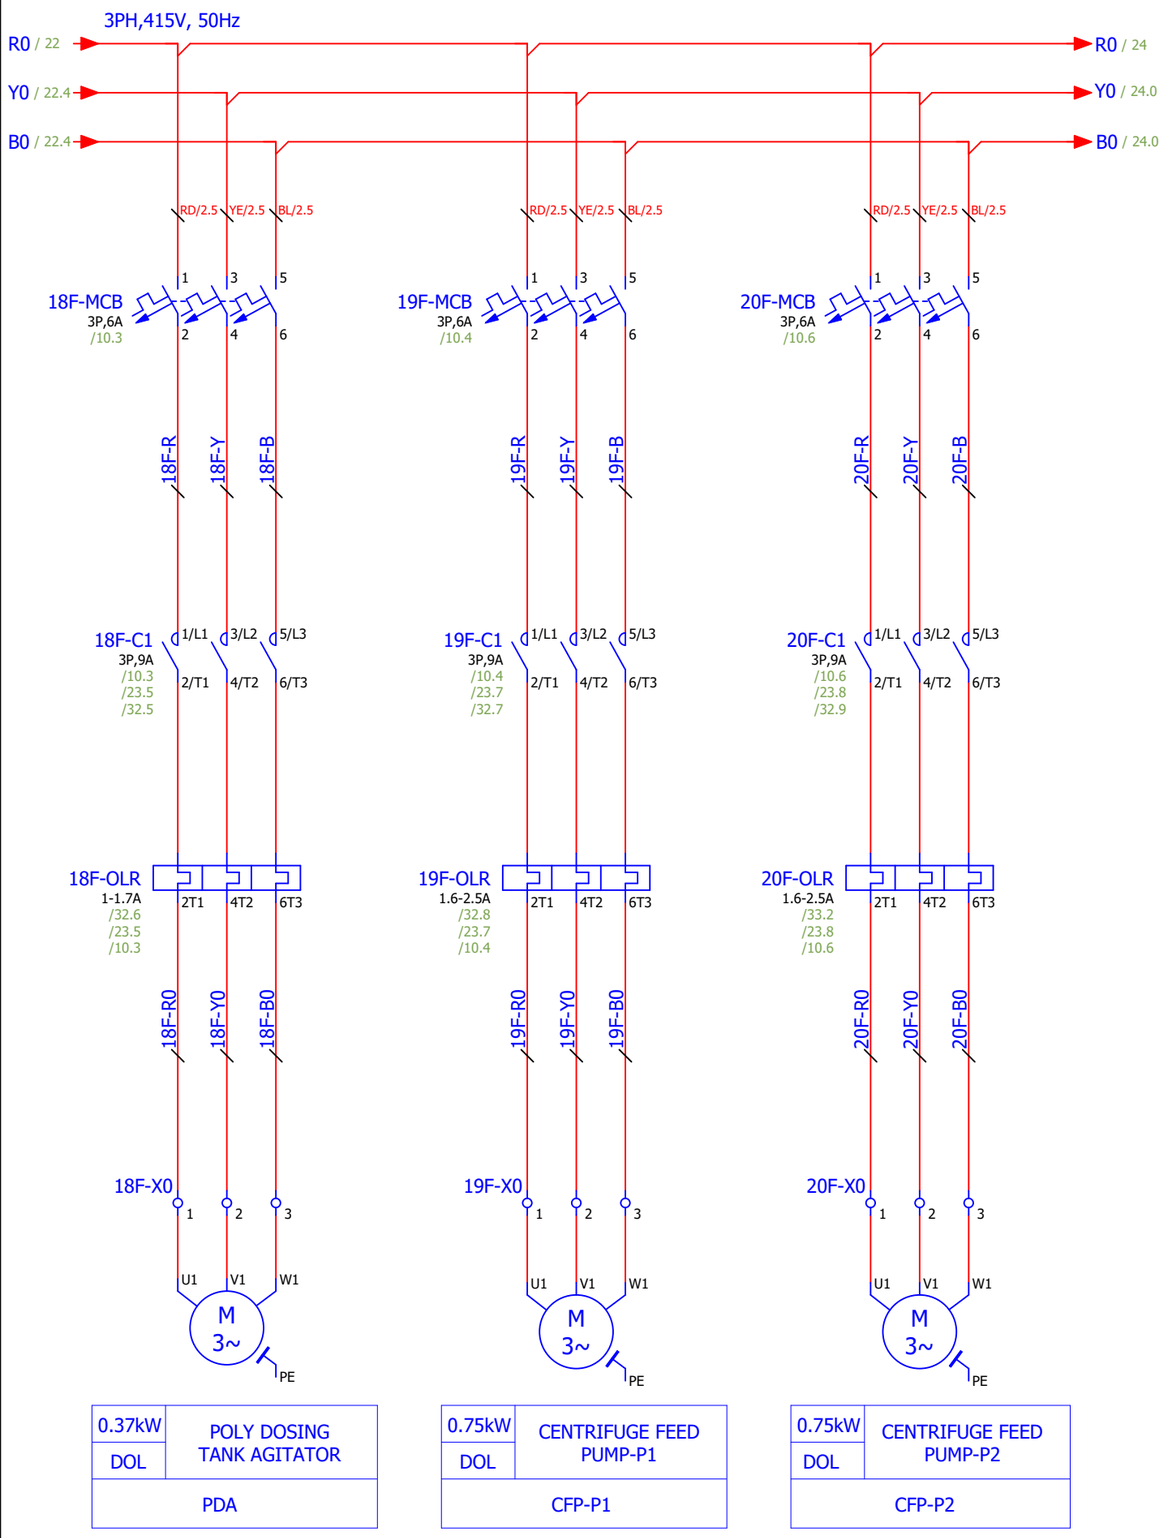

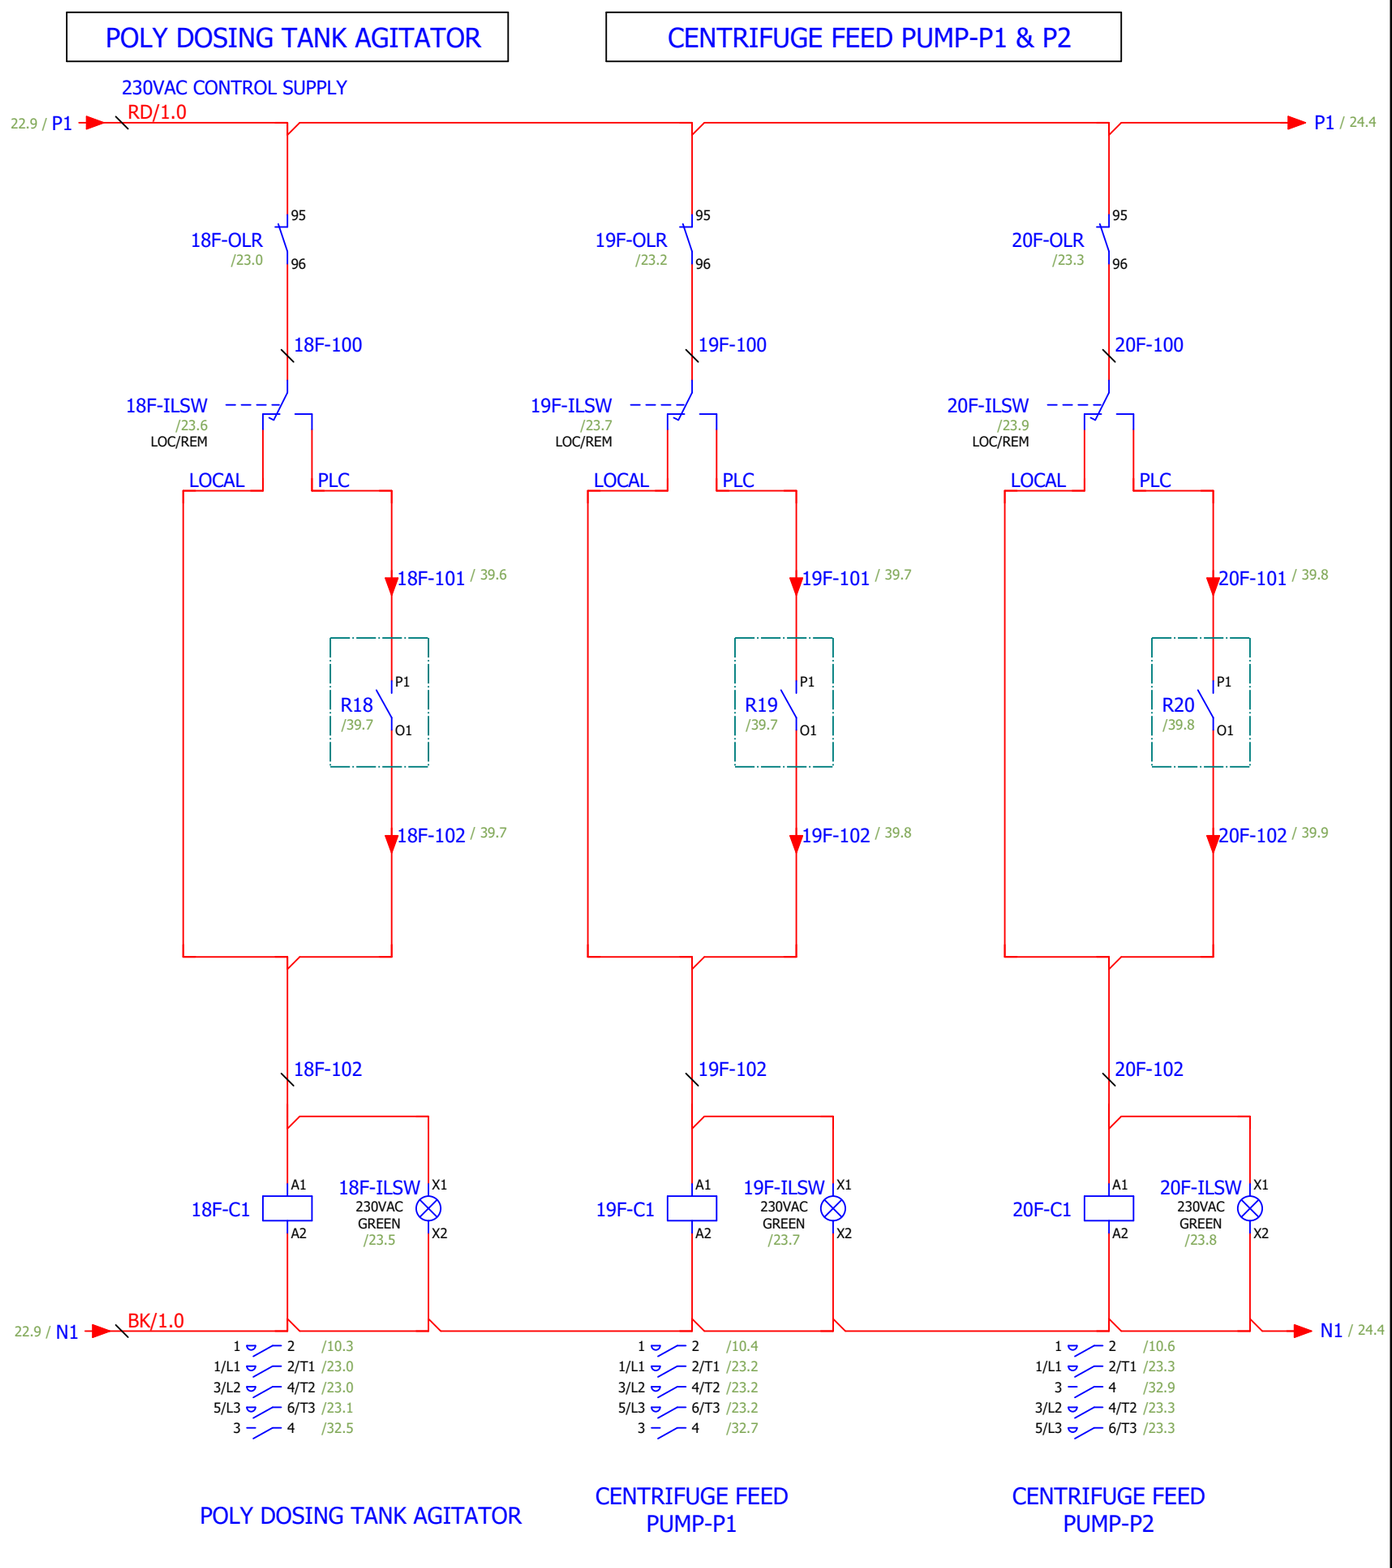
**AQUACARESEE PVT. LTD.**
**OFFICE NO.204, 205 AND 206**
**VINAYAK ARCADE, 2ND FLOOR**
**OPP. BAJAJ AUTO, AKURDI,PUNE-411035**
**www.aquacaresee.co.in**

| REVISION | DETAILS | DATE |
|---|---|---|
| 00 | AS BUILT | 23-01-2025 |
| 01 | AS PER COMMENTS | 09-12-2025 |
| 00 | FOR APPROVAL | 04-12-2025 |


TITLE:- POLY DOSING TANK AGITATOR PUMP- P1 & CENFG. FEED PUMP-P1 & P2 POWER & CONTROL WIRING (18F,19F & 20F)


| | |
|---|---|
| DRAWN BY | N.J. |
| CHECKED | V.K. |
| APPROVED | P.B. |

SYSTEM:-375 KLD MBR STP

PROJECT:- 375 KLD MBR STP PLANT CONTROL PANEL

| DRG. NO.:PRG-2526-637 | SHEET NO. 24 / 47 | REV.NO. AS BUILT |
|---|---|---|

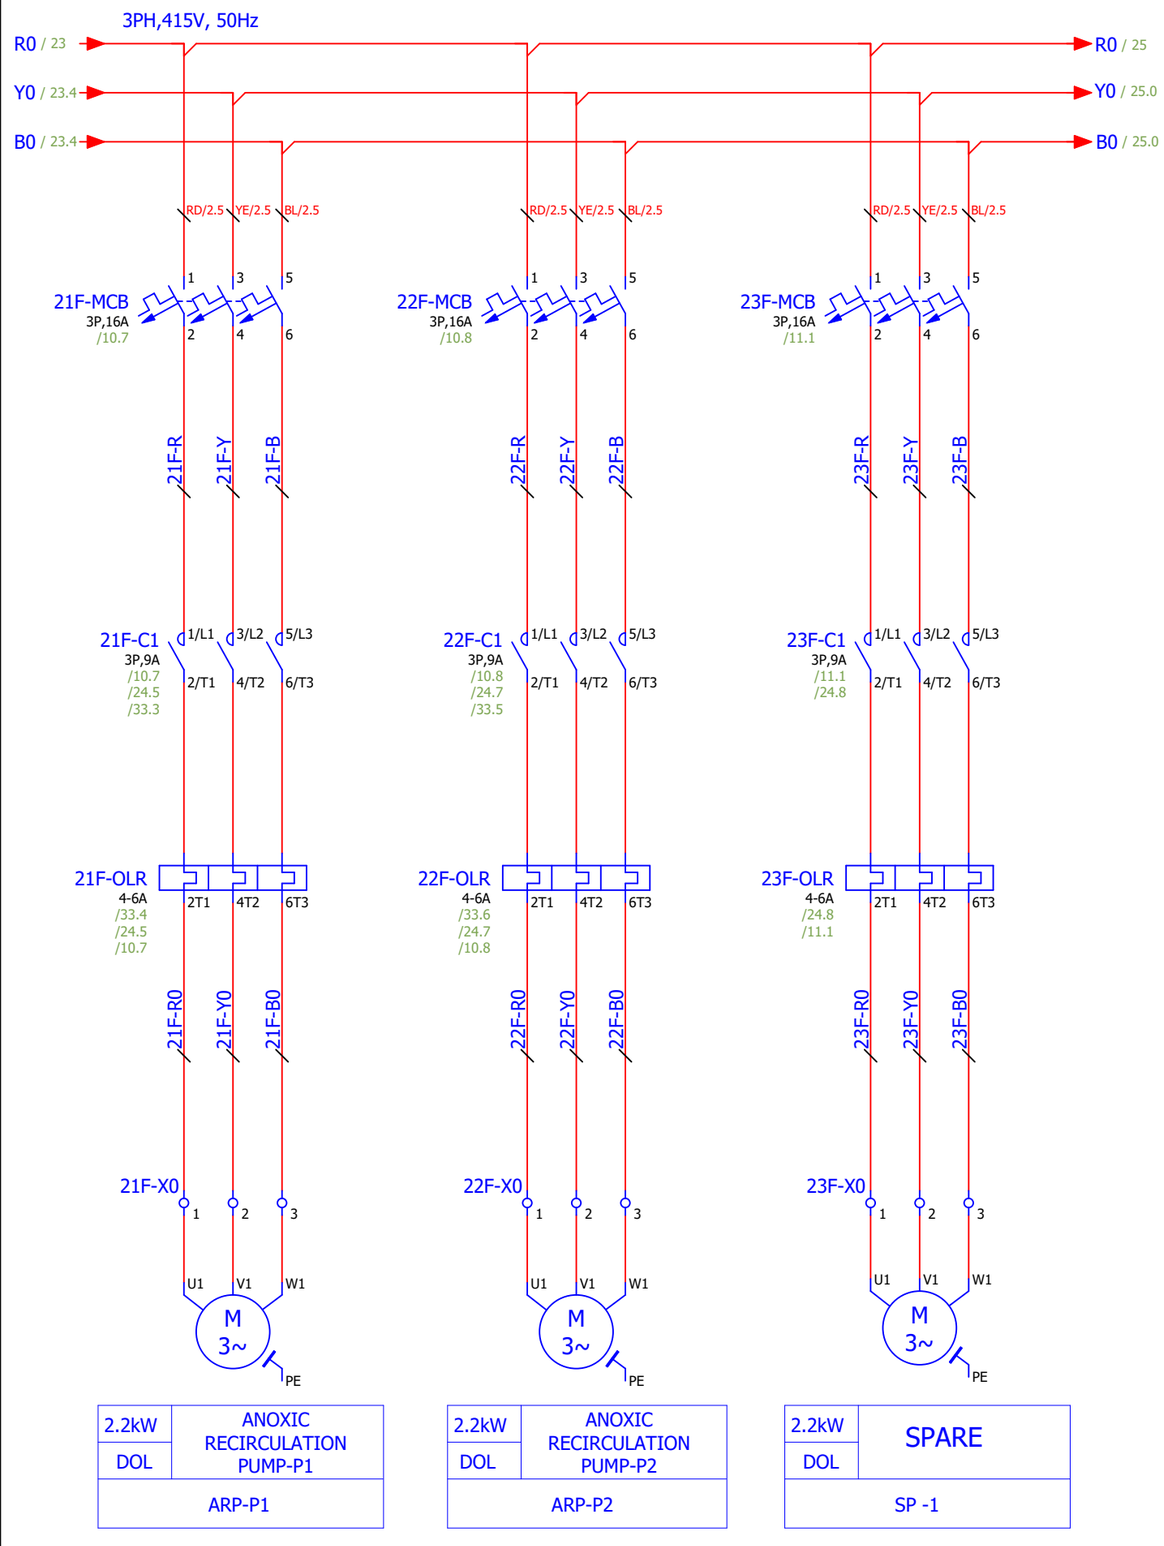

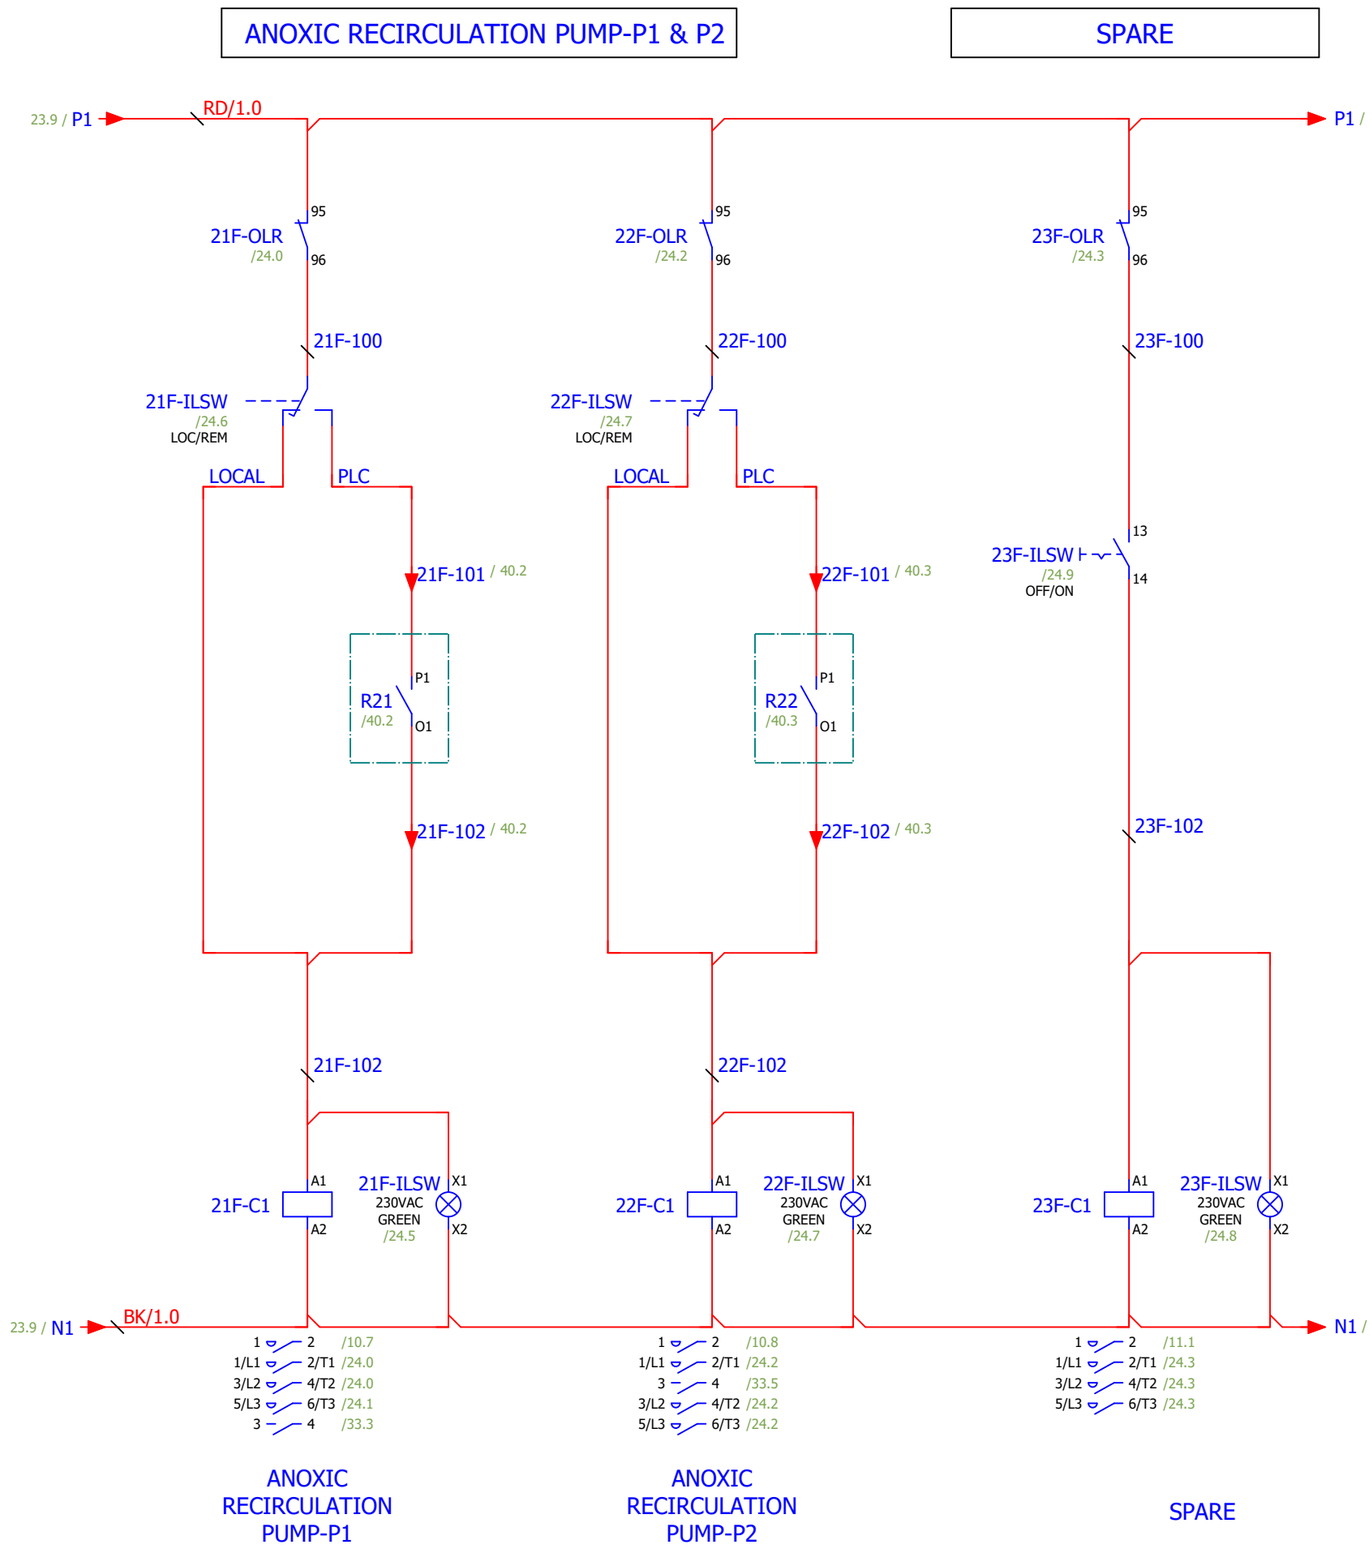
**AQUACARESEE PVT. LTD.**
**OFFICE NO.204, 205 AND 206**
**VINAYAK ARCADE, 2ND FLOOR**
**OPP. BAJAJ AUTO, AKURDI,PUNE-411035**
**www.aquacaresee.co.in**

| REVISION | DETAILS | DATE |
|---|---|---|
| 00 | AS BUILT | 23-01-2025 |
| 01 | AS PER COMMENTS | 09-12-2025 |
| 00 | FOR APPROVAL | 04-12-2025 |

TITLE:- ANOXIC RECIRCULATION PUMP P1 &P2-POWER & CONTROL WIRING (21F & 22F)

| | |
|---|---|
| DRAWN BY | N.J. |
| CHECKED | V.K. |
| APPROVED | P.B. |

SYSTEM:-375 KLD MBR STP

PROJECT:- 375 KLD MBR STP PLANT CONTROL PANEL

| DRG. NO.:PRG-2526-637 | SHEET NO. 25 / 47 | REV.NO. AS BUILT |
|---|---|---|

3PH,415V, 50Hz

R0 / 24
Y0 / 24.4
B0 / 24.4
N /

24F-MCB
2P,6AMP
/11.3

25F-MCB
2P,6AMP
/11.4

26F-MCB
2P,6AMP
/11.6

27F-MCB
2P,6AMP
/11.7

28F-MCB
2P,10AMP
/12.1

24F-R
24F-N
25F-Y
25F-N
26F-B
26F-N
27F-R
28F-N
28F-R0
28F-N0

28F-R0 / 26.0
28F-N0 / 26.0

24F-ILSW1
/25.0
LOC/REM
LOCAL
PLC

25F-ILSW1
/25.2
LOC/REM
LOCAL
PLC

26F-ILSW1
/25.4
LOC/REM
LOCAL
PLC

27F-ILSW1
/25.5
LOC/REM
LOCAL
PLC

24F-R0
40.4
R23
/40.4
P10
O10
24F-R1
40.4

25F-Y0
40.5
R24
/40.5
25F-Y1
40.5

26F-B0
40.5
R25
/40.6
26F-B1
40.6

27F-R0
40.6
R26
/40.7
27F-R1
40.7

24F-ILSW1
230VAC
GREEN
/25.0

25F-ILSW1
230VAC
GREEN
/25.2

26F-ILSW1
230VAC
GREEN
/25.4

27F-ILSW1
230VAC
GREEN
/25.5

X1
X2

24F-X0
25F-X0
26F-X0
27F-X0
28F-X0
28F-X1
1 2 3 PE

| | |
|---|---|
| 0.1kW | POLY DOSING PUMP |
| ON/OFF | |
| PDP | |

| | |
|---|---|
| 0.1kW | HYPO DOSING PUMP |
| ON/OFF | |
| HDP | |

| | |
|---|---|
| 0.1kW | CITRIC DOSING PUMP |
| ON/OFF | |
| CDP | |

| | |
|---|---|
| 0.75kW | AIR COMPRESSOR |
| ON/OFF | |
| AC | |

| | |
|---|---|
| 0.5kW | UV SYSTEM |
| ON/OFF | |
| UV | |

| | |
|---|---|
| 0.1kW | FLOW METER-01 |
| ON/OFF | |
| FM-01 | |

**AQUACARESEE PVT. LTD.**
**OFFICE NO.204, 205 AND 206**
**VINAYAK ARCADE, 2ND FLOOR**
**OPP. BAJAJ AUTO, AKURDI,PUNE-411035**
**www.aquacaresee.co.in**

| REVISION | DETAILS | DATE |
|---|---|---|
| 00 | AS BUILT | 23-01-2025 |
| 01 | AS PER COMMENTS | 09-12-2025 |
| 00 | FOR APPROVAL | 04-12-2025 |


TITLE:- DOSING & CITRIC PUMPS & SUPPLY FEEDER

| | |
|---|---|
| DRAWN BY | N.J. |
| CHECKED | V.K. |
| APPROVED | P.B. |

SYSTEM:-375 KLD MBR STP

PROJECT:- 375 KLD MBR STP PLANT CONTROL PANEL

DRG. NO.:PRG-2526-637 | SHEET NO. 26 / 47 | REV.NO. AS BUILT

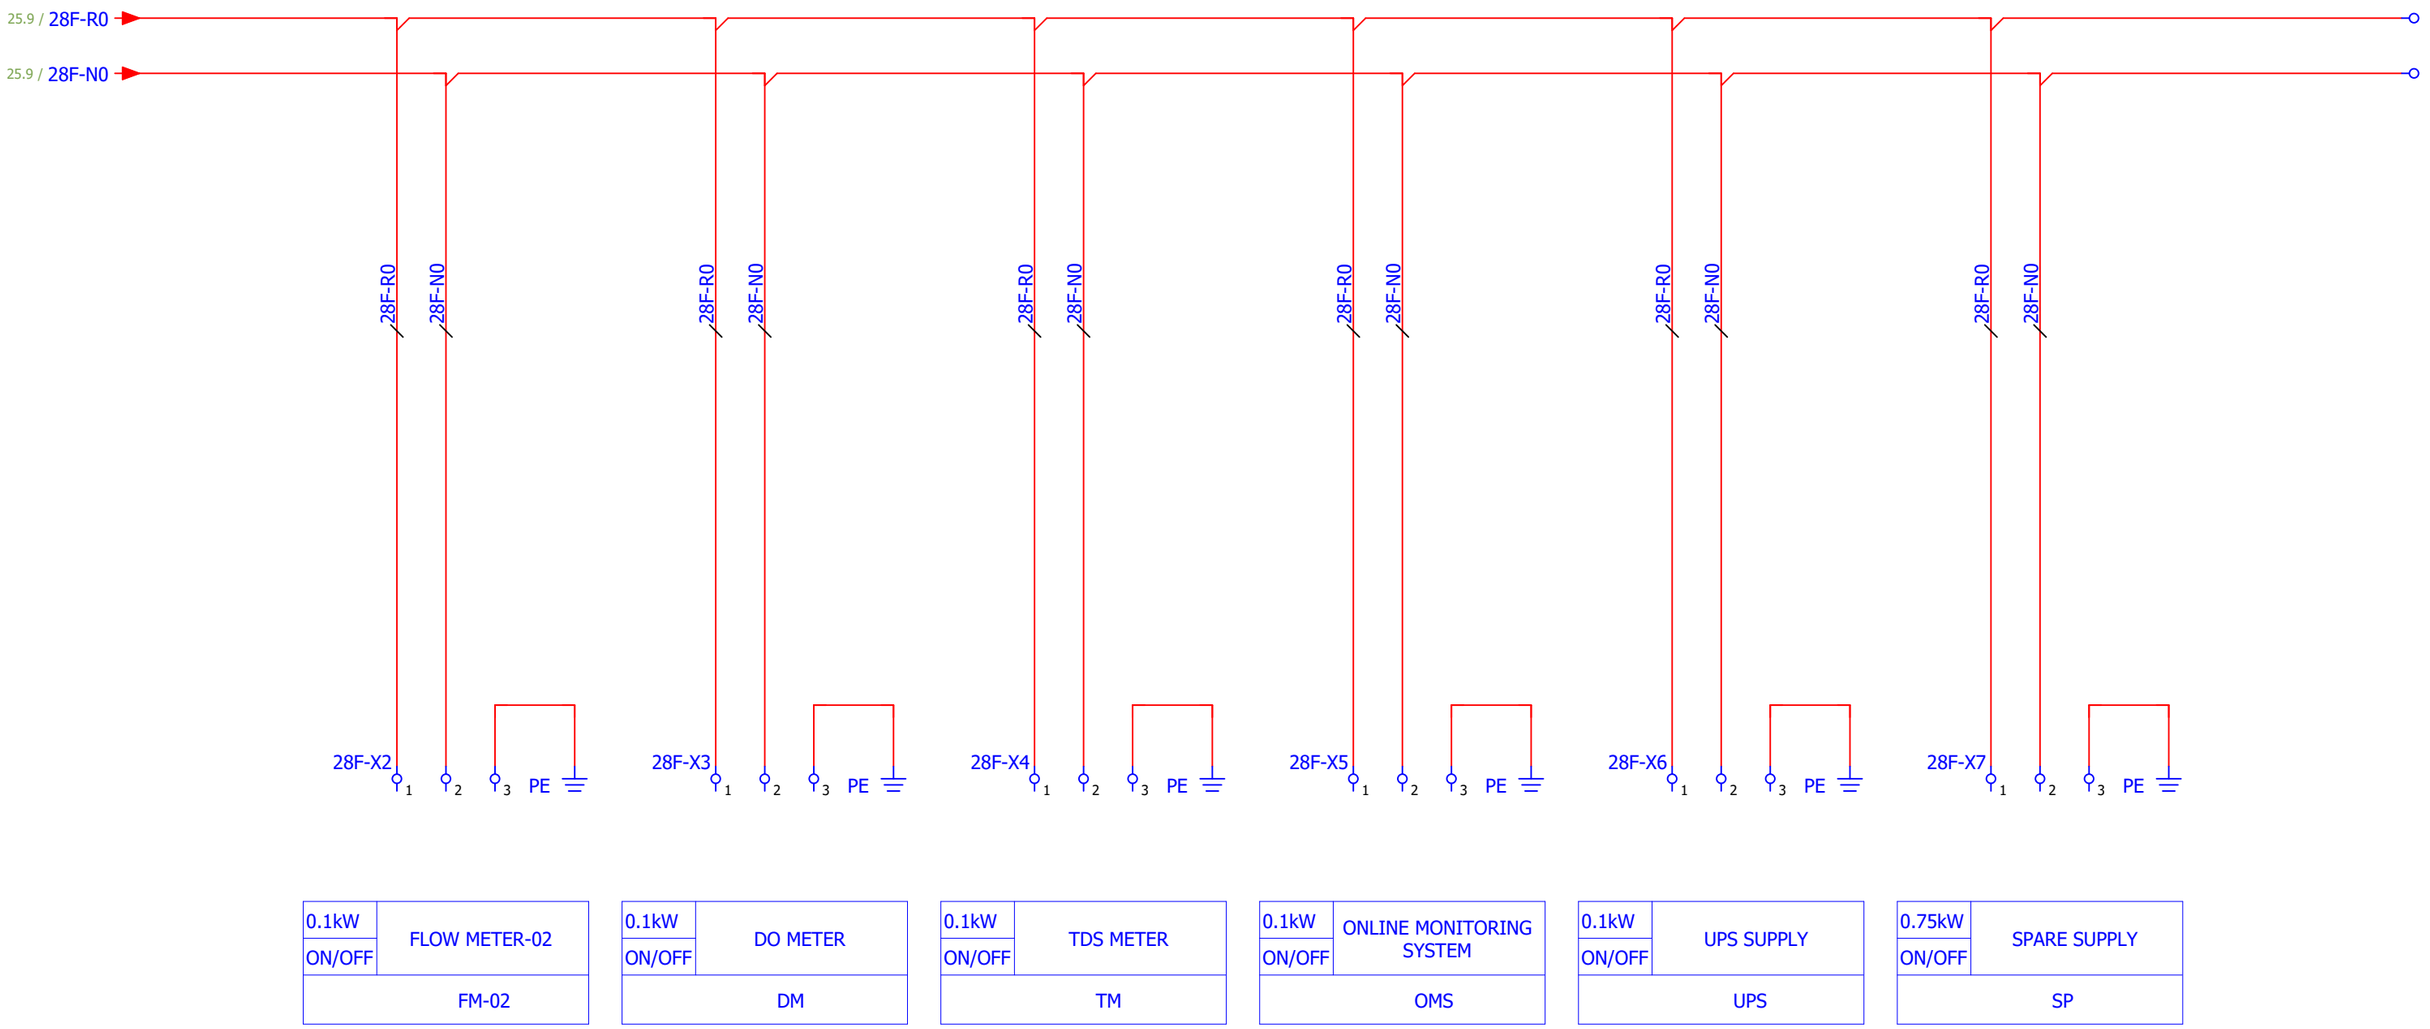


**AQUACARESEE PVT. LTD.**
**OFFICE NO.204, 205 AND 206**
**VINAYAK ARCADE, 2ND FLOOR**
**OPP. BAJAJ AUTO, AKURDI,PUNE-411035**
**www.aquacaresee.co.in**

| REVISION | DETAILS | DATE |
|---|---|---|
| 00 | AS BUILT | 23-01-2025 |
| 01 | AS PER COMMENTS | 09-12-2025 |
| 00 | FOR APPROVAL | 04-12-2025 |

TITLE:- DOSING & CITRIC PUMPS & SUPPLY FEEDER

| | |
|---|---|
| DRAWN BY | N.J. |
| CHECKED | V.K. |
| APPROVED | P.B. |

SYSTEM:-375 KLD MBR STP


PROJECT:- 375 KLD MBR STP PLANT CONTROL PANEL

DRG. NO.:PRG-2526-637 | SHEET NO. 27 / 47 | REV.NO. AS BUILT

# PLC WIRING DIAGRAM

**AQUACARESEE PVT. LTD.**
**OFFICE NO.204, 205 AND 206**
**VINAYAK ARCADE, 2ND FLOOR**
**OPP. BAJAJ AUTO, AKURDI,PUNE-411035**
**www.aquacaresee.co.in**

| REVISION | DETAILS | DATE | | | |
|---|---|---|---|---|---|
| 00 | AS BUILT | 23-01-2025 | TITLE:- PLC WIRING DIAGRAM | | SYSTEM:-375 KLD MBR STP |
| 01 | AS PER COMMENTS | 09-12-2025 | DRAWN BY | N.J. | PROJECT:- 375 KLD MBR STP PLANT CONTROL PANEL |
| 00 | FOR APPROVAL | 04-12-2025 | CHECKED | V.K. | |
| | | | APPROVED | P.B. | DRG. NO.:PRG-2526-637 / SHEET NO. 28 / 47 / REV.NO. AS BUILT |

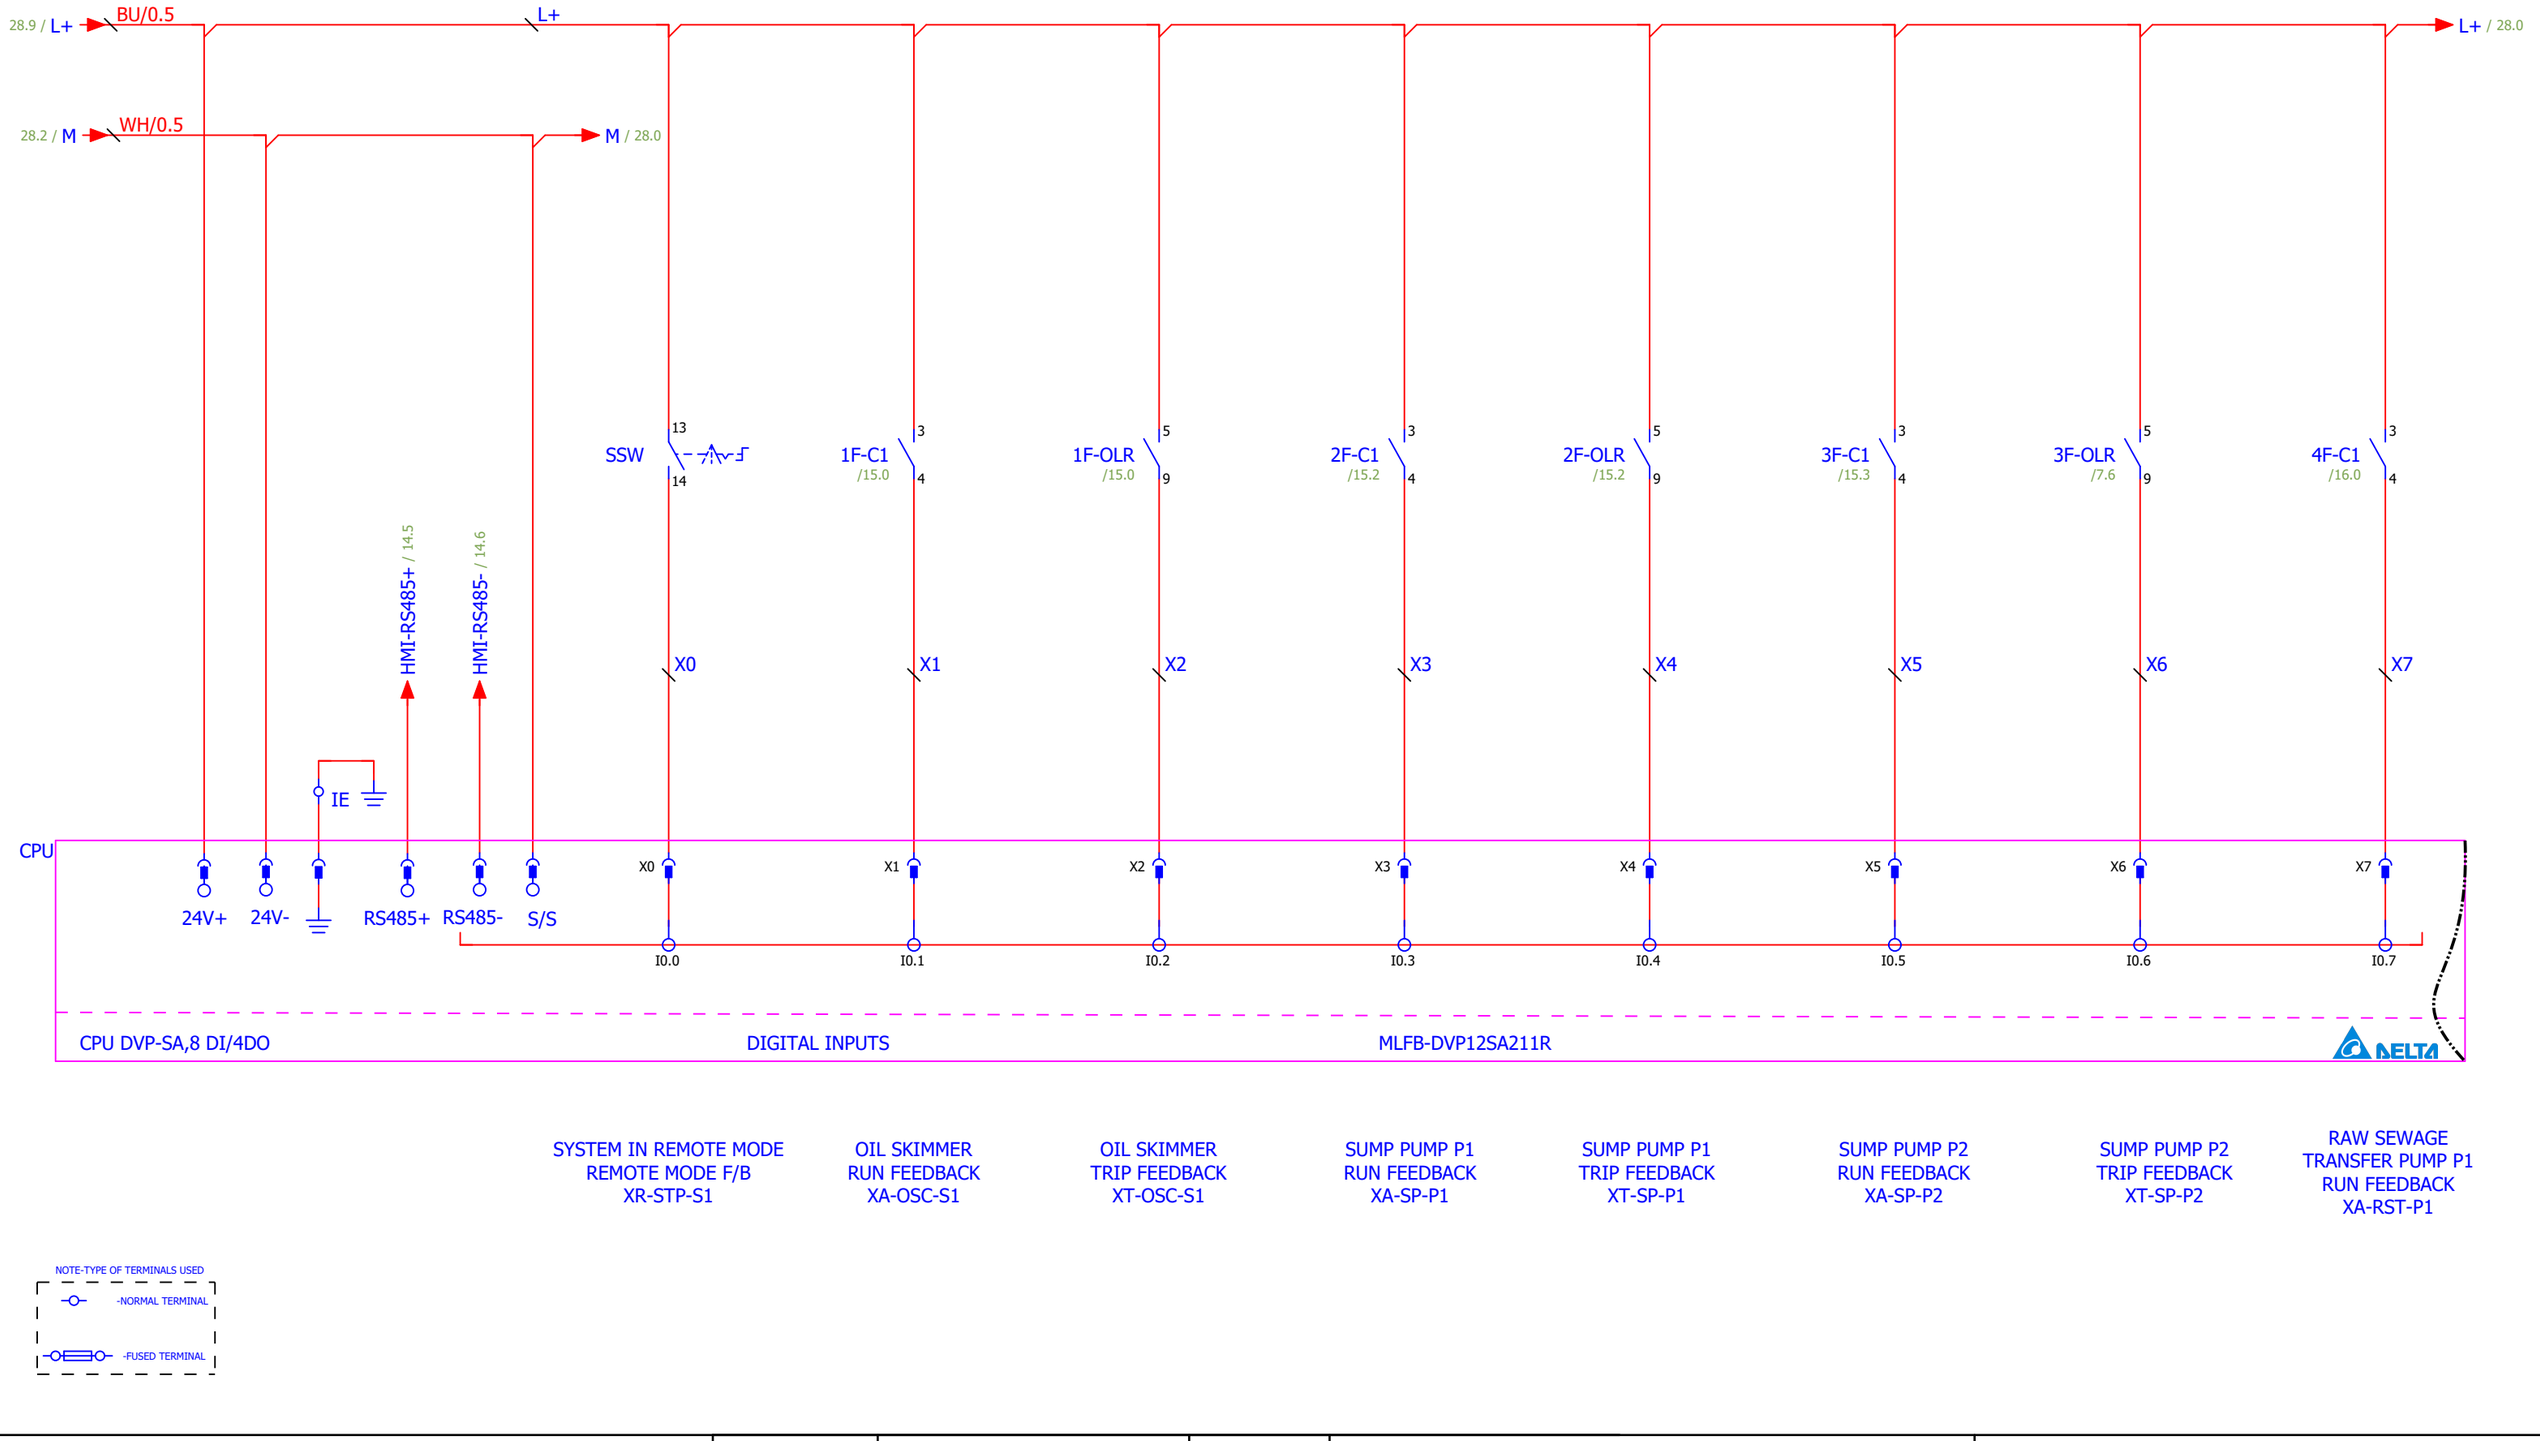


**AQUACARESEE PVT. LTD.**
**OFFICE NO.204, 205 AND 206**
**VINAYAK ARCADE, 2ND FLOOR**
**OPP. BAJAJ AUTO, AKURDI,PUNE-411035**
**www.aquacaresee.co.in**

| REVISION | DETAILS | DATE |
|---|---|---|
| 00 | AS BUILT | 23-01-2025 |
| 01 | AS PER COMMENTS | 09-12-2025 |
| 00 | FOR APPROVAL | 04-12-2025 |


TITLE:- CPU-DIGITAL INPUT WIRING

| | |
|---|---|
| DRAWN BY | N.J. |
| CHECKED | V.K. |
| APPROVED | P.B. |

SYSTEM:-375 KLD MBR STP

PROJECT:- 375 KLD MBR STP PLANT CONTROL PANEL

DRG. NO.:PRG-2526-637 | SHEET NO. 29 / 47 | REV.NO. AS BUILT

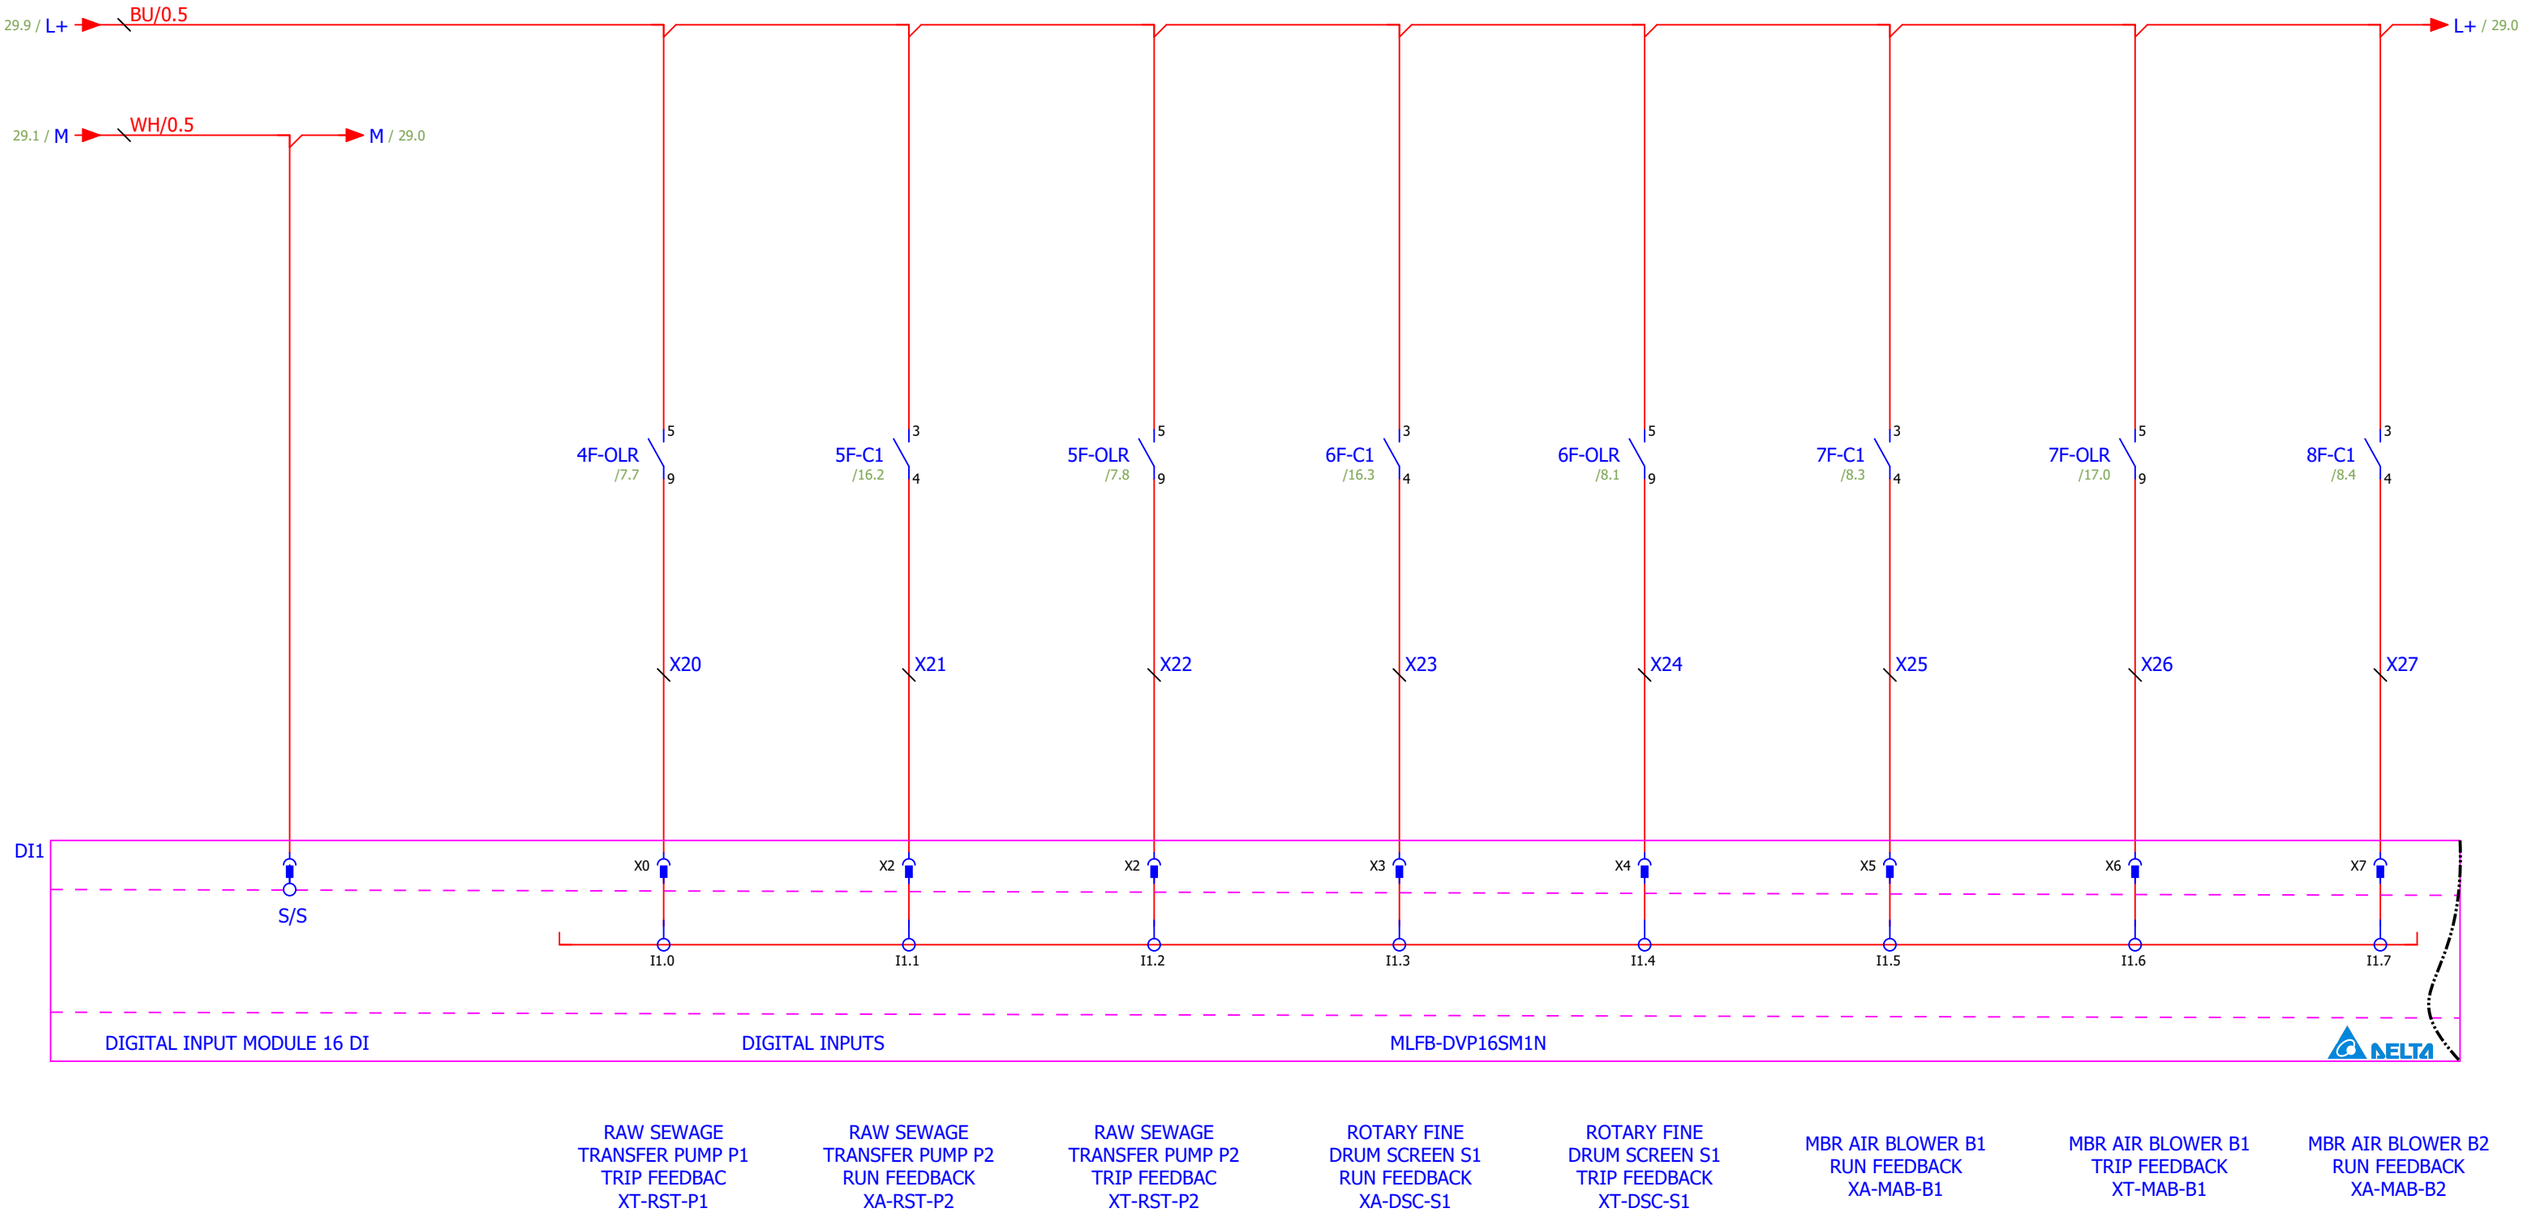


**AQUACARESEE PVT. LTD.**
**OFFICE NO.204, 205 AND 206**
**VINAYAK ARCADE, 2ND FLOOR**
**OPP. BAJAJ AUTO, AKURDI,PUNE-411035**
**www.aquacaresee.co.in**

| REVISION | DETAILS | DATE |
|---|---|---|
| 00 | AS BUILT | 23-01-2025 |
| 01 | AS PER COMMENTS | 09-12-2025 |
| 00 | FOR APPROVAL | 04-12-2025 |


TITLE:- DIGITAL INPUT MODULE-1 WIRING DIAGRAM

| | |
|---|---|
| DRAWN BY | N.J. |
| CHECKED | V.K. |
| APPROVED | P.B. |

SYSTEM:-375 KLD MBR STP

PROJECT:- 375 KLD MBR STP PLANT CONTROL PANEL

DRG. NO.:PRG-2526-637 | SHEET NO. 30 / 47 | REV.NO. AS BUILT

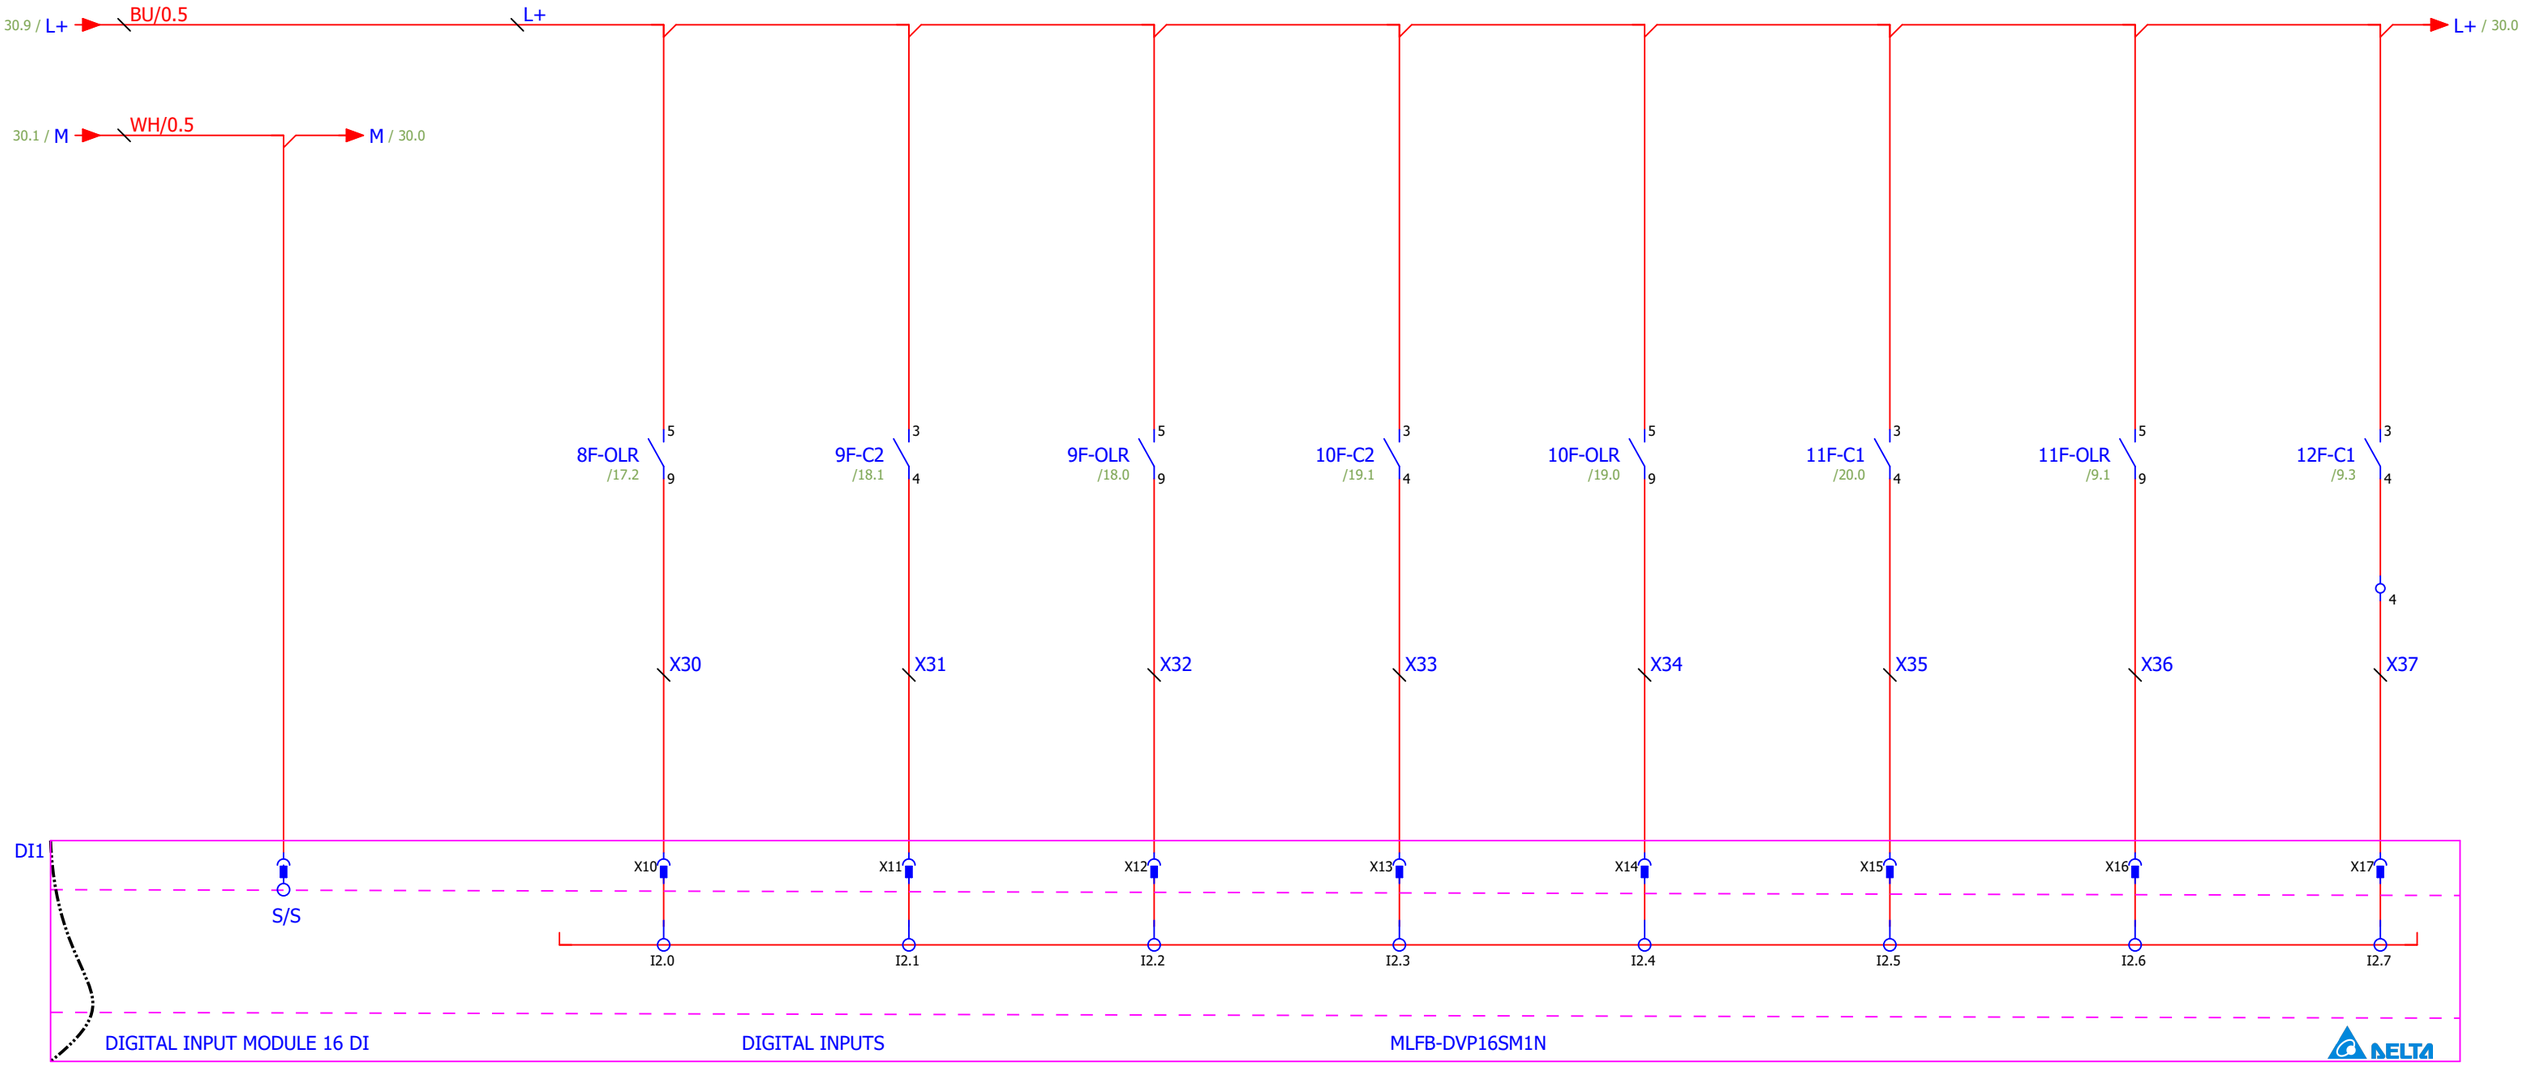


MBR AIR BLOWER B2 TRIP FEEDBACK XT-MAB-B2

AERATION TANK AIR BLOWER B1 RUN FEEDBACK XA-AAB-B1

AERATION TANK AIR BLOWER B1 TRIP FEEDBACK XT-AAB-B1

AERATION TANK AIR BLOWER B2 RUN FEEDBACK XA-AAB-B2

AERATION TANK AIR BLOWER B2 TRIP FEEDBACK XT-AAB-B2

MBR PERMEATE PUMP P1 RUN FEEDBACK XA-MPP-P1

MBR PERMEATE PUMP P1 TRIP FEEDBACK XT-MPP-P1

MBR PERMEATE PUMP P2 RUN FEEDBACK XA-MPP-P2

NOTE-TYPE OF TERMINALS USED

-NORMAL TERMINAL

-FUSED TERMINAL

**AQUACARESEE PVT. LTD.**

**OFFICE NO.204, 205 AND 206**
**VINAYAK ARCADE, 2ND FLOOR**
**OPP. BAJAJ AUTO, AKURDI,PUNE-411035**
**www.aquacaresee.co.in**

| REVISION | DETAILS | DATE |
|---|---|---|
| 00 | AS BUILT | 23-01-2025 |
| 01 | AS PER COMMENTS | 09-12-2025 |
| 00 | FOR APPROVAL | 04-12-2025 |


TITLE:- DIGITAL INPUT MODULE-1 WIRING DIAGRAM

| | |
|---|---|
| DRAWN BY | N.J. |
| CHECKED | V.K. |
| APPROVED | P.B. |

SYSTEM:-375 KLD MBR STP

PROJECT:- 375 KLD MBR STP PLANT CONTROL PANEL

DRG. NO.:PRG-2526-637 | SHEET NO. 31 / 47 | REV.NO. AS BUILT

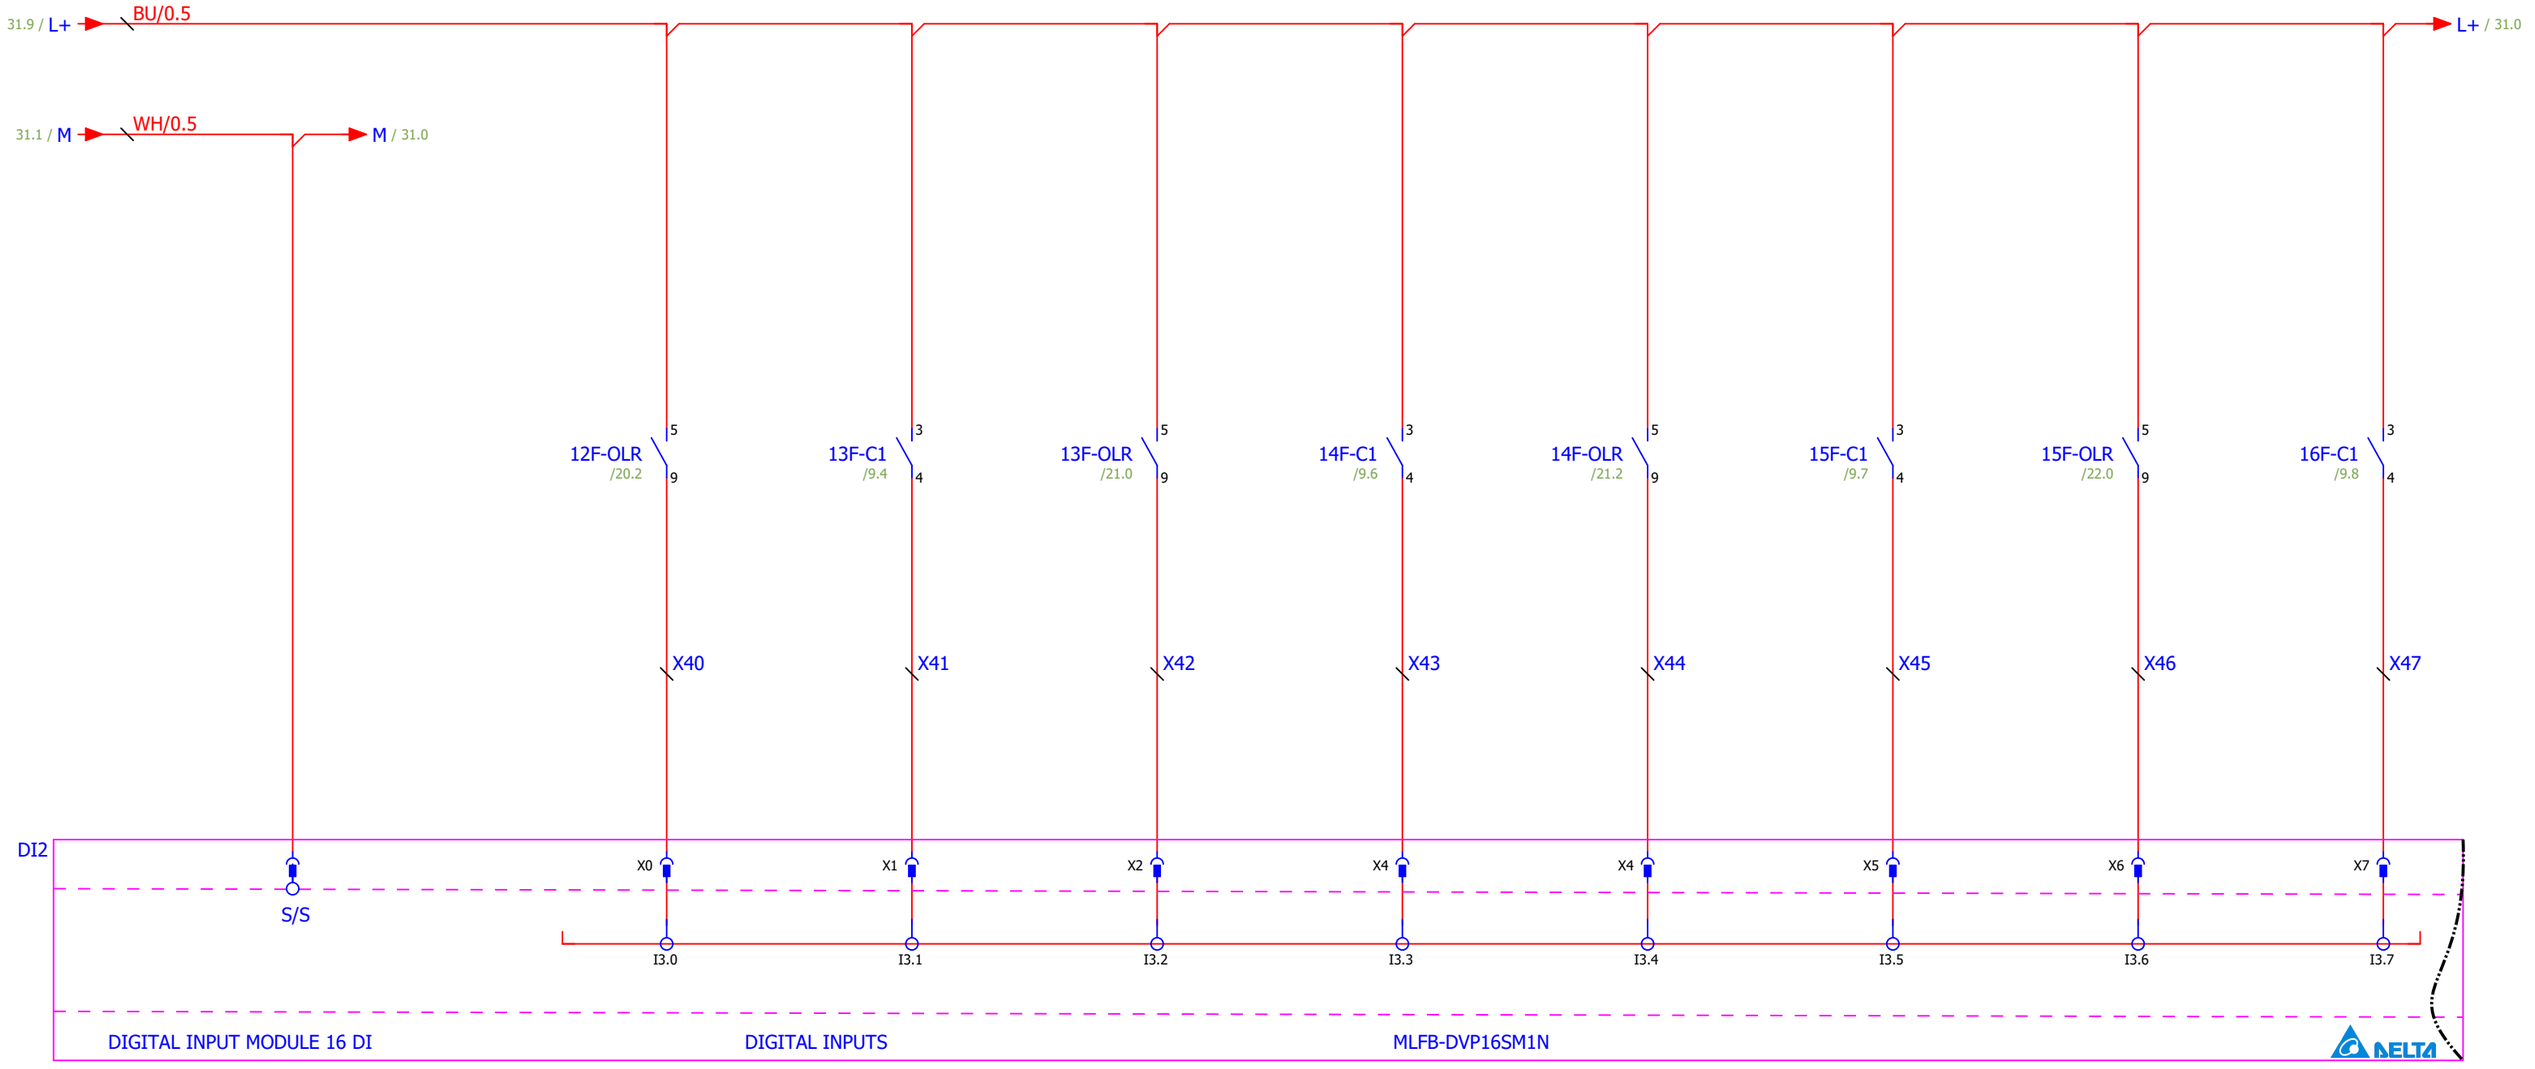


**AQUACARESEE PVT. LTD.**
**OFFICE NO.204, 205 AND 206**
**VINAYAK ARCADE, 2ND FLOOR**
**OPP. BAJAJ AUTO, AKURDI,PUNE-411035**
**www.aquacaresee.co.in**

| REVISION | DETAILS | DATE |
|---|---|---|
| 00 | AS BUILT | 23-01-2025 |
| 01 | AS PER COMMENTS | 09-12-2025 |
| 00 | FOR APPROVAL | 04-12-2025 |


TITLE:- DIGITAL INPUT MODULE-2 WIRING DIAGRAM

| | |
|---|---|
| DRAWN BY | N.J. |
| CHECKED | V.K. |
| APPROVED | P.B. |

SYSTEM:-375 KLD MBR STP

PROJECT:- 375 KLD MBR STP PLANT CONTROL PANEL

DRG. NO.:PRG-2526-637 | SHEET NO. 32 / 47 | REV.NO. AS BUILT

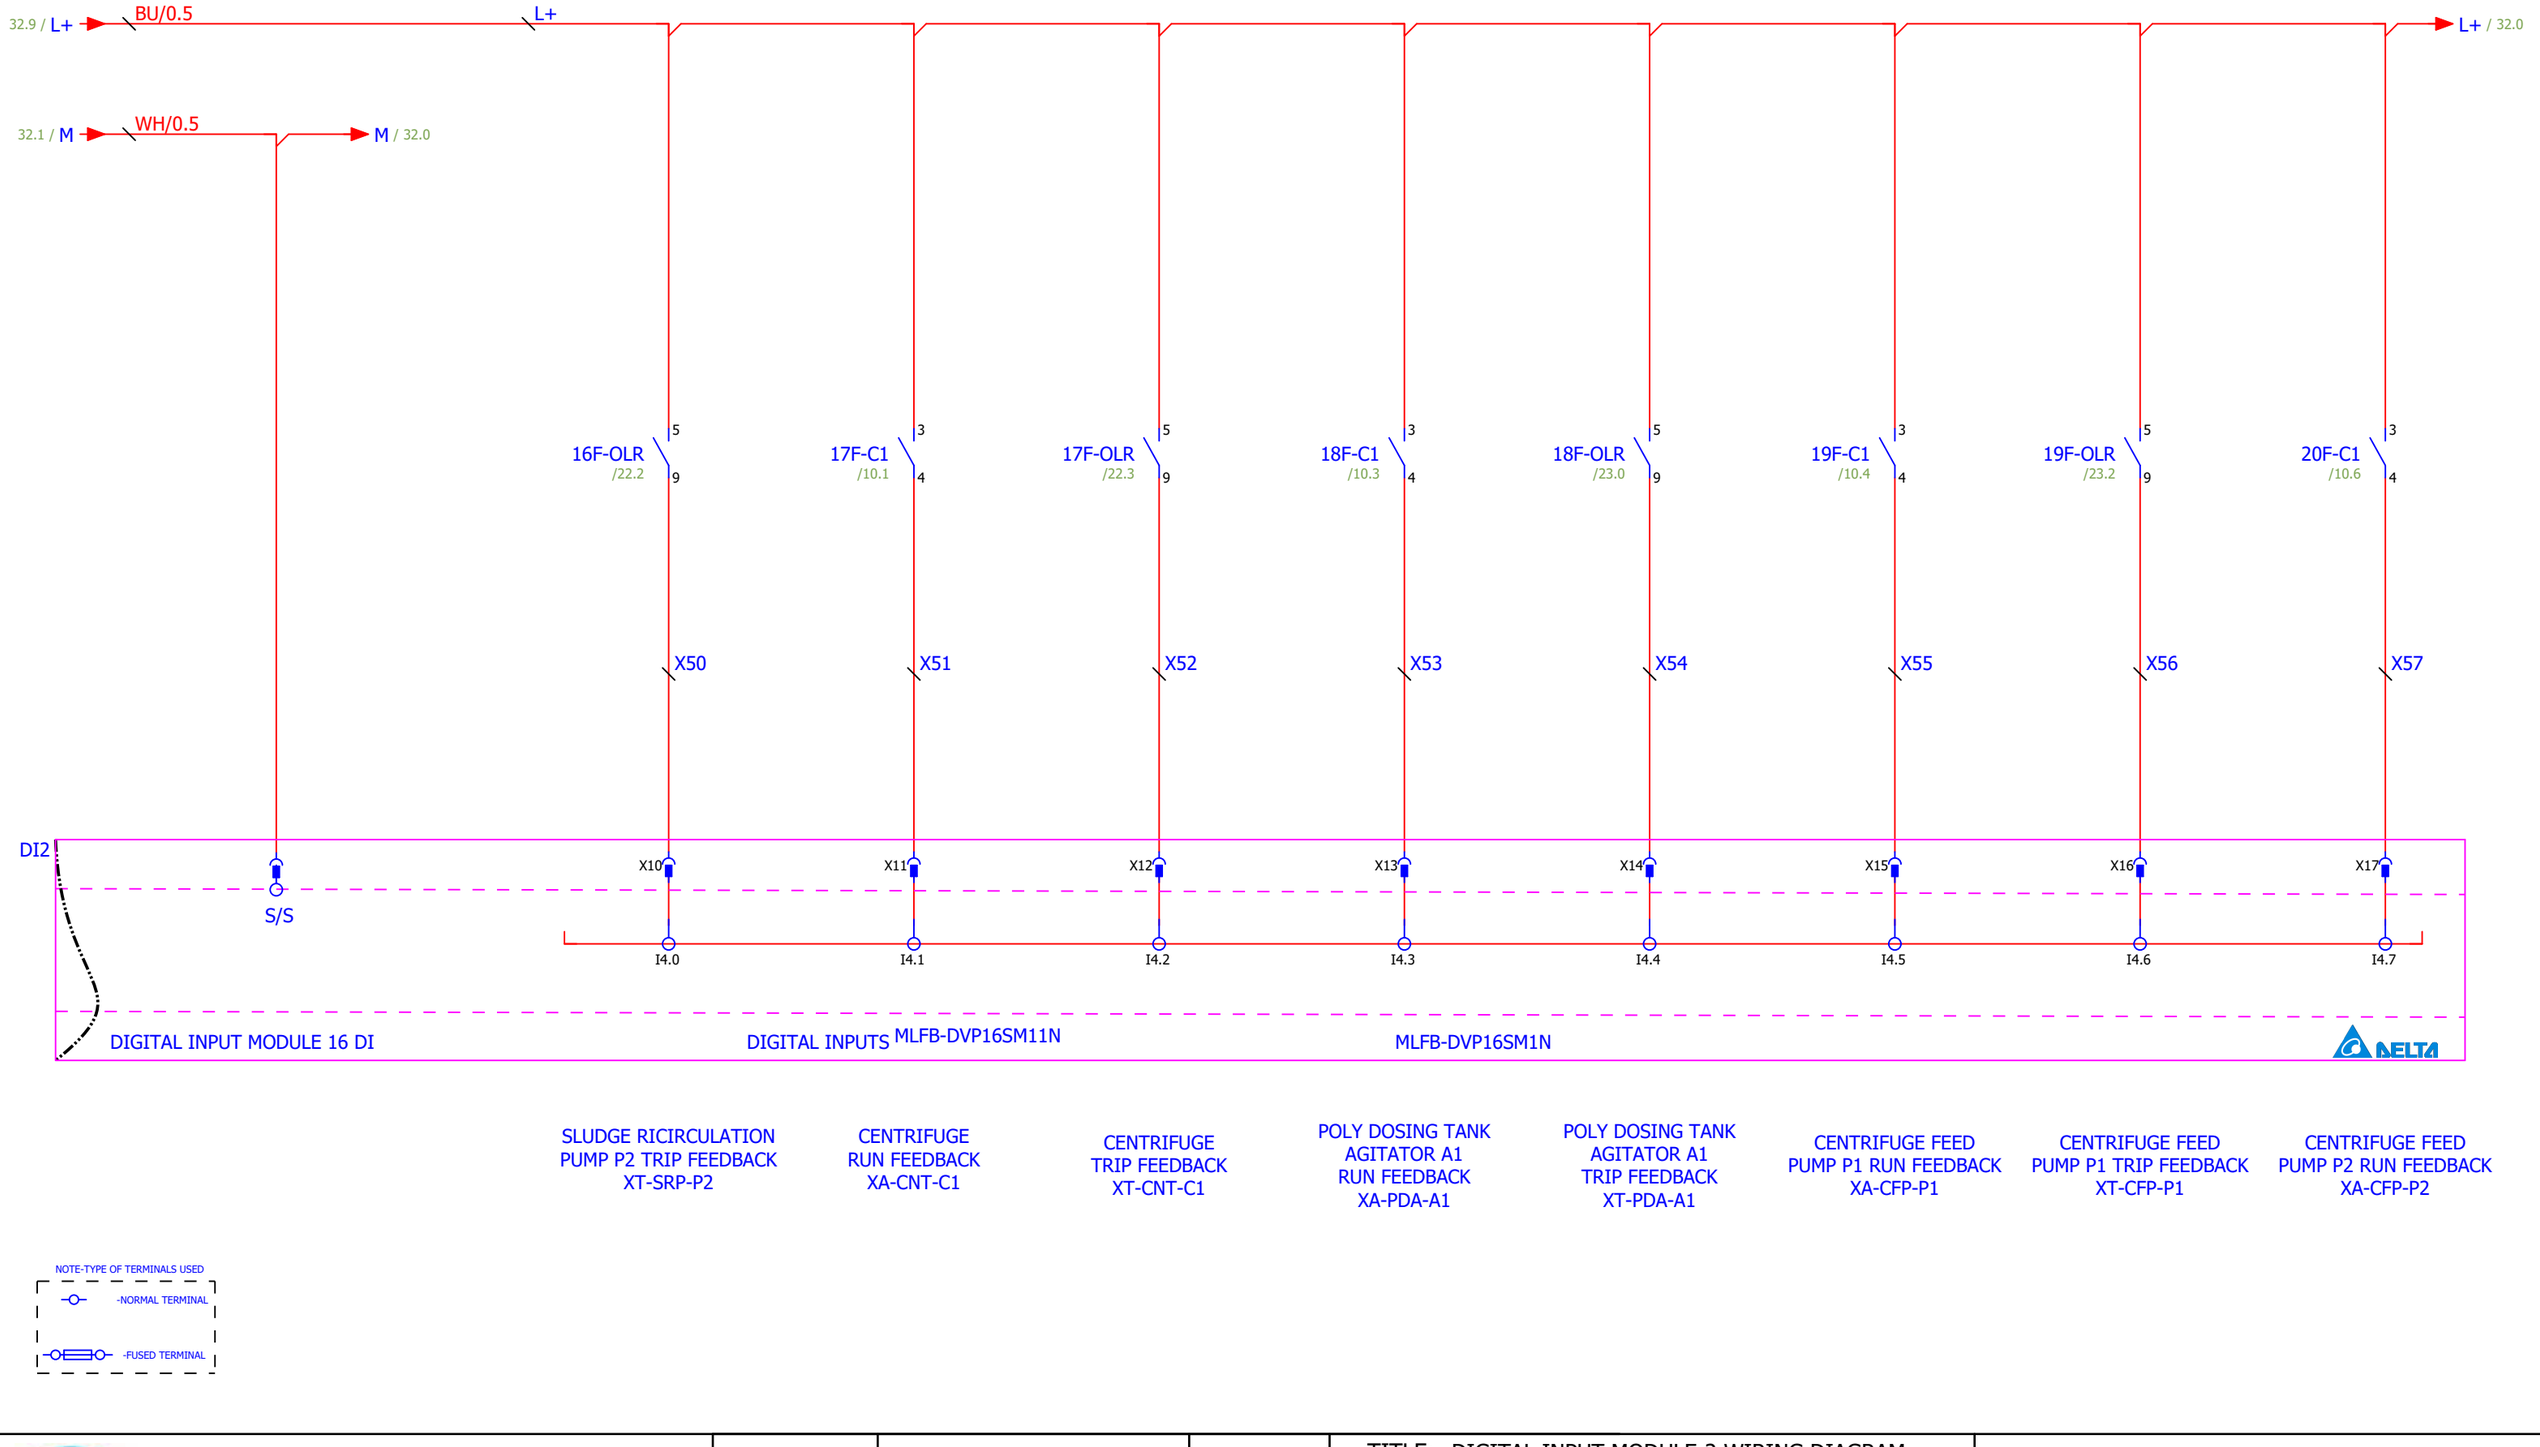


**AQUACARESEE PVT. LTD.**
**OFFICE NO.204, 205 AND 206**
**VINAYAK ARCADE, 2ND FLOOR**
**OPP. BAJAJ AUTO, AKURDI,PUNE-411035**
**www.aquacaresee.co.in**

| REVISION | DETAILS | DATE |
|---|---|---|
| 00 | AS BUILT | 23-01-2025 |
| 01 | AS PER COMMENTS | 09-12-2025 |
| 00 | FOR APPROVAL | 04-12-2025 |


TITLE:- DIGITAL INPUT MODULE-2 WIRING DIAGRAM

| | |
|---|---|
| DRAWN BY | N.J. |
| CHECKED | V.K. |
| APPROVED | P.B. |

SYSTEM:-375 KLD MBR STP

PROJECT:- 375 KLD MBR STP PLANT CONTROL PANEL

DRG. NO.:PRG-2526-637 | SHEET NO. 33 / 47 | REV.NO. AS BUILT

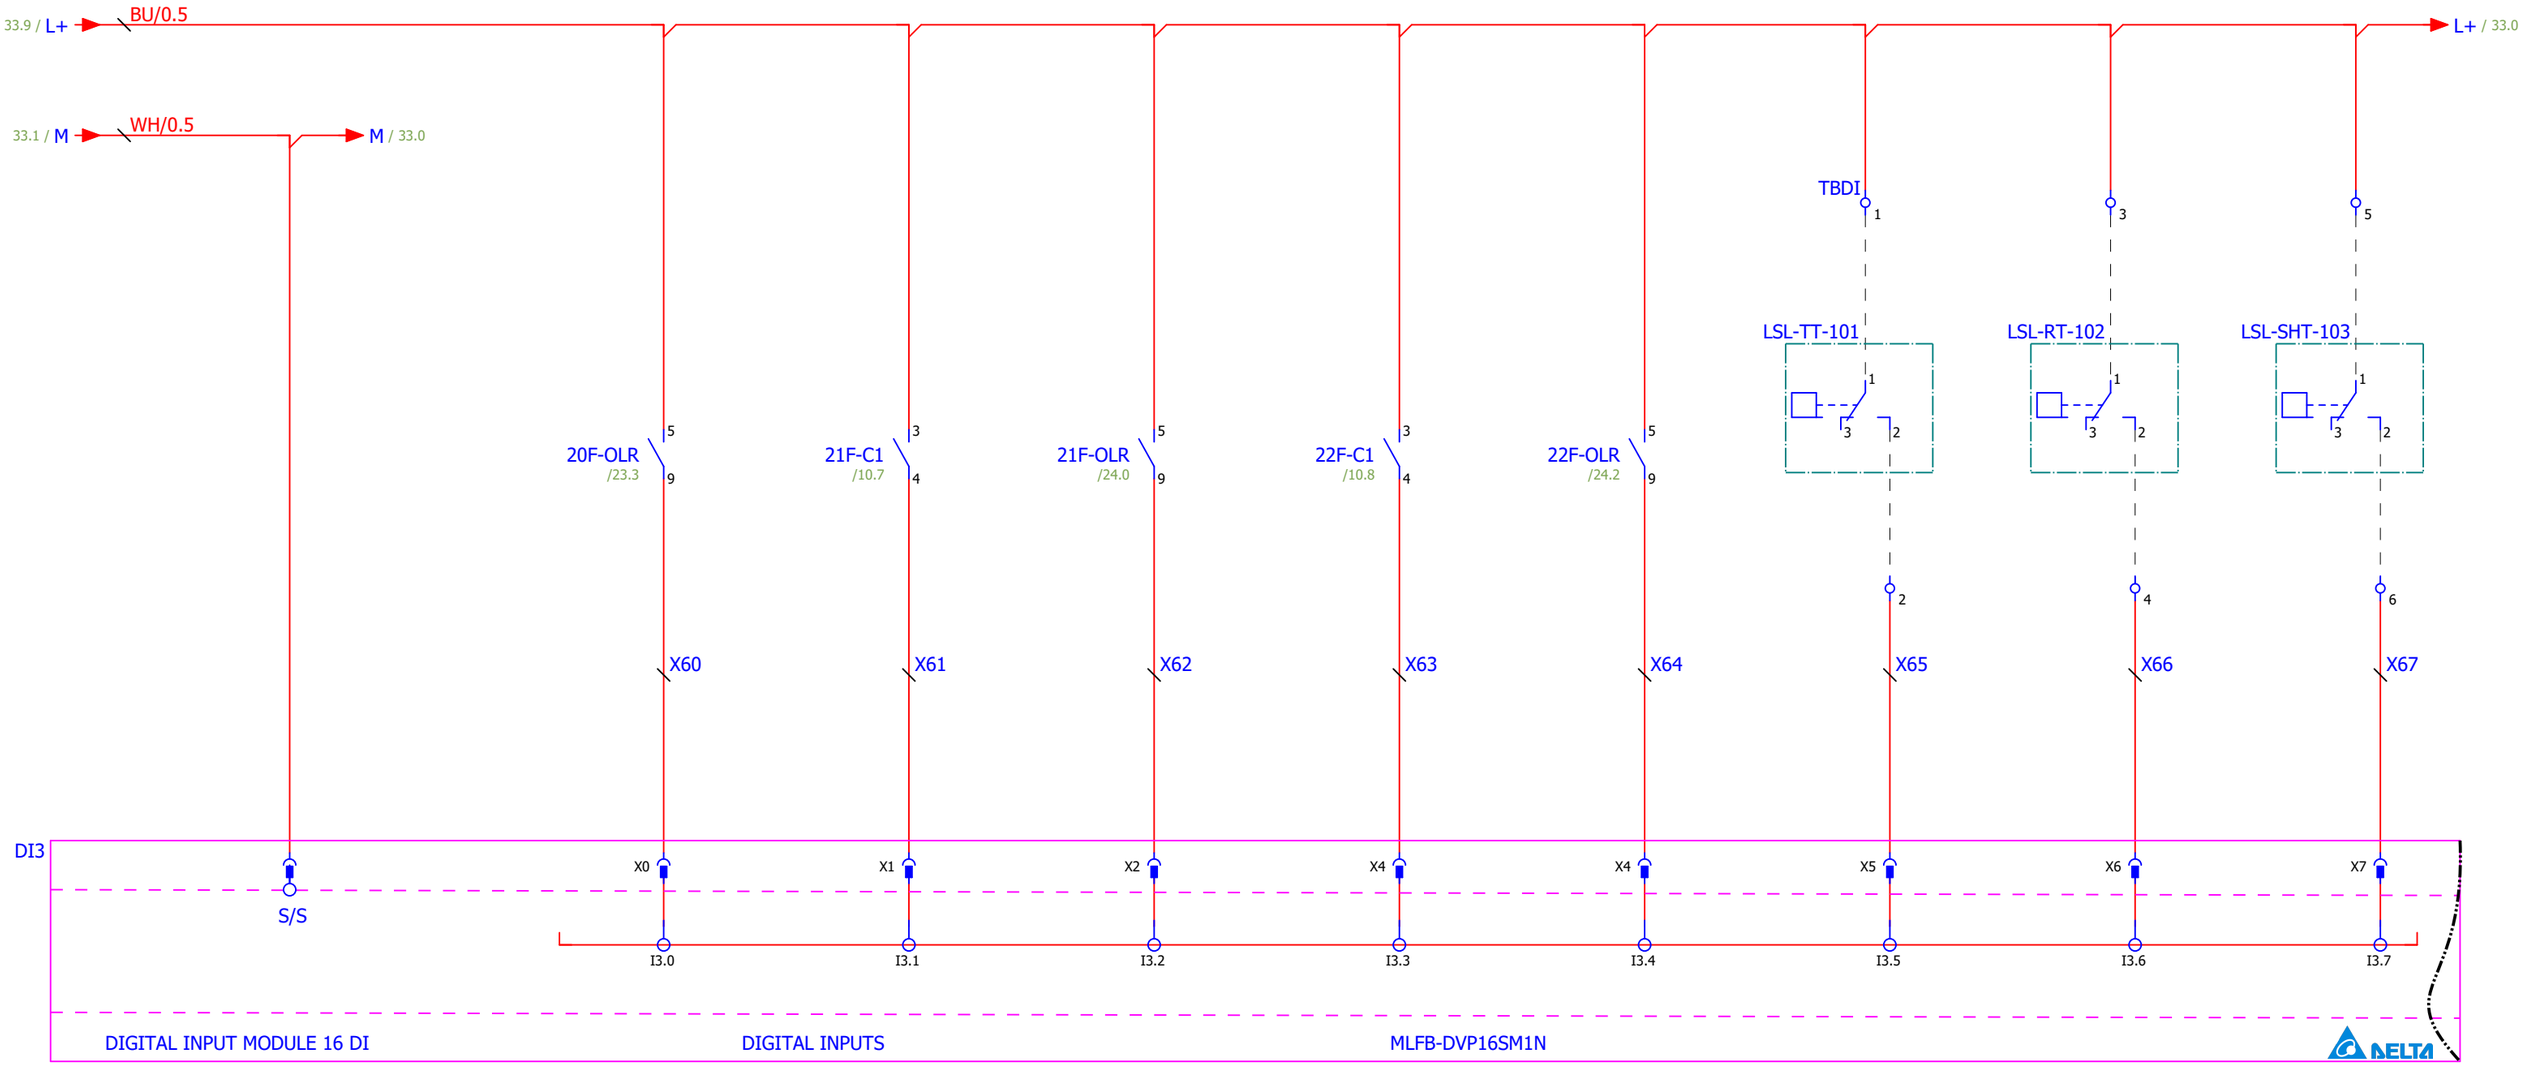


| | | | | |
|---|---|---|---|---|
| CENTRIFUGE FEED PUMP P2 TRIP FEEDBACK XT-CFP-P2 | ANOXIC RECIRCULATION PUMP P1RUN FEEDBACK XA-ARP-P1 | ANOXIC RECIRCULATION PUMP P1 TRIP FEEDBACK XT-ARP-P1 | ANOXIC RECIRCULATION PUMP P2 RUN FEEDBACK XA-ARP-P2 | ANOXIC RECIRCULATION PUMP P2 TRIP FEEDBACK XT-ARP-P2 |

| | | |
|---|---|---|
| TREATED WATER TANK LEVEL SWITCH LSL-TT-101 | RAW WATER TANK LEVEL SWITCH LSL-RT-102 | SLUDGE HOLDING TANK LEVEL SWITCH LSL-SHT-103 |

NOTE-TYPE OF TERMINALS USED
-NORMAL TERMINAL
-FUSED TERMINAL

**AQUACARESEE PVT. LTD.**
**OFFICE NO.204, 205 AND 206**
**VINAYAK ARCADE, 2ND FLOOR**
**OPP. BAJAJ AUTO, AKURDI,PUNE-411035**
**www.aquacaresee.co.in**

| REVISION | DETAILS | DATE |
|---|---|---|
| 00 | AS BUILT | 23-01-2025 |
| 01 | AS PER COMMENTS | 09-12-2025 |
| 00 | FOR APPROVAL | 04-12-2025 |


TITLE:- DIGITAL INPUT MODULE-3 WIRING DIAGRAM

| | |
|---|---|
| DRAWN BY | N.J. |
| CHECKED | V.K. |
| APPROVED | P.B. |

SYSTEM:-375 KLD MBR STP

PROJECT:- 375 KLD MBR STP PLANT CONTROL PANEL

| DRG. NO.:PRG-2526-637 | SHEET NO. 34 / 47 | REV.NO. AS BUILT |
|---|---|---|

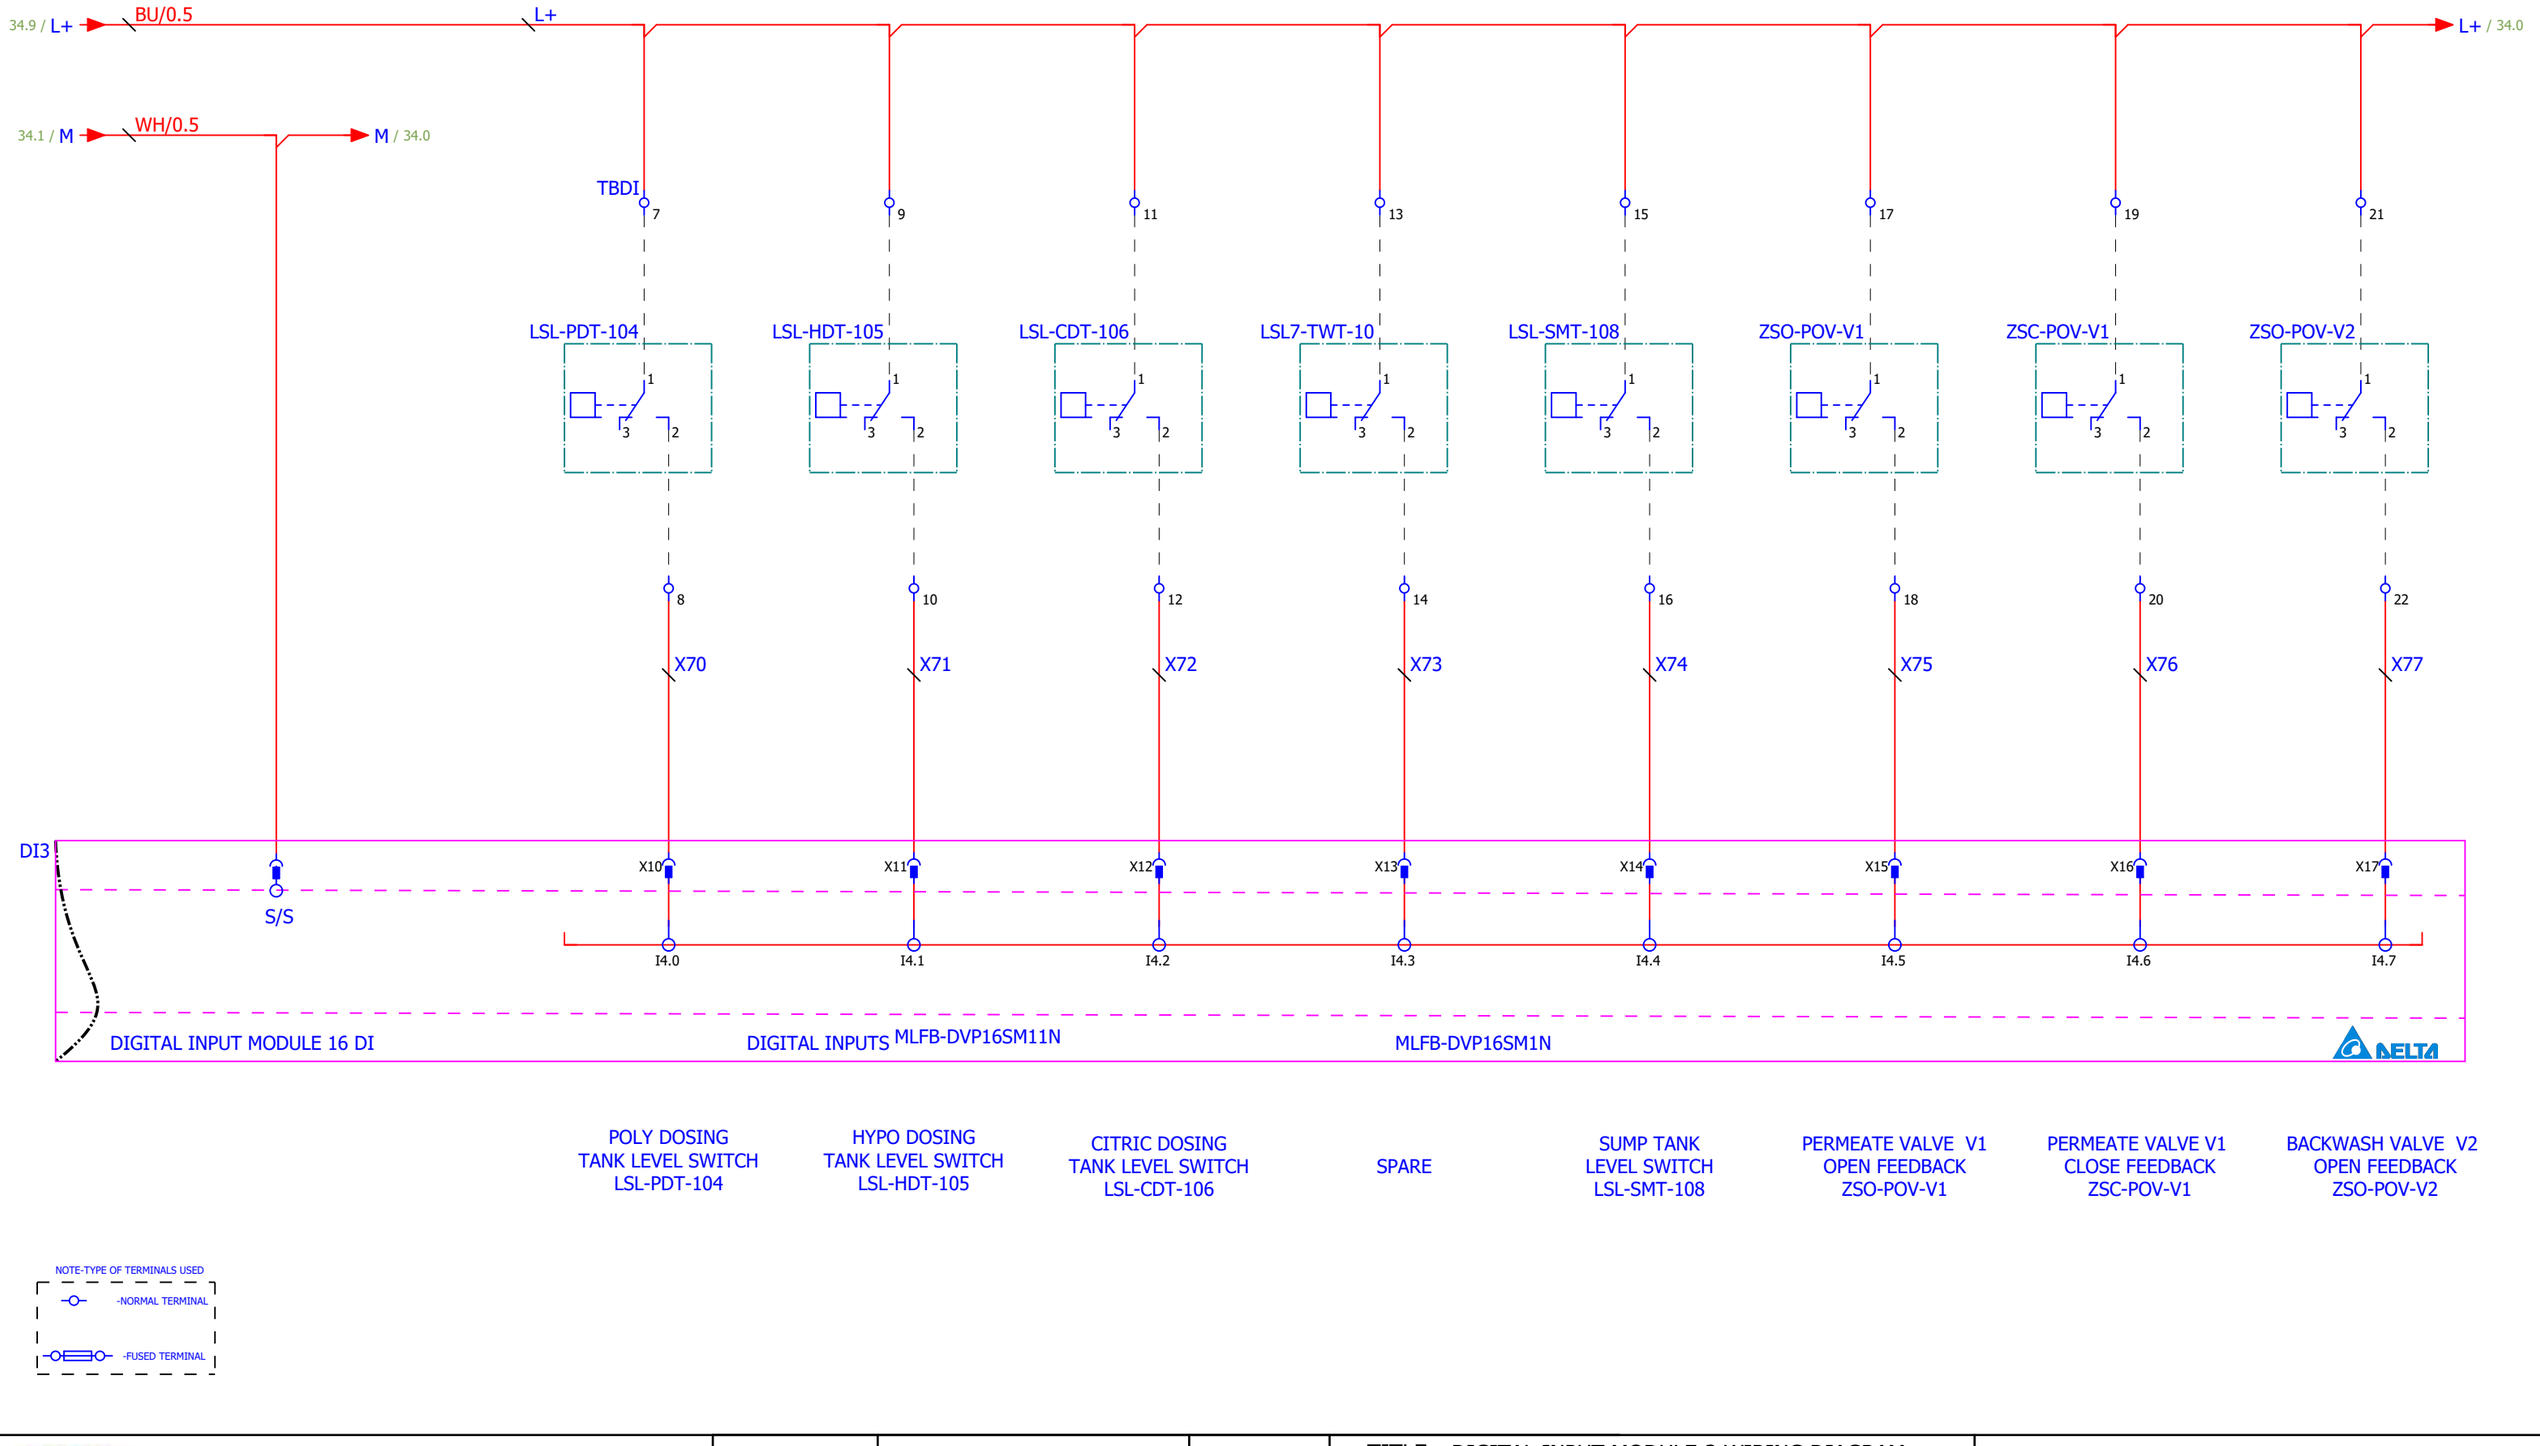


| | | | | | |
|---|---|---|---|---|---|
| POLY DOSING TANK LEVEL SWITCH LSL-PDT-104 | HYPO DOSING TANK LEVEL SWITCH LSL-HDT-105 | CITRIC DOSING TANK LEVEL SWITCH LSL-CDT-106 | SPARE | SUMP TANK LEVEL SWITCH LSL-SMT-108 | PERMEATE VALVE V1 OPEN FEEDBACK ZSO-POV-V1 | PERMEATE VALVE V1 CLOSE FEEDBACK ZSC-POV-V1 | BACKWASH VALVE V2 OPEN FEEDBACK ZSO-POV-V2 |

NOTE-TYPE OF TERMINALS USED
-NORMAL TERMINAL
-FUSED TERMINAL

**AQUACARESEE PVT. LTD.**
**OFFICE NO.204, 205 AND 206**
**VINAYAK ARCADE, 2ND FLOOR**
**OPP. BAJAJ AUTO, AKURDI,PUNE-411035**
**www.aquacaresee.co.in**

| REVISION | DETAILS | DATE |
|---|---|---|
| 00 | AS BUILT | 23-01-2025 |
| 01 | AS PER COMMENTS | 09-12-2025 |
| 00 | FOR APPROVAL | 04-12-2025 |


TITLE:- DIGITAL INPUT MODULE-3 WIRING DIAGRAM

| | |
|---|---|
| DRAWN BY | N.J. |
| CHECKED | V.K. |
| APPROVED | P.B. |

SYSTEM:-375 KLD MBR STP

PROJECT:- 375 KLD MBR STP PLANT CONTROL PANEL

DRG. NO.:PRG-2526-637 | SHEET NO. 35 / 47 | REV.NO. AS BUILT

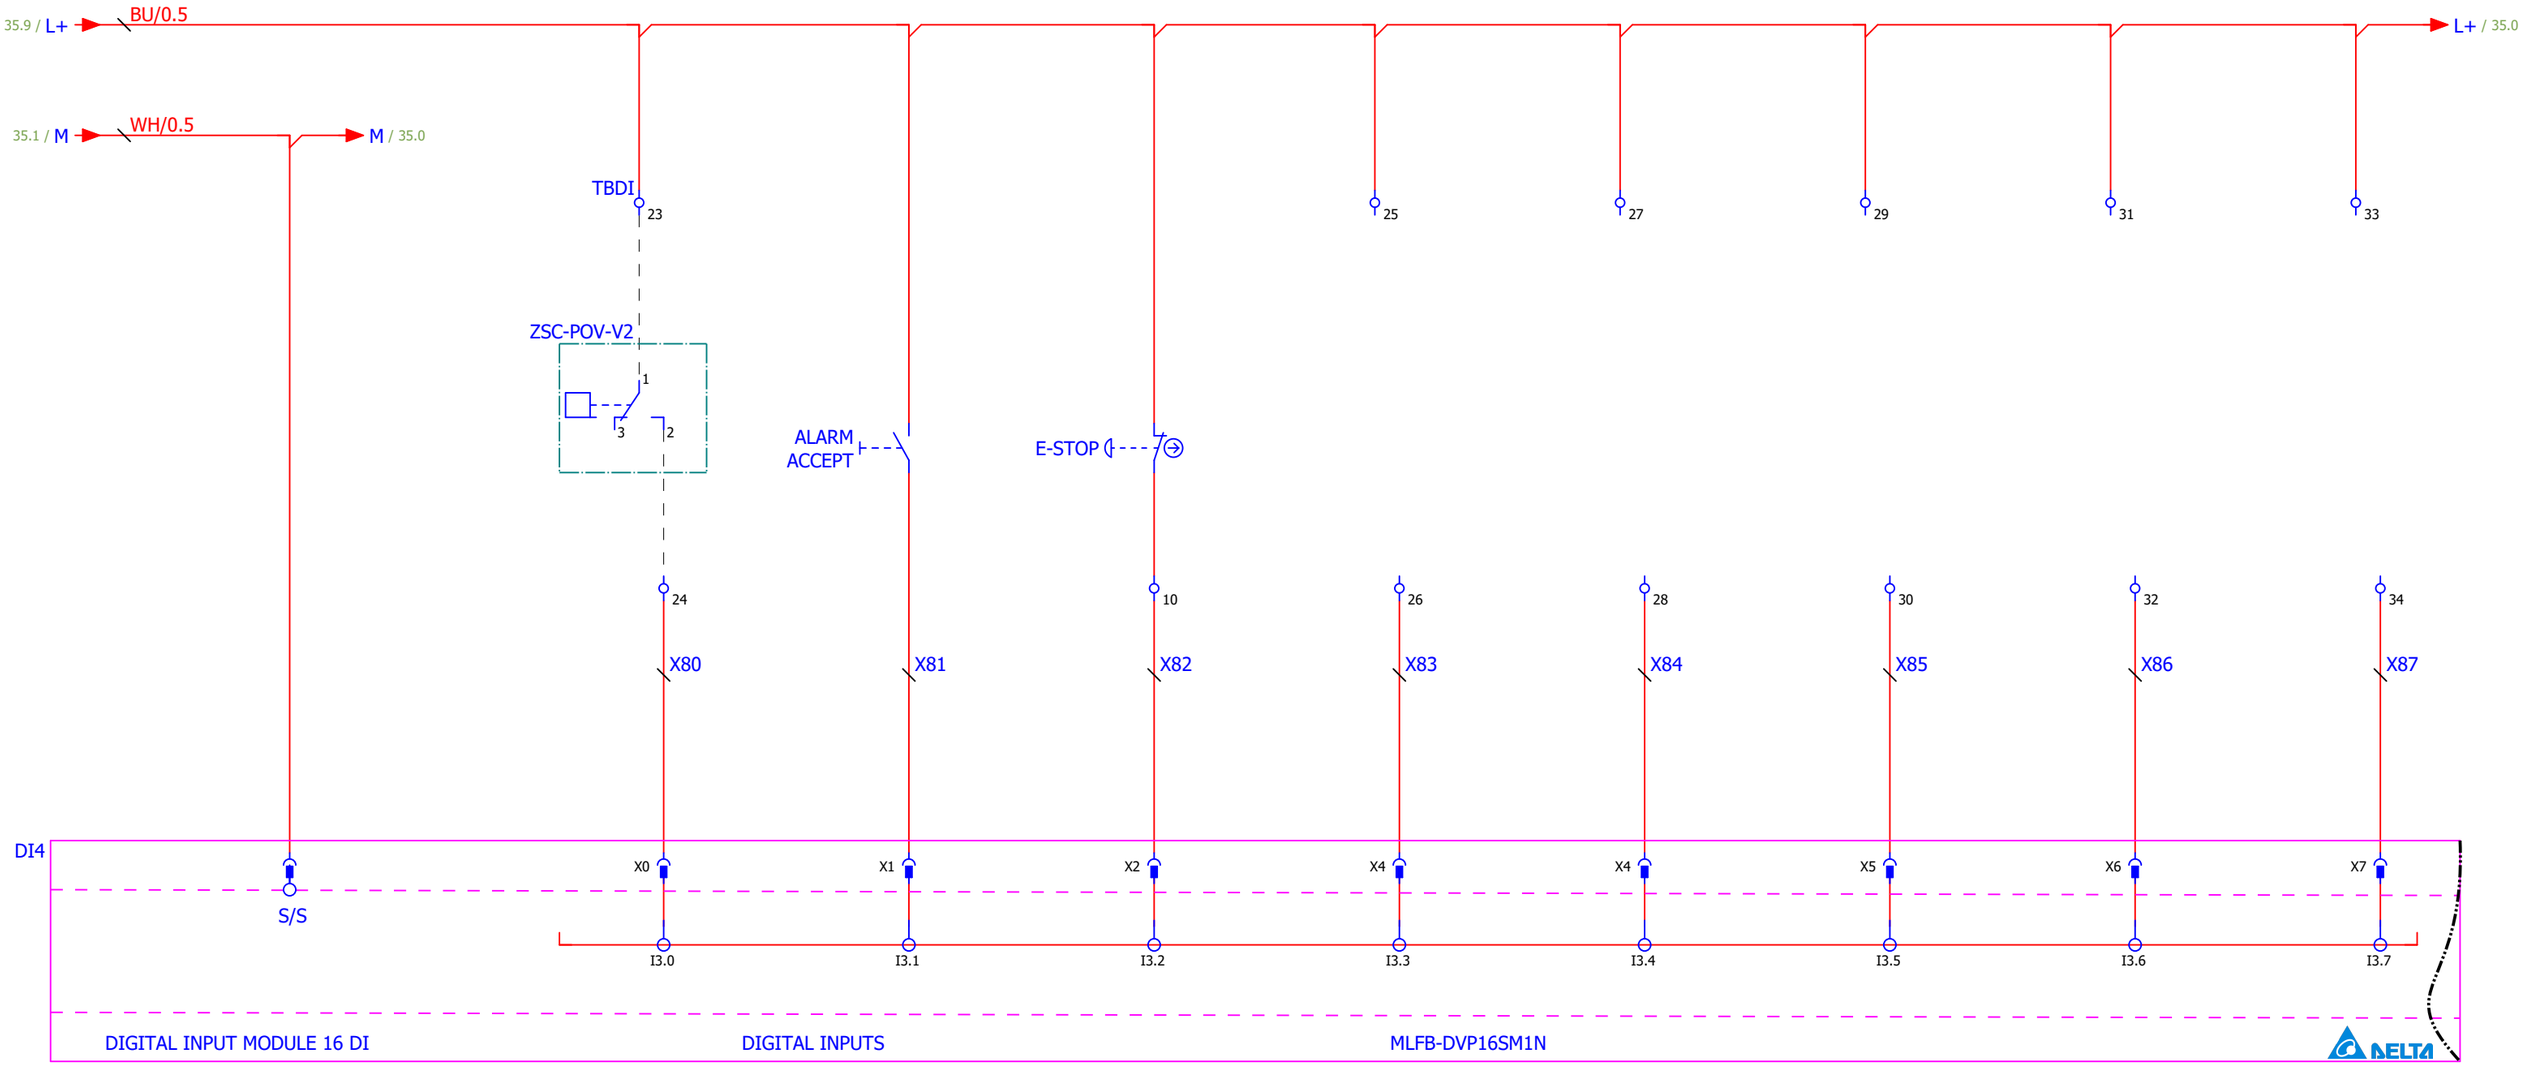


NOTE-TYPE OF TERMINALS USED

-NORMAL TERMINAL

-FUSED TERMINAL

**AQUACARESEE PVT. LTD.**

**OFFICE NO.204, 205 AND 206**
**VINAYAK ARCADE, 2ND FLOOR**
**OPP. BAJAJ AUTO, AKURDI,PUNE-411035**
**www.aquacaresee.co.in**

| REVISION | DETAILS | DATE |
|---|---|---|
| 00 | AS BUILT | 23-01-2025 |
| 01 | AS PER COMMENTS | 09-12-2025 |
| 00 | FOR APPROVAL | 04-12-2025 |


| | |
|---|---|
| DRAWN BY | N.J. |
| CHECKED | V.K. |
| APPROVED | P.B. |

TITLE:- DIGITAL INPUT MODULE-4 WIRING DIAGRAM

SYSTEM:-375 KLD MBR STP

PROJECT:- 375 KLD MBR STP PLANT CONTROL PANEL

DRG. NO.:PRG-2526-637 | SHEET NO. 36 / 47 | REV.NO. AS BUILT

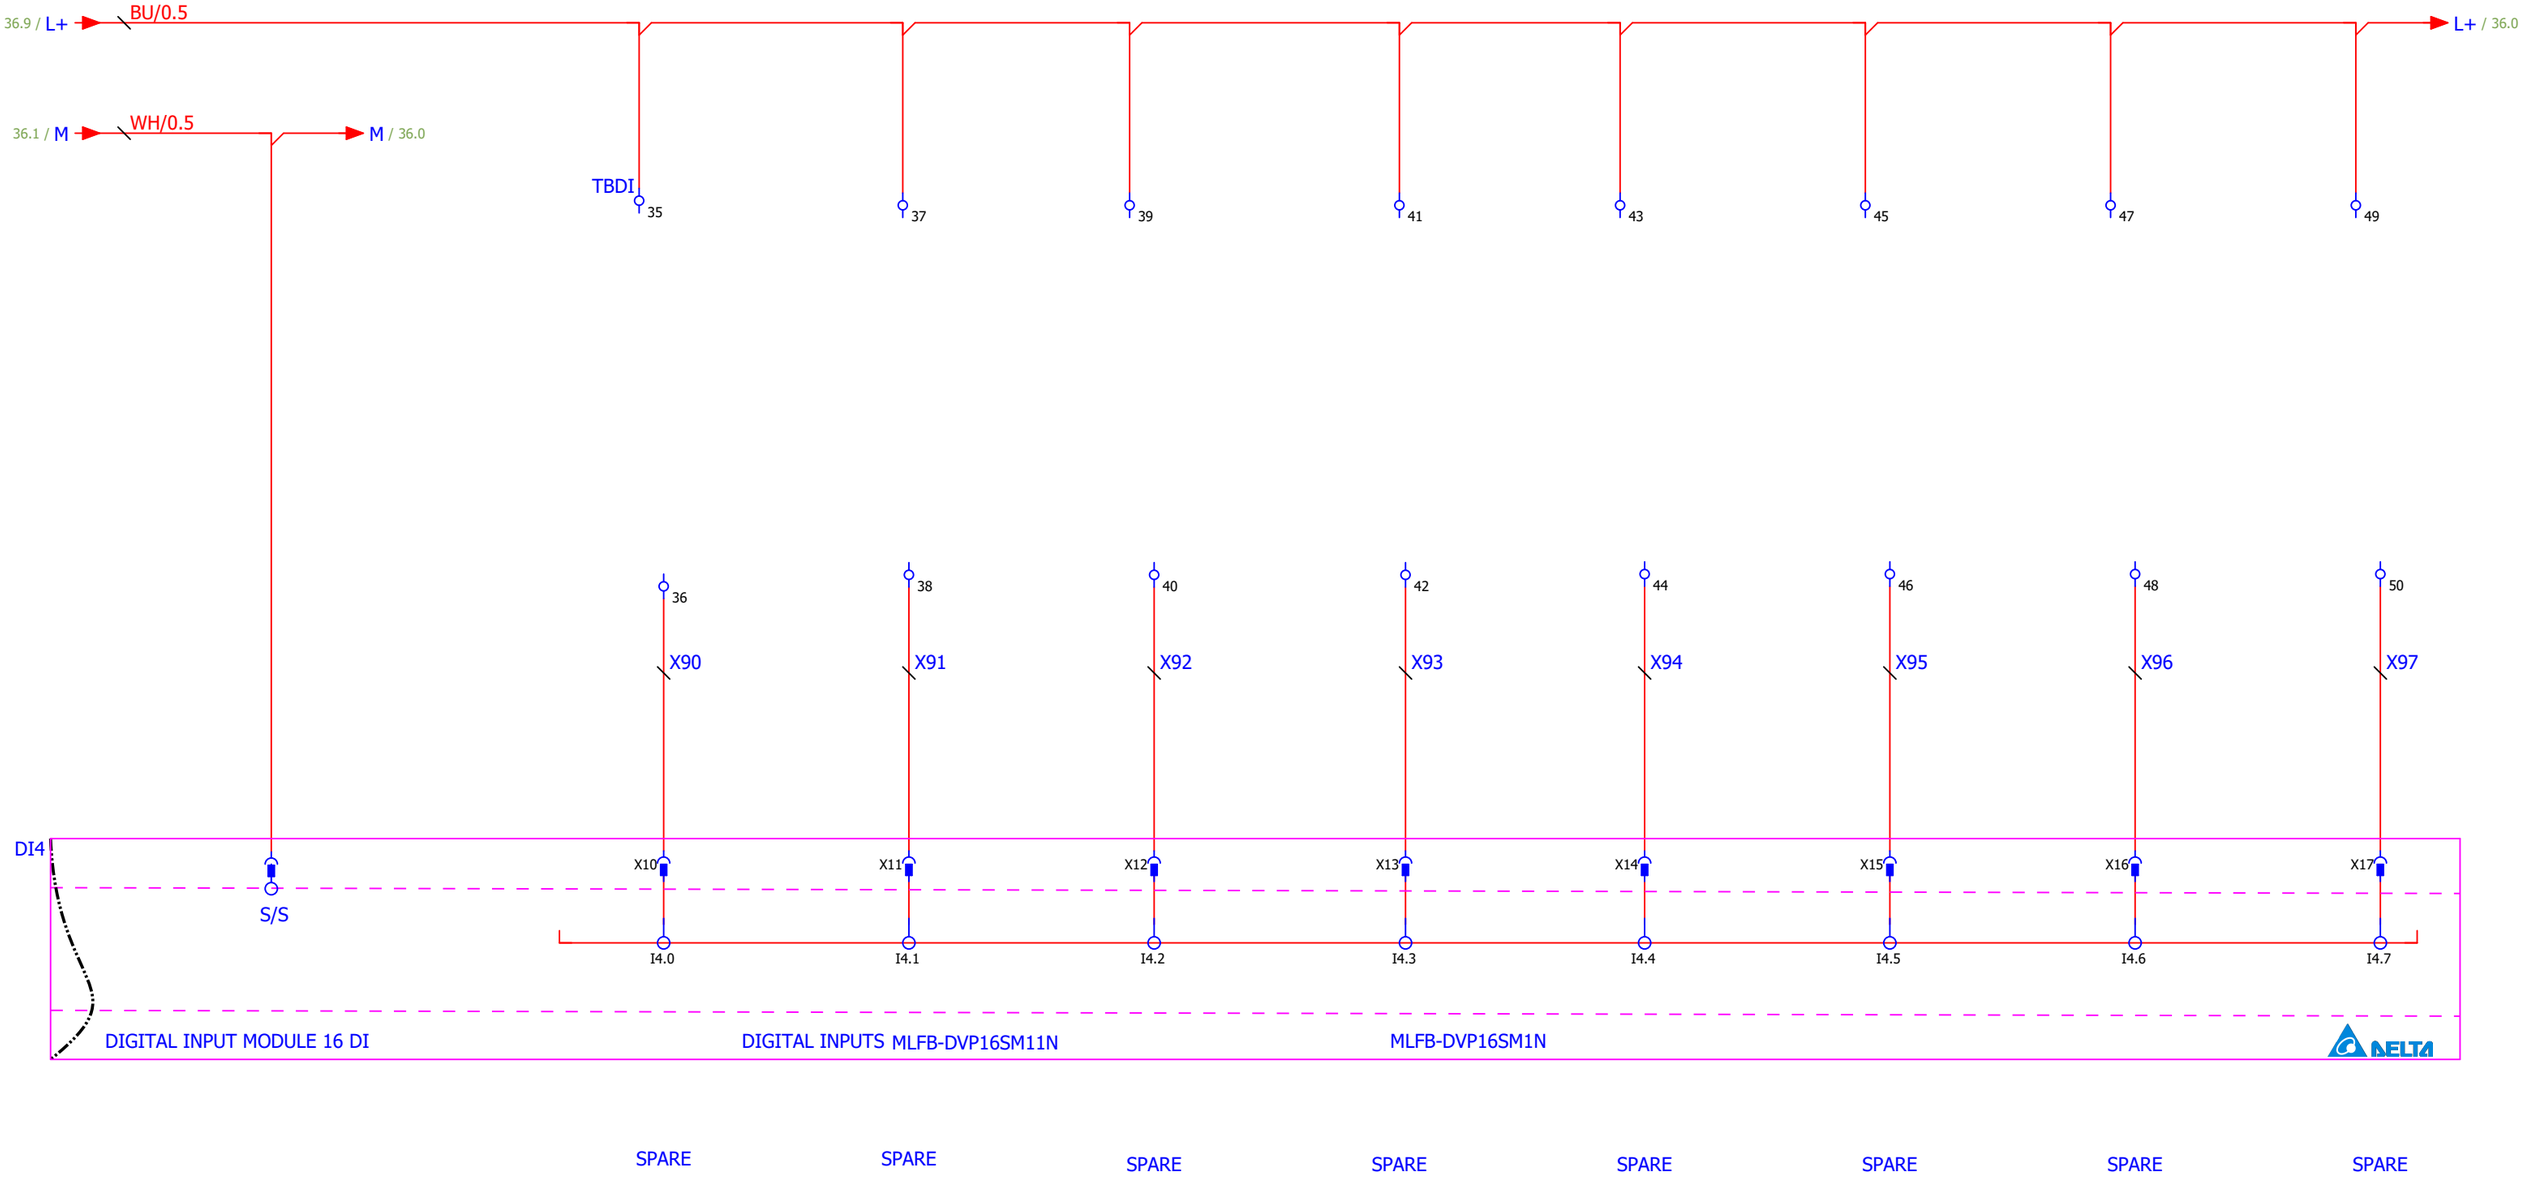


NOTE-TYPE OF TERMINALS USED

-NORMAL TERMINAL

-FUSED TERMINAL

**AQUACARESEE PVT. LTD.**

**OFFICE NO.204, 205 AND 206**
**VINAYAK ARCADE, 2ND FLOOR**
**OPP. BAJAJ AUTO, AKURDI,PUNE-411035**
**www.aquacaresee.co.in**

| REVISION | DETAILS | DATE |
|---|---|---|
| 00 | AS BUILT | 23-01-2025 |
| 01 | AS PER COMMENTS | 09-12-2025 |
| 00 | FOR APPROVAL | 04-12-2025 |


TITLE:- DIGITAL INPUT MODULE-4 WIRING DIAGRAM

| | |
|---|---|
| DRAWN BY | N.J. |
| CHECKED | V.K. |
| APPROVED | P.B. |

SYSTEM:-375 KLD MBR STP

PROJECT:- 375 KLD MBR STP PLANT CONTROL PANEL

DRG. NO.:PRG-2526-637 | SHEET NO. 37 / 47 | REV.NO. AS BUILT

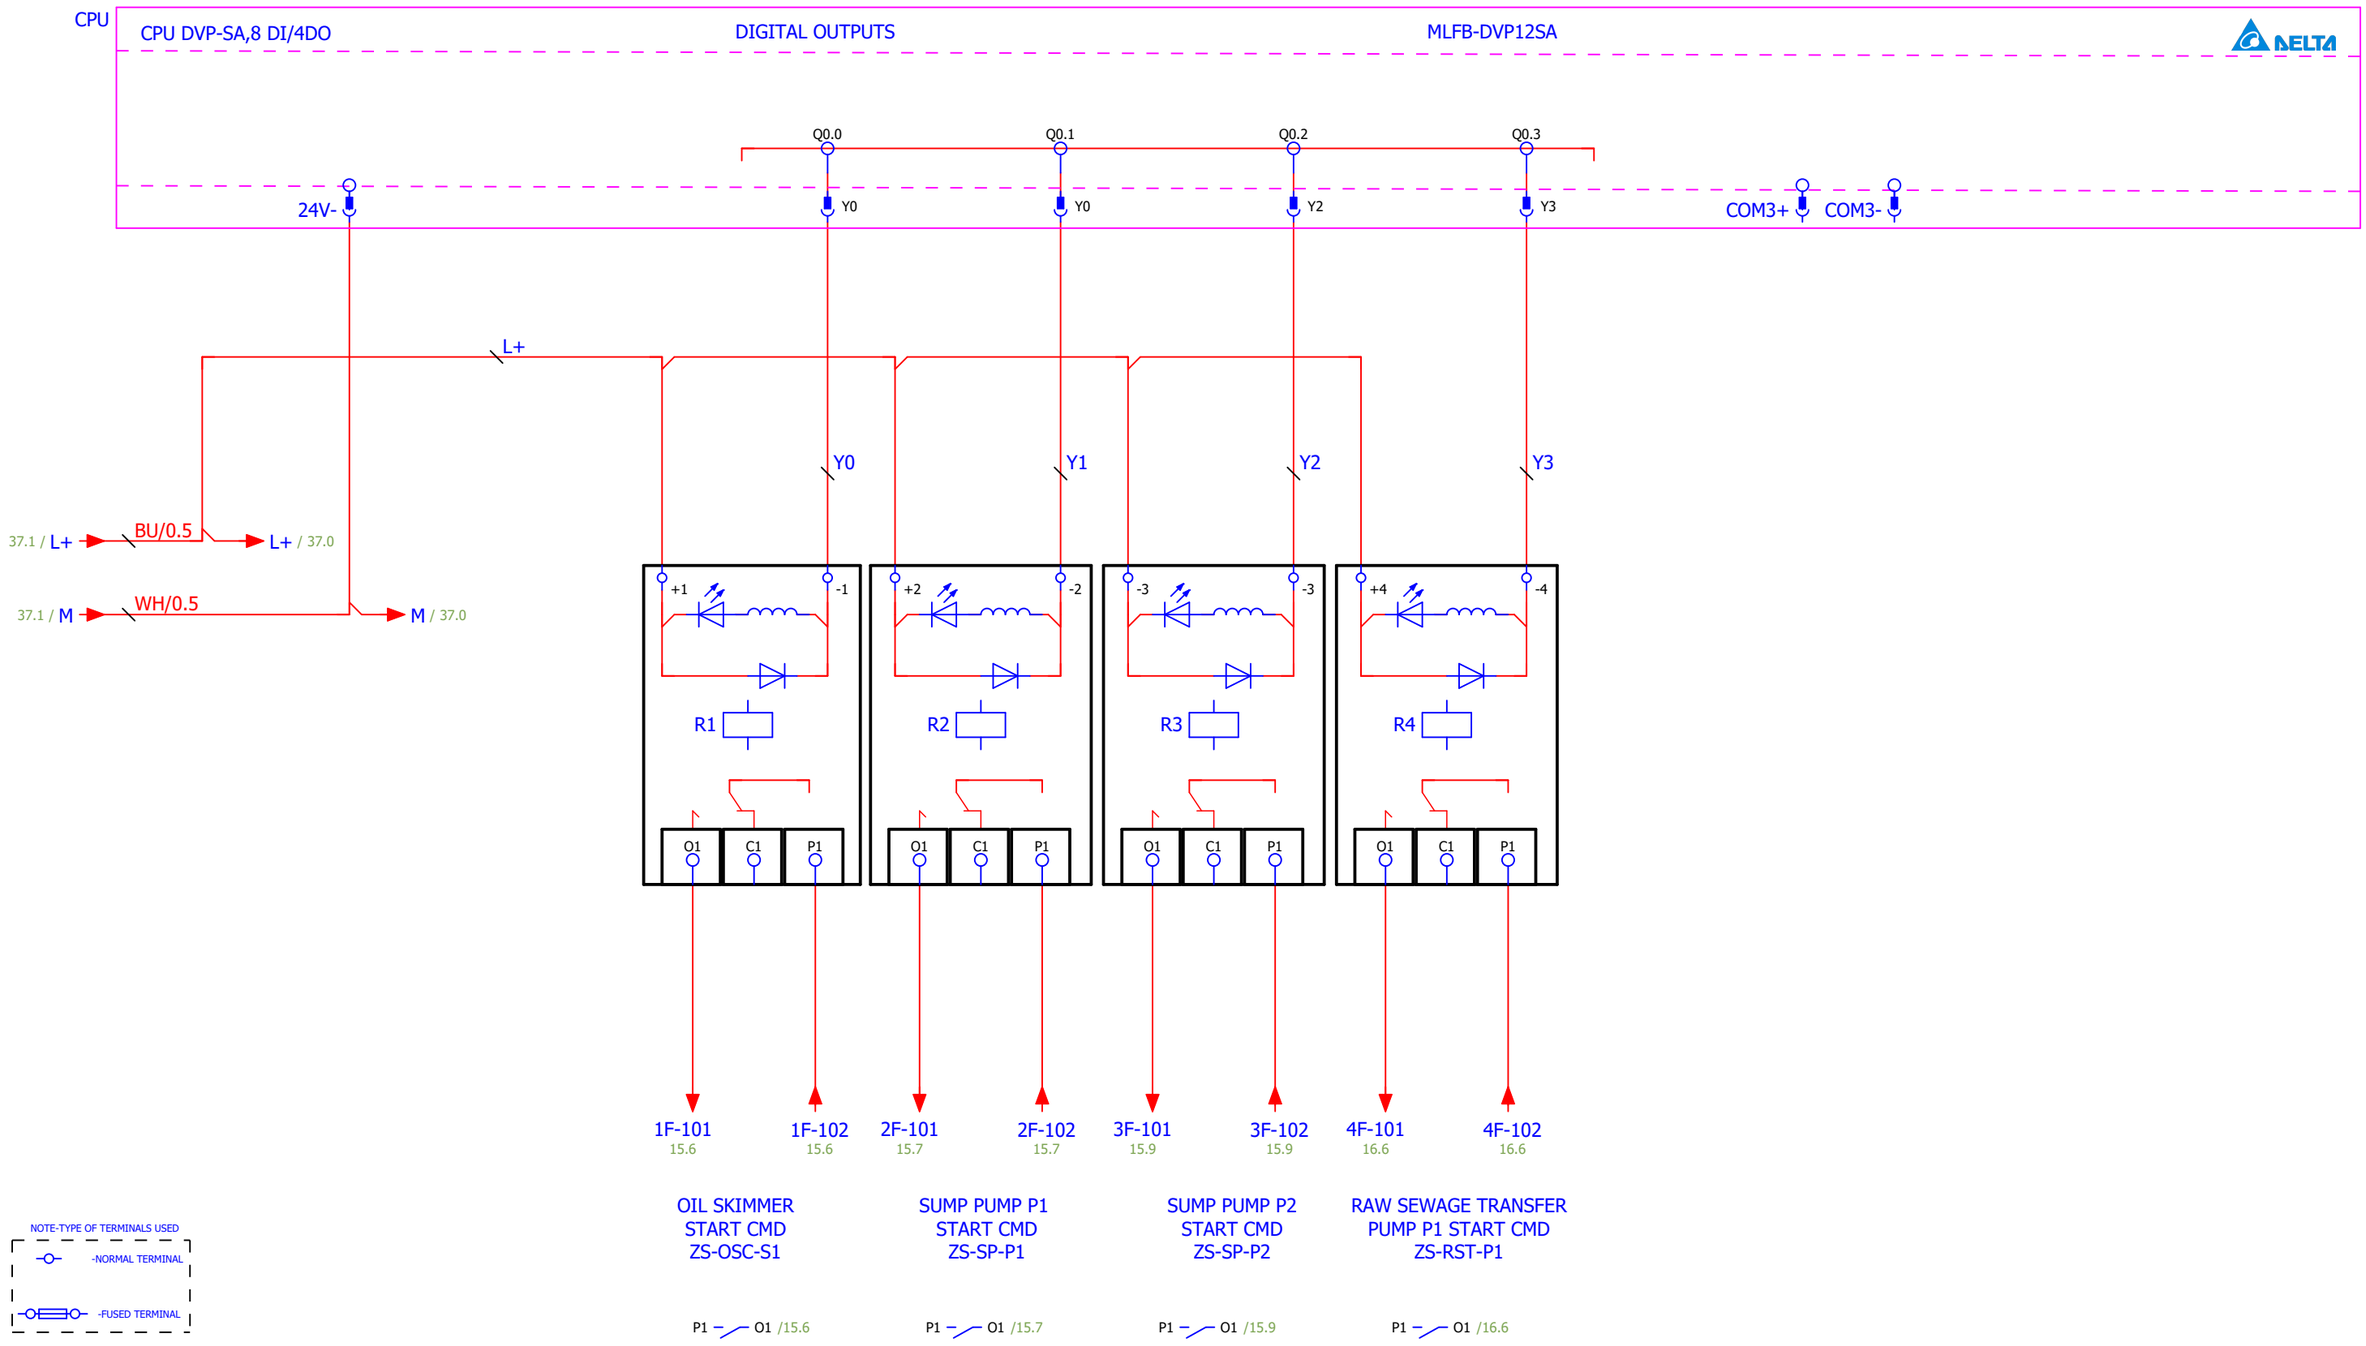


**AQUACARESEE PVT. LTD.**
**OFFICE NO.204, 205 AND 206**
**VINAYAK ARCADE, 2ND FLOOR**
**OPP. BAJAJ AUTO, AKURDI,PUNE-411035**
**www.aquacaresee.co.in**

| REVISION | DETAILS | DATE |
|---|---|---|
| 00 | AS BUILT | 23-01-2025 |
| 01 | AS PER COMMENTS | 09-12-2025 |
| 00 | FOR APPROVAL | 04-12-2025 |


| | |
|---|---|
| DRAWN BY | N.J. |
| CHECKED | V.K. |
| APPROVED | P.B. |

TITLE:- CPU DIGITAL OUTPUT WIRING

SYSTEM:-375 KLD MBR STP

PROJECT:- 375 KLD MBR STP PLANT CONTROL PANEL

DRG. NO.:PRG-2526-637 | SHEET NO. 38 / 47 | REV.NO. AS BUILT

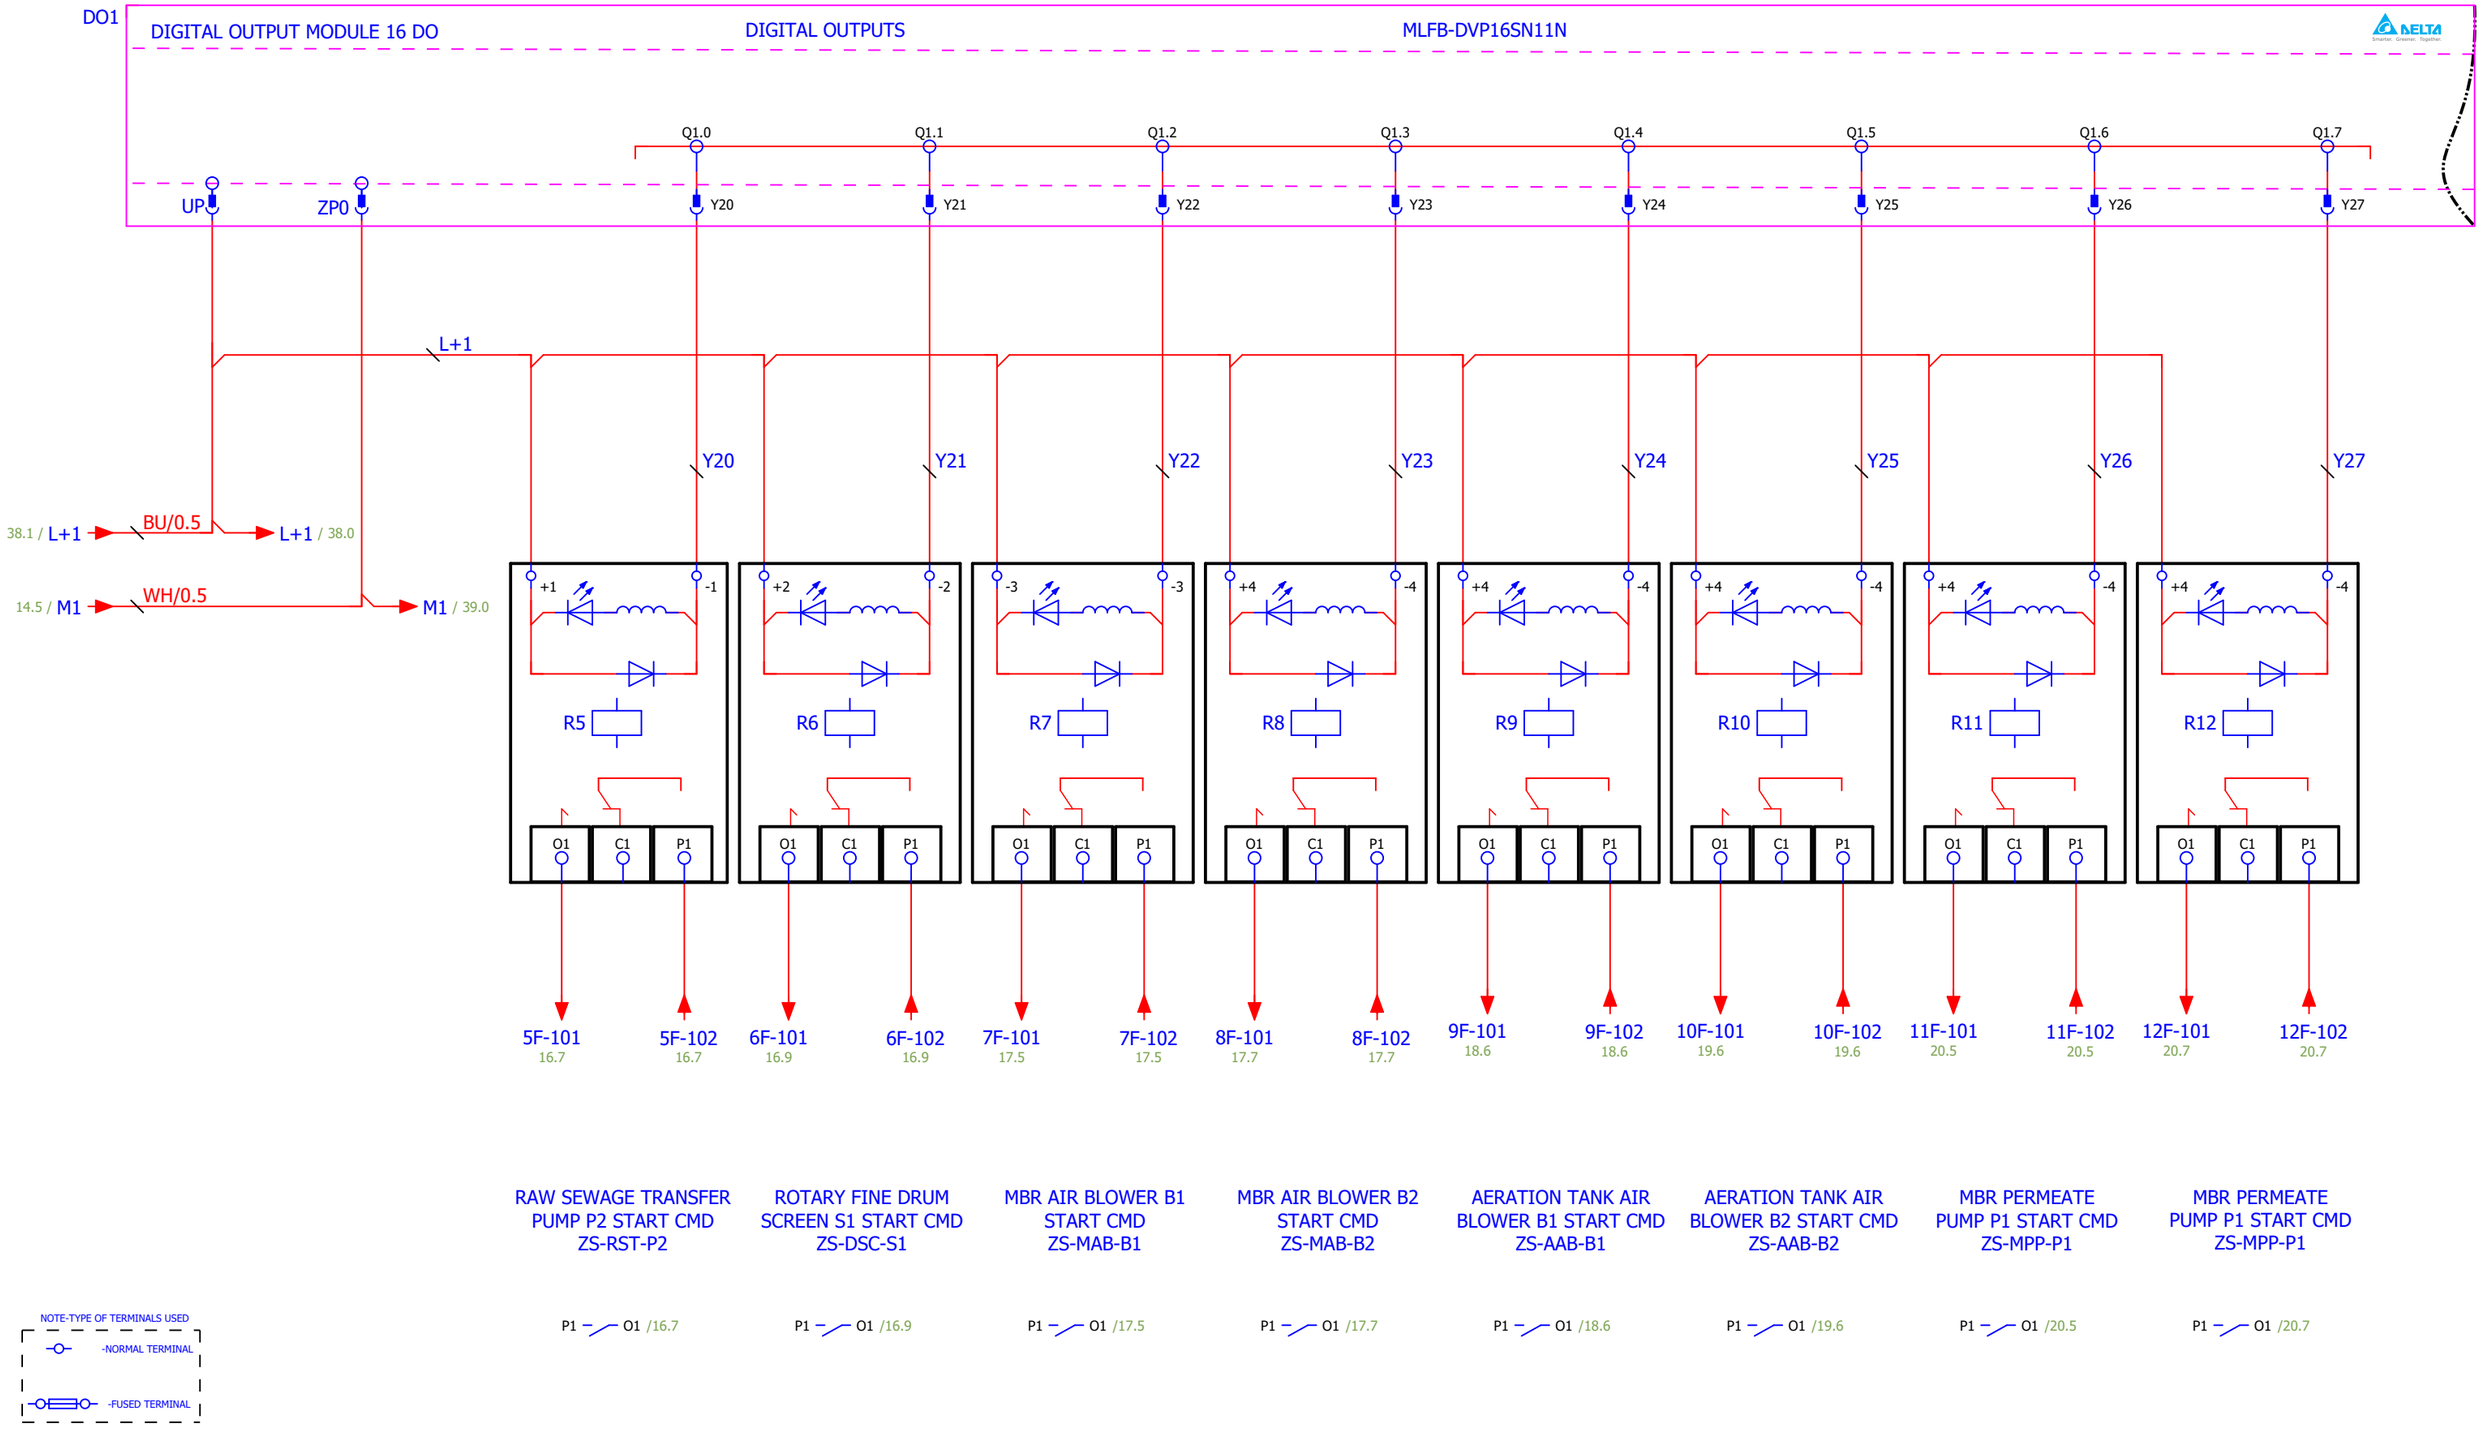


**AQUACARESEE PVT. LTD.**
**OFFICE NO.204, 205 AND 206**
**VINAYAK ARCADE, 2ND FLOOR**
**OPP. BAJAJ AUTO, AKURDI,PUNE-411035**
**www.aquacaresee.co.in**

| REVISION | DETAILS | DATE |
|---|---|---|
| 00 | AS BUILT | 23-01-2025 |
| 01 | AS PER COMMENTS | 09-12-2025 |
| 00 | FOR APPROVAL | 04-12-2025 |


| | |
|---|---|
| DRAWN BY | N.J. |
| CHECKED | V.K. |
| APPROVED | P.B. |

TITLE:- DIGITAL OUTPUT MODULE-1 WIRING DIAGRAM

SYSTEM:-375 KLD MBR STP

PROJECT:- 375 KLD MBR STP PLANT CONTROL PANEL

DRG. NO.:PRG-2526-637 | SHEET NO. 39 / 47 | REV.NO. AS BUILT

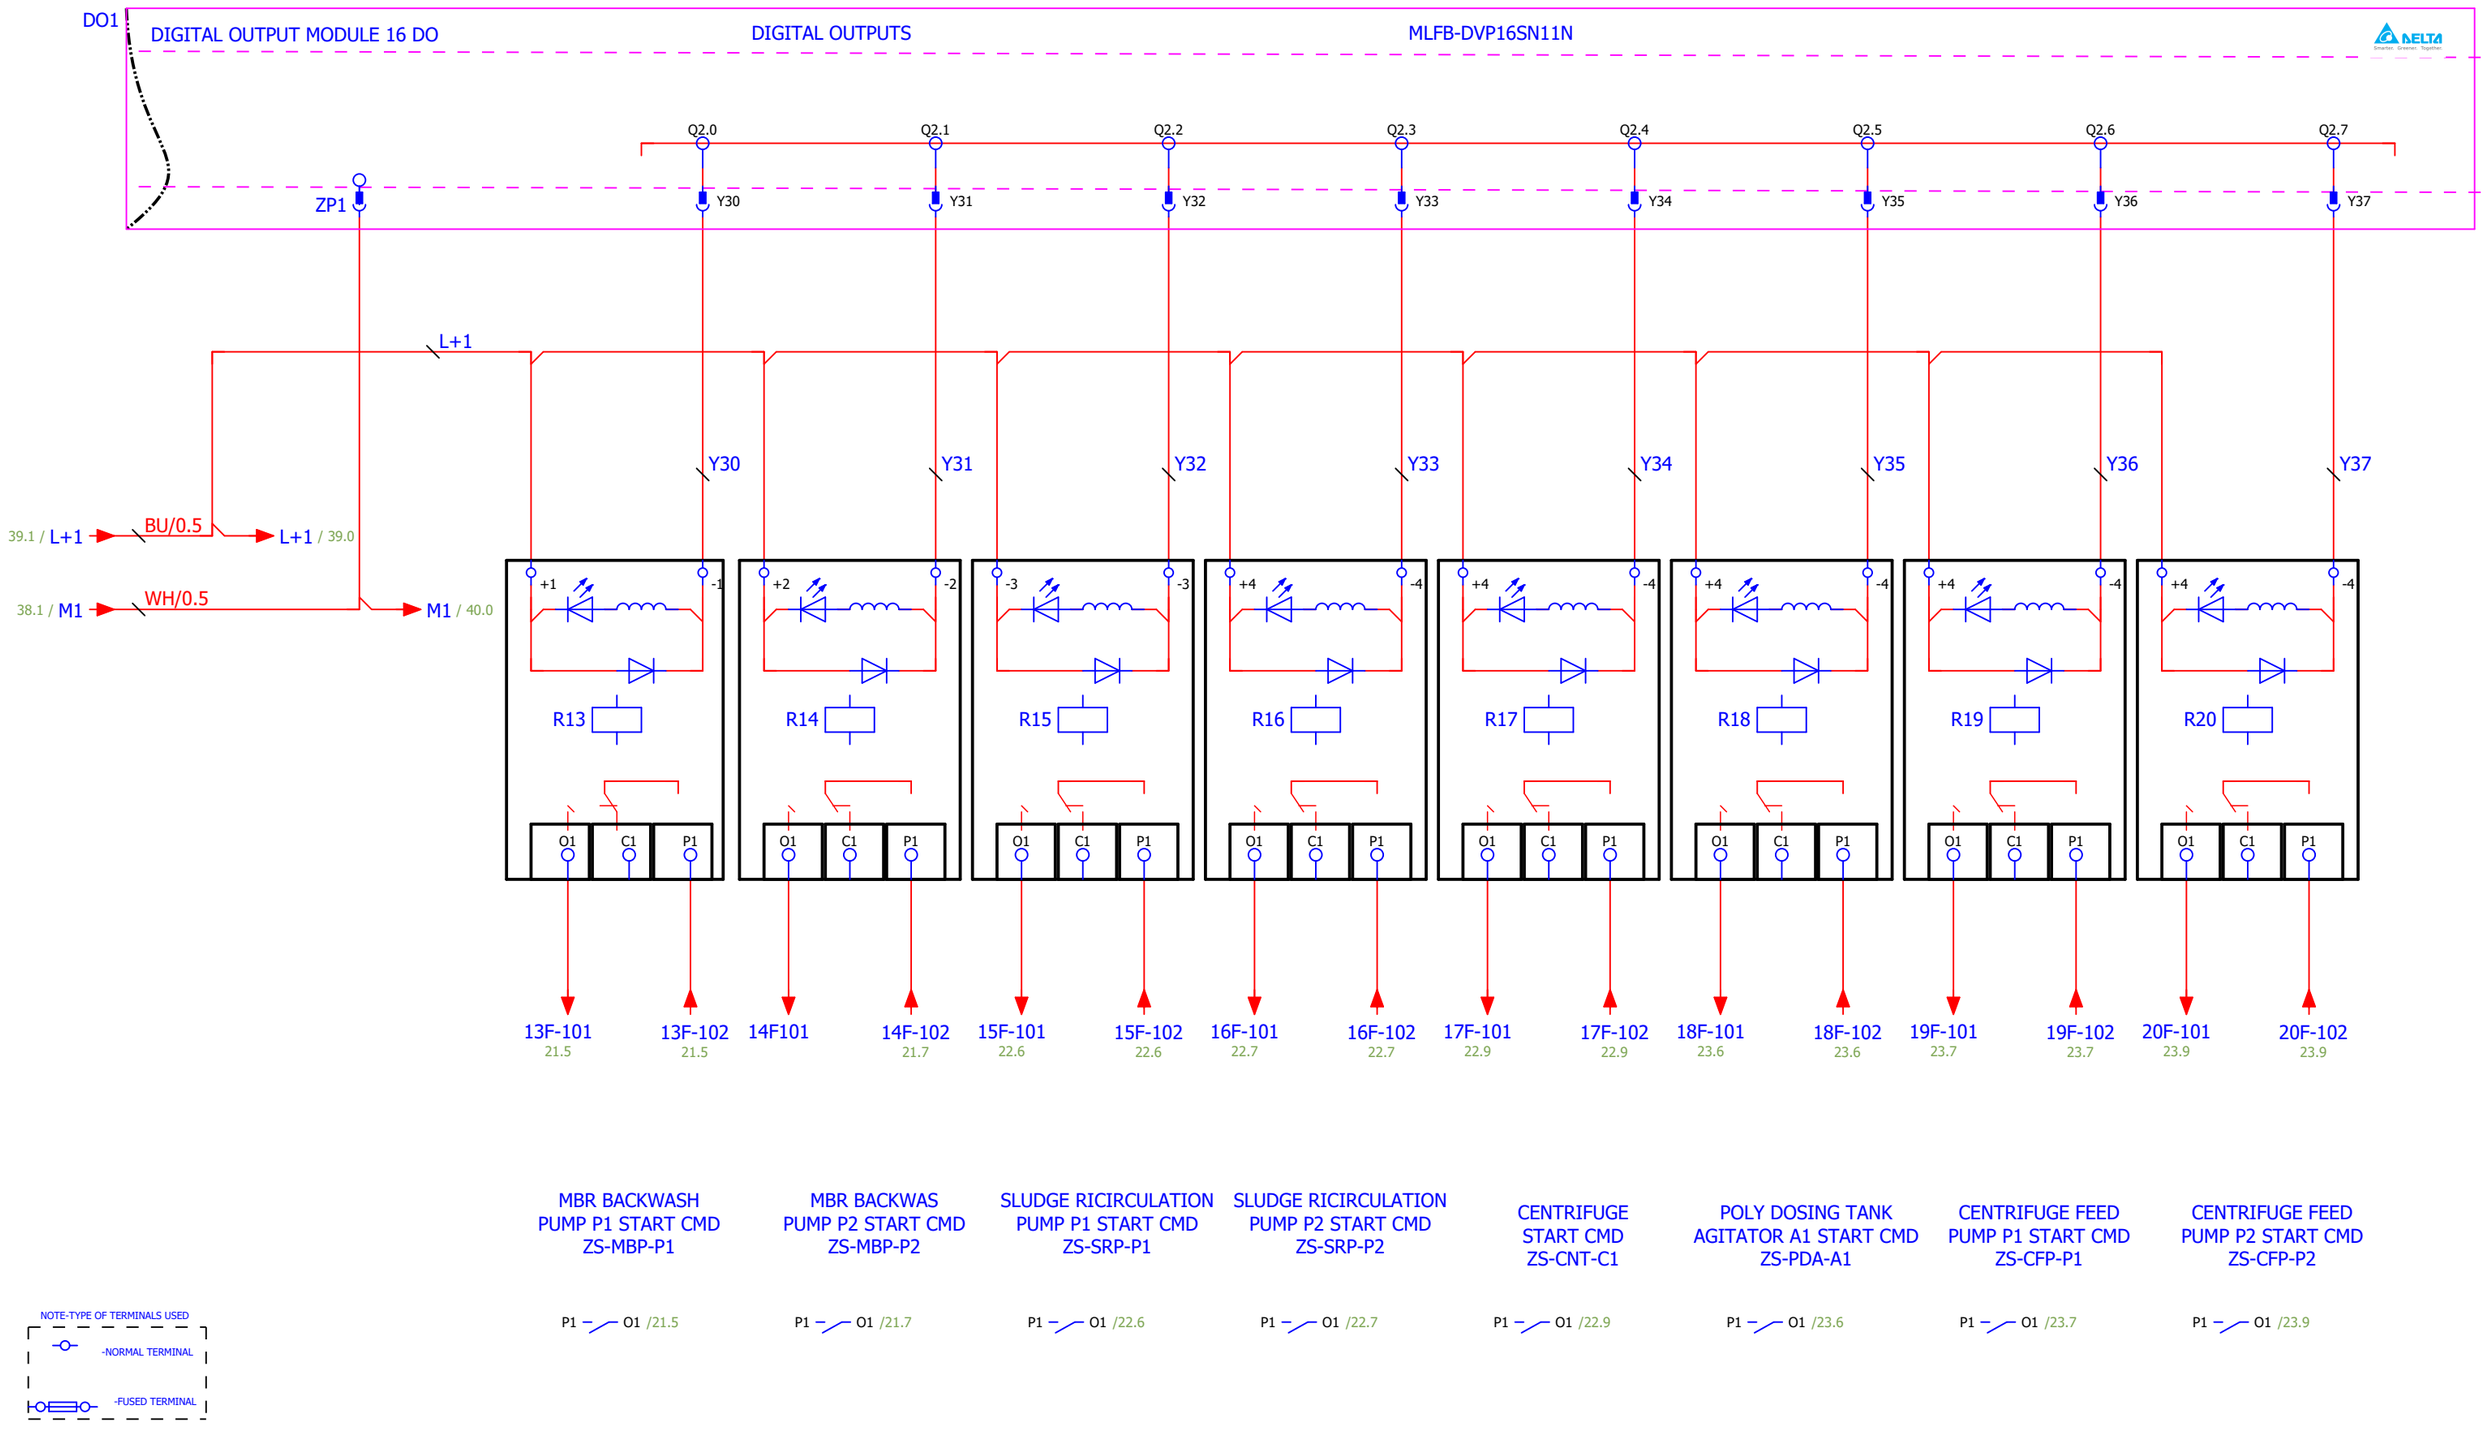


**AQUACARESEE PVT. LTD.**
**OFFICE NO.204, 205 AND 206**
**VINAYAK ARCADE, 2ND FLOOR**
**OPP. BAJAJ AUTO, AKURDI,PUNE-411035**
**www.aquacaresee.co.in**

| REVISION | DETAILS | DATE |
|---|---|---|
| 00 | AS BUILT | 23-01-2025 |
| 01 | AS PER COMMENTS | 09-12-2025 |
| 00 | FOR APPROVAL | 04-12-2025 |


TITLE:- DIGITAL OUTPUT MODULE-1 WIRING DIAGRAM

| | |
|---|---|
| DRAWN BY | N.J. |
| CHECKED | V.K. |
| APPROVED | P.B. |

SYSTEM:-375 KLD MBR STP

PROJECT:- 375 KLD MBR STP PLANT CONTROL PANEL

DRG. NO.:PRG-2526-637 | SHEET NO. 40 / 47 | REV.NO. AS BUILT

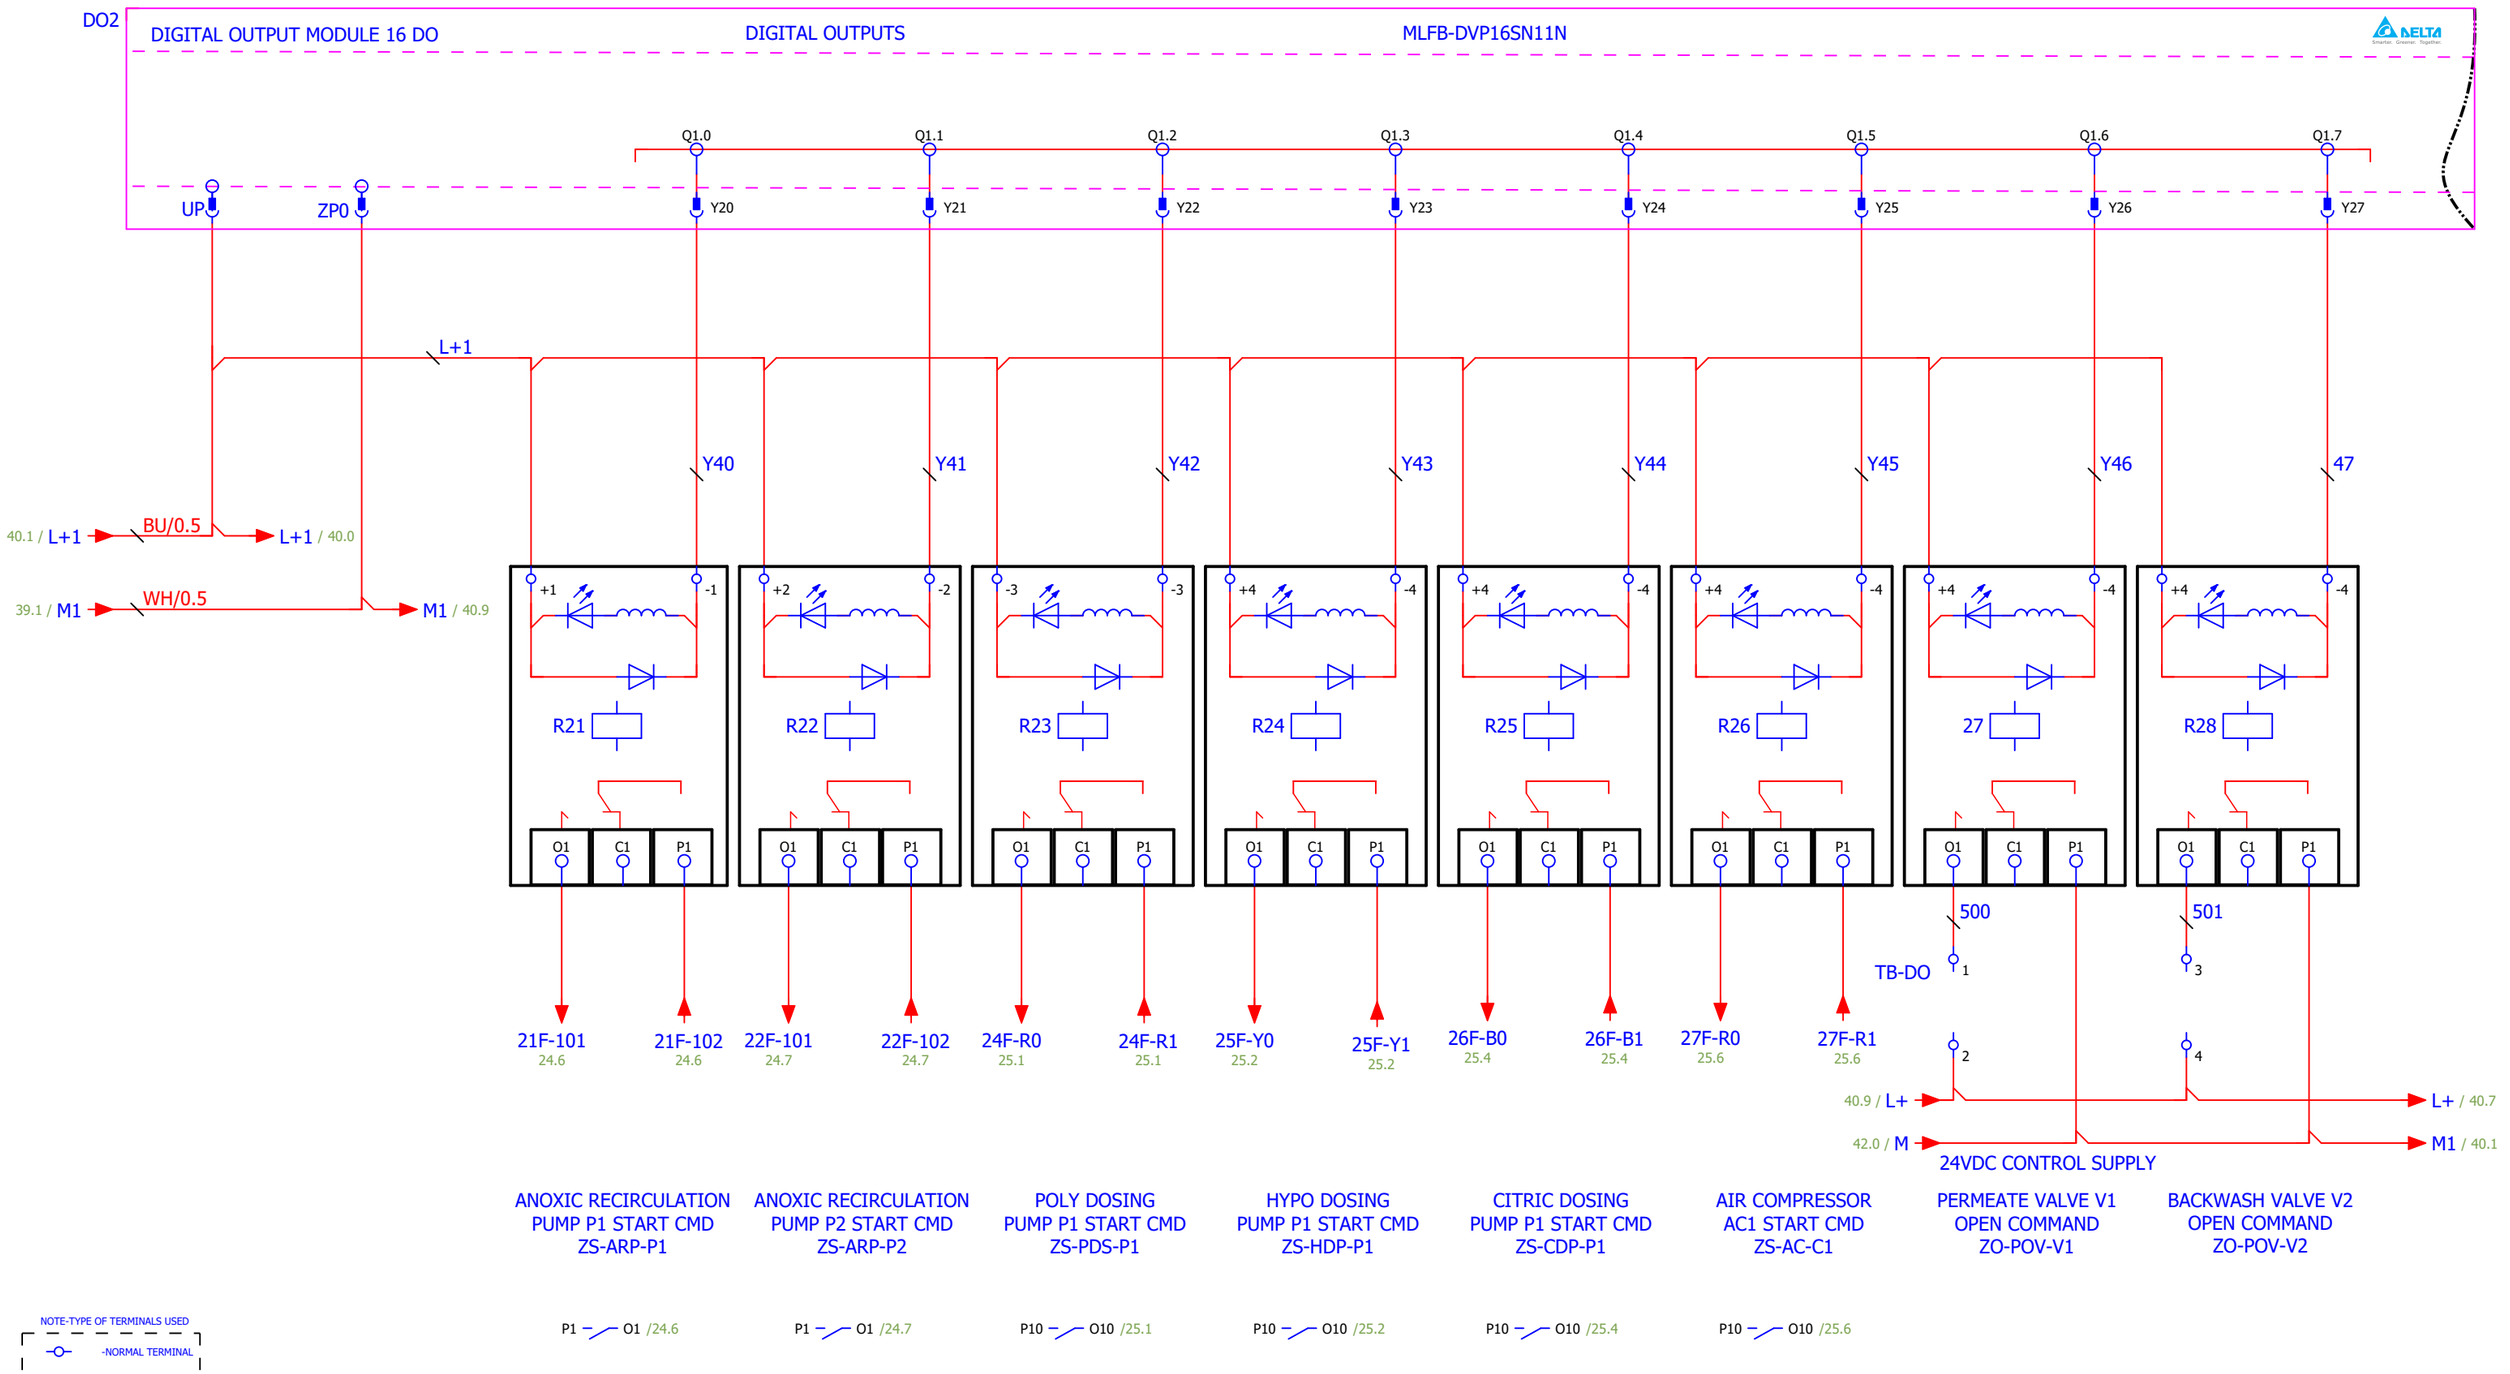


**AQUACARESEE PVT. LTD.**
OFFICE NO.204, 205 AND 206
VINAYAK ARCADE, 2ND FLOOR
OPP. BAJAJ AUTO, AKURDI,PUNE-411035
www.aquacaresee.co.in

| REVISION | DETAILS | DATE |
|---|---|---|
| 00 | AS BUILT | 23-01-2025 |
| 01 | AS PER COMMENTS | 09-12-2025 |
| 00 | FOR APPROVAL | 04-12-2025 |

| | |
|---|---|
| DRAWN BY | N.J. |
| CHECKED | V.K. |
| APPROVED | P.B. |


TITLE:- DIGITAL OUTPUT MODULE-2 WIRING DIAGRAM

SYSTEM:-375 KLD MBR STP

PROJECT:- 375 KLD MBR STP PLANT CONTROL PANEL

DRG. NO.:PRG-2526-637 | SHEET NO. 41 / 47 | REV.NO. AS BUILT

| 0 | 1 | 2 | 3 | 4 | 5 | 6 | 7 | 8 | 9 |
|---|---|---|---|---|---|---|---|---|---|

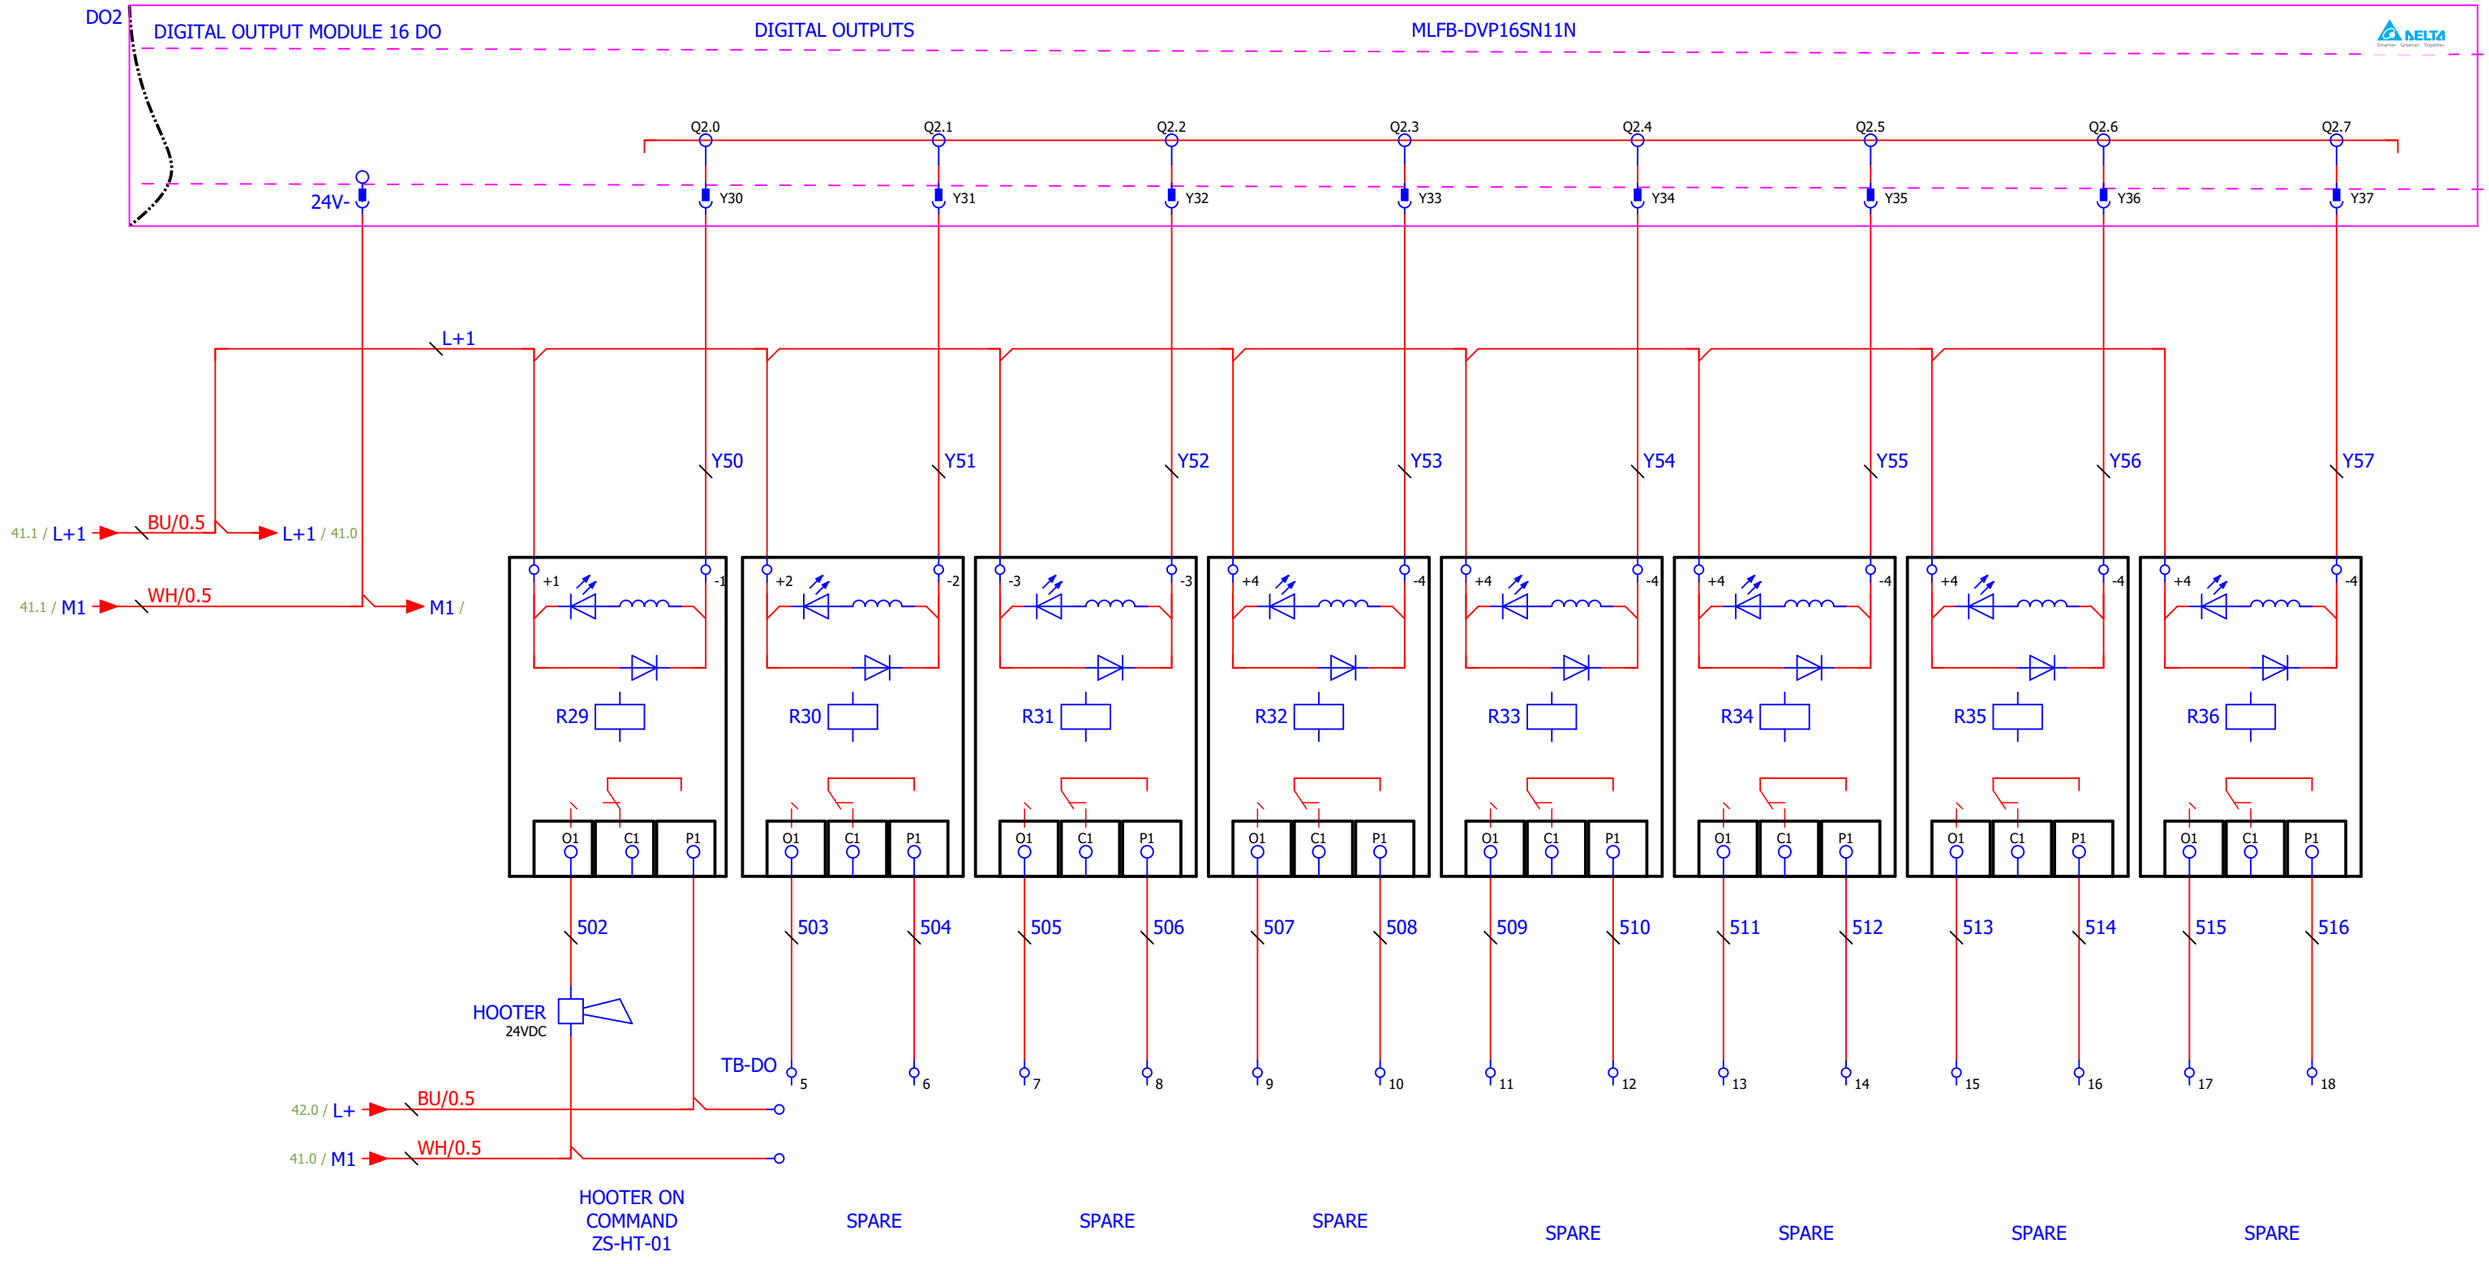


**AQUACARESEE PVT. LTD.**
**OFFICE NO.204, 205 AND 206**
**VINAYAK ARCADE, 2ND FLOOR**
**OPP. BAJAJ AUTO, AKURDI,PUNE-411035**
**www.aquacaresee.co.in**

| REVISION | DETAILS | DATE |
|---|---|---|
| 00 | AS BUILT | 23-01-2025 |
| 01 | AS PER COMMENTS | 09-12-2025 |
| 00 | FOR APPROVAL | 04-12-2025 |


TITLE:- DIGITAL OUTPUT MODULE-2 WIRING DIAGRAM

| | |
|---|---|
| DRAWN BY | N.J. |
| CHECKED | V.K. |
| APPROVED | P.B. |

SYSTEM:-375 KLD MBR STP

PROJECT:- 375 KLD MBR STP PLANT CONTROL PANEL

| DRG. NO.:PRG-2526-637 | SHEET NO. 42 / 47 | REV.NO. AS BUILT |
|---|---|---|

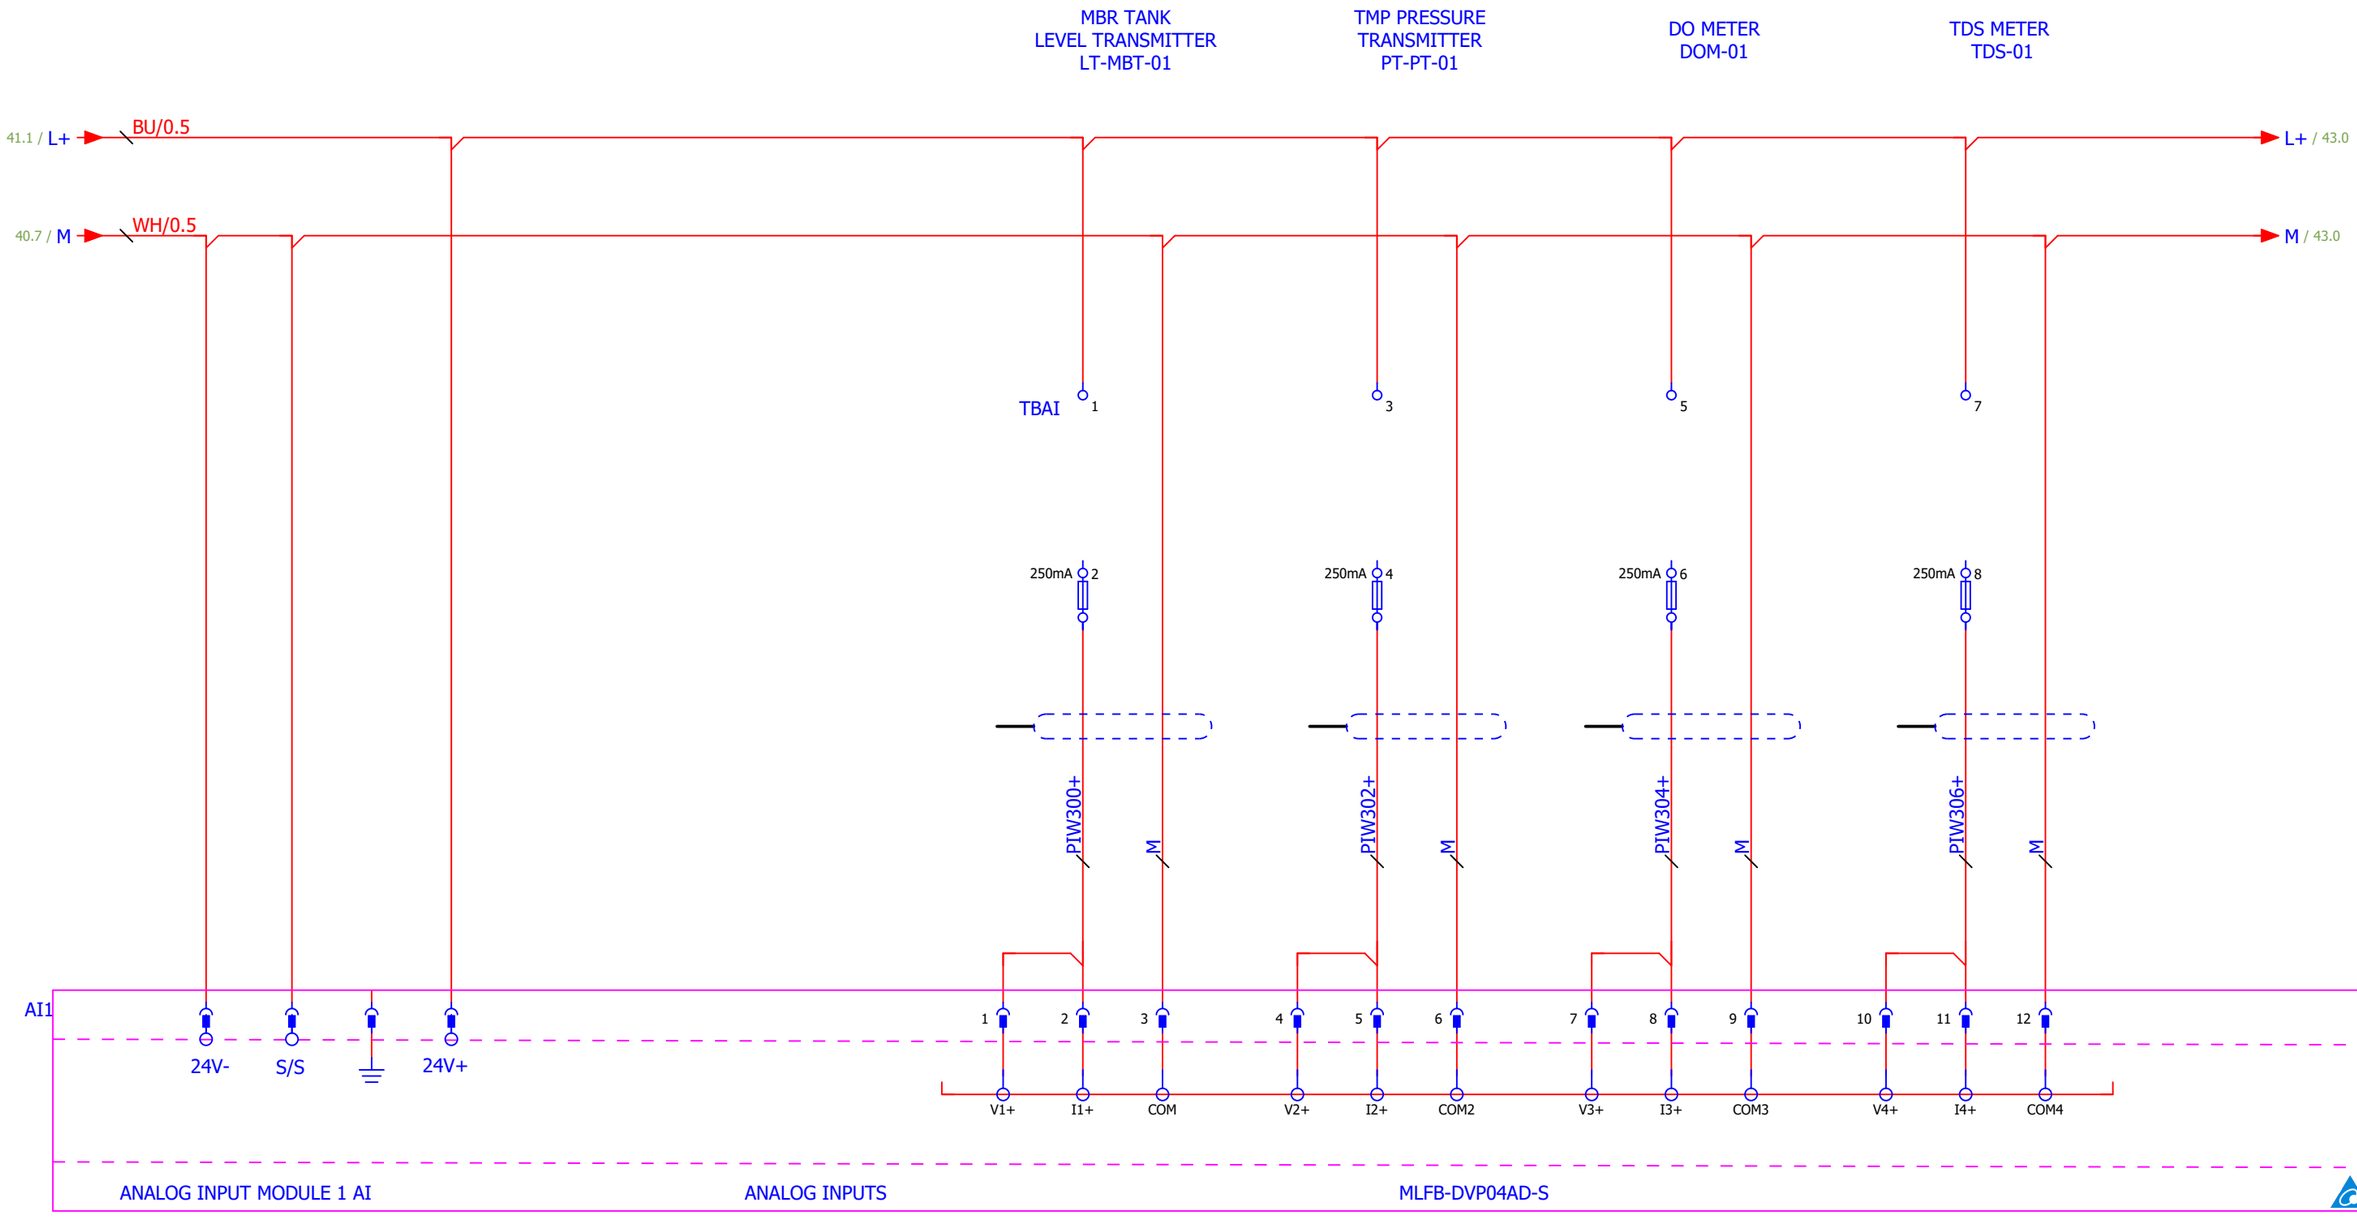


NOTE-TYPE OF TERMINALS USED

-NORMAL TERMINAL

-FUSED TERMINAL

**AQUACARESEE PVT. LTD.**

**OFFICE NO.204, 205 AND 206**
**VINAYAK ARCADE, 2ND FLOOR**
**OPP. BAJAJ AUTO, AKURDI,PUNE-411035**
**www.aquacaresee.co.in**

| REVISION | DETAILS | DATE |
|---|---|---|
| 00 | AS BUILT | 23-01-2025 |
| 01 | AS PER COMMENTS | 09-12-2025 |
| 00 | FOR APPROVAL | 04-12-2025 |


| | |
|---|---|
| DRAWN BY | N.J. |
| CHECKED | V.K. |
| APPROVED | P.B. |

TITLE:- ANALOG INPUT WIRING DIAGRAM

SYSTEM:-375 KLD MBR STP

PROJECT:- 375 KLD MBR STP PLANT CONTROL PANEL

DRG. NO.:PRG-2526-637 | SHEET NO. 43 / 47 | REV.NO. AS BUILT

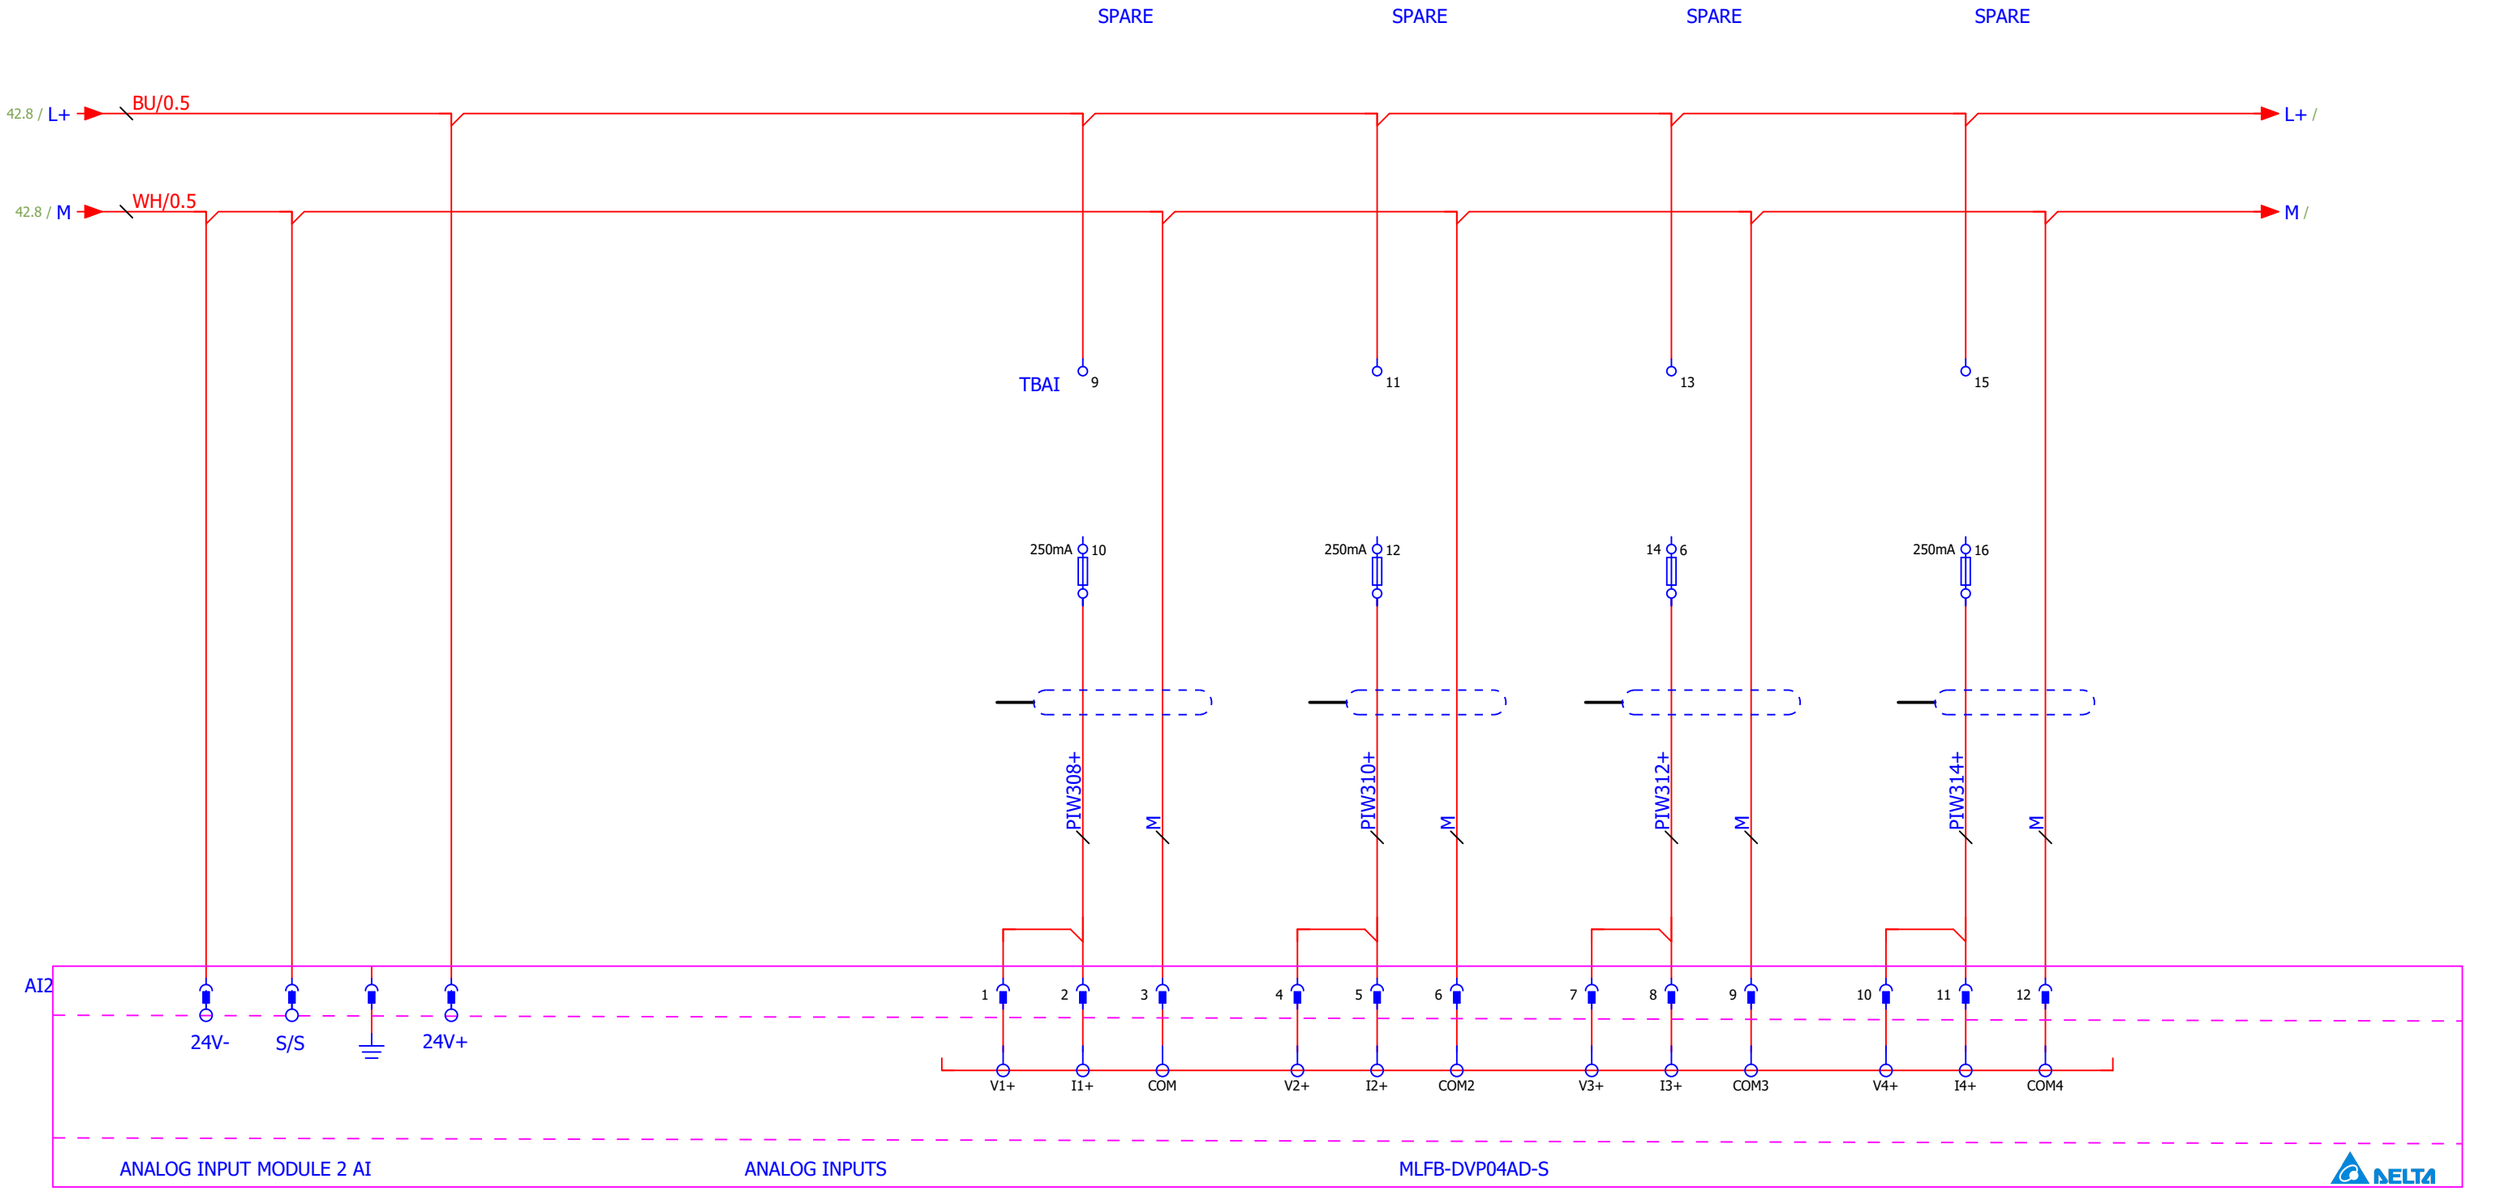


NOTE-TYPE OF TERMINALS USED

-NORMAL TERMINAL

-FUSED TERMINAL

**AQUACARESEE PVT. LTD.**

**OFFICE NO.204, 205 AND 206**
**VINAYAK ARCADE, 2ND FLOOR**
**OPP. BAJAJ AUTO, AKURDI,PUNE-411035**
**www.aquacaresee.co.in**

| REVISION | DETAILS | DATE |
|---|---|---|
| 00 | AS BUILT | 23-01-2025 |
| 01 | AS PER COMMENTS | 09-12-2025 |
| 00 | FOR APPROVAL | 04-12-2025 |

TITLE:- ANALOG INPUT WIRING DIAGRAM

| | |
|---|---|
| DRAWN BY | N.J. |
| CHECKED | V.K. |
| APPROVED | P.B. |

SYSTEM:-375 KLD MBR STP

PROJECT:- 375 KLD MBR STP PLANT CONTROL PANEL

DRG. NO.:PRG-2526-637 | SHEET NO. 44 / 47 | REV.NO. AS BUILT

# TERMINAL DETAILS

## TERMINAL DETAILS

| IN PANEL | ON FIELD |
|---|---|

### INCOMING BUSBAR (Cu)

R/Y/B-1RX20X10
N-1RX20X5

| | | |
|---|---|---|
| 1 | R | RD |
| 2 | Y | YE |
| 3 | B | BU |
| 4 | N | BK |

INCOMER POWER
415V, 3PH
4 WIRE,32A

### POWER TERMINAL (1F-X0)

2.5SQMM

| | | | |
|---|---|---|---|
| 1F-R0 | 1 | RD | OIL SKIMMER |
| 1F-Y0 | 2 | YE | |
| 1F-B0 | 3 | BU | |

### POWER TERMINAL (2F-X0)

2.5SQMM

| | | | |
|---|---|---|---|
| 2F-R0 | 1 | RD | SUMP PUMP -P1 |
| 2F-Y0 | 2 | YE | |
| 2F-B0 | 3 | BU | |

### POWER TERMINAL (3F-X0)

2.5SQMM

| | | | |
|---|---|---|---|
| 3F-R0 | 1 | RD | SUMP PUMP -P2 |
| 3F-Y0 | 2 | YE | |
| 3F-B0 | 3 | BU | |

### POWER TERMINAL (4F-X0)

2.5SQMM

| | | | |
|---|---|---|---|
| 4F-R0 | 1 | RD | RAW SEWAGE TRANSFER PUMP-P1 |
| 4F-Y0 | 2 | YE | |
| 4F-B0 | 3 | BU | |

## TERMINAL DETAILS

| IN PANEL | ON FIELD |
|---|---|

### POWER TERMINAL (5F-X0)

2.5SQMM

| | | | |
|---|---|---|---|
| 5F-R0 | 1 | RD | RAW SEWAGE TRANSFER PUMP-P2 |
| 5F-Y0 | 2 | YE | |
| 5F-B0 | 3 | BU | |

### POWER TERMINAL (6F-X0)

2.5SQMM

| | | | |
|---|---|---|---|
| 6F-R0 | 1 | RD | ROTARY FINE DRUM SCREEN |
| 6F-Y0 | 2 | YE | |
| 6F-B0 | 3 | BU | |

### POWER TERMINAL (7F-X0)

2.5SQMM

| | | | |
|---|---|---|---|
| 7F-R0 | 1 | RD | MBR AIR BLOWER-B1 |
| 7F-Y0 | 2 | YE | |
| 7F-B0 | 3 | BU | |

### POWER TERMINAL (8F-X0)

2.5SQMM

| | | | |
|---|---|---|---|
| 8F-R0 | 1 | RD | MBR AIR BLOWER-B2 |
| 8F-Y0 | 2 | YE | |
| 8F-B0 | 3 | BU | |

### POWER TERMINAL (9F-X0)

2.5SQMM

| | | | |
|---|---|---|---|
| 9F-R0 | 1 | RD | AERATION AIR BLOWER-B1 |
| 9F-Y0 | 2 | YE | |
| 9F-B0 | 3 | BU | |
| 9F-R1 | 4 | RD | |
| 9F-Y1 | 5 | YE | |
| 9F-B1 | 6 | BU | |

## TERMINAL DETAILS

| IN PANEL | ON FIELD |
|---|---|

### POWER TERMINAL (10F-X0)

2.5SQMM

| | | | |
|---|---|---|---|
| 10F-R0 | 1 | RD | AERATION AIR BLOWER-B2 |
| 10F-Y0 | 2 | YE | |
| 10F-B0 | 3 | BU | |
| 10F-R1 | 4 | RD | |
| 10F-Y1 | 5 | YE | |
| 10F-B1 | 6 | BU | |

### POWER TERMINAL (11F-X0)

2.5SQMM

| | | | |
|---|---|---|---|
| 11F-R0 | 1 | RD | MBR PERMEATE PUMP-P1 |
| 11F-Y0 | 2 | YE | |
| 11F-B0 | 3 | BU | |

### POWER TERMINAL 12F-X0)

2.5SQMM

| | | | |
|---|---|---|---|
| 12F-R0 | 1 | RD | MBR PERMEATE PUMP-P2 |
| 12F-Y0 | 2 | YE | |
| 12F-B0 | 3 | BU | |

### POWER TERMINAL 13F-X0)

2.5SQMM

| | | | |
|---|---|---|---|
| 13F-R0 | 1 | RD | MBR BACKWASH PUMP-P1 |
| 13F-Y0 | 2 | YE | |
| 13F-B0 | 3 | BU | |

### POWER TERMINAL (14F-X0)

2.5SQMM

| | | | |
|---|---|---|---|
| 14F-R0 | 1 | RD | MBR BACKWASH PUMP-P2 |
| 14F-Y0 | 2 | YE | |
| 14F-B0 | 3 | BU | |

## TERMINAL DETAILS

| IN PANEL | ON FIELD |
|---|---|

### POWER TERMINAL (15F-X0)

2.5SQMM

| | | | |
|---|---|---|---|
| 15F-R0 | 1 | RD | SLUDGE RECIRCULATION PUMP-P1 |
| 15F-Y0 | 2 | YE | |
| 15F-B0 | 3 | BU | |

### POWER TERMINAL (16F-X0)

2.5SQMM

| | | | |
|---|---|---|---|
| 16F-R0 | 1 | RD | SLUDGE RECIRCULATION PUMP-P2 |
| 16F-Y0 | 2 | YE | |
| 16F-B0 | 3 | BU | |

### POWER TERMINAL (17F-X0)

2.5SQMM

| | | | |
|---|---|---|---|
| 17F-R0 | 1 | RD | CENTRIFUGE |
| 17F-Y0 | 2 | YE | |
| 17F-B0 | 3 | BU | |

### POWER TERMINAL (18F-X0)

2.5SQMM

| | | | |
|---|---|---|---|
| 18F-R0 | 1 | RD | POLY DOSING TANK AGITATOR |
| 18F-Y0 | 2 | YE | |
| 18F-B0 | 3 | BU | |

### POWER TERMINAL (19F-X0)

2.5SQMM

| | | | |
|---|---|---|---|
| 19F-R0 | 1 | RD | CENTRIFUGE FEED PUMP-P1 |
| 19F-Y0 | 2 | YE | |
| 19F-B0 | 3 | BU | |


**AQUACARESEE PVT. LTD.**
OFFICE NO.204, 205 AND 206
VINAYAK ARCADE, 2ND FLOOR
OPP. BAJAJ AUTO, AKURDI,PUNE-411035
www.aquacaresee.co.in


| REVISION | DETAILS | DATE |
|---|---|---|
| 00 | AS BUILT | 23-01-2025 |
| 01 | AS PER COMMENTS | 09-12-2025 |
| 00 | FOR APPROVAL | 04-12-2025 |

TITLE:- TERMINAL DETAILS

| | |
|---|---|
| DRAWN BY | N.J. |
| CHECKED | V.K. |
| APPROVED | P.B. |

SYSTEM:-375 KLD MBR STP

PROJECT:- 375 KLD MBR STP PLANT CONTROL PANEL


| DRG. NO.:PRG-2526-637 | SHEET NO. 45 / 47 | REV.NO. AS BUILT |
|---|---|---|

# TERMINAL DETAILS


## TERMINAL DETAILS

| IN PANEL | ON FIELD |
|---|---|


### POWER TERMINAL (20F-X0)

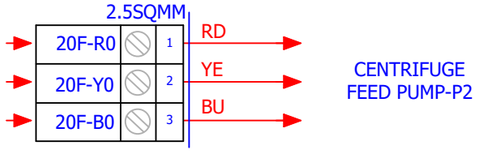



### POWER TERMINAL (21F-X0)

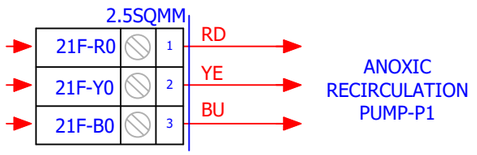



### POWER TERMINAL (22F-X0)

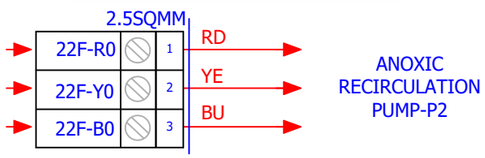


### POWER TERMINAL (23F-X0)

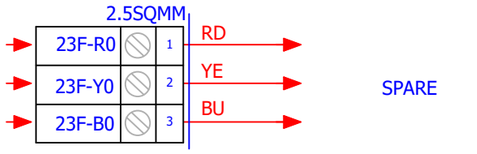



### POWER TERMINAL (24F-X0)

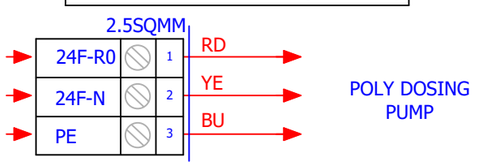



## TERMINAL DETAILS

| IN PANEL | ON FIELD |
|---|---|


### POWER TERMINAL (25F-X0)

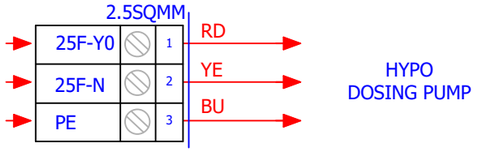



### POWER TERMINAL (26F-X0)

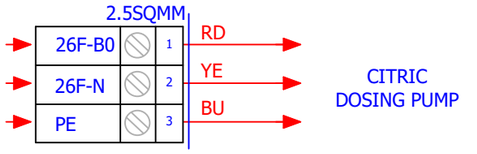



### POWER TERMINAL (27F-X0)

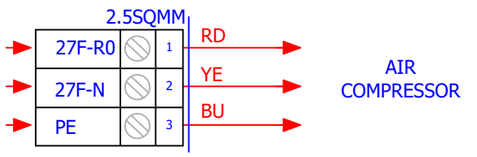


### POWER TERMINAL (28F-X0)

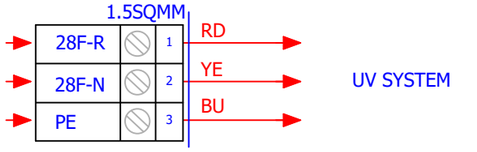



### POWER TERMINAL (28F-X1)

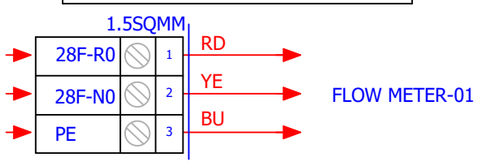



## TERMINAL DETAILS

| IN PANEL | ON FIELD |
|---|---|


### POWER TERMINAL (28F-X2)

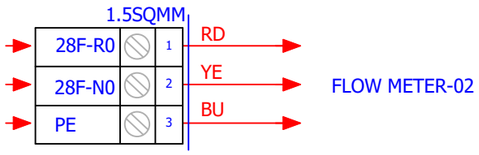



### POWER TERMINAL (28F-X3)

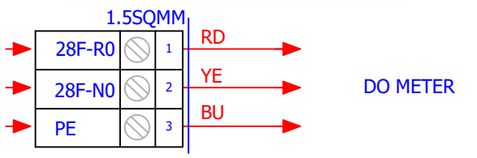



### POWER TERMINAL (28F-X4)

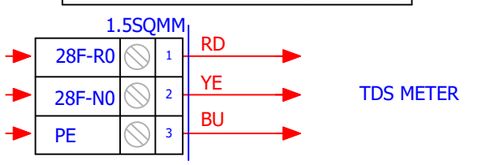


### POWER TERMINAL (28F-X5)

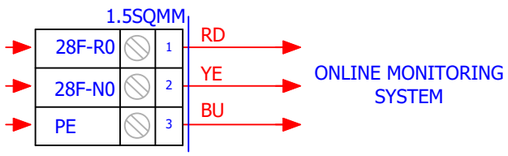



### POWER TERMINAL (28F-X6)

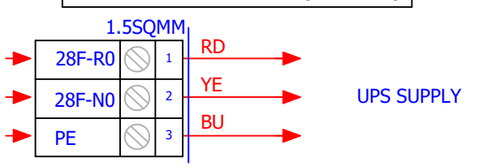


## TERMINAL DETAILS

| IN PANEL | ON FIELD |
|---|---|

### POWER TERMINAL (28F-X7)

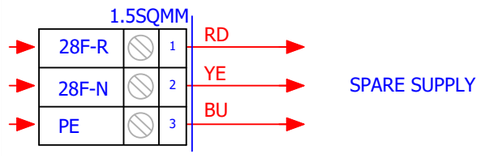



**AQUACARESEE PVT. LTD.**

**OFFICE NO.204, 205 AND 206**
**VINAYAK ARCADE, 2ND FLOOR**
**OPP. BAJAJ AUTO, AKURDI,PUNE-411035**
**www.aquacaresee.co.in**


| REVISION | DETAILS | DATE |
|---|---|---|
| 00 | AS BUILT | 23-01-2025 |
| 01 | AS PER COMMENTS | 09-12-2025 |
| 00 | FOR APPROVAL | 04-12-2025 |

TITLE:- TERMINAL DETAILS

| | |
|---|---|
| DRAWN BY | N.J. |
| CHECKED | V.K. |
| APPROVED | P.B. |

SYSTEM:-375 KLD MBR STP

PROJECT:- 375 KLD MBR STP PLANT CONTROL PANEL

DRG. NO.:PRG-2526-637 | SHEET NO. 46 / 47 | REV.NO. AS BUILT

# TERMINAL DETAILS

## TERMINAL DETAILS

| IN PANEL | ON FIELD |
|---|---|

### DIGITAL INPUT (TB-DI)

0.5SQMM

| | | | | |
|---|---|---|---|---|
| L+ | 1 | BU | TREATED WATER TANK LEVEL SWITCH LSL-TT-101 |
| X65 | 2 | BU | |
| L+ | 3 | BU | RAW WATER TANK LEVEL SWITCH LSL-RT-102 |
| X66 | 4 | BU | |
| L+ | 5 | BU | SLUDGE HOLDING TANK LEVEL SWITCH LSL-SHT-103 |
| X67 | 6 | BU | |
| L+ | 7 | BU | POLY DOSING TANK LEVEL SWITCH LSL-PDT-104 |
| X70 | 8 | BU | |
| L+ | 9 | BU | HYPO DOSING TANK LEVEL SWITCH LSL-HDT-105 |
| X71 | 10 | BU | |
| L+ | 11 | BU | CITRIC DOSING TANK LEVEL SWITCH LSL-CDT-106 |
| X72 | 12 | BU | |
| L+ | 13 | BU | SPARE |
| X73 | 14 | BU | |
| L+ | 15 | BU | SUMP TANK LEVEL SWITCH LSL-SMT-108 |
| X74 | 16 | BU | |
| L+ | 17 | BU | PERMEATE VALVE V1 OPEN FEEDBACK ZSO-POV-V1 |
| X75 | 18 | BU | |
| L+ | 19 | BU | PERMEATE VALVE V1 CLOSE FEEDBACK ZSC-POV-V1 |
| X76 | 20 | BU | |
| L+ | 21 | BU | BACKWASH VALVE V2 OPEN FEEDBACK ZSO-POV-V2 |
| X77 | 22 | BU | |
| L+ | 23 | BU | BACKWASH VALVE V2 CLOSE FEEDBACK ZSC-POV-V2 |
| X80 | 24 | BU | |
| L+ | 25 | BU | SPARE |
| X83 | 26 | BU | |
| L+ | 27 | BU | SPARE |
| X84 | 28 | BU | |
| L+ | 29 | BU | SPARE |
| X85 | 30 | BU | |
| L+ | 31 | BU | SPARE |
| X86 | 32 | BU | |

## TERMINAL DETAILS

| IN PANEL | ON FIELD |
|---|---|

### DIGITAL INPUT (TB-DI)

0.5SQMM

| | | | |
|---|---|---|---|
| L+ | 33 | BU | SPARE |
| X87 | 34 | BU | |
| L+ | 35 | BU | SPARE |
| X90 | 36 | BU | |
| L+ | 37 | BU | SPARE |
| X81 | 38 | BU | |
| L+ | 39 | BU | SPARE |
| X92 | 40 | BU | |
| L+ | 41 | BU | SPARE |
| X93 | 42 | BU | |
| L+ | 43 | BU | SPARE |
| X94 | 44 | BU | |
| L+ | 45 | BU | SPARE |
| X95 | 46 | BU | |
| L+ | 47 | BU | SPARE |
| X96 | 48 | BU | |
| L+ | 49 | BU | SPARE |
| X97 | 50 | BU | |

### DIGITAL OUTPUT (TB-DO)

0.5SQMM

| | | | |
|---|---|---|---|
| 500 | 1 | WH | PERMEATE VALVE V1 OPEN COMMAND ZO-POV-V1 |
| M | 2 | BU | |
| 501 | 3 | WH | BACKWASH VALVE V2 OPEN COMMAND ZO-POV-V2 |
| M | 4 | BU | |
| 503 | 5 | WH | SPARE |
| 504 | 6 | BU | |
| 505 | 7 | WH | SPARE |
| 506 | 8 | BU | |
| 507 | 9 | WH | SPARE |
| 508 | 10 | BU | |

## TERMINAL DETAILS

| IN PANEL | ON FIELD |
|---|---|

### DIGITAL OUTPUT (TB-DO)

0.5SQMM

| | | | |
|---|---|---|---|
| 509 | 11 | WH | SPARE |
| 510 | 12 | BU | |
| 511 | 13 | WH | SPARE |
| 512 | 14 | BU | |
| 513 | 15 | WH | SPARE |
| 514 | 16 | BU | |
| 515 | 17 | WH | SPARE |
| 516 | 18 | BU | |

### ANALOG INPUT (TB-AI)

0.5SQMM

| | | | |
|---|---|---|---|
| L+ | 1 | BU | MBR TANK LEVEL TRANSMITTER LT-MBT-01 |
| PIW300+ | 2 | WH | |
| L+ | 3 | BU | TMP PRESSURE TRANSMITTER PT-PT-01 |
| PIW302+ | 4 | WH | |
| L+ | 5 | BU | DO METER DOM-01 |
| PIW304+ | 6 | WH | |
| L+ | 7 | BU | TDS METER TDS-01 |
| PIW306+ | 8 | WH | |
| L+ | 9 | BU | SPARE |
| PIW308+ | 10 | WH | |
| L+ | 11 | BU | SPARE |
| PIW310+ | 12 | WH | |
| L+ | 13 | BU | SPARE |
| PIW312+ | 14 | WH | |
| L+ | 15 | BU | SPARE |
| PIW314+ | 16 | WH | |


**AQUACARESEE PVT. LTD.**
OFFICE NO.204, 205 AND 206
VINAYAK ARCADE, 2ND FLOOR
OPP. BAJAJ AUTO, AKURDI,PUNE-411035
www.aquacaresee.co.in


| REVISION | DETAILS | DATE |
|---|---|---|
| 00 | AS BUILT | 23-01-2025 |
| 01 | AS PER COMMENTS | 09-12-2025 |
| 00 | FOR APPROVAL | 04-12-2025 |

TITLE:- TERMINAL DETAILS

| | |
|---|---|
| DRAWN BY | N.J. |
| CHECKED | V.K. |
| APPROVED | P.B. |

SYSTEM:-375 KLD MBR STP

PROJECT:- 375 KLD MBR STP PLANT CONTROL PANEL

DRG. NO.:PRG-2526-637 | SHEET NO. 47 / 47 | REV.NO. AS BUILT